

O.D.O.T. DISTRICT 2 SURVEY OFFICE (USE ONLY)

PERSONNEL

REFERENCE NO. 9

SHEET 12 OF 21

NOTES GARRETT

DATE 7/7/20

ROUTE SR 108

H.C. AUBLE

WEATHER SUNNY

COUNTY HENRY

R.C. MAHLER

TEMP. 90°

TOWNSHIP PLEASANT

SECTION 11

DWG BY NIESE PID 95739

T 3 N R 6 E


TYPE MONUMENT LG R.R.SPIKE

ON SURFACE - ~~BELOW~~ ON

OFFSET \odot PAVEMENT 39.05' LT : ~~RT~~

3.9' TO S EDGE PAVEMENT

STATION: 264+88.26

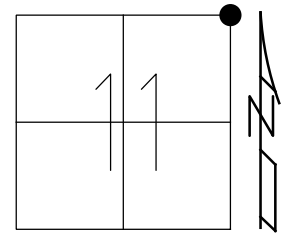


HORZ.DATUM: NAD83 (2011)

GEOID: NAVD88 2012A

GRID: NORTHING: 577079.304

EASTING: 1519550.917

RECORD:
 FD R.R.SPIKE
 3" DOWN
 4/30/03, MB
 FD R.R.SPIKE
 10/30/03, MB
 FD R.R.SPIKE
 REF9
 2/4/16, JLL
 FD RR SPIKE
 2/14/19, JLL
 10/4/19, JFO
 7/7/20, DSA
 FD LG RR SPIKE
 12/14/20, DSA

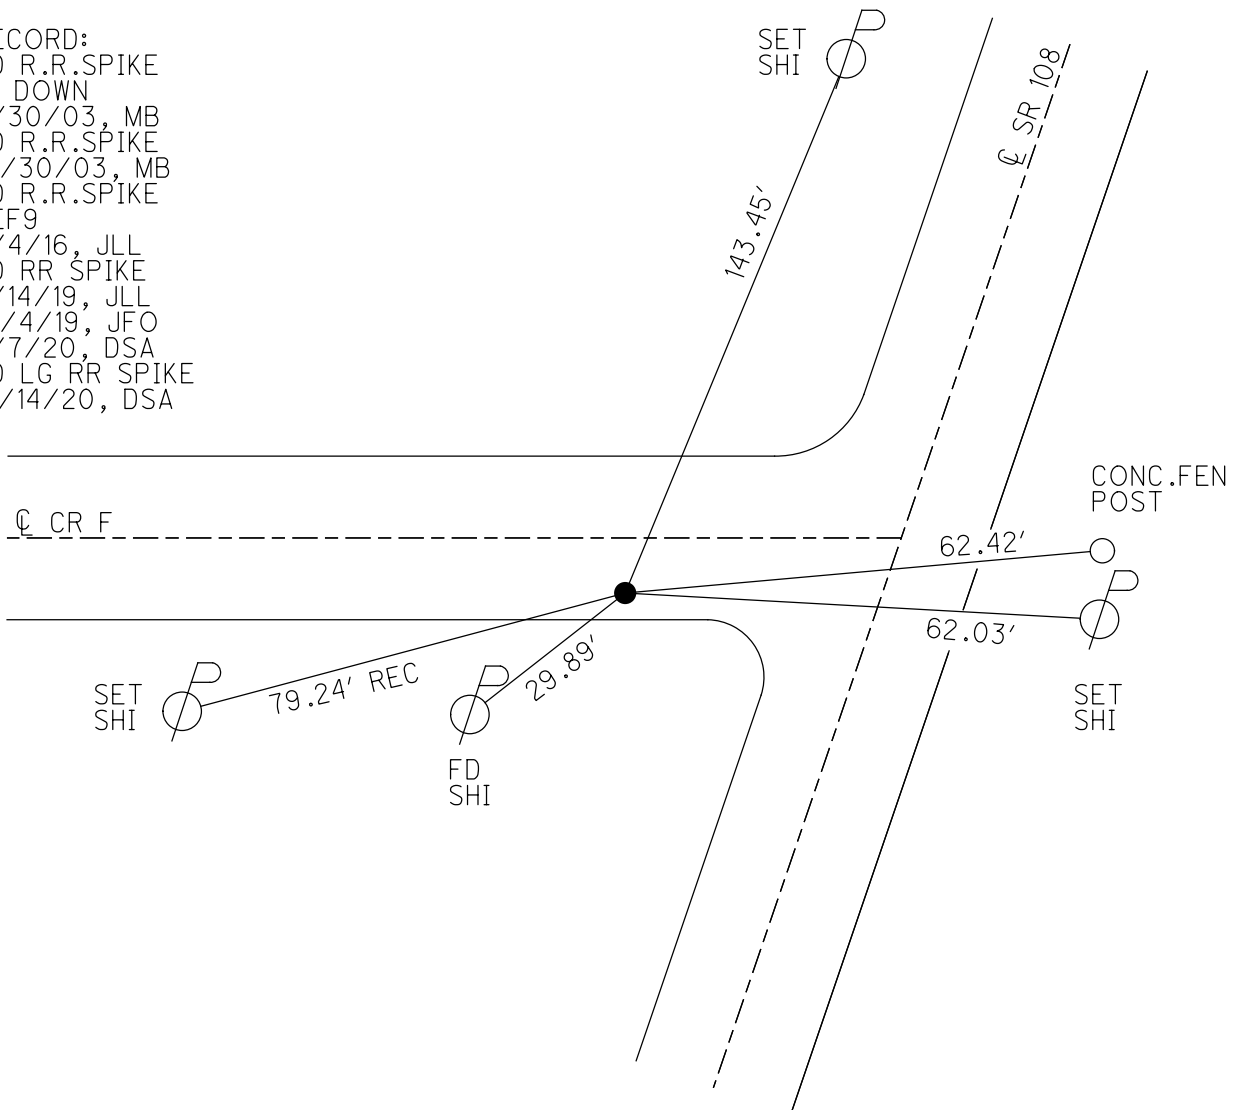

O.D.O.T. DISTRICT 2 SURVEY OFFICE (USE ONLY)

PERSONNEL _____ REFERENCE NO. 9 SHEET 5 OF 16

NOTES BRUMBAUGH DATE 4/30/03 ROUTE SR 108
 H.C. BARNHISEL WEATHER PTLY CLOUDY COUNTY HENRY
 R.C. RYALL TEMP. 60° TOWNSHIP PLEASANT
 _____ SECTION 11
 _____ T 3 N R 6 E

TYPE MONUMENT R.R.SPIKE


~~ON SURFACE~~ - BELOW 3"

LEFT - CL PAV'T - ~~RIGHT~~ 39.3'

3' N TO S EDGE PAVEMENT


S.L.M. 265+88.5

Grid: Northing: 577079.304 Easting: 1519550.917

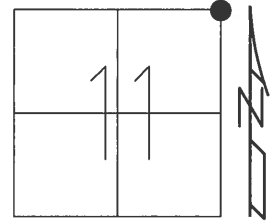

RECORD:
 FD R.R.SPIKE
 10/30/03, MB
 FD R.R.SPIKE
 REF9
 2/4/16, JLL

NOTE: SEC CORS
 FOR 11,12,1,2

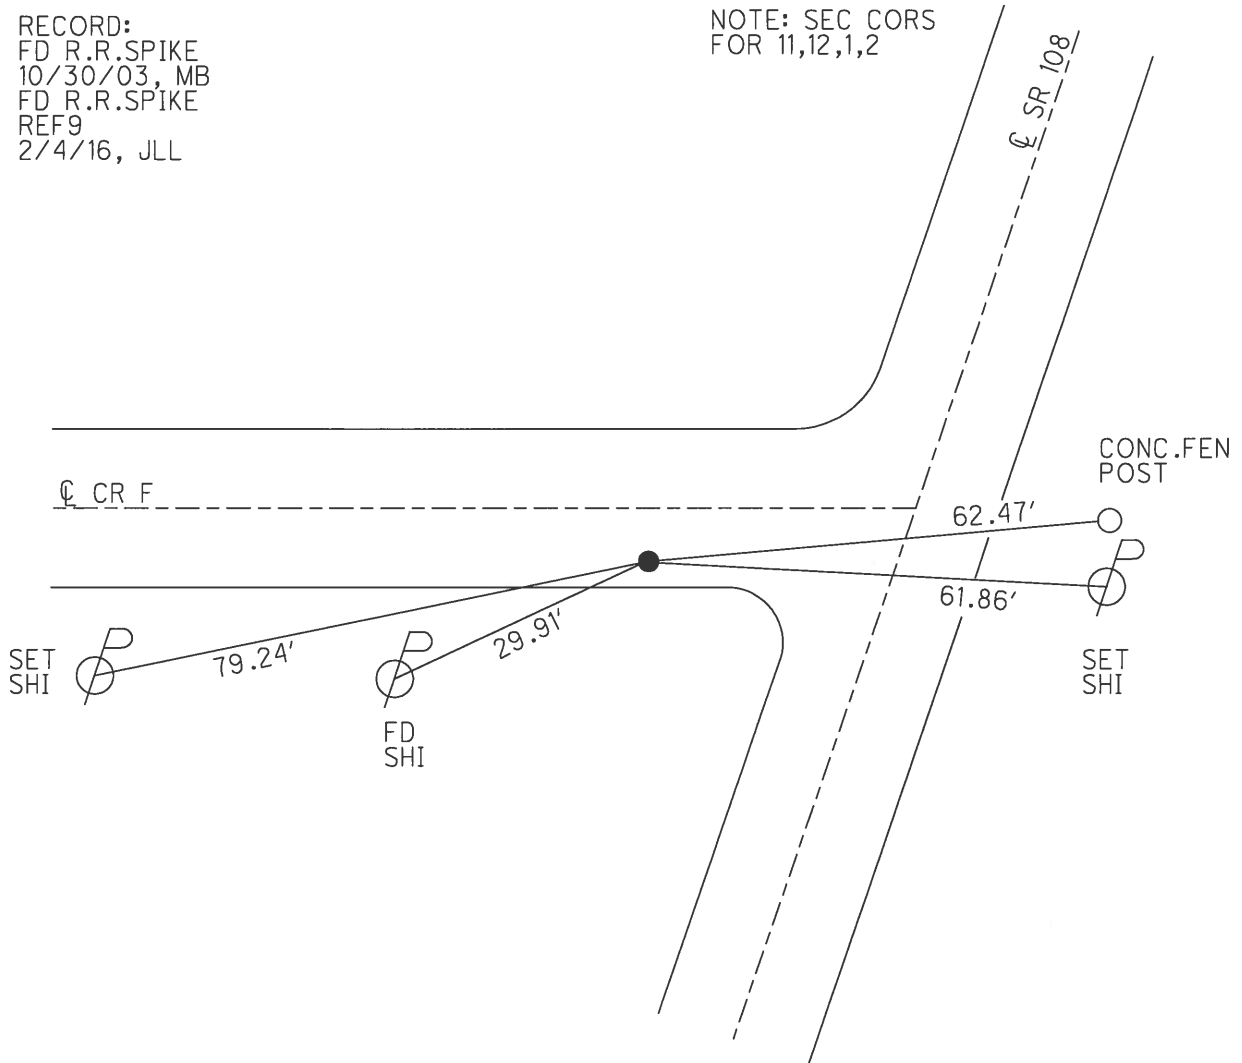

O.D.O.T. DISTRICT 2 SURVEY OFFICE

PERSONNEL

REFERENCE NO. 9 SHEET 12 OF 20

NOTES BRUMBAUGH

H.C. BARNHISEL

R.C. RYALL

DRAWN: CANTERBURY

DATE 4-30-03

WEATHER Pt. Cloudy

TEMP. +60°

ROUTE S.R.# 108

COUNTY HENRY

TOWNSHIP PLEASANT

SECTION 11

T. 3 N. R. 6 E.


TYPE MONUMENT R.R. SPIKE

ON SURFACE - BELOW 3" DOWN


LEFT - CL PAV'T. - RIGHT 39.3' LT CL

3.0' N TO S. EDGE PAVEMENT - C.R. "F"

S.L.M. 264 + 92

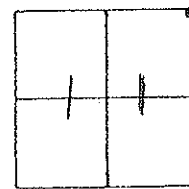

POINT NOT COVERED
10/30/03
M.B.

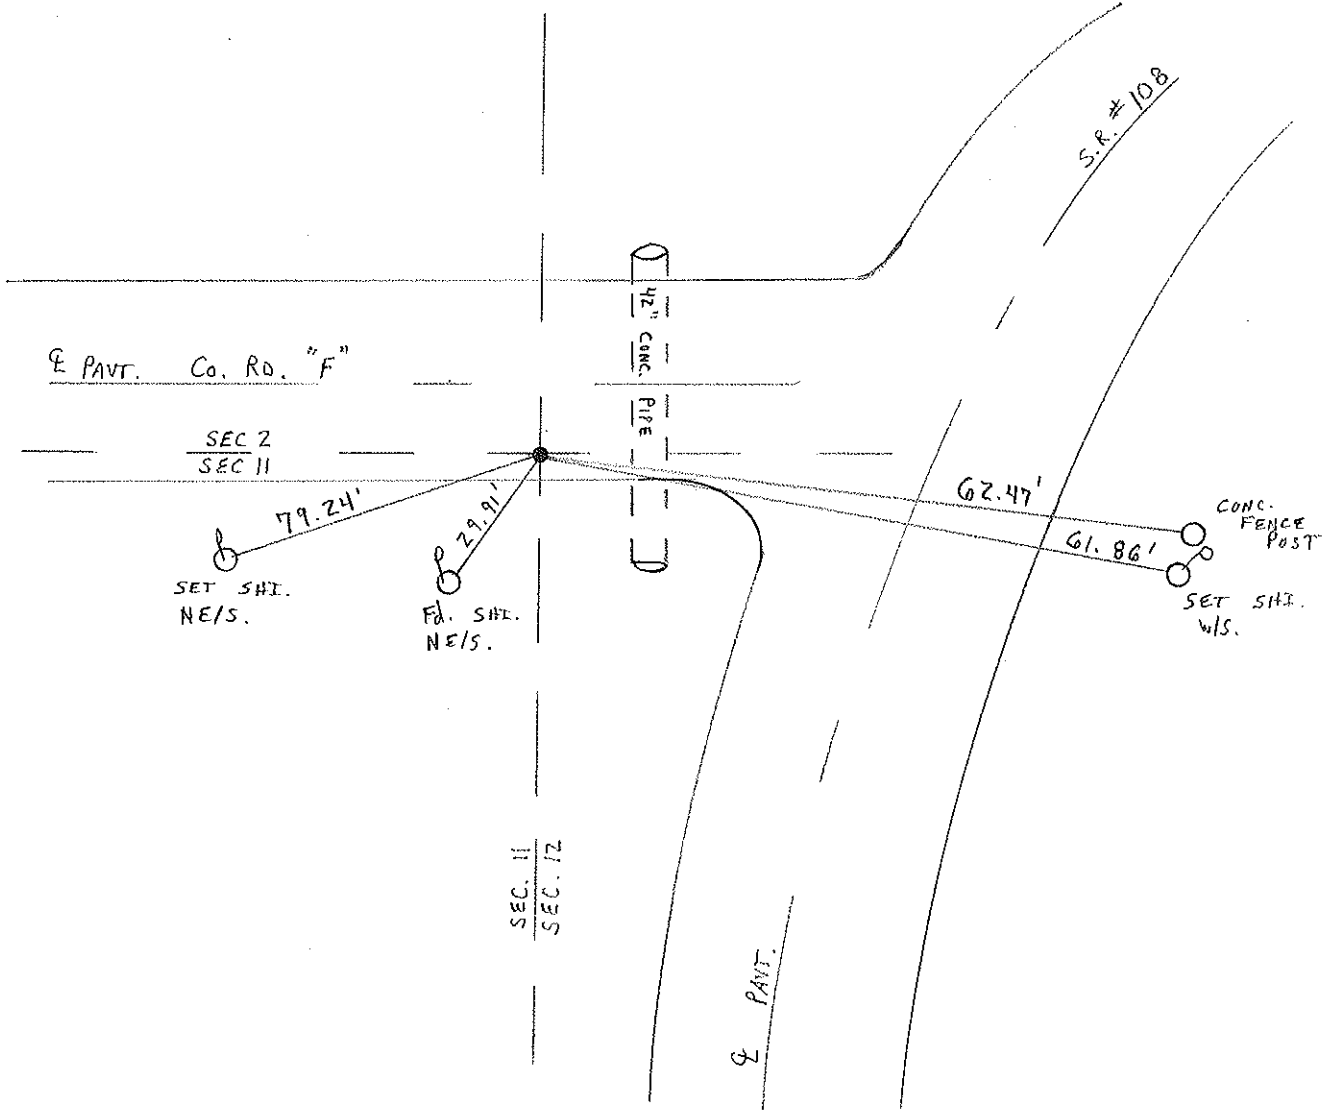

O.D.O.T. DISTRICT 2 SURVEY OFFICE

PERSONNEL

REFERENCE NO. 9

SHEET 11 OF 54

NOTES Lo EHRKE

H.C. CURTIS

DATE 7-21-92

ROUTE S.R. 108

R.C. Romero

WEATHER Pt Cloudy

COUNTY Henry

FALKOWSKI

TEMP. +75

TOWNSHIP Pleasant

SECTION 11

T 3 N R 6 E



TYPE MONUMENT R.R. Spike

ON SURFACE - BELOW yes

LEFT C PAV'T. - RIGHT 39.3 SR108

3.0 N TO S EDGE PAVEMENT - C.R."F"

S.L.M. 266+92

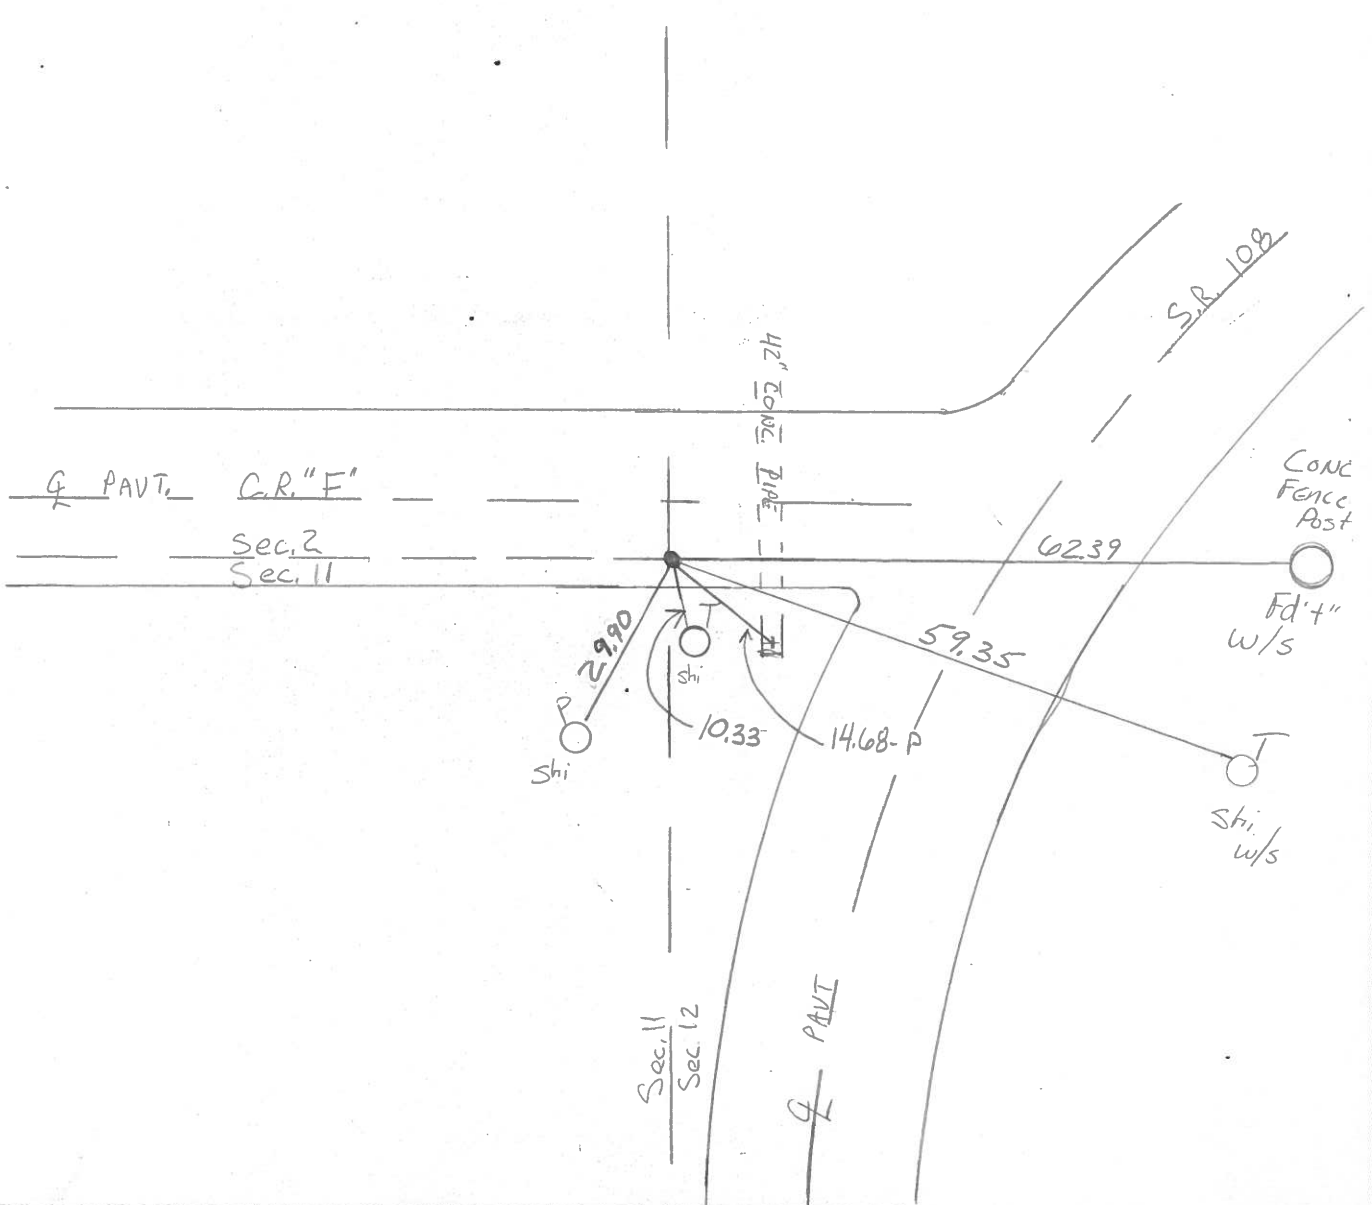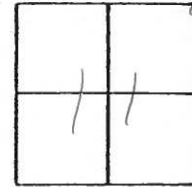

County HENRY S.R. 108

Township PLEASANT

Section N.E. Cor Sec 11

T3N, R6E

Personnel Barnhisel


Loehrke H.C.

Householder R.C.

Date 5-2-84

Weather Clear

Temp. +60°

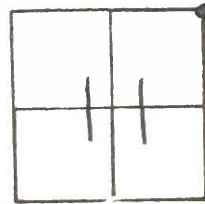


9

FD Lg RR. SPK
@ surface

SLM: 266+84

39.3 Lt @ 108

30 n/of S/EP
of Rd "F"

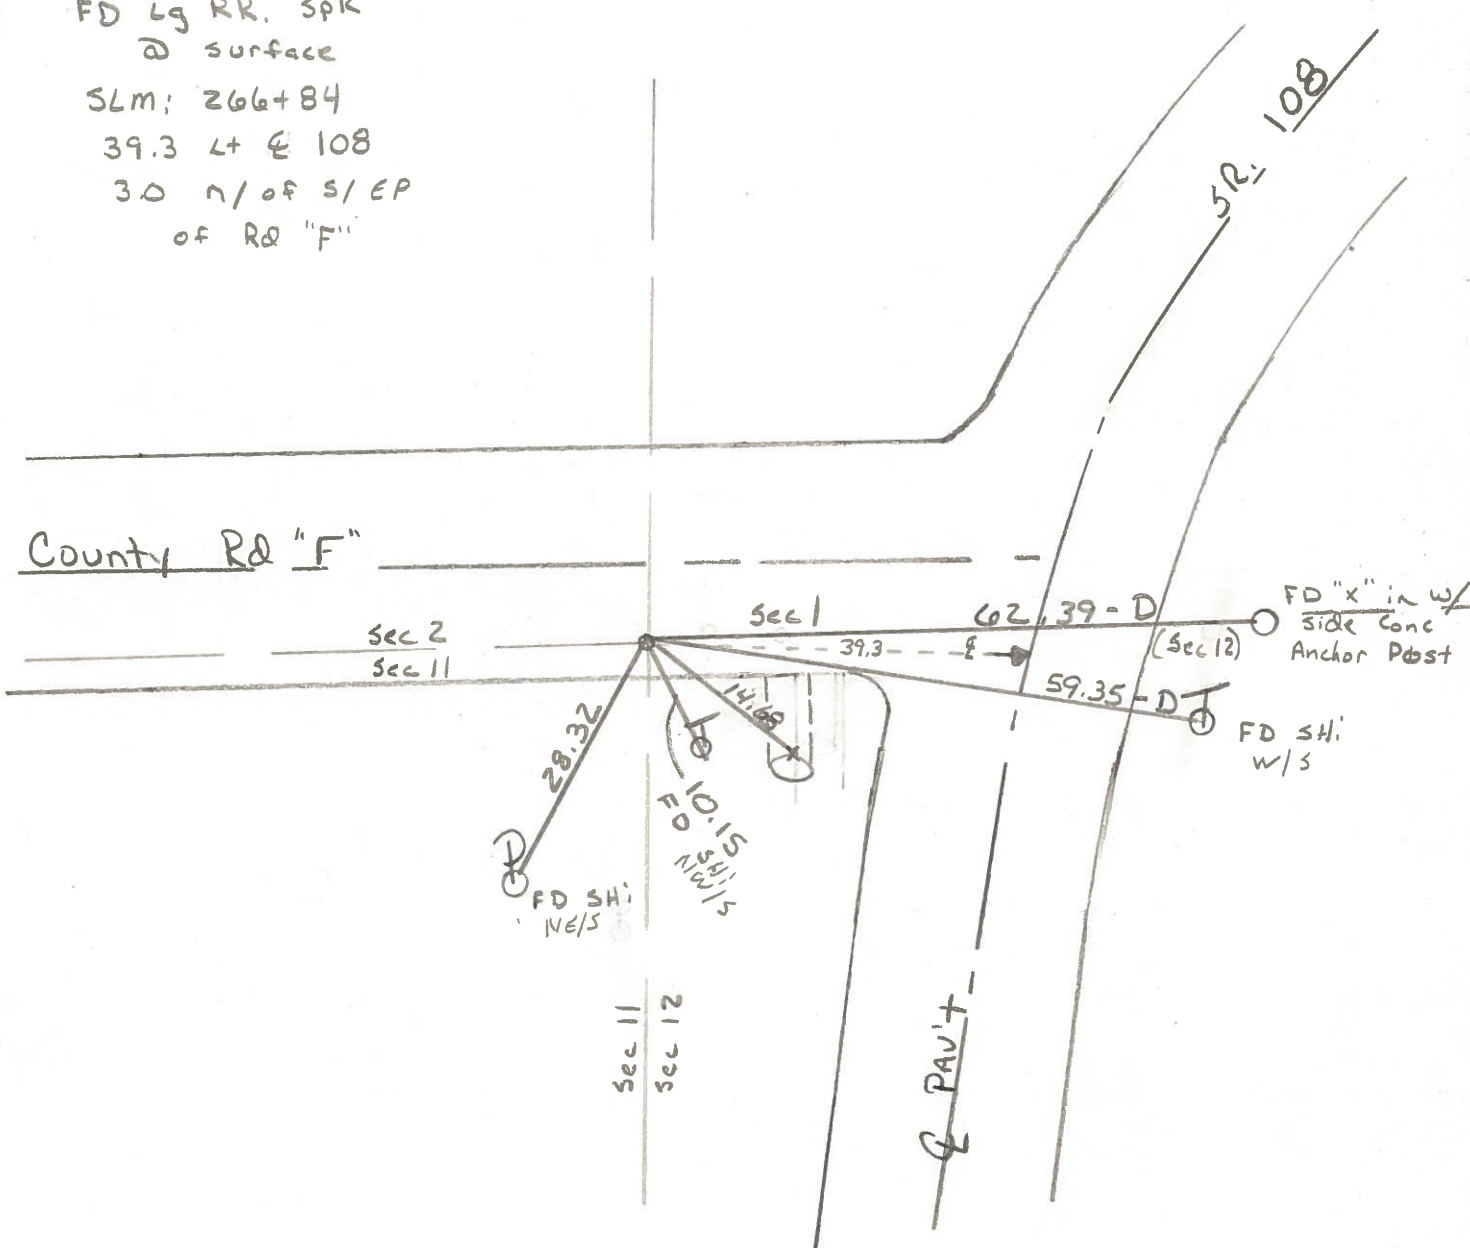

County Rd "F"

SR: 108

Sec 2
Sec 11

Sec 1

62.39-D

(Sec 12)

FD "x" in w/
side Conc
Anchor Post

59.35-D

FD SH:
W/S

28.32
FD SH:
NE/S

14.68
10.15
FD SH:
NW/S

Sec 11
Sec 12

PAV'T

OD.O.T. DISTRICT 2 SURVEY OFFICE

Sht. 8 of 11
S.R. 108

County HENRY

Date 8-2-78

Township PLEASANT

Weather LT. RAIN

Section N.E. COR. SEC. 11

Temp. +83°

T3N, R6E


Personnel BURNSIDE

SMITH

BOWERS

KNAPE

MEAD

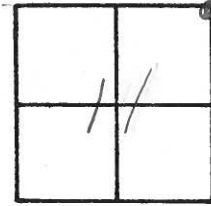

9

FD. R.R. SPK. @
SURFACE

COUNTY RD. "F"

SEC. 2
SEC. 1

SEC. 2
SEC. 11

SEC. 1

SEC. 12

SEC. 11
SEC. 12



108

62.38'

"+" IN W. SIDE
CONC. ANCHOR
POST

59.33

SHI.

SHI.

"+" TOP S. END
36" CONC.
PIPE

S.R.

PERSONNEL	TITLE	PERSONNEL	TITLE	COUNTY	DATE	WEATHER	TEMP.
TOM SIK				HENRY	Sept. 17, 1974		
Neuser				S. R. 108			
VANYO				SEC. PLEASANT 7			
GRANATA							

DESCRIPTION _____ LEFT _____ CENTER LINE _____ RIGHT _____ JOB NO. _____

