

O.D.O.T. DISTRICT 2 SURVEY OFFICE (USE ONLY)

PERSONNEL _____ REFERENCE NO. 10 B SHEET 8 OF 16
 NOTES HELDMAN DATE 4/26/17 ROUTE SR 108
 H.C. LEU WEATHER PTLY CLOUDY COUNTY HENRY
 R.C. HELDMAN TEMP. 64° TOWNSHIP PLEASANT
 _____ SECTION 1
 _____ T 3 N R 6 E

TYPE MONUMENT MAG/WASHER



ON SURFACE - ~~BELOW~~ ON _____

~~LEFT~~ - ☉ PAV'T - RIGHT 0.5', 0.5' W OF ☉ N

- TO - EDGE PAVEMENT

S.L.M. 311+02.6

Grid: Northing: 580943.787 Easting: 1519875.862

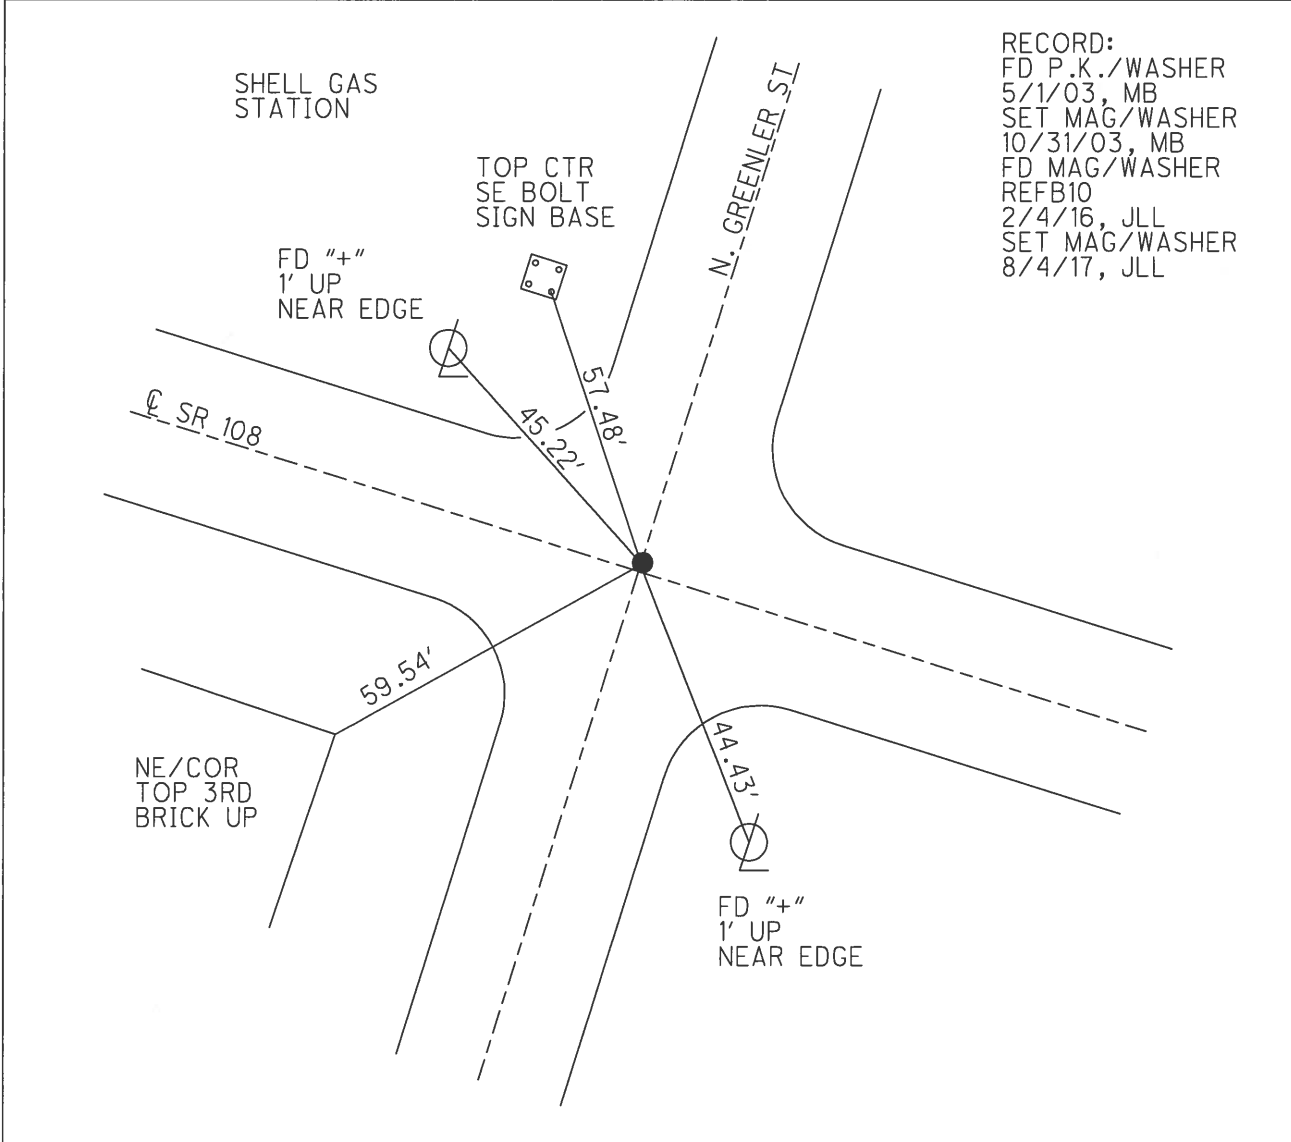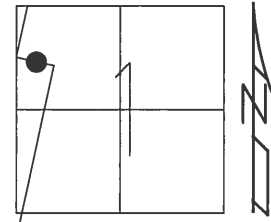

O.D.O.T. DISTRICT 2 SURVEY OFFICE

PERSONNEL

REFERENCE NO. 10-B

SHEET 15 OF 20

NOTES BRUMBAUGH

H.C. BARNHISEL

R.C. RYALL

DRAWN: CANTERBURY

DATE 5-01-03

WEATHER Pt. CLOUDY

TEMP. +68°

ROUTE S.R. # 109

COUNTY HENRY

TOWNSHIP PLEASANT

SECTION 2

T 3 N R 6 E


TYPE MONUMENT P.K. / WASHER

ON SURFACE - BELOW 1" DOWN


LEFT - & PAV'T. - RIGHT ON &

TO EDGE PAVEMENT

S.L.M. 309 + 95

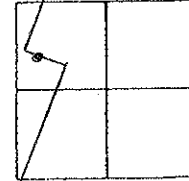

RESET MAG/WASHER
10-31-03
M.C.

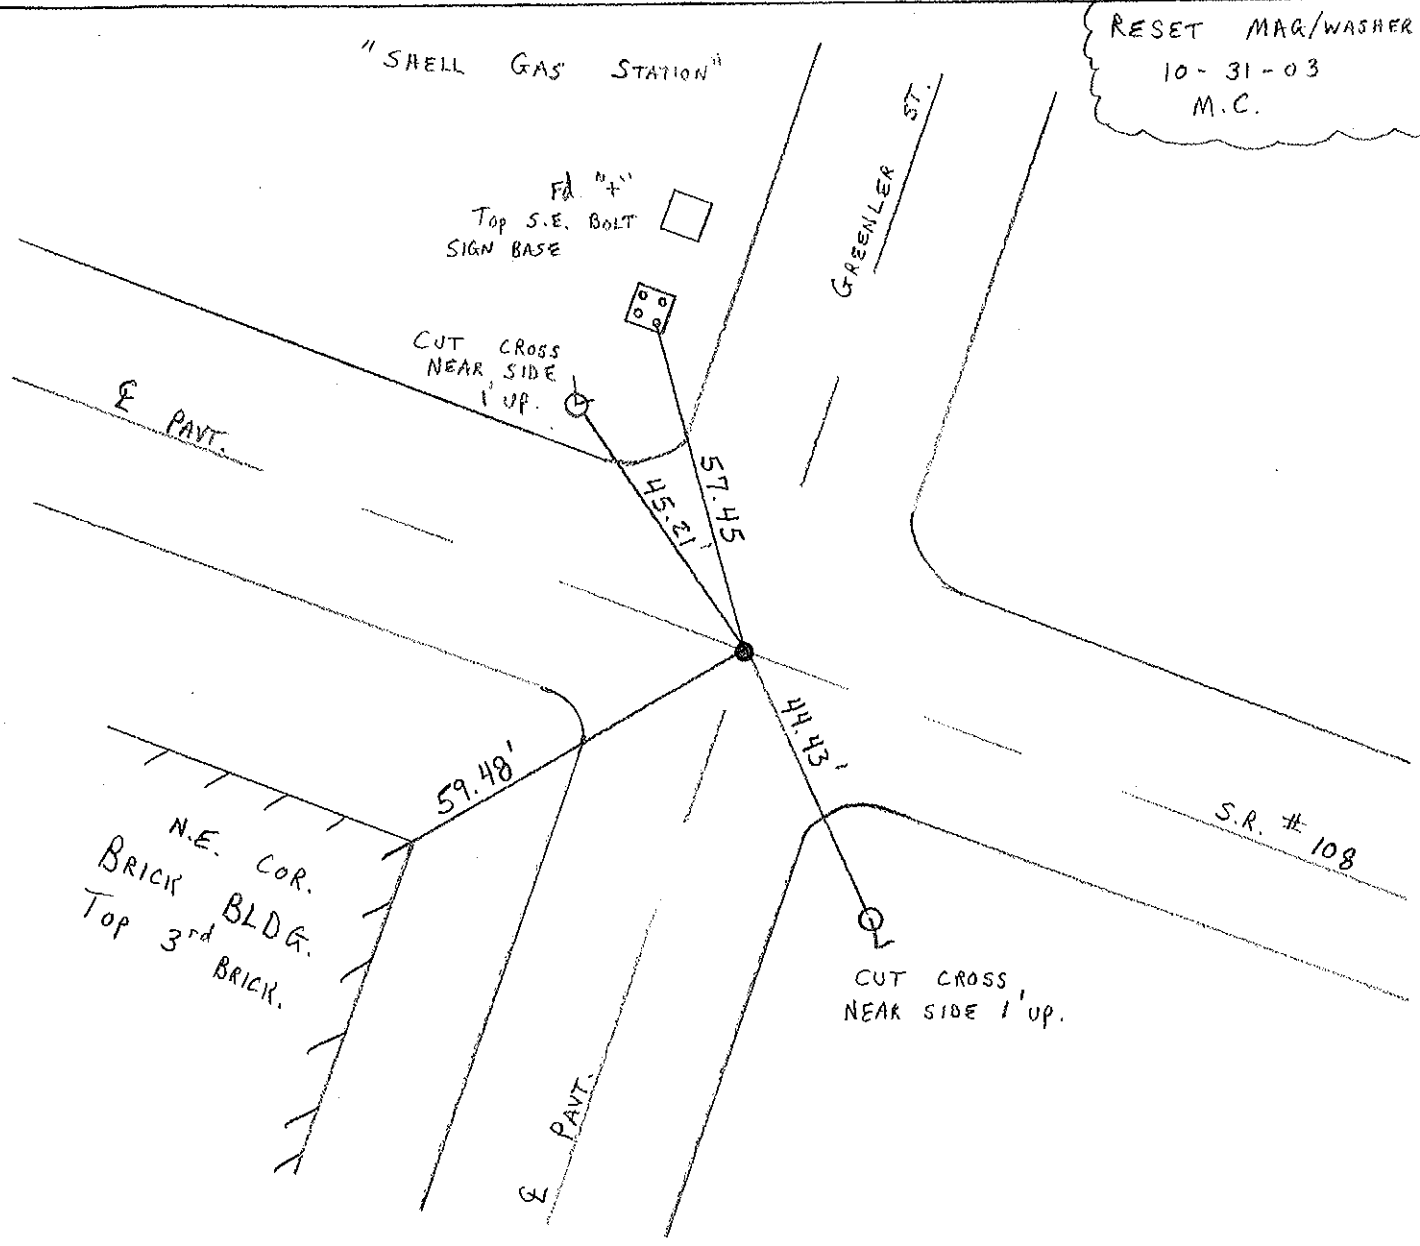

O.D.O.T. DISTRICT 2 SURVEY OFFICE

PERSONNEL

REFERENCE NO. 10-B

SHEET 14 OF 54

NOTES LOGHME

H.C. CURTIS

DATE 8-14-92

ROUTE S.R. 109

R.C. ROMETO

WEATHER Cloudy

COUNTY HENRY

FALKOWSKI

TEMP. 108

TOWNSHIP PLEASANT

SECTION 1

RESET 9-29-92

T 3 N 6 E



TYPE MONUMENT P.K. & WASHER

ON SURFACE - BELOW Yes

LEFT - ☐ PAVT. - RIGHT Yes

TO EDGE PAVEMENT

S.L.M. 309 +95

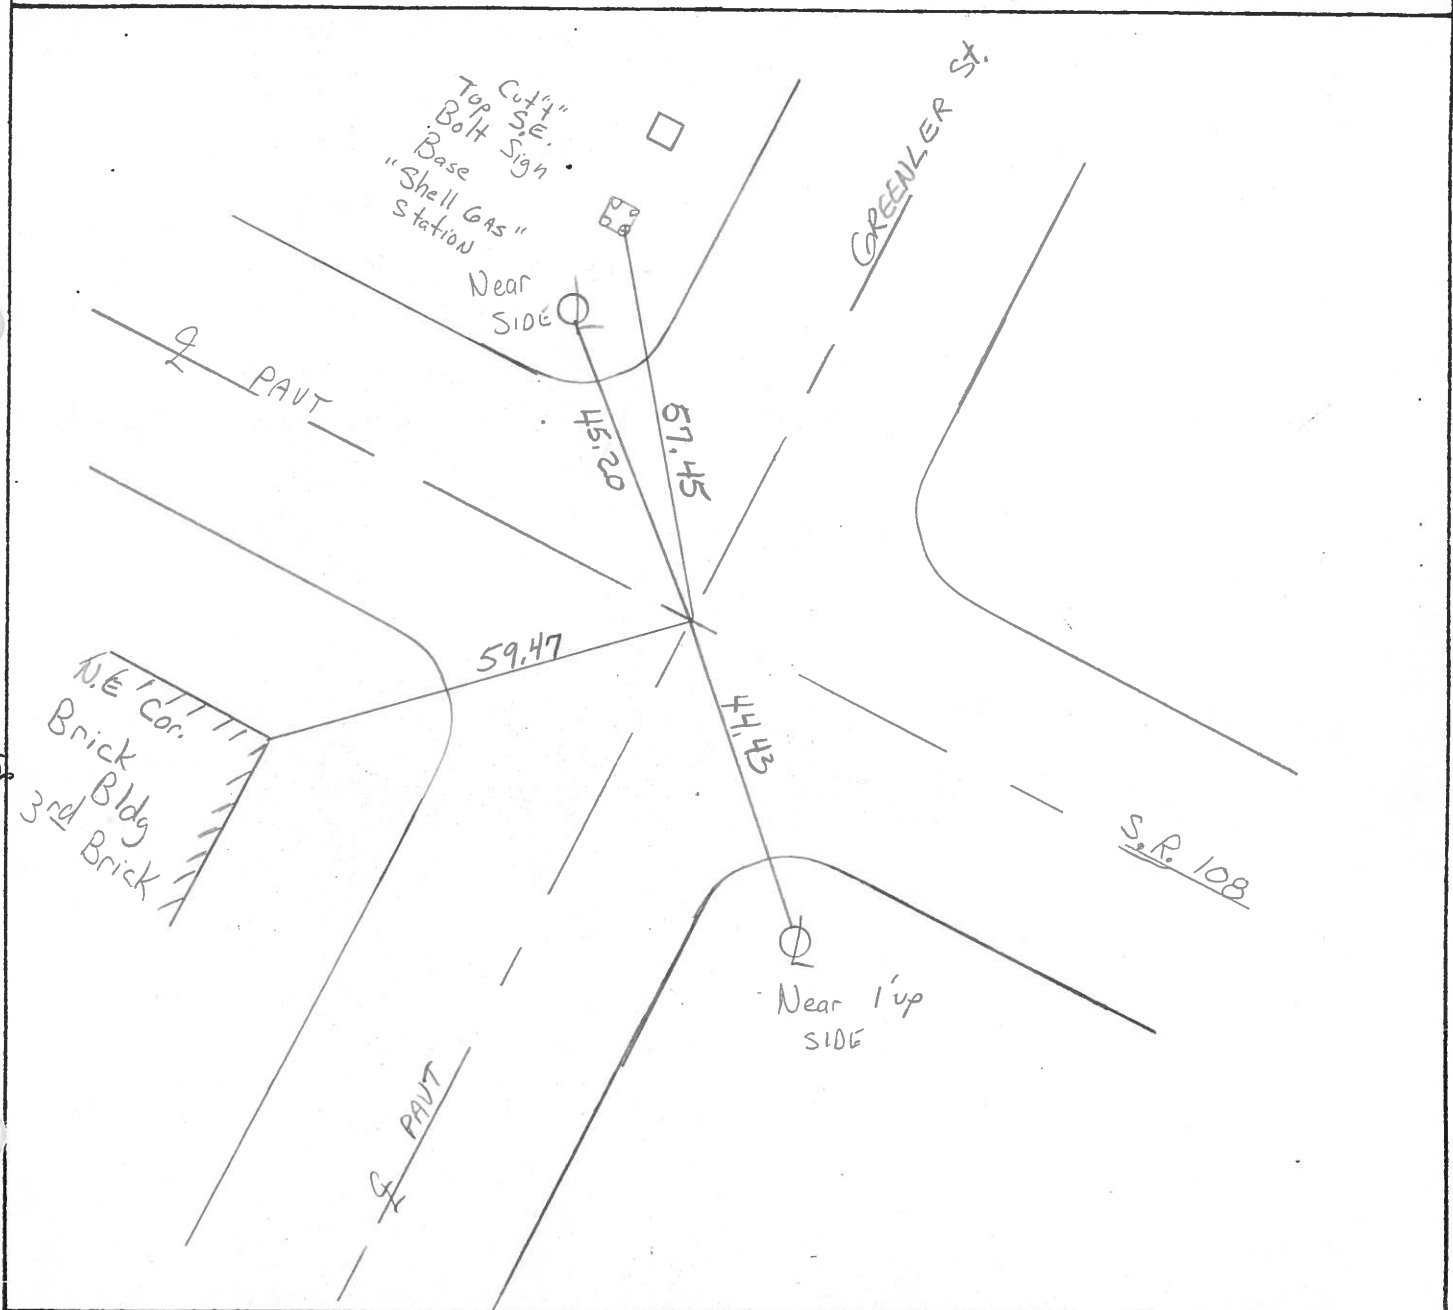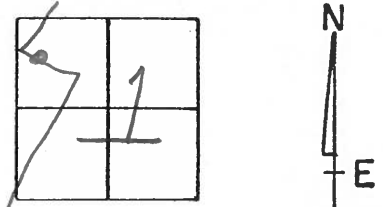

County HENRY S.R. 108

Township Pleasant

Section 1

T3N, R6E

Personnel Barnhisel


Loehrke H.C.

Hausholder R.C.

Date 5-2-84

Weather Clear

Temp. +60°

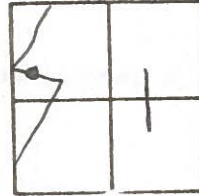


10-B

FD P.K. Nail

@ surface

E of 108

E of Greener St

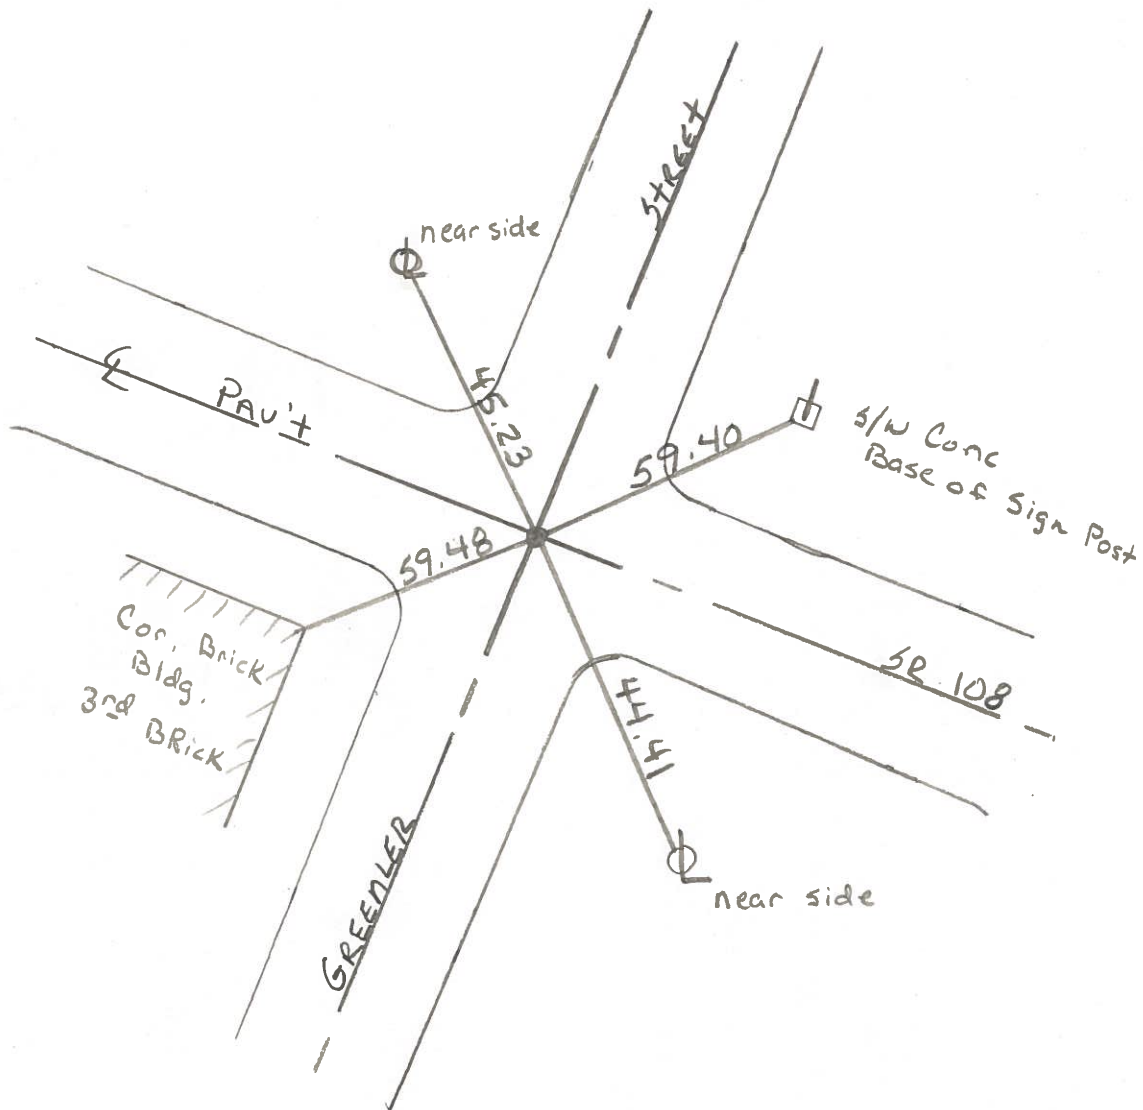

County HENRY

Date 8-2-78

Township PLEASANT

Weather CLOUDY

Section HOLGATE

Temp. +83°

T_N, R_E



Personnel BURNSIDE

SMITH

BOWERS

KNAPE

MEAD

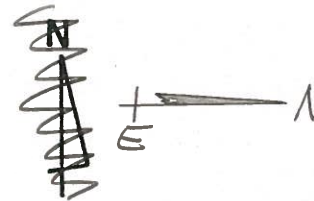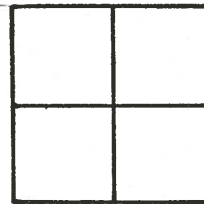

10-B

FD. P.K. NAIL
@ SURFACE

