



O.D.O.T. DISTRICT 2 SURVEY OFFICE (USE ONLY)

PERSONNEL _____ REFERENCE NO. 11 SHEET 9 OF 16
 NOTES HELDMAN DATE 4/16/17 ROUTE SR 108
 H.C. LEU WEATHER PTLY CLOUDY COUNTY HENRY
 R.C. HELDMAN TEMP. 64° TOWNSHIP PLEASANT
 SECTION 1
 T 3 N R 6 E

TYPE MONUMENT MAG/WASHER
 ON SURFACE - ~~BELOW~~ ON
~~LEFT~~ - ☉ PAV'T - RIGHT 0.5' OF ☉ N
22.8' TO LT EDGE PAVEMENT
 S.L.M. 314+45.02
 Grid: Northing: 581033.287 Easting: 1519545.354

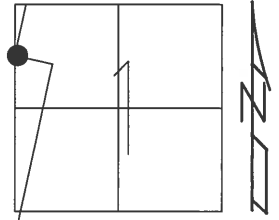

RECORD:
 FD 3/4" IRON BOLT
 4" DOWN
 6/27/84
 FD P.K./WASHER ATOP
 SM.R.R.SPIKE
 5/1/03, MB
 SET MAG/WASHER
 10/31/03, MB
 FD MAG/WASHER
 REF11
 2/4/16, JLL
 SET MAG/WASHER
 8/4/17, JLL

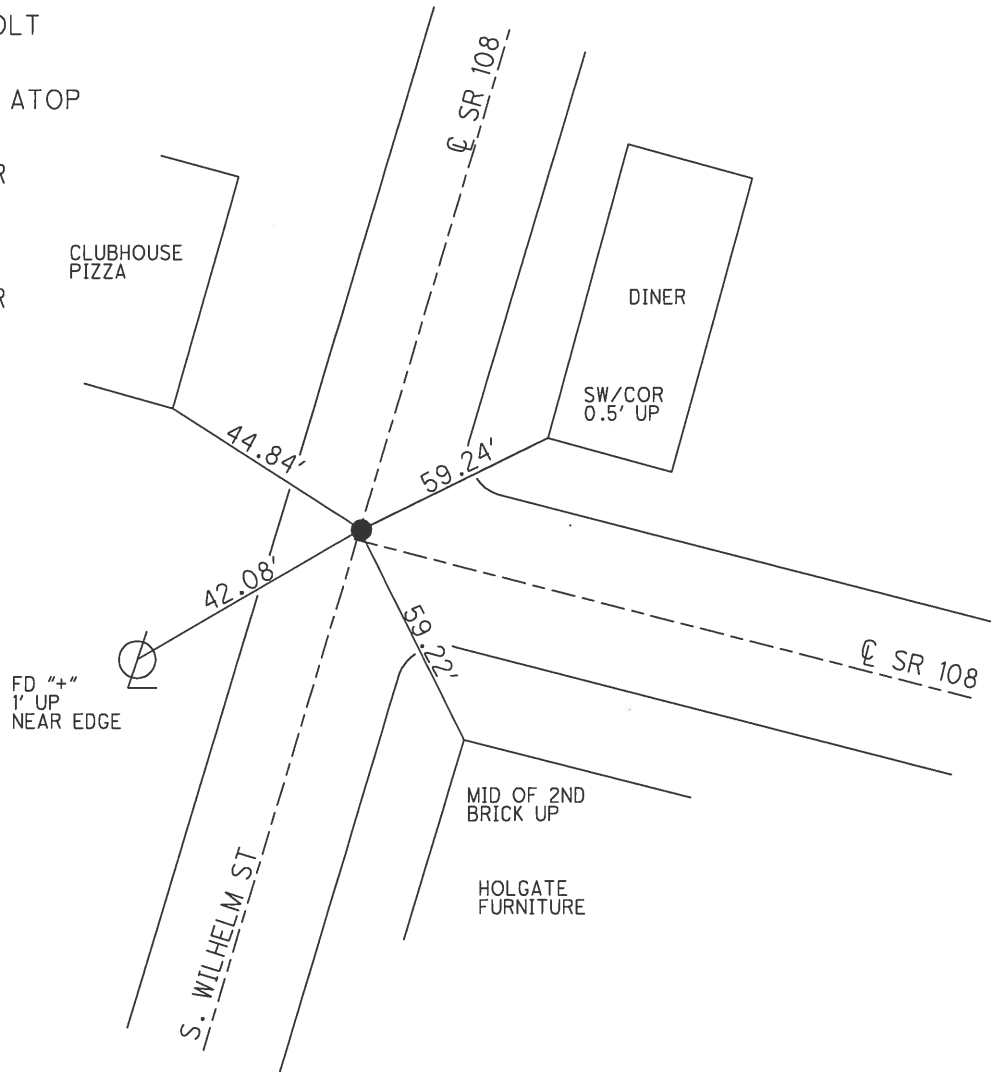

O.D.O.T. DISTRICT 2 SURVEY OFFICE

PERSONNEL

REFERENCE NO. 11


SHEET 16 OF 20

NOTES BRUMBAUGH
 H.C. BARNHISEL
 R.C. RYALL
 DRAWN: CANTERBURY

DATE 5-01-03
 WEATHER Pt. CLOUDY
 TEMP. +68°


ROUTE S.R. # 108
 COUNTY HENRY
 TOWNSHIP PLEASANT
 SECTION 1
T 3 N R 6 E

TYPE MONUMENT P.R./WASHER ATOP SA. R.R. SPK.
 ON SURFACE - ~~BELOW~~ SURFACE
~~LEFT - & PAVT - RIGHT~~ ON &
~~Z2.8 TO LT EDGE PAVEMENT~~
 S.L.M. 313 + 36

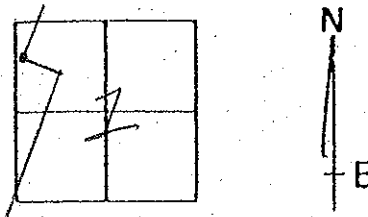

RECORD: FD 3/4" IRON BOLT 4"
DOWN, & OF S.R. # 108 &
WILHELM ST. 6-27-84

RESET MAG/WASHER
 10-31-03
 M.C.

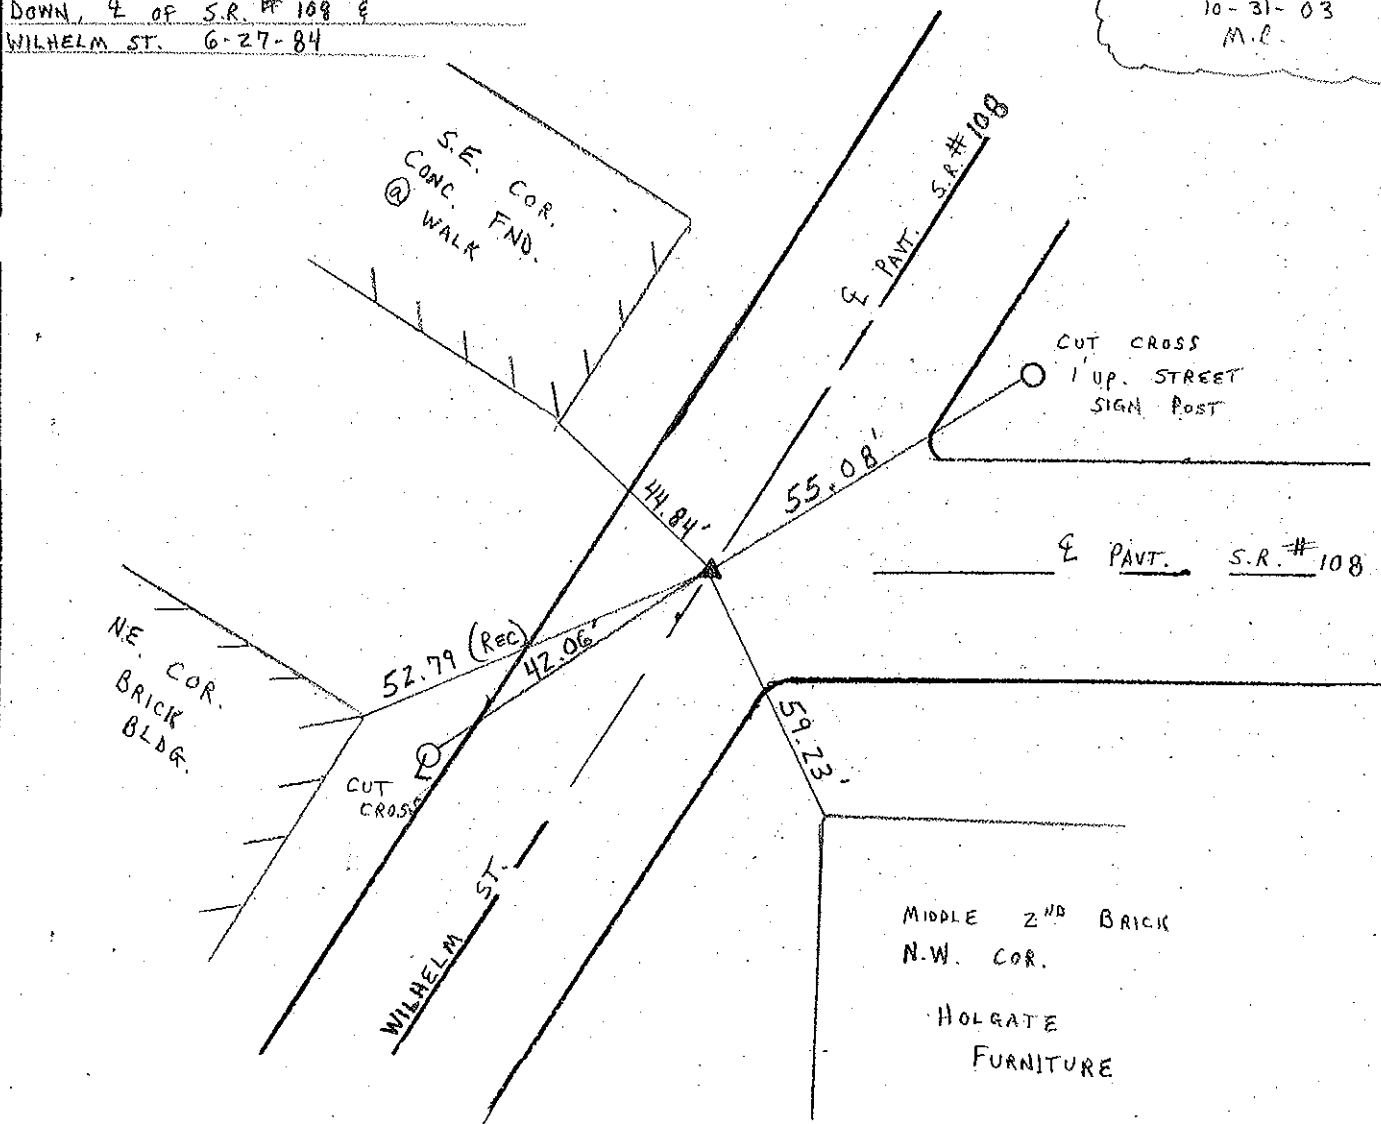

O.D.O.T. DISTRICT 2 SURVEY OFFICE

PERSONNEL

REFERENCE NO. 11

SHEET 15 OF 54

NOTES LOEHRKE

H.C. CURTIS

DATE 8-14-92

ROUTE S.R. 108

R.C. ROMETO

WEATHER CLOUDY

COUNTY Henry

FALKOWSKI

TEMP. +68

TOWNSHIP Plea

SECTION 1

T. 3 N. R. 6 E

TYPE MONUMENT Sm. R.R. Spike


Set P.K. / WASHHER
9-29-92

ON SURFACE - BELOW Yes


LEFT - C PAV'T. - RIGHT Yes

22.8 TO Lt EDGE PAVEMENT

S.L.M. 313+36

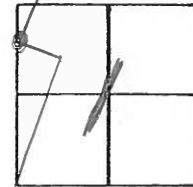

RECORD: Rd 3/4" IRON BOLT
4" DOWN, E OF
SR 108 & WILHELM ST.
6-27-84

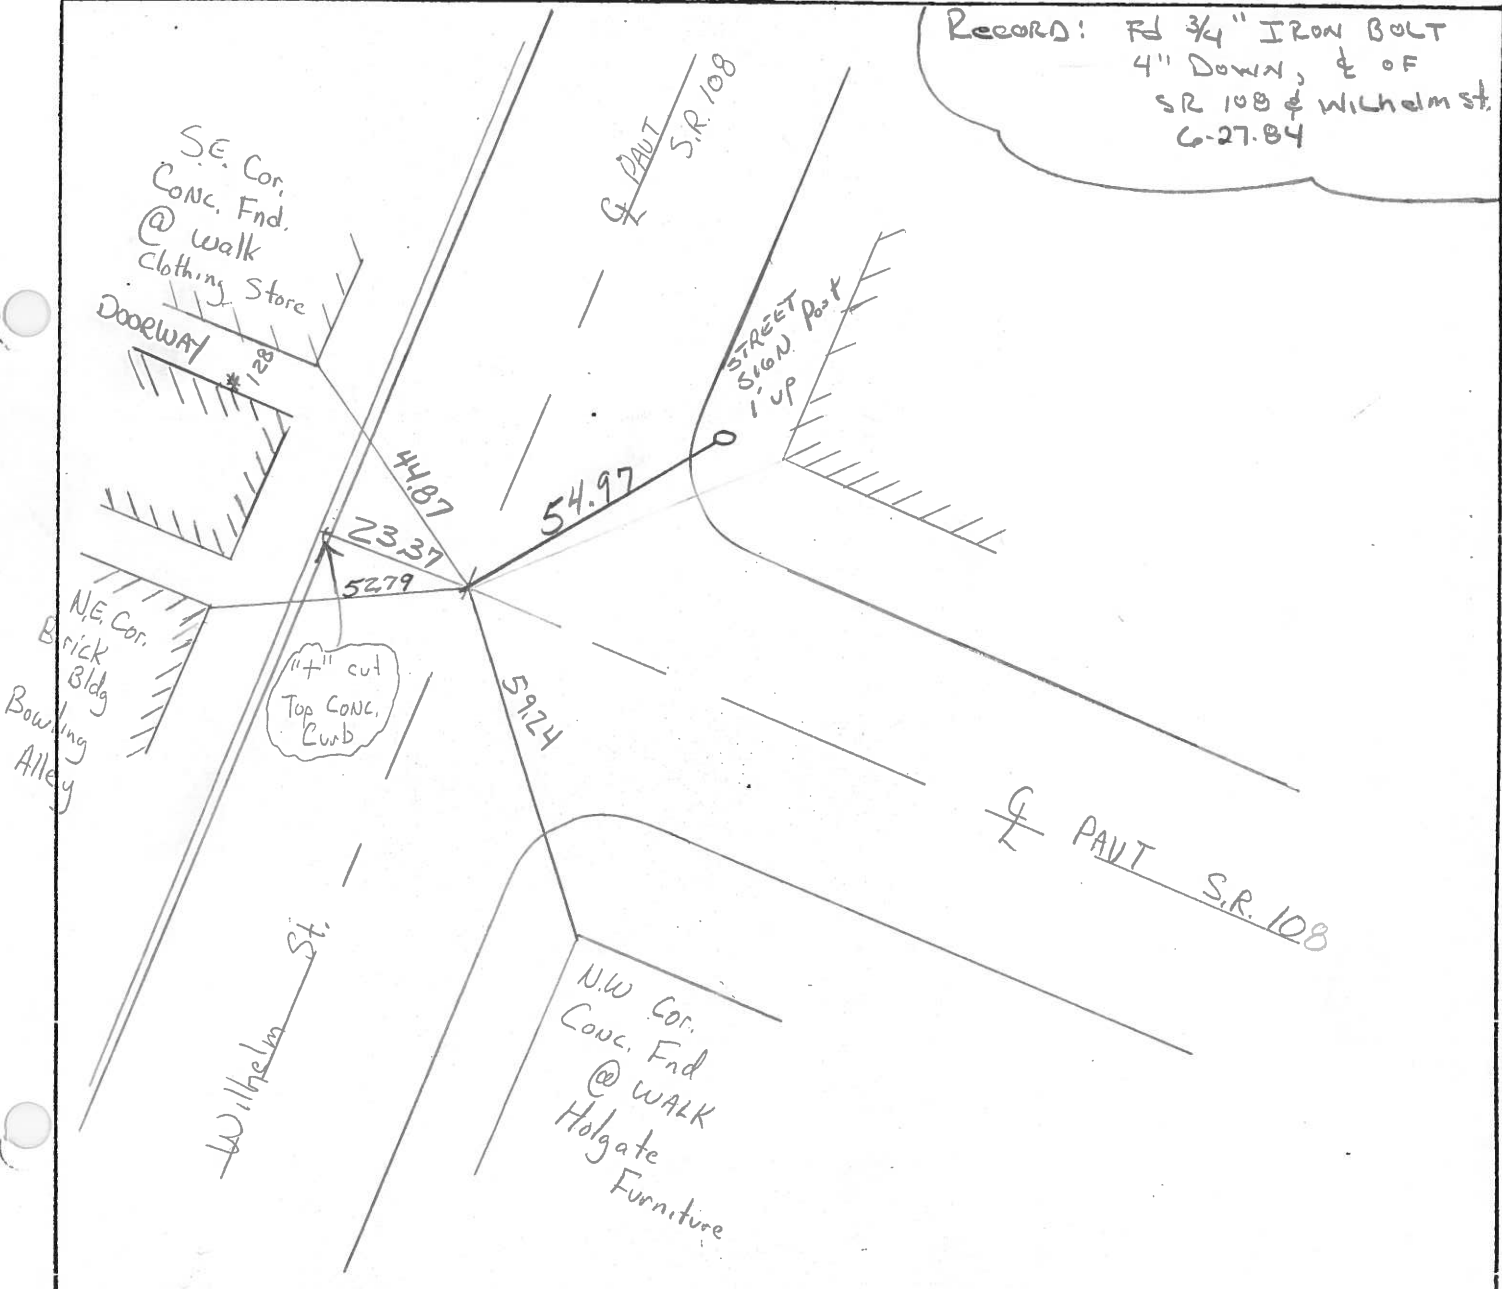

County HENRY S.R. 108

Township Pleasant

Section 1

T3N, R16E

Personnel Hoffman

Loehrke HC


Householder RC

Barnhisel NOTES

Date 6-27-84

Weather partly cloudy

Temp. 61 + 77°

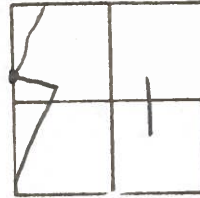

11

SLM 314+16

FD 3/4" Iron Bolt


4" Down

E of SR 108 + Wilhelm St

8-27-84


Set 5m/RR SPIKE

M.D.B.

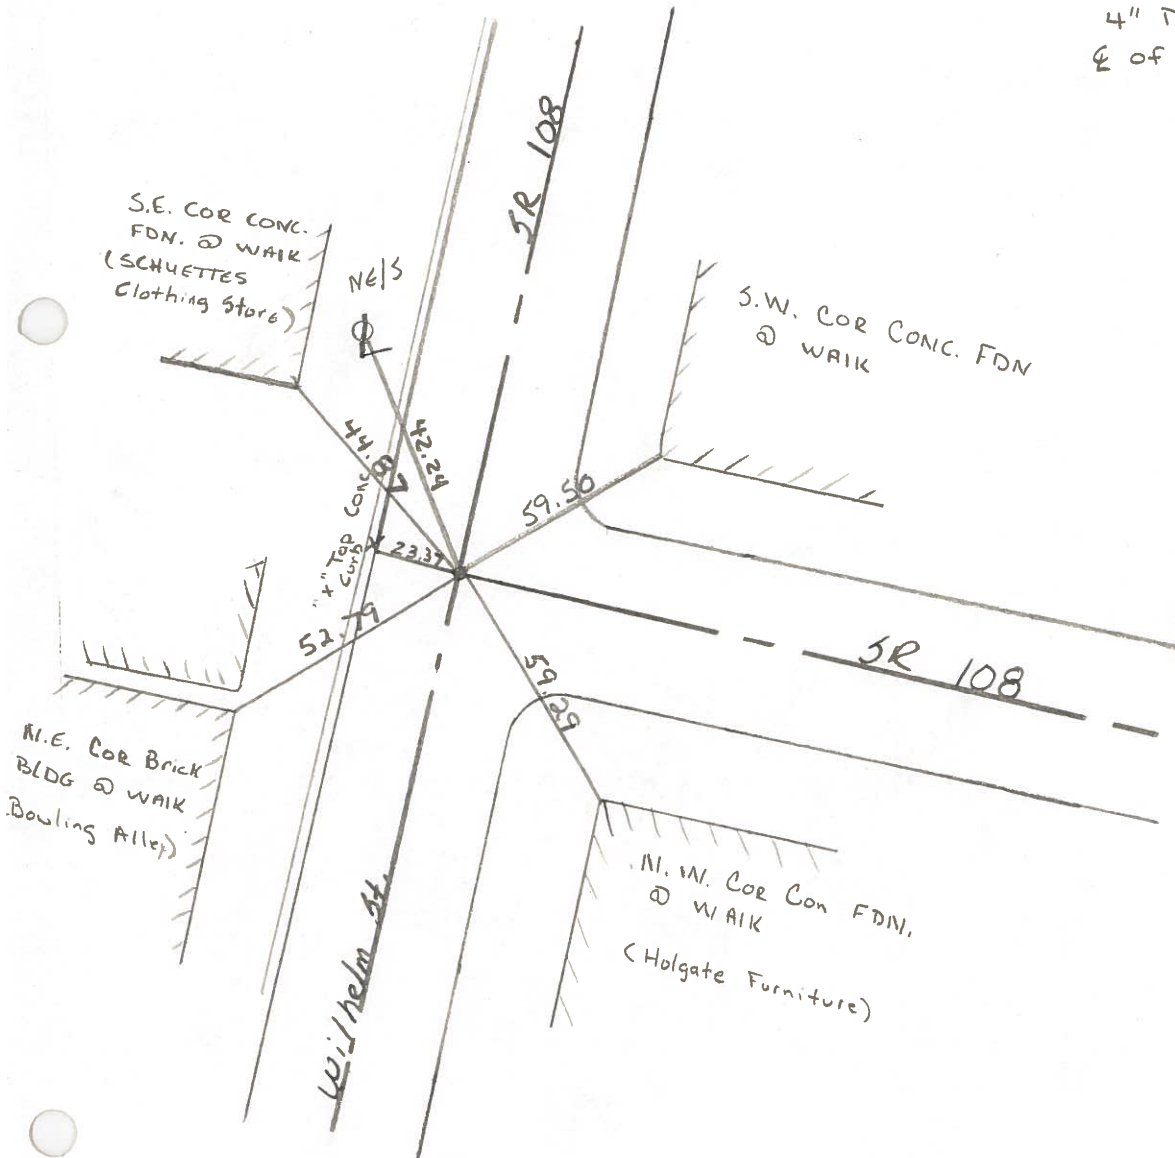

PERSONNEL	TITLE	PERSONNEL	TITLE	COUNTY	HENRY	DATE	July 15, 1974
Dimsic				S. R.	108	WEATHER	
Newer				SEC.	Pleasant Twp.	TEMP.	
Granata							

DESCRIPTION	LEFT	CENTER LINE	RIGHT	JOB NO.
-------------	------	-------------	-------	---------

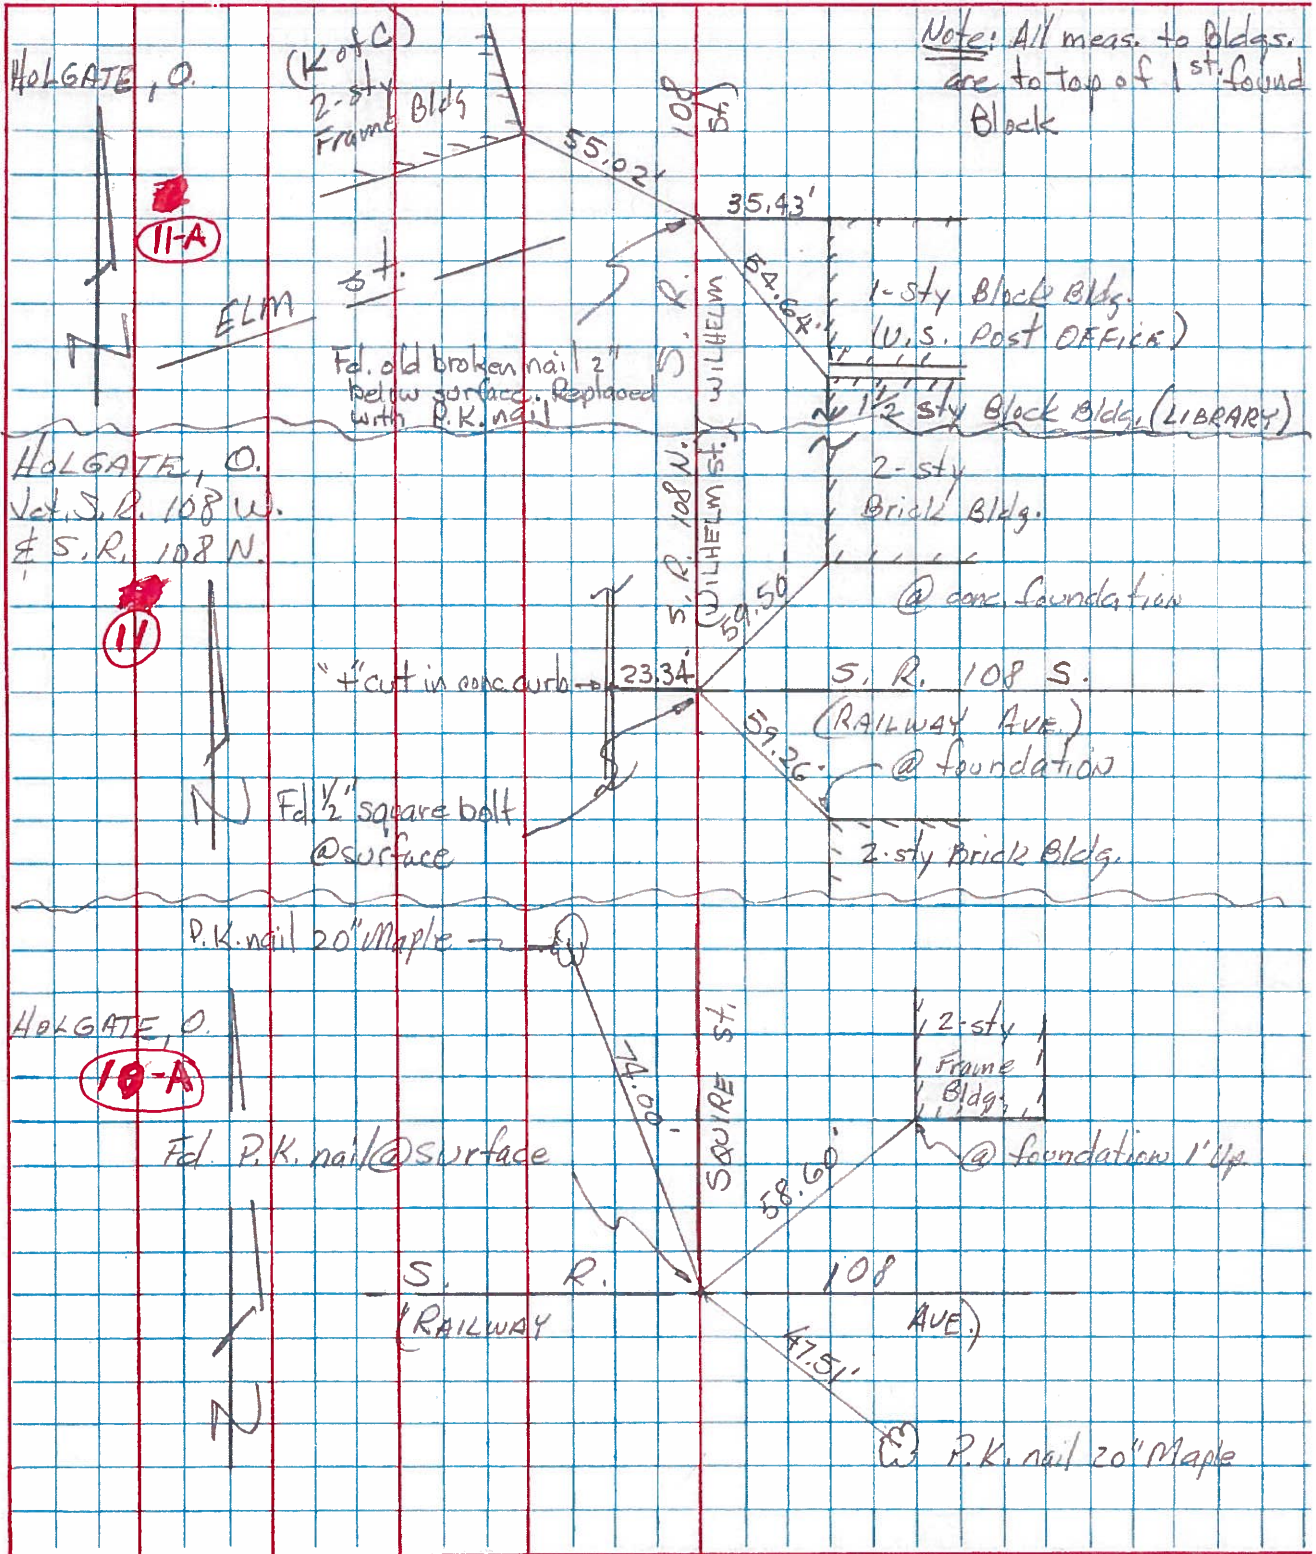

PERSONNEL	TITLE	PERSONNEL	TITLE
BURNSIDE			
SMITH			
BOWERS			

COUNTY HENRY DATE 5-4-72
 S. R. 108 WEATHER CLOUDY
 SEC. HOLGATE TEMP. + 45°

DESCRIPTION _____ LEFT _____ CENTER LINE _____ RIGHT _____ JOB NO. _____

