
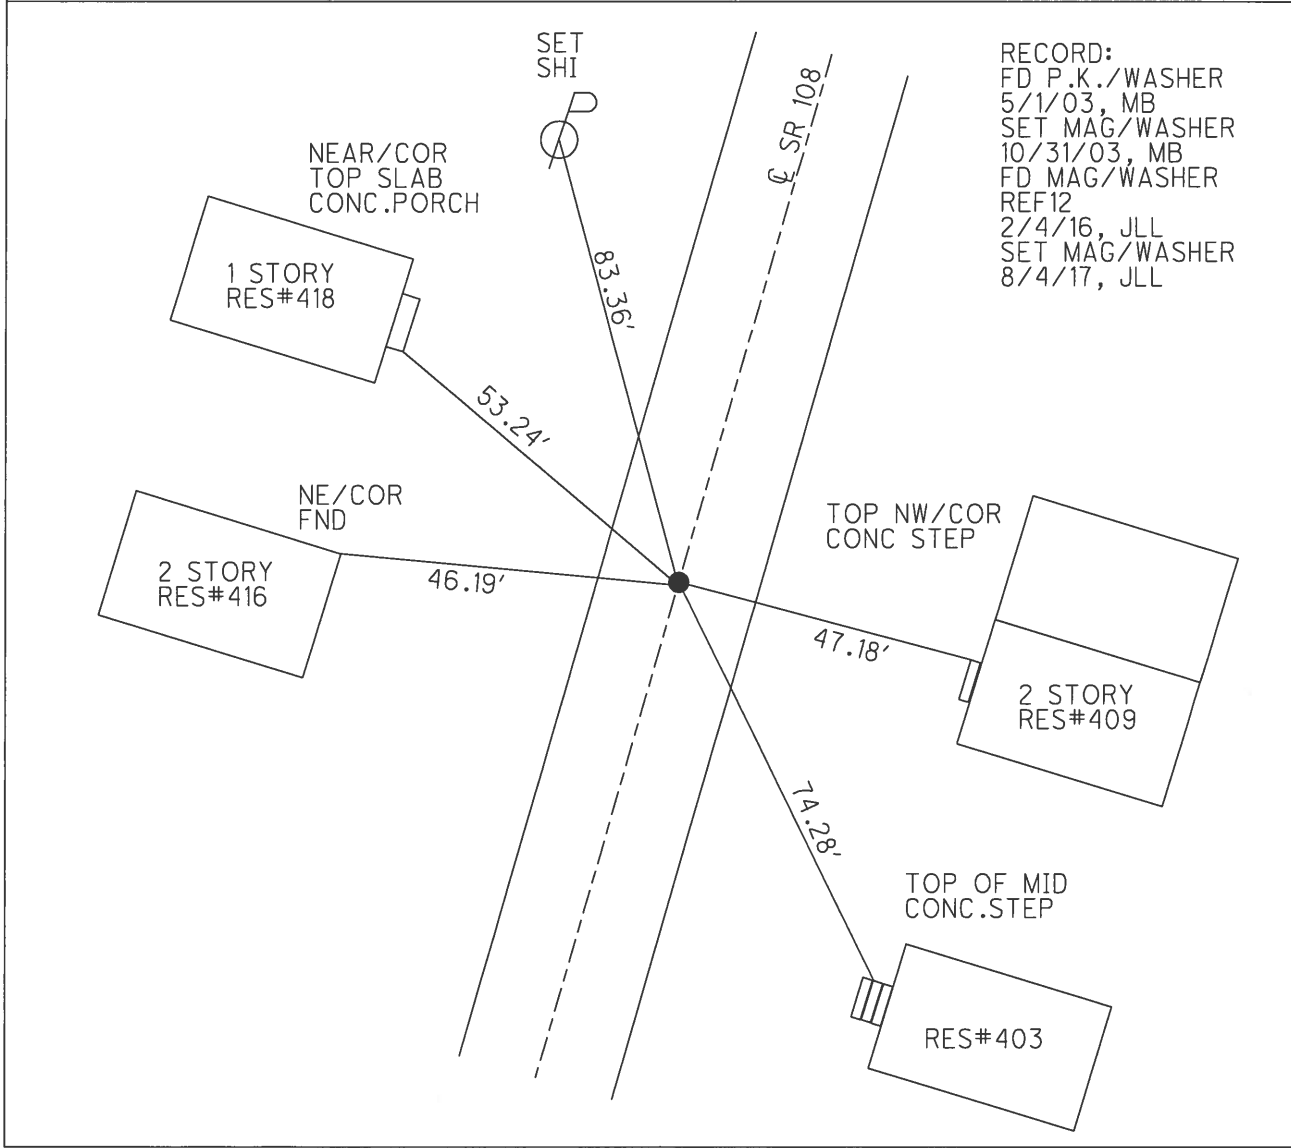


O.D.O.T. DISTRICT 2 SURVEY OFFICE (USE ONLY)

PERSONNEL \_\_\_\_\_ REFERENCE NO. 13 SHEET 12 OF 16  
 NOTES LEU DATE 2/4/16 ROUTE SR 108  
 H.C. LEU WEATHER CLOUDY COUNTY HENRY  
 R.C. FARKAS TEMP. 30° TOWNSHIP PLEASANT  
 SECTION 1  
 T 3 N R 6 E

TYPE MONUMENT MAG/WASHER  
 ON SURFACE - ~~BELOW~~ ON  
 LEFT - ☉ PAV'T - RIGHT ON  
10.5' TO RT EDGE PAVEMENT  
 S.L.M. 326+54.23  
 Grid: Northing: 582201.228 Easting: 1519859.982

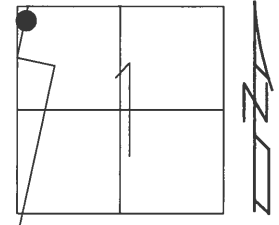

RECORD:  
 FD P.K./WASHER  
 5/1/03, MB  
 SET MAG/WASHER  
 10/31/03, MB  
 FD MAG/WASHER  
 REF12  
 2/4/16, JLL  
 SET MAG/WASHER  
 8/4/17, JLL

# O.D.O.T. DISTRICT 2 SURVEY OFFICE

PERSONNEL

REFERENCE NO. 13

SHEET 19 OF 20

NOTES BRUMBAUGH

H.C. BARNHISEL

R.C. RYALL

DRAWN: CANTERBURY

DATE 5-01-03

WEATHER SUNNY

TEMP. +70°

ROUTE S.R. # 108

COUNTY HENRY

TOWNSHIP PLEASANT

SECTION 1

T 3 N R 6 E


TYPE MONUMENT P.K. / WASHER

ON SURFACE - BELOW 1" DOWN


~~LEFT - & PAV'T. - RIGHT~~ ON &

10.5 TO RT EDGE PAVEMENT

S.L.M. 325 + 42

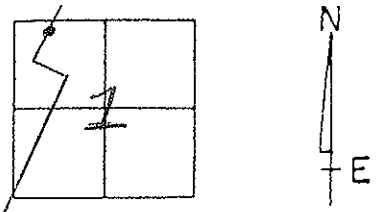

RESET MAG/WASHER  
10-31-03  
M.C.

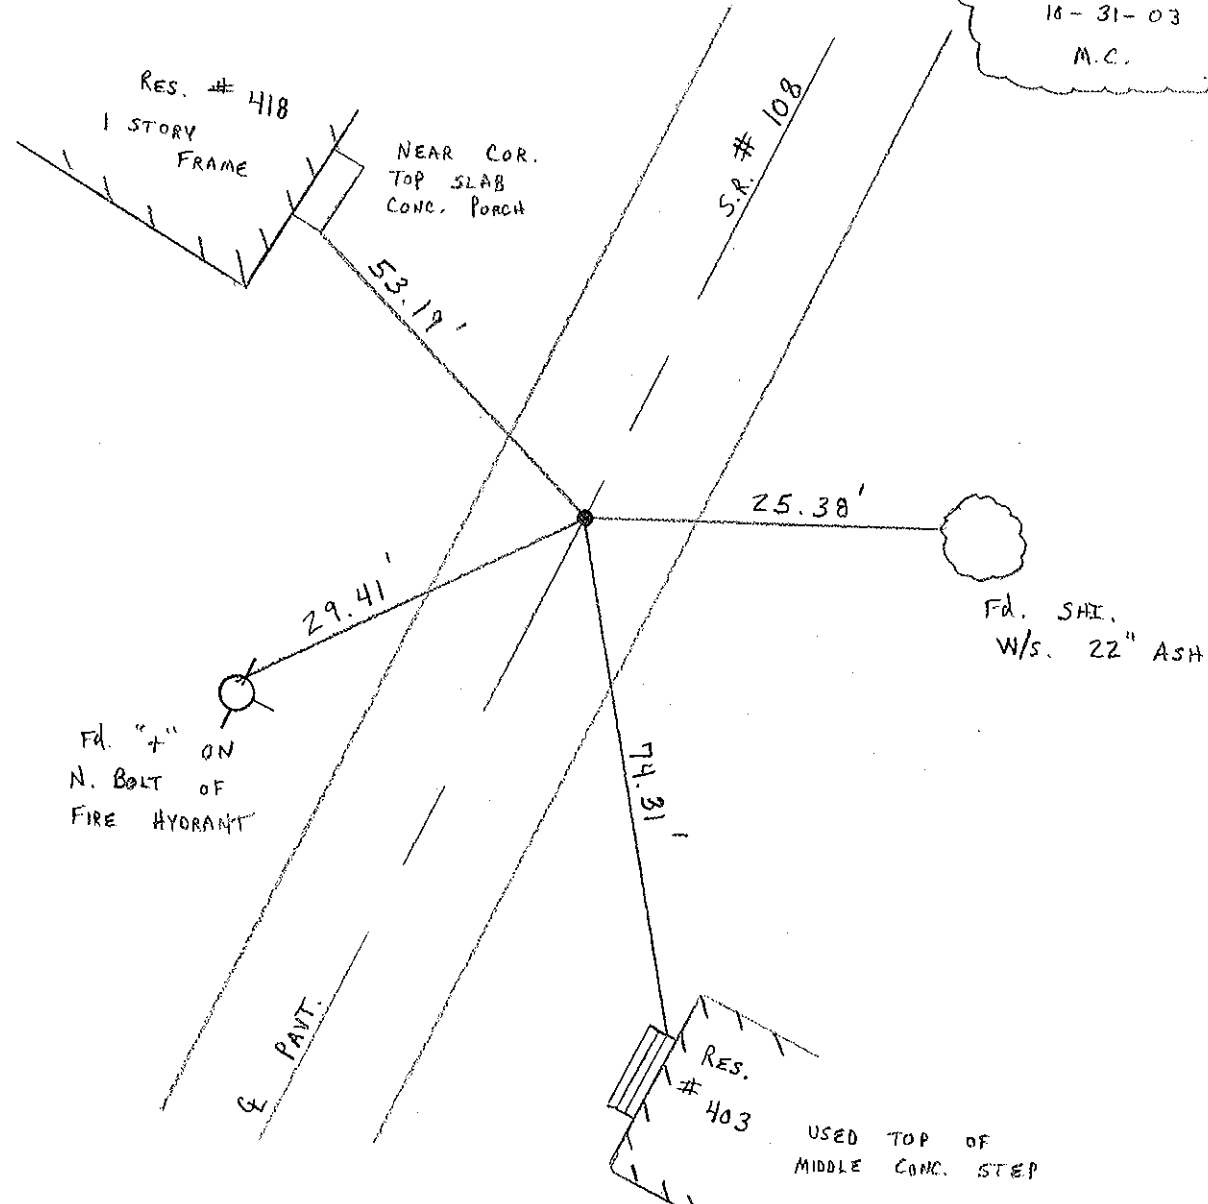

# O.D.O.T. DISTRICT 2 SURVEY OFFICE

PERSONNEL

REFERENCE NO. 13

SHEET 18 OF 54

NOTES LOEMRKE

H.C. CURTIS

DATE 8-14-92

ROUTE S.R. 108

R.C. ROMERO

WEATHER Cloudy

COUNTY HENRY

FALKOWSKI

TEMP. +70

TOWNSHIP Pleasant

SECTION 1

RESET 9-29-92

T 3 N R 6 E



TYPE MONUMENT PK & WASHER

ON SURFACE - BELOW Yes

~~LEFT~~ - & PAV'T. - ~~RIGHT~~ Yes

10.5 TO Rt EDGE PAVEMENT

S.L.M. 325+42

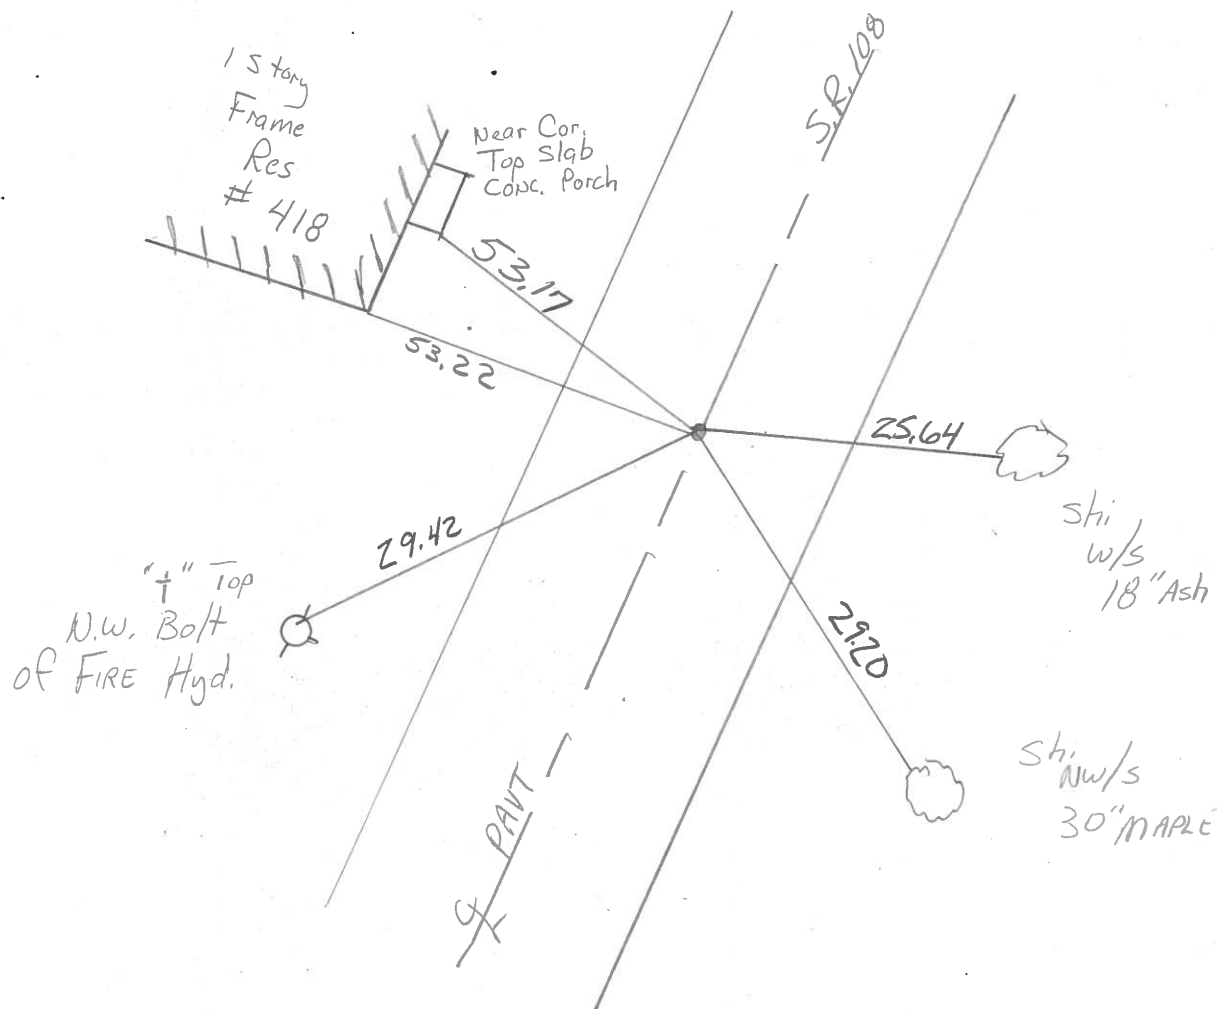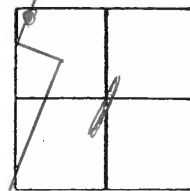

County HENRY S.R. 108

Township PLEASANT

Section 2

T3N, R6E

Personnel Hoffman

Loehke H.C.


Householder R.C.

Barnhisel Notes

Date 6-27-84

Weather PARTLY CLOUDY

Temp. +77°

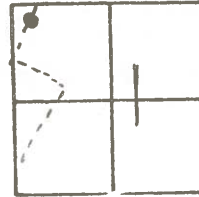

#13

SLM 326+25

FD PK @ SURFACE

E of 108


11.6 to Rt EP

10.0 to Lt EP

8-27-84


SET PK/WASHER

M.R.B.

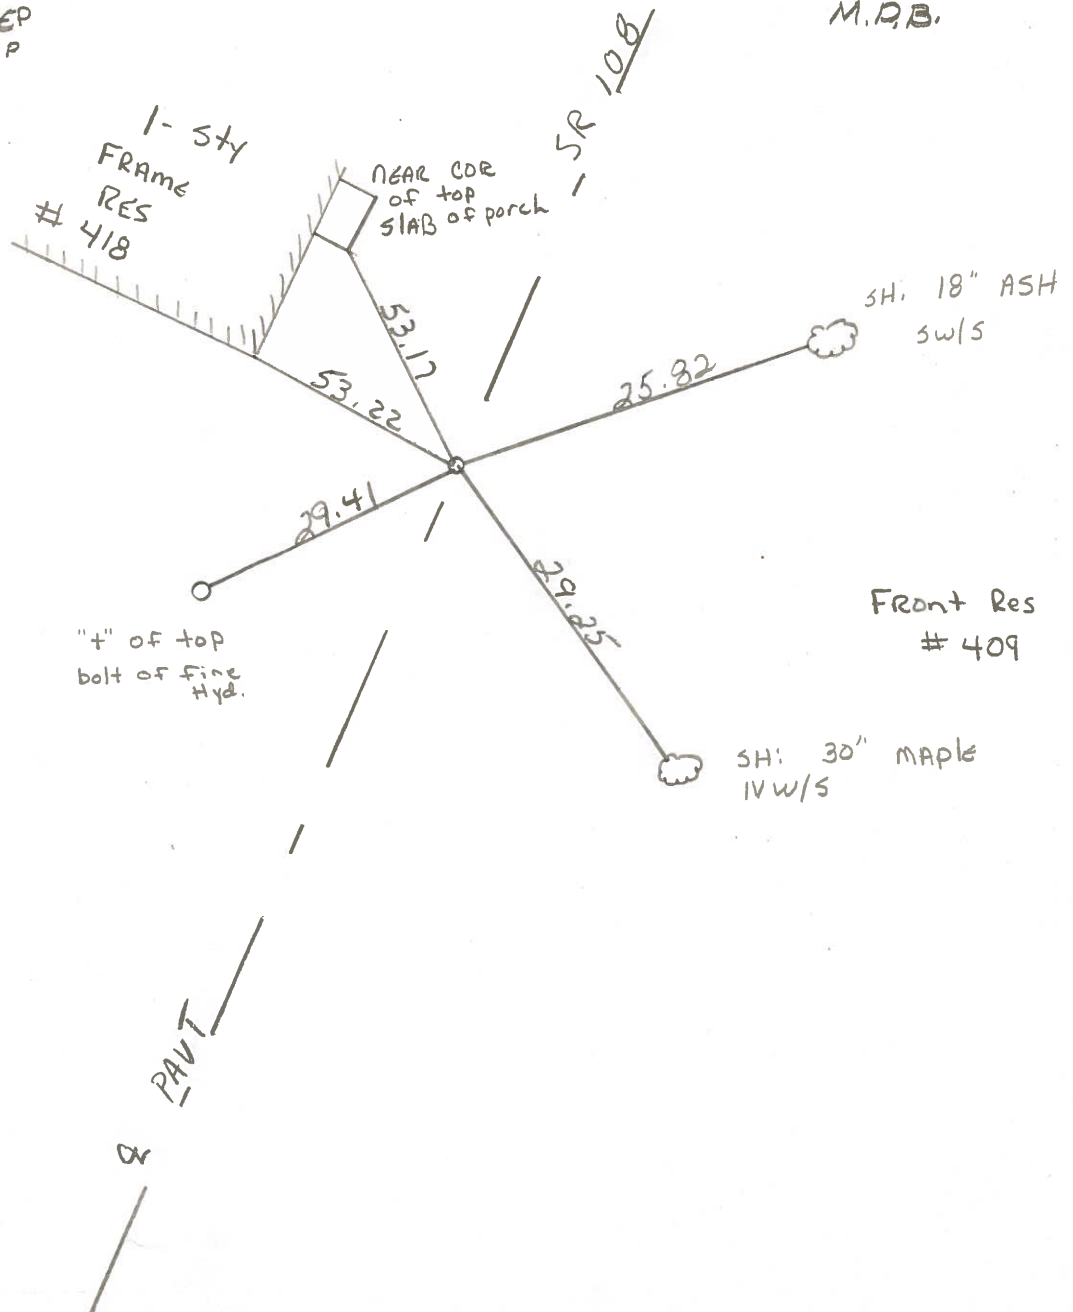

PERSONNEL	TITLE	PERSONNEL	TITLE	COUNTY	DATE
Tomsic				HENRY	July 16, 1974
Nausev				S. R. 108	WEATHER
Vandy				SEC. PLEASANT TWP.	TEMP.
Granata					

DESCRIPTION 1958 Plans Sta. LEFT CENTER LINE RIGHT JOB NO.

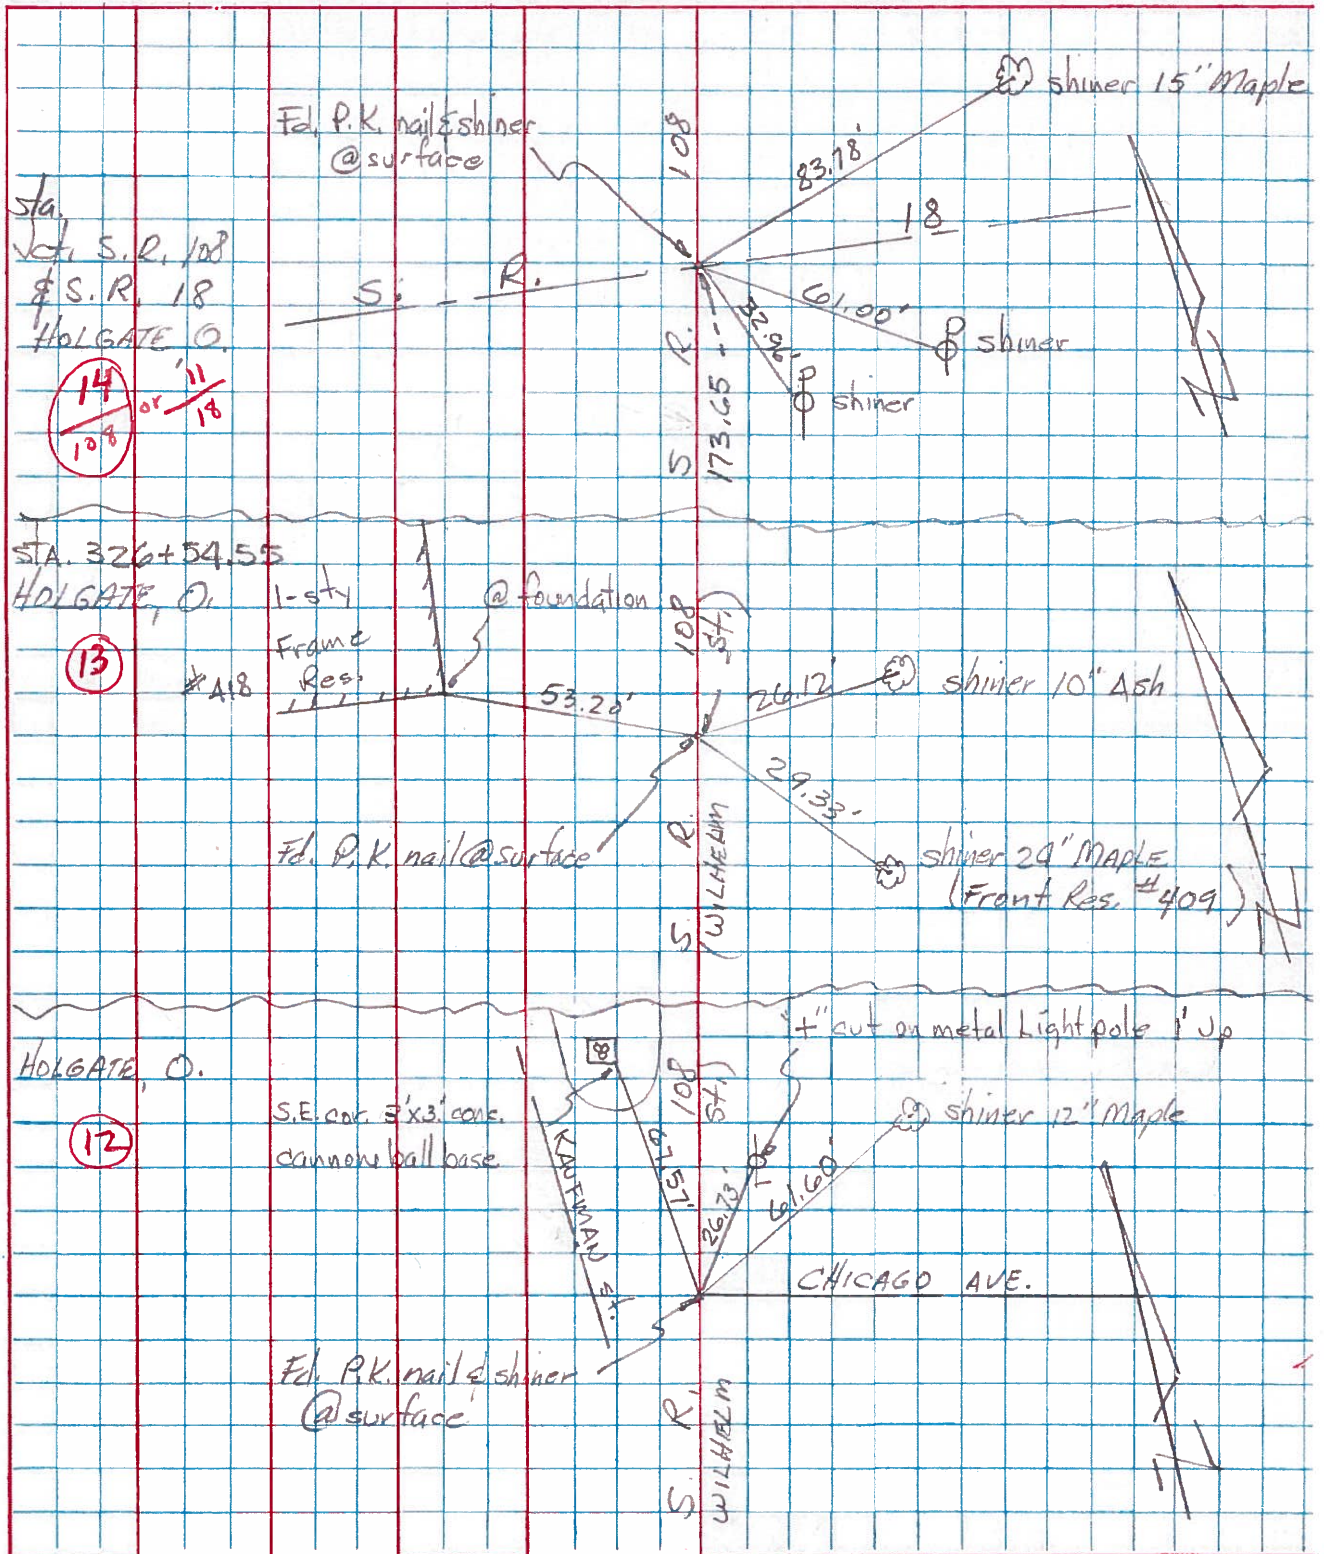


PERSONNEL	TITLE	PERSONNEL	TITLE	COUNTY	DATE	WEATHER	TEMP.
Louys				Herr	6/2/71	Cloudy Fog	70°
Friksen	Recorder			S. R. # 108			
Pav				SEC. Halgate to Co Rd L			
Shaw							

DESCRIPTION Ref R/W Plan 1958 LEFT CENTER LINE RIGHT JOB NO.

ST. 336+64.97


PI. 331+71.23  
 $\Delta = 32^\circ 25' \text{ RT}$   
 Est I. Pipe from mon.  
 5/24/71 S.H.L.

15

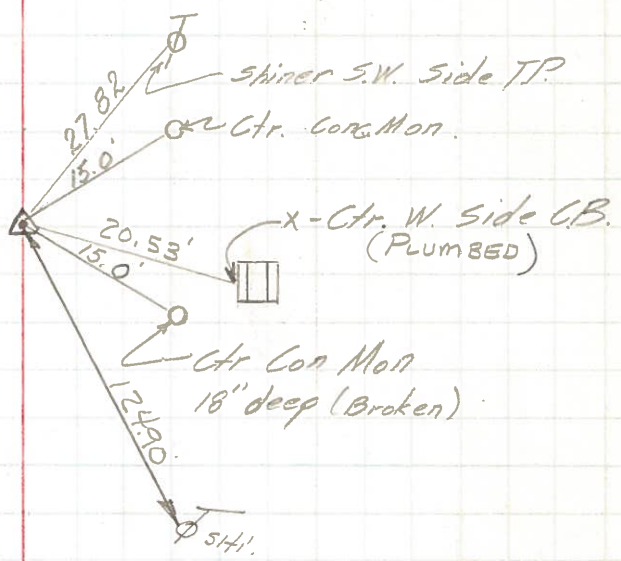

Near Side Fire Hydrant

TS. 326+54.55  
 Found Small R.R. Spk  
 5/24/71 S.H.L.

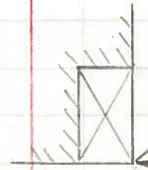

S.E. Cor Porch Found

36.00' Ctr. Mon.

N.W. Cor Gar Found

13

JK 5-4-72

JK 5-4-72