



O.D.O.T. DISTRICT 2 SURVEY OFFICE (USE ONLY)

PERSONNEL _____ REFERENCE NO. 15 SHEET 14 OF 16
 NOTES LOEHRKE DATE 8/18/92 ROUTE SR 108
 H.C. CURTIS WEATHER CLEAR COUNTY HENRY
 R.C. ROMETO TEMP. 75° TOWNSHIP FLATROCK
 _____ FALKOWSKI _____ SECTION 36
 _____ T 4 N R 6 E

TYPE MONUMENT 1" IPIPE
~~ON SURFACE~~ - BELOW 1.5'
 LEFT - CL PAV'T - ~~RIGHT~~ 61.5'
49' LT TO LT EDGE PAVEMENT
 S.L.M. 331+71.22
 Grid: Northing: 582700.186 Easting: 1519993.939

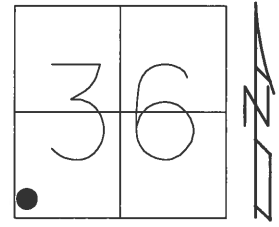

RECORD: P.I.
 $\Delta = 32^\circ 26' 19''$
 FD 1" IPIPE
 1 1/2' DOWN
 6/27/84, CL
 D.N.F. IPIPE
 2/17/16, JLL
 CALC3
 2/26/16, DCH

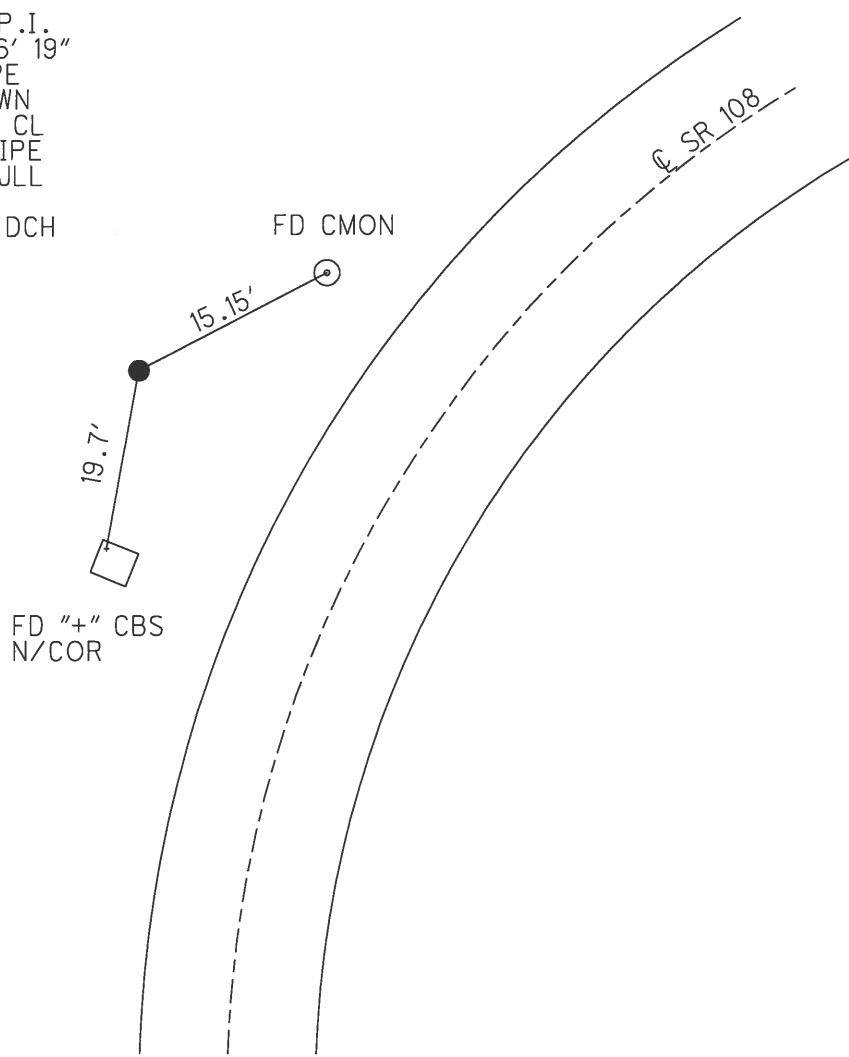

O.D.O.T. DISTRICT 2 SURVEY OFFICE

PERSONNEL

REFERENCE NO. 15

SHEET 20 OF 54

NOTES LOEHRKE

H.C. CURTIS

DATE 8-18-92

ROUTE S.R. 108

R.C. ROMEO

WEATHER CLEAR

COUNTY HENRY

FALKOWSKI

TEMP. +75

TOWNSHIP FLAT ROCK

SECTION 36

T 4 N R 6 E


TYPE MONUMENT 1" IRON PIPE

ON SURFACE - BELOW 1 1/2 feet


LEFT - 61.5 PAV'T. - RIGHT

49 1/4 ~~TO~~ PL EDGE PAVEMENT

S.L.M. 330+55

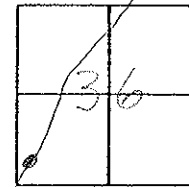

P.I.

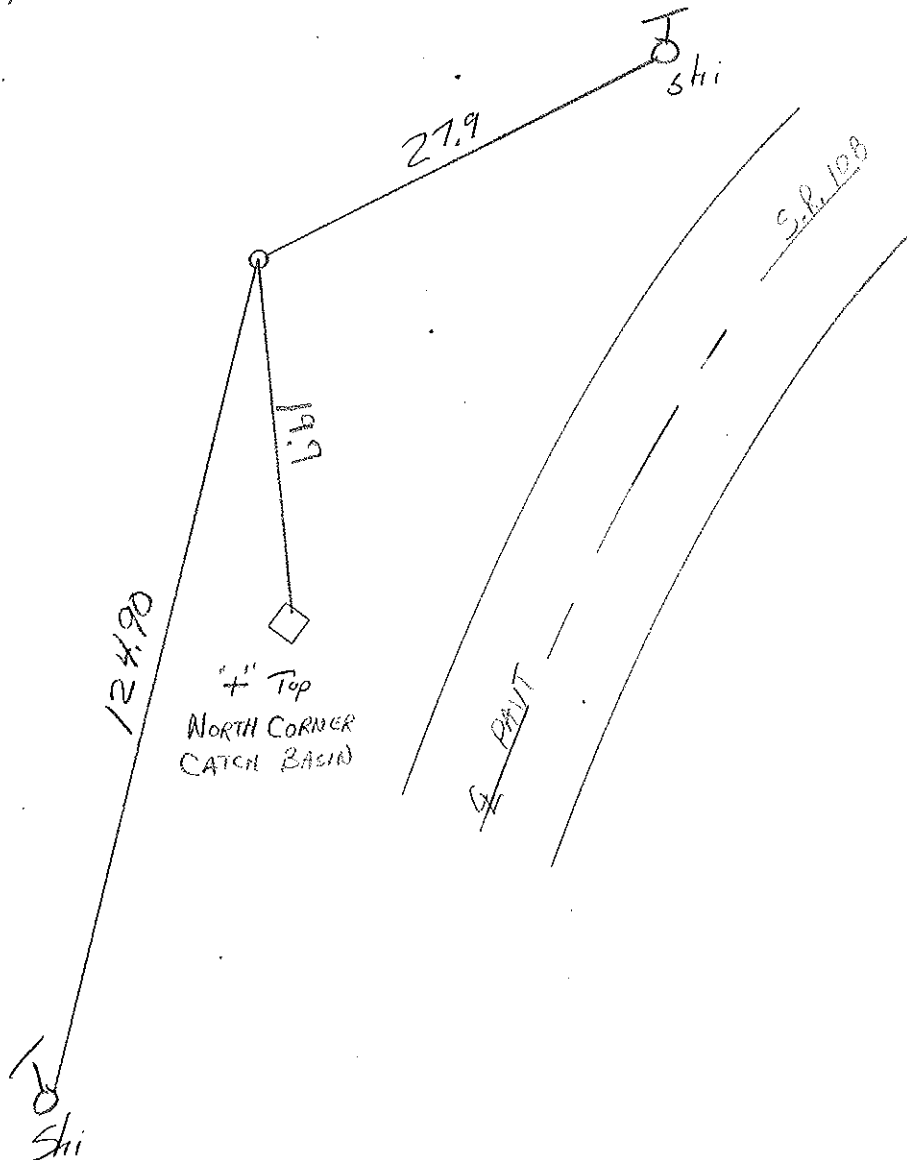

County HENRY S.R. 10B

Township FLAT ROCK

Section 36

T4N, R6E

Personnel Hoffman

Loehrke


Householder

Barnhisel

Date 6-27-84

Weather PARTLY CLOUDY

Temp. +77°

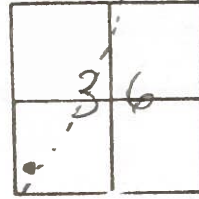

15


PT 15

P.I.

SLM 331+29


FD 1" IRON PIPE

1 1/2 ft Down

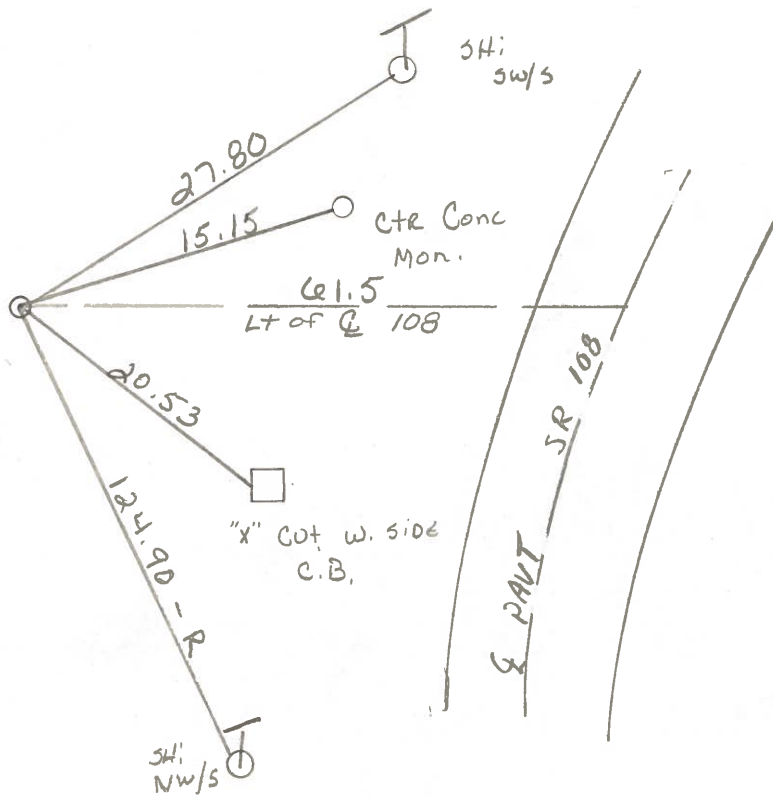


PERSONNEL	TITLE	PERSONNEL	TITLE	COUNTY	DATE	WEATHER	TEMP.
Tomsic				HENRY	July 22, 1974		
Neuser							
Vanyo				S. R. 108			
Granata				SEC. Flatrock Twp			

DESCRIPTION _____ LEFT _____ CENTER LINE _____ RIGHT _____ JOB NO. _____

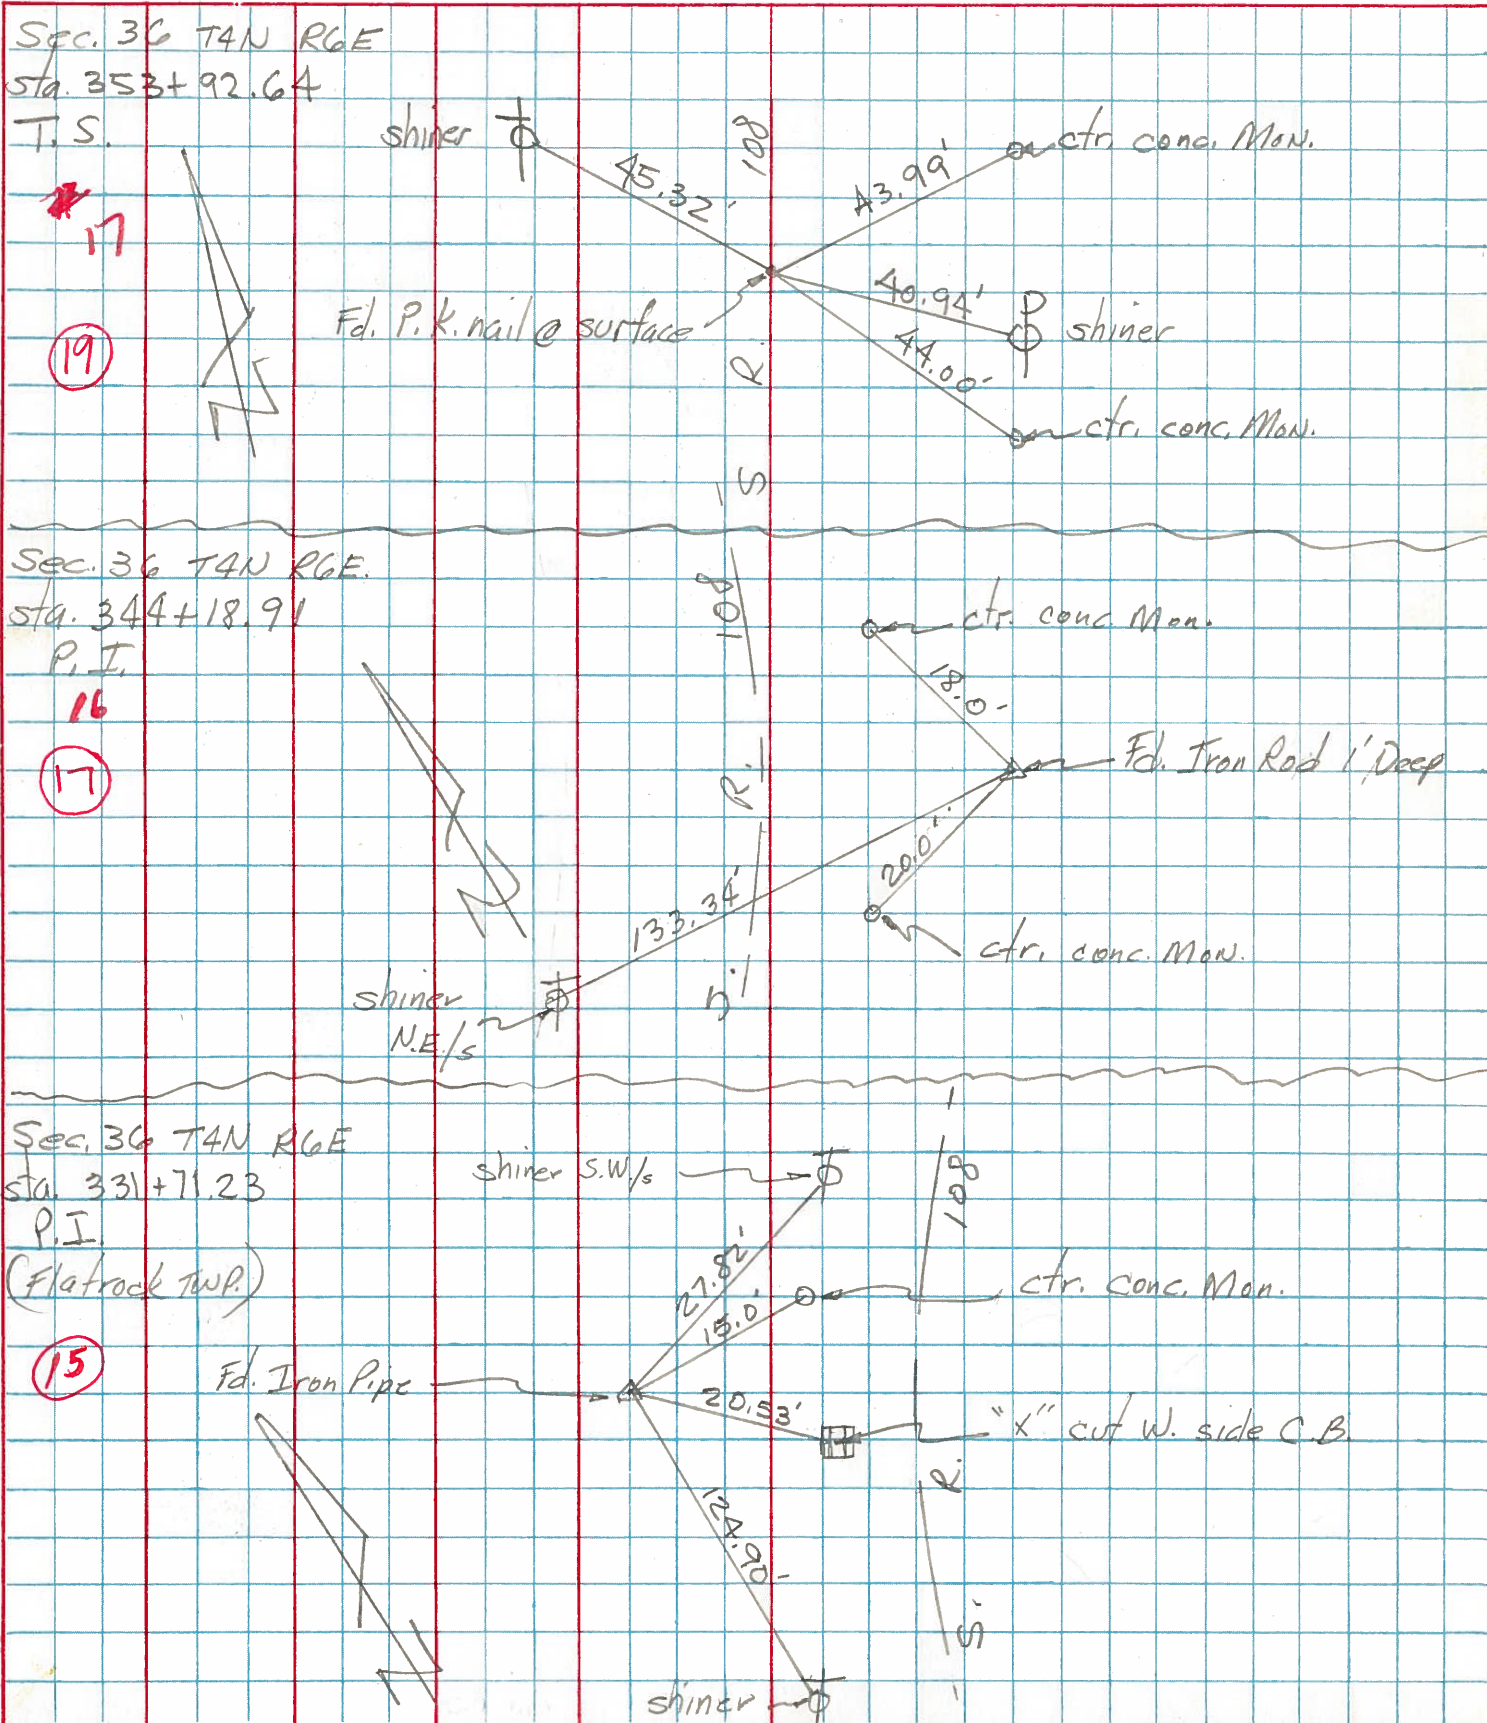

PERSONNEL	TITLE	PERSONNEL	TITLE	COUNTY	DATE
Louns				Henn	6/2/71
Fritzen	Recorder			S. R. # 108	WEATHER Cloudy Fog
Pan				SEC. Halgate to Co Rd L	TEMP. 70°
Shaw					

DESCRIPTION Rel. Plan Plan 1958 JOB NO. _____

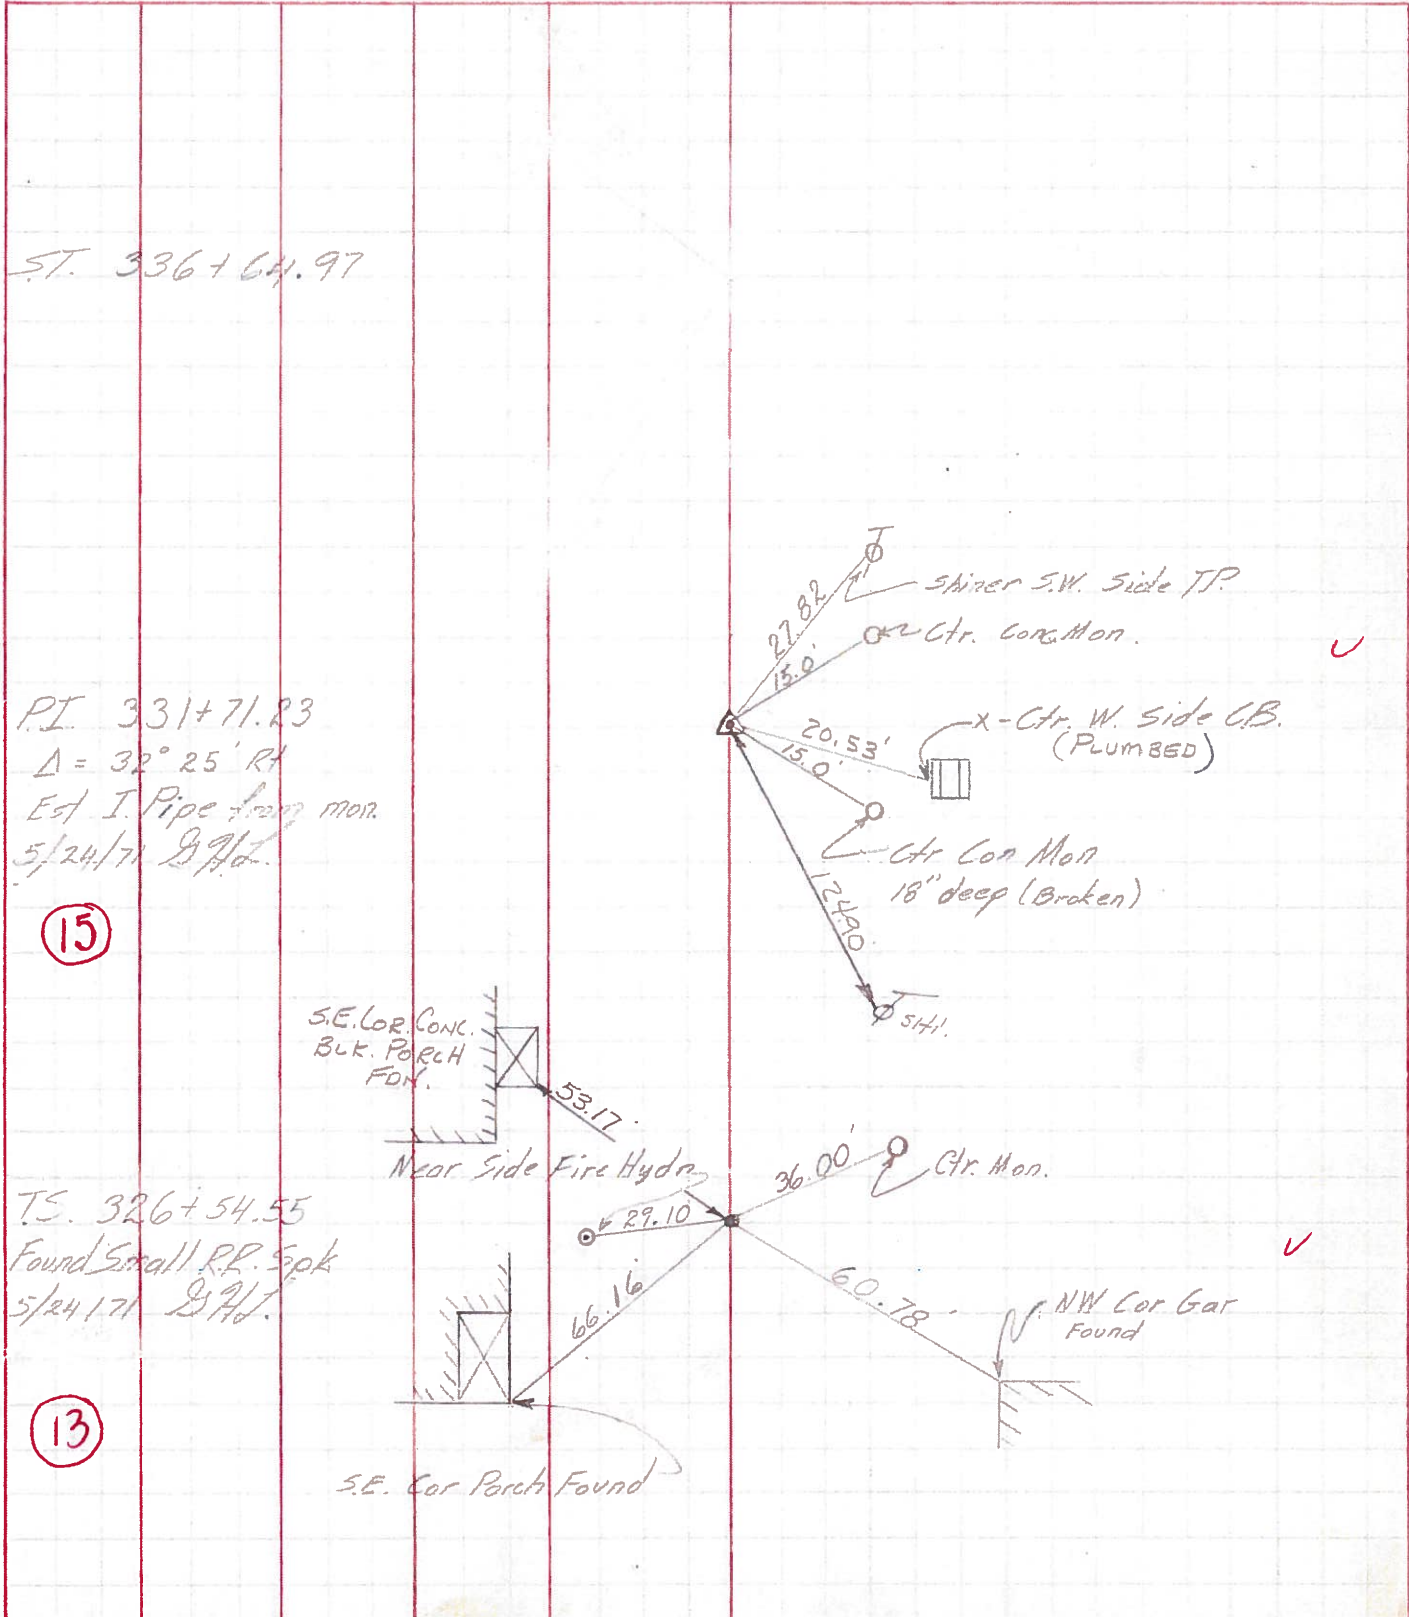

JK 5-4-72

JK 5-4-72