

O.D.O.T. DISTRICT 2 SURVEY OFFICE (USE ONLY)

PERSONNEL

REFERENCE NO. 16

SHEET 1 OF 48

NOTES ELKHECHEN

DATE 10/25/18

ROUTE SR 108

H.C. LEU

WEATHER CLEAR

COUNTY HENRY

R.C. MILLER

TEMP. 35°

TOWNSHIP FLATROCK

RHOADES

SECTION 36

DWG BY MILLER PID 94319

T 4 N R 6 E

TYPE MONUMENT P.K.SHANK

~~ON SURFACE~~ - BELOW 3"

OFFSET \odot PAVEMENT 0.3' ~~LT~~ : RT

12.2' TO RT EDGE PAVEMENT


STATION: 337+92.85

HORZ.DATUM: NAD83 (2011)


GEOID: 2012A

GRID: NORTHING: 583136.067

EASTING: 1520469.571

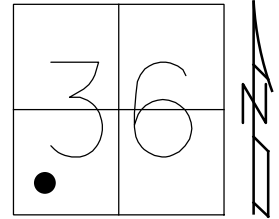


RECORD:
 FD P.K./WASHER
 8/18/92, CL
 SET P.K./WASHER
 9-29-92, CL
 FD P.K.SHANK
 3" DOWN
 REF16
 10-25-18, JLL
 SET MAG/WASHER
 10-20-20, DSA

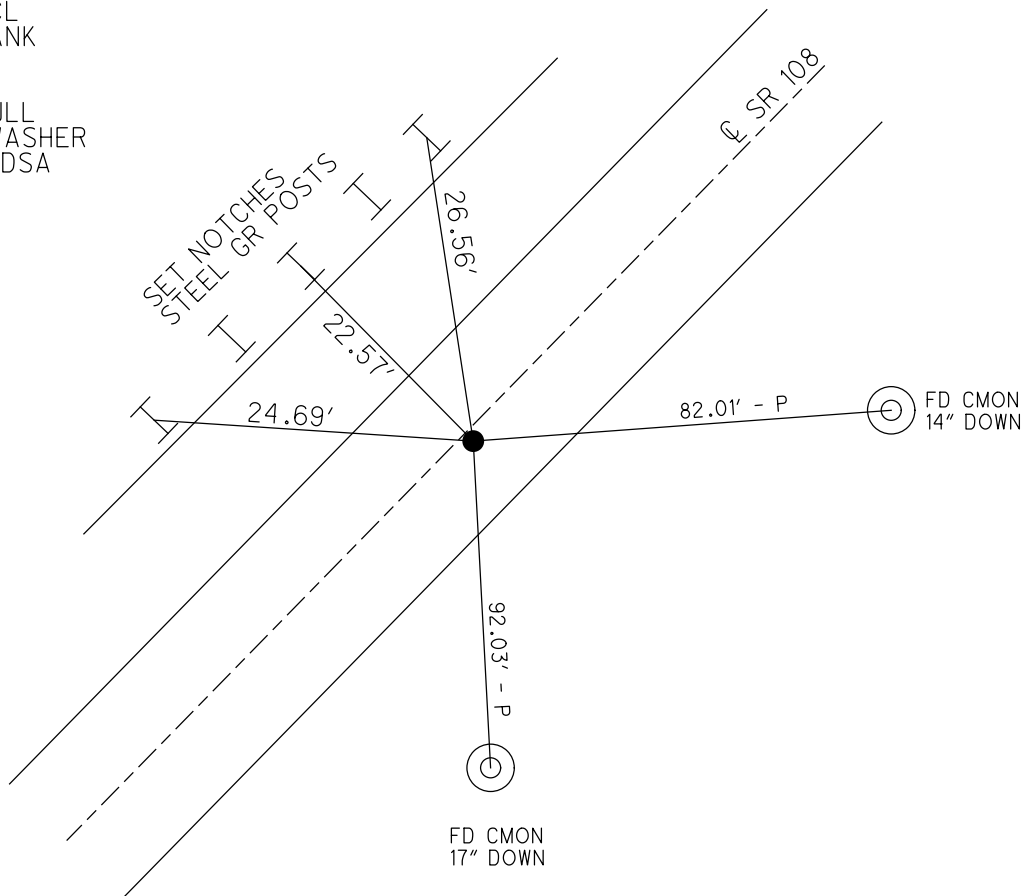


O.D.O.T. DISTRICT 2 SURVEY OFFICE (USE ONLY)

PERSONNEL _____ REFERENCE NO. 16 SHEET 14 OF 16
 NOTES LOEHRKE DATE 8/18/92 ROUTE SR 108
 H.C. CURTIS WEATHER PTLY CLOUDY COUNTY HENRY
 R.C. ROMETO TEMP. 75° TOWNSHIP FLATROCK
 _____ FALKOWSKI _____ SECTION 36
 _____ T 4 N R 6 E

TYPE MONUMENT P.K./WASHER
 ON SURFACE - ~~BELOW~~ ON _____
~~LEFT~~ - CL PAV'T - RIGHT 0.3'
12.2' TO RT EDGE PAVEMENT
 S.L.M. 336+65.19
 Grid: Northing: - _____ Easting: - _____

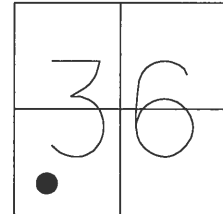

RECORD:
 SET P.K./WASHER
 9/29/92, CL
 D.N.F. P.K./WASHER
 4/26/17, JLL

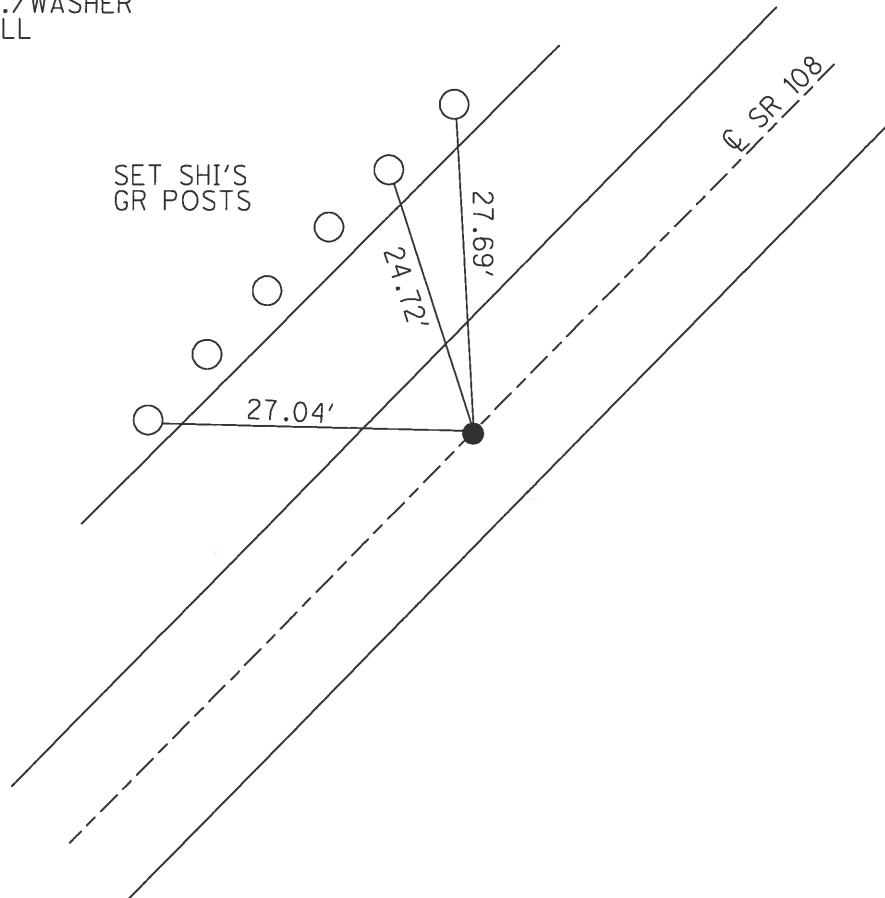

O.D.O.T. DISTRICT 2 SURVEY OFFICE

PERSONNEL

REFERENCE NO. 16

SHEET 21 OF 54

NOTES LOEHARKE

H.C. CURTIS

DATE 8-18-92

ROUTE S.R. 108

R.C. ROMETO

WEATHER Pt Cloudy

COUNTY HENRY

FALKOWSKI

TEMP. 47.5

TOWNSHIP FLAT Rock

SECTION 36

T 4 N R 6 E

RESET 9-29-92



TYPE MONUMENT P.K. / WASHER

ON SURFACE - BELOW Yes

LEFT - C. PAV'T. - RIGHT 0.3

1/2 TO Rt. EDGE PAVEMENT

S.L.M. 336 + 88

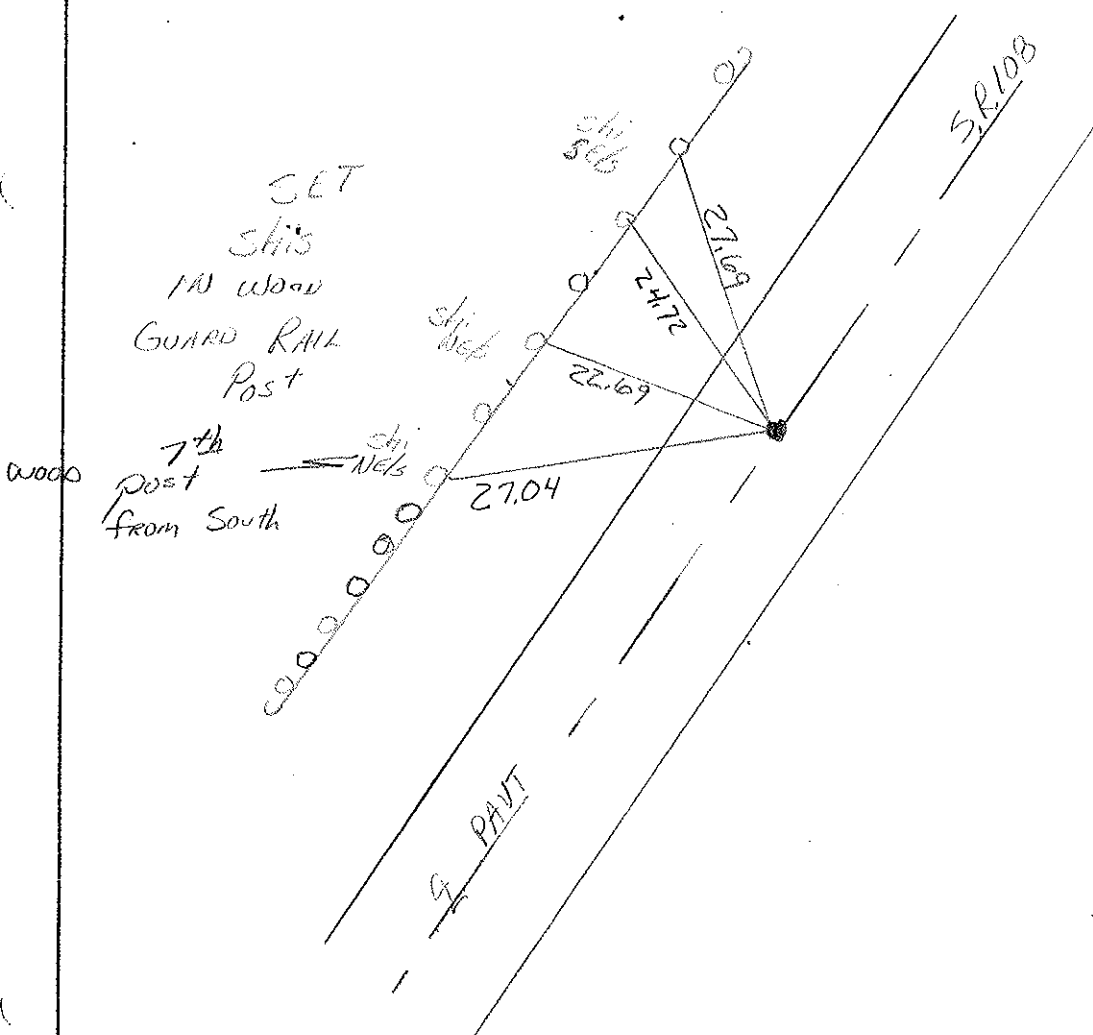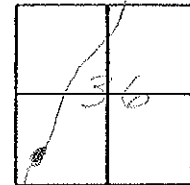

County HENRY S.R. 108

Township FLATROCK

Section 36

T4N, R6E

Personnel Hoffman

Loehrke H.C.


Householder R.C.

Barnhiser Notes

Date 6-27-84

Weather Partly Cloudy

Temp. +77°

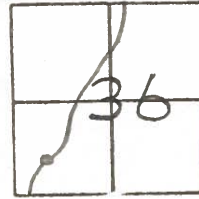

#16

SLM 337+93

FD PK @ SURFACE

ON E OF 108


11.5 Lt of EP

11.5 Rt of EP


8-27-84

SET PK/WASHER

M.D.B.

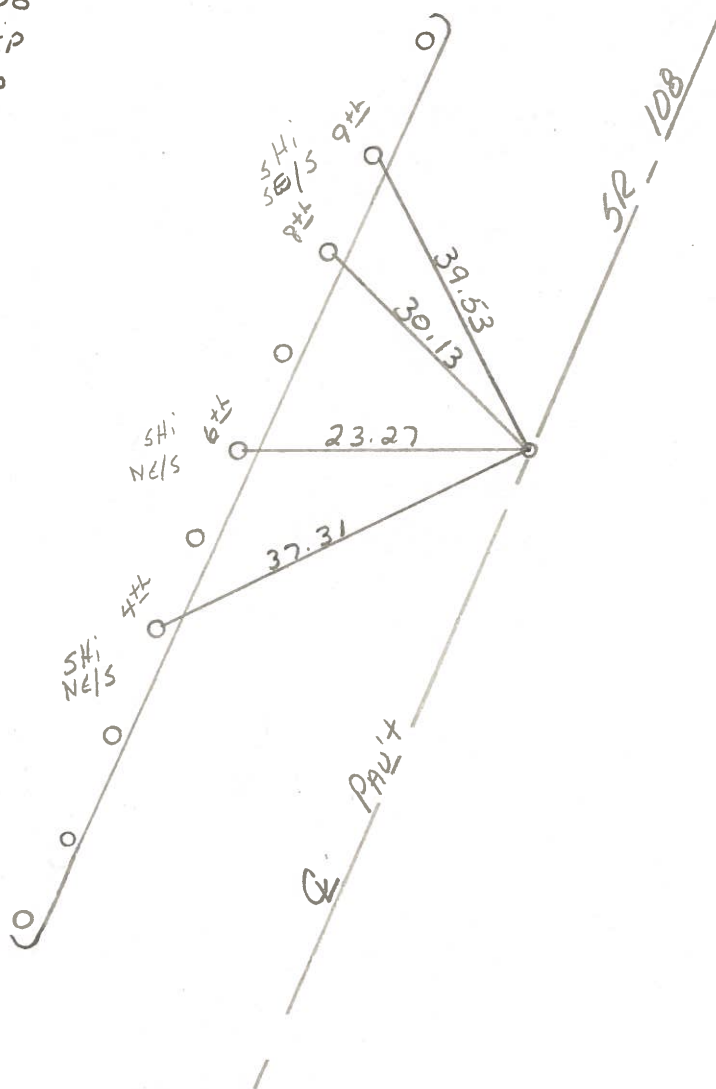


PERSONNEL TITLE PERSONNEL TITLE COUNTY HENRY DATE July 16, 1974
 Tomsic _____
 Meuser _____
 Vanyo _____
 Granata _____
 S. R. 108 WEATHER _____
 SEC. Flatrock TWP. TEMP. _____
 DESCRIPTION 1958 R/W PLANS sta. JOB NO. _____

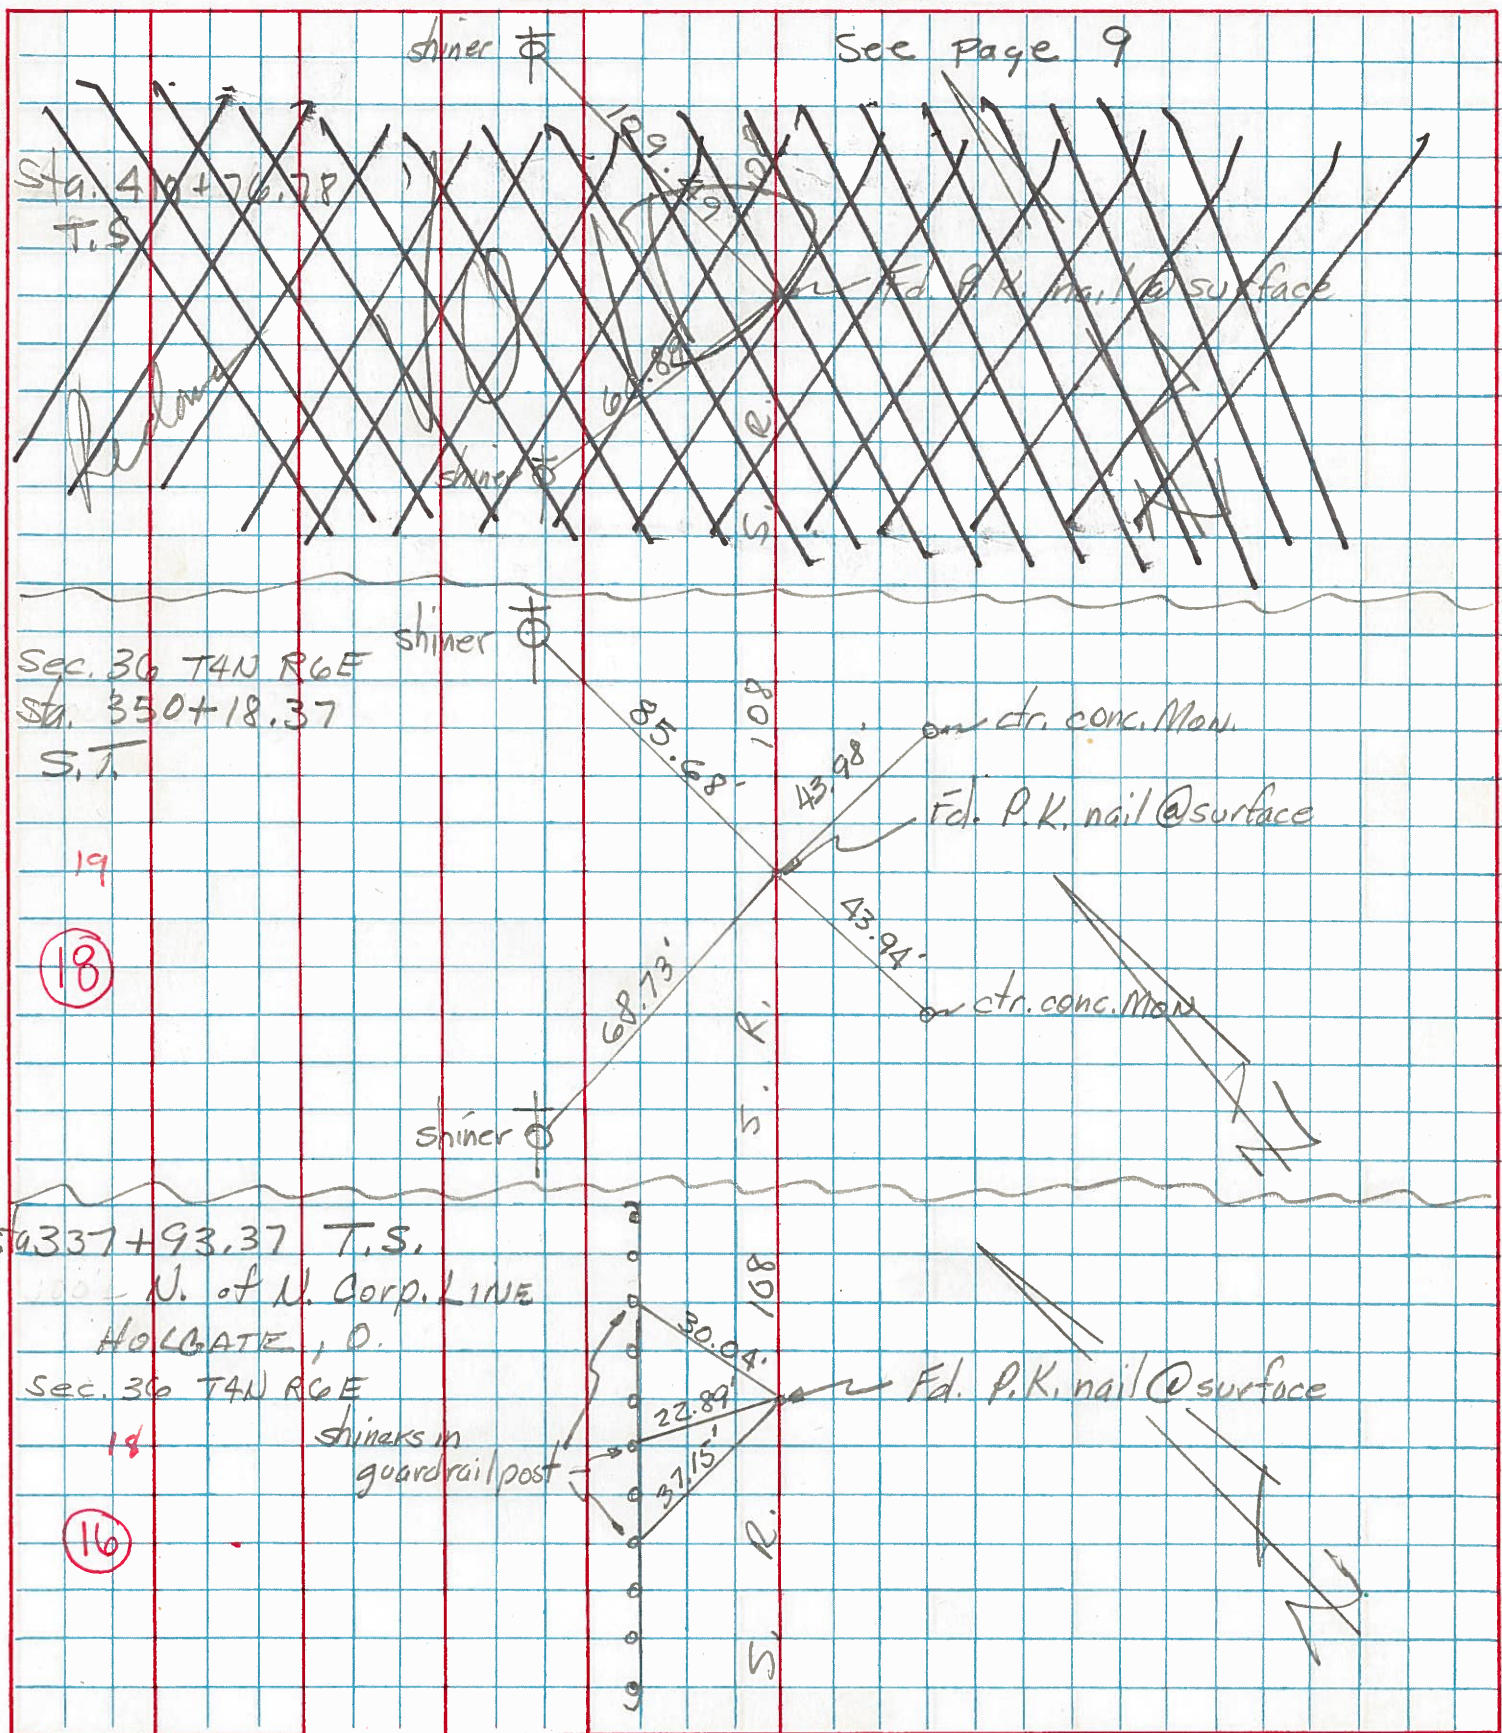

PERSONNEL TITLE PERSONNEL TITLE
 Lovys _____
 Eriksen Recorder _____
 Row _____
 Shaw _____

COUNTY Hert DATE 6/2/71
 S. R. # 108 WEATHER Cloud Fog Rain
 SEC. Holgate to Co Rd L TEMP. 70°

DESCRIPTION Ref R/W Plan 1959 Ties JOB NO. _____

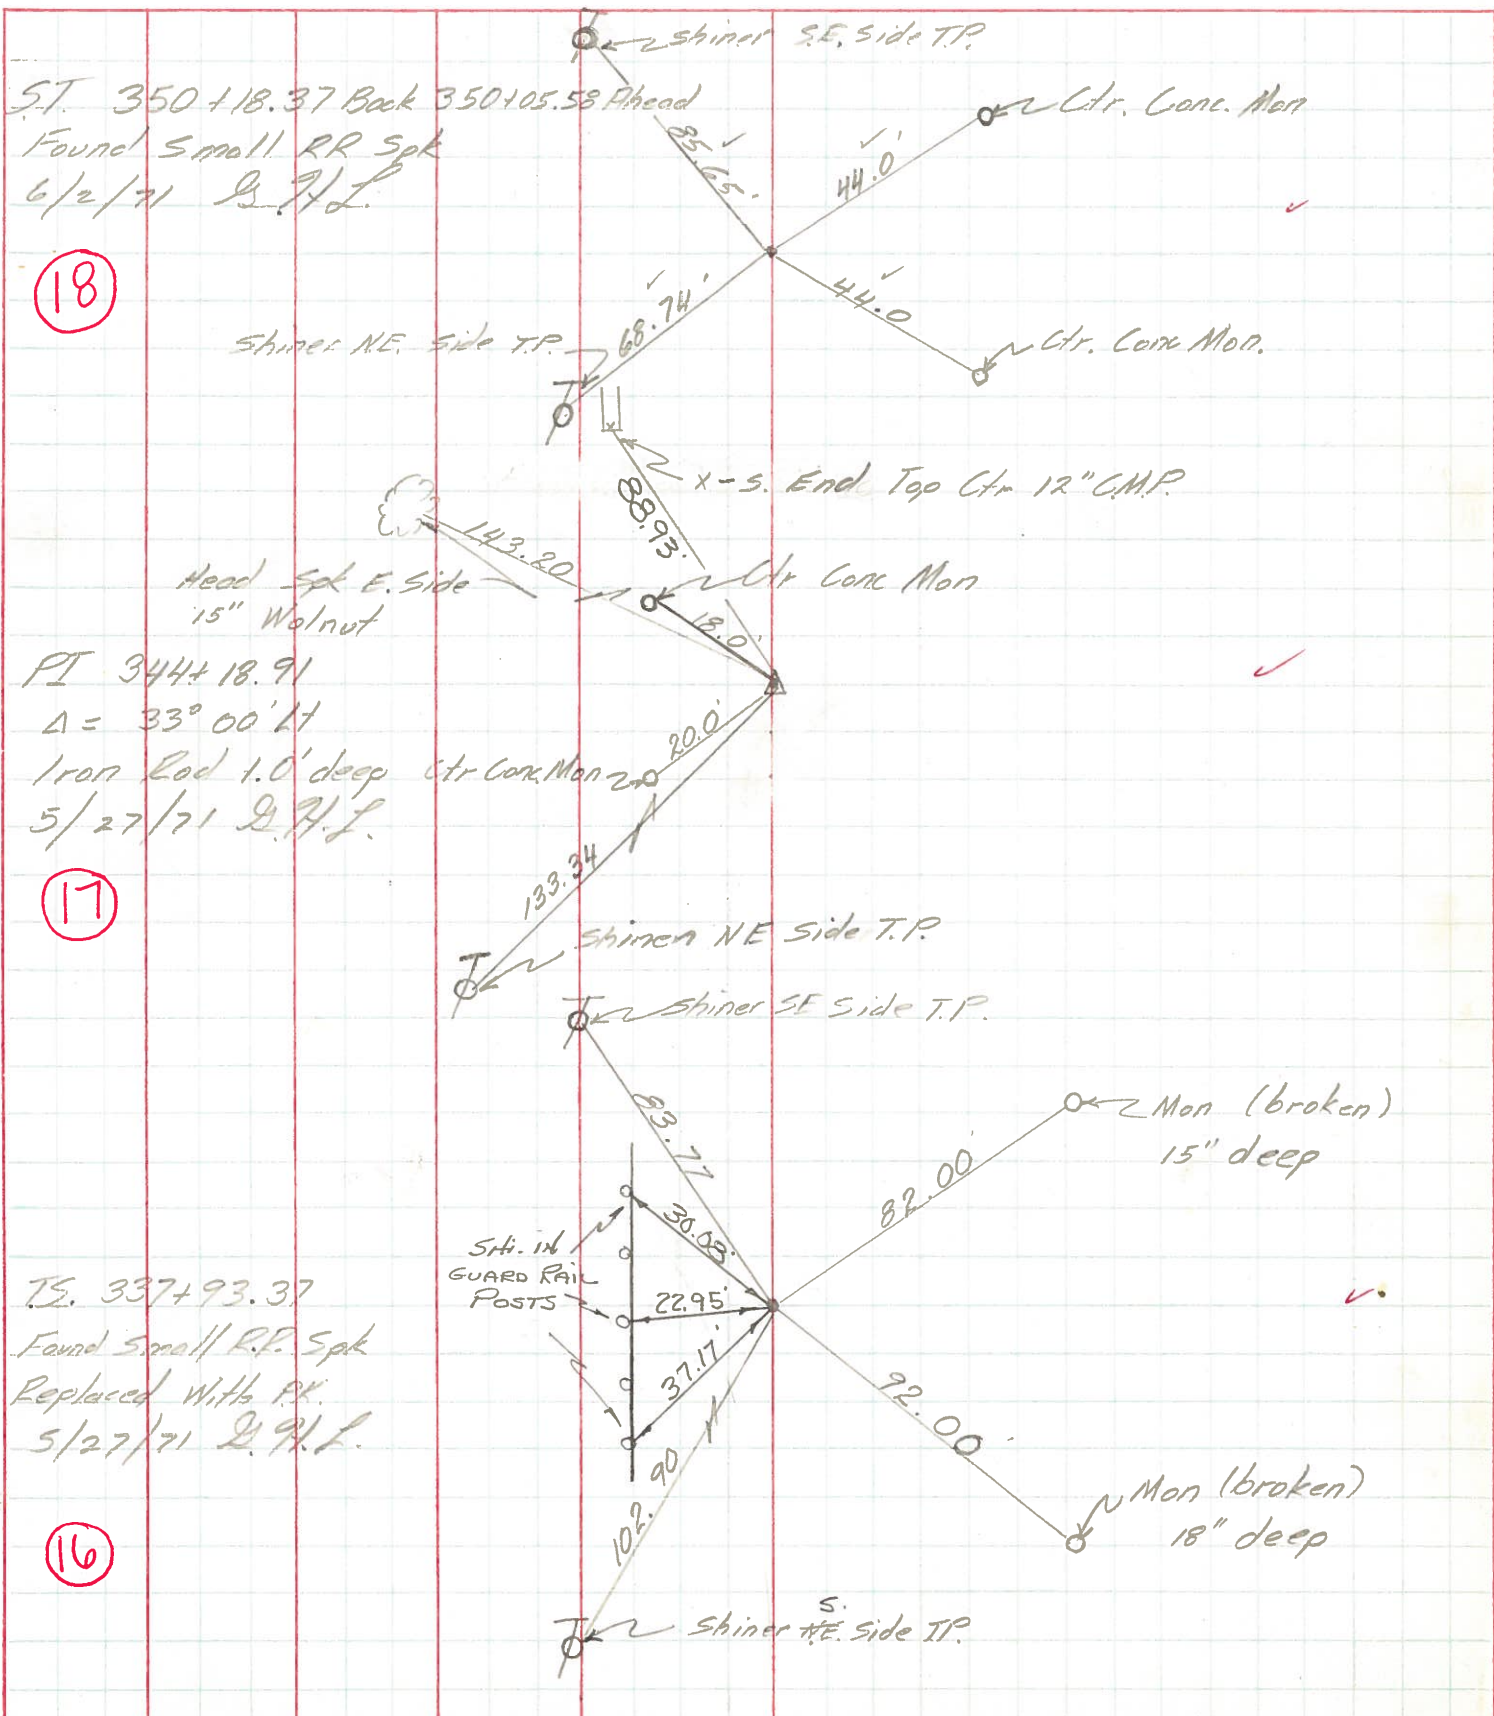

JK 5-4-72

JK 5-4-72

JK 5-4-72

18

17

16