


O.D.O.T. DISTRICT 2 SURVEY OFFICE (USE ONLY)


PERSONNEL _____ REFERENCE NO. 18 SHEET 3 OF 48
 NOTES LEU DATE 3/09/20 ROUTE SR 108
 H.C. LEU WEATHER CLOUDY/WINDY COUNTY HENRY
 R.C. BALBAUGH TEMP. 60° TOWNSHIP FLATROCK
 DWG BY BALBAUGH PID 94319 SECTION 36
 T 4 N R 6 E

TYPE MONUMENT P.K. NAIL
~~ON SURFACE~~ - BELOW 3"
 OFFSET 0.9' PAVEMENT LT : RT
11.9' TO LT EDGE PAVEMENT
 STATION: 350+18.32

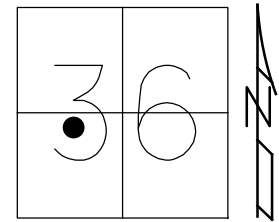

HORIZ.DATUM: NAD83 (2011) GEOID: 2012A
 GRID: NORTHING: 584163.878 EASTING: 1521087.060

RECORD: S.T.
 STA 350+18.37
 FD P.K./WASHER
 8/18/92, CL
 SET P.K./WASHER
 9-29-92
 FD P.K.NAIL
 3" DOWN
 REF18
 10-25-18, JLL
 SET MAG/WASHER
 10-20-20, DSA

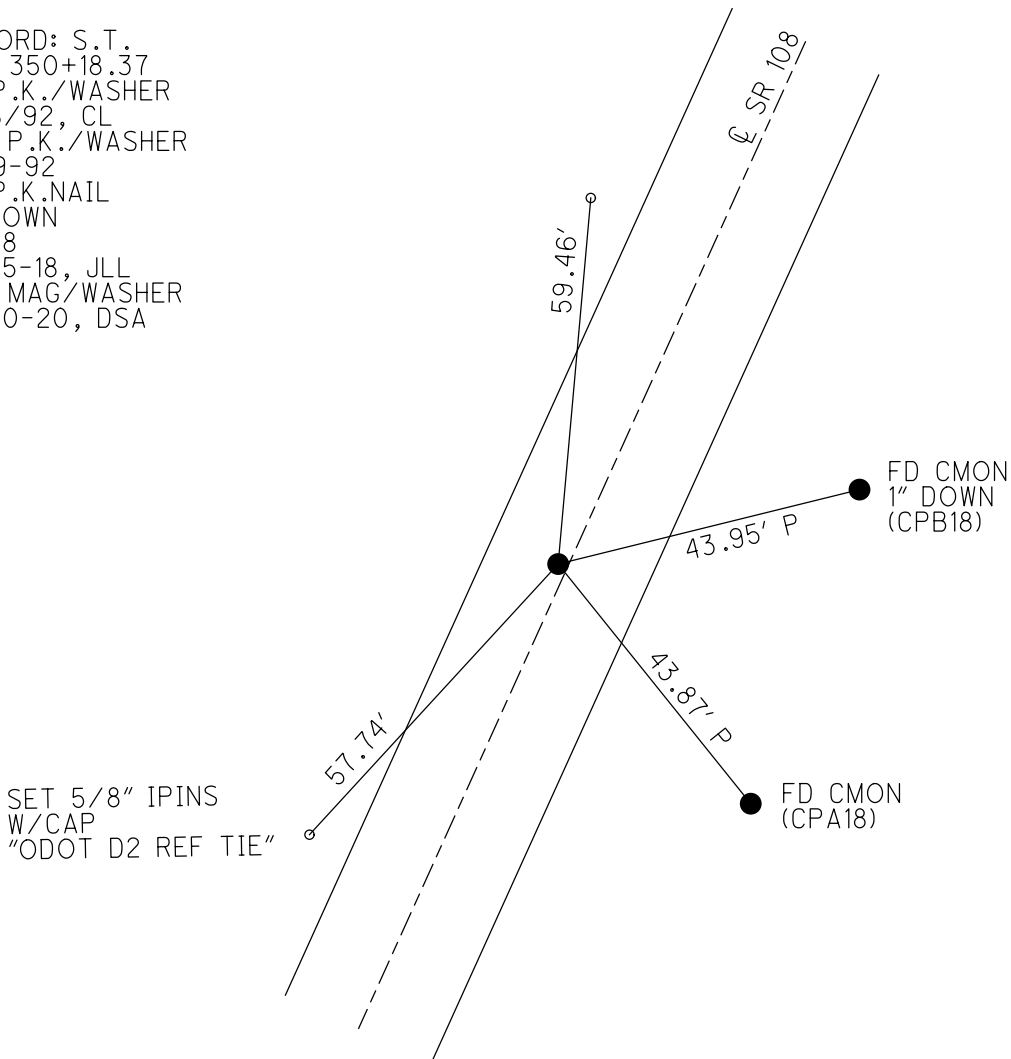

O.D.O.T. DISTRICT 2 SURVEY OFFICE

PERSONNEL

REFERENCE NO. 18

SHEET 23 OF 54

NOTES LOEHARKE

H.C. CURTIS

R.C. FALKOWSKI

ROMETO

DATE 8-18-92

WEATHER PT CLOUDY

TEMP. +75

ROUTE S.R. 108

COUNTY HENRY

TOWNSHIP FLAT ROCK

SECTION 36

T 4 N R 6 E

RESET 9-29-92


TYPE MONUMENT P.K. / WASHER

ON SURFACE - BELOW Yes


LEFT - 0 PAV'T. - RIGHT 0.9'

11.9 TO 4 1/2 EDGE PAVEMENT

S.L.M. 349 + 12

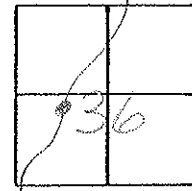

RECORD
 S.T.
 Sta 350+19.37

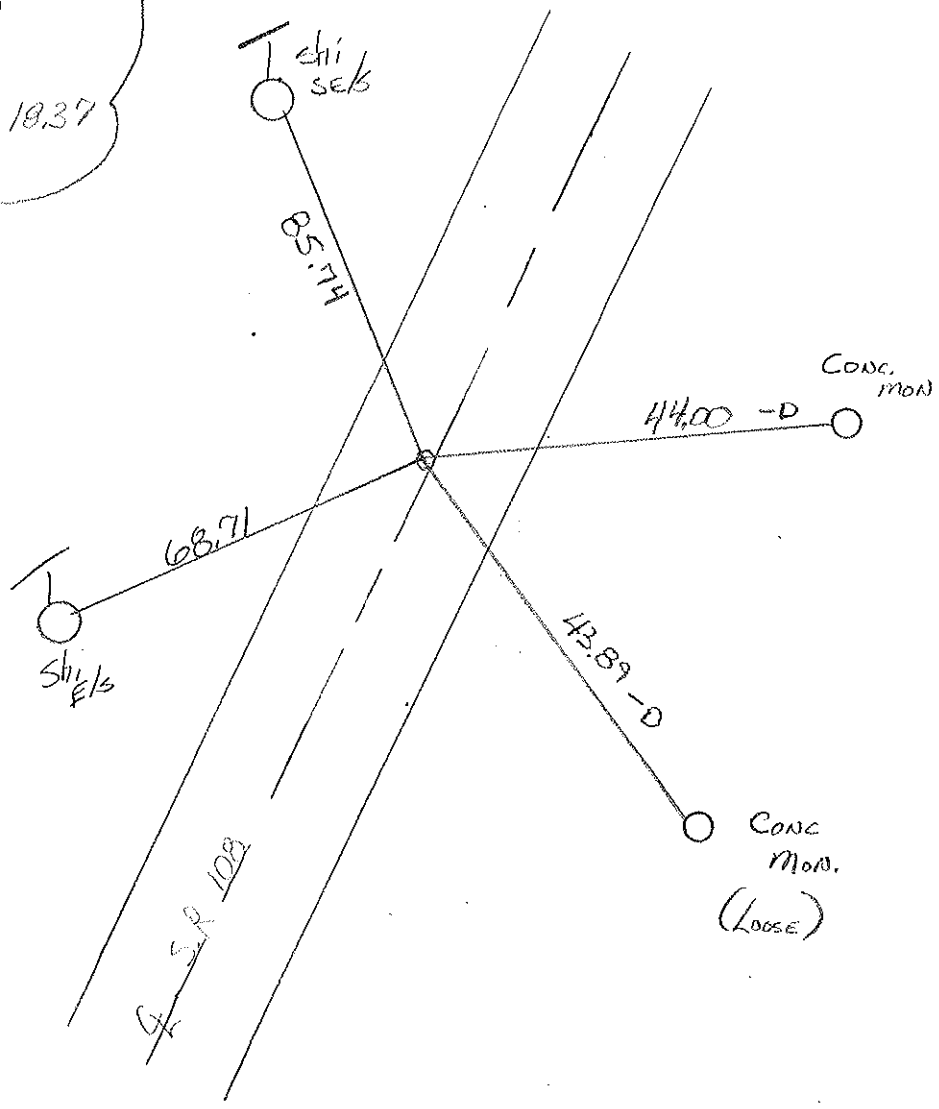

County HERny S.R. 108

Township FLATROCK

Section 36

T4N, R6E

Personnel Hoffman

Loehrke H.C.

Householder R.C.


Bernhisel Notes

#18

Date 6-27-84

Weather Partly Cloudy

Temp. +77°

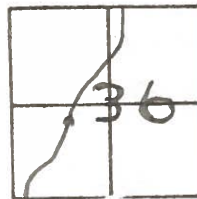

SLM 349+88

FD PK ED SURFACE

on E of 108

11.7 Lt EP


12.0 Rt EP

8-27-84

SET PK/WASHER


M.P.B.

Recorded
Sta. 350+18.37
S.T.

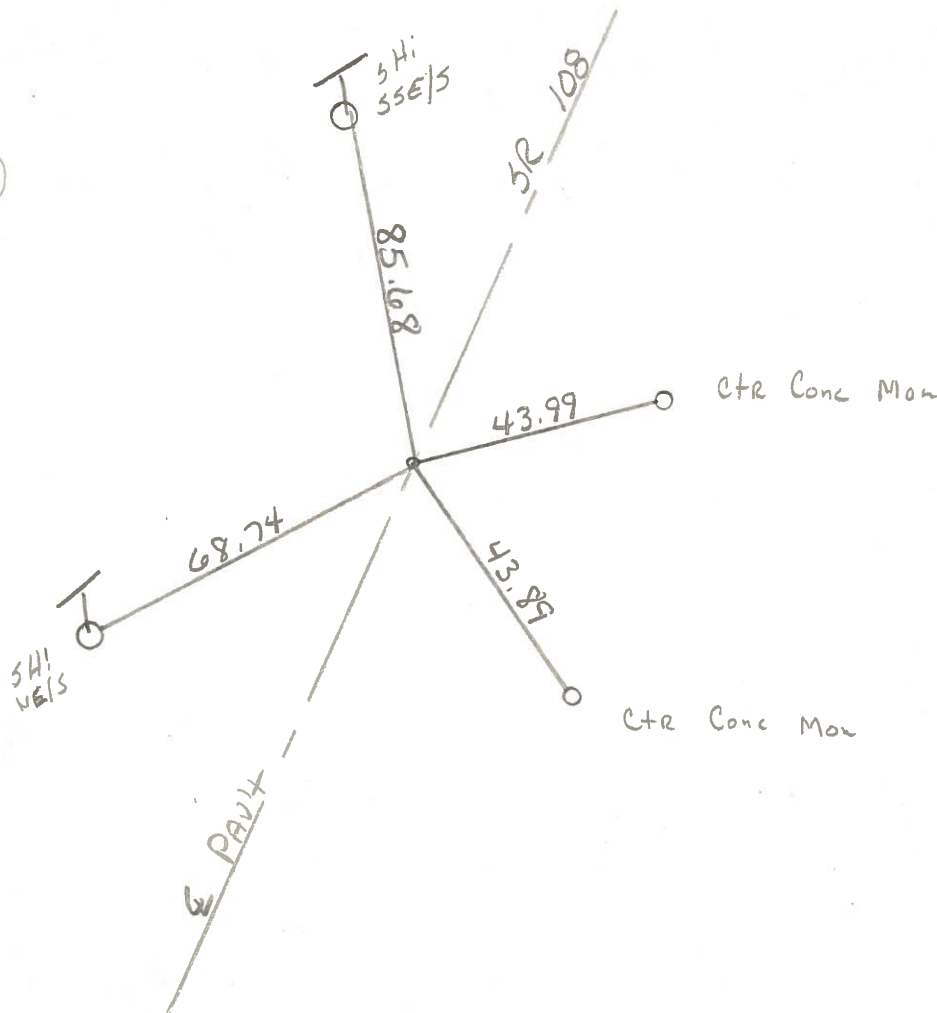


PERSONNEL	TITLE	PERSONNEL	TITLE	COUNTY	DATE
Tomsic				HENRY	July 16, 1974
Musser				S. R. 108	WEATHER
Janyo				SEC. Flatrock TWP.	TEMP.
Granata					

DESCRIPTION: 1958 R/w PLANS sta.

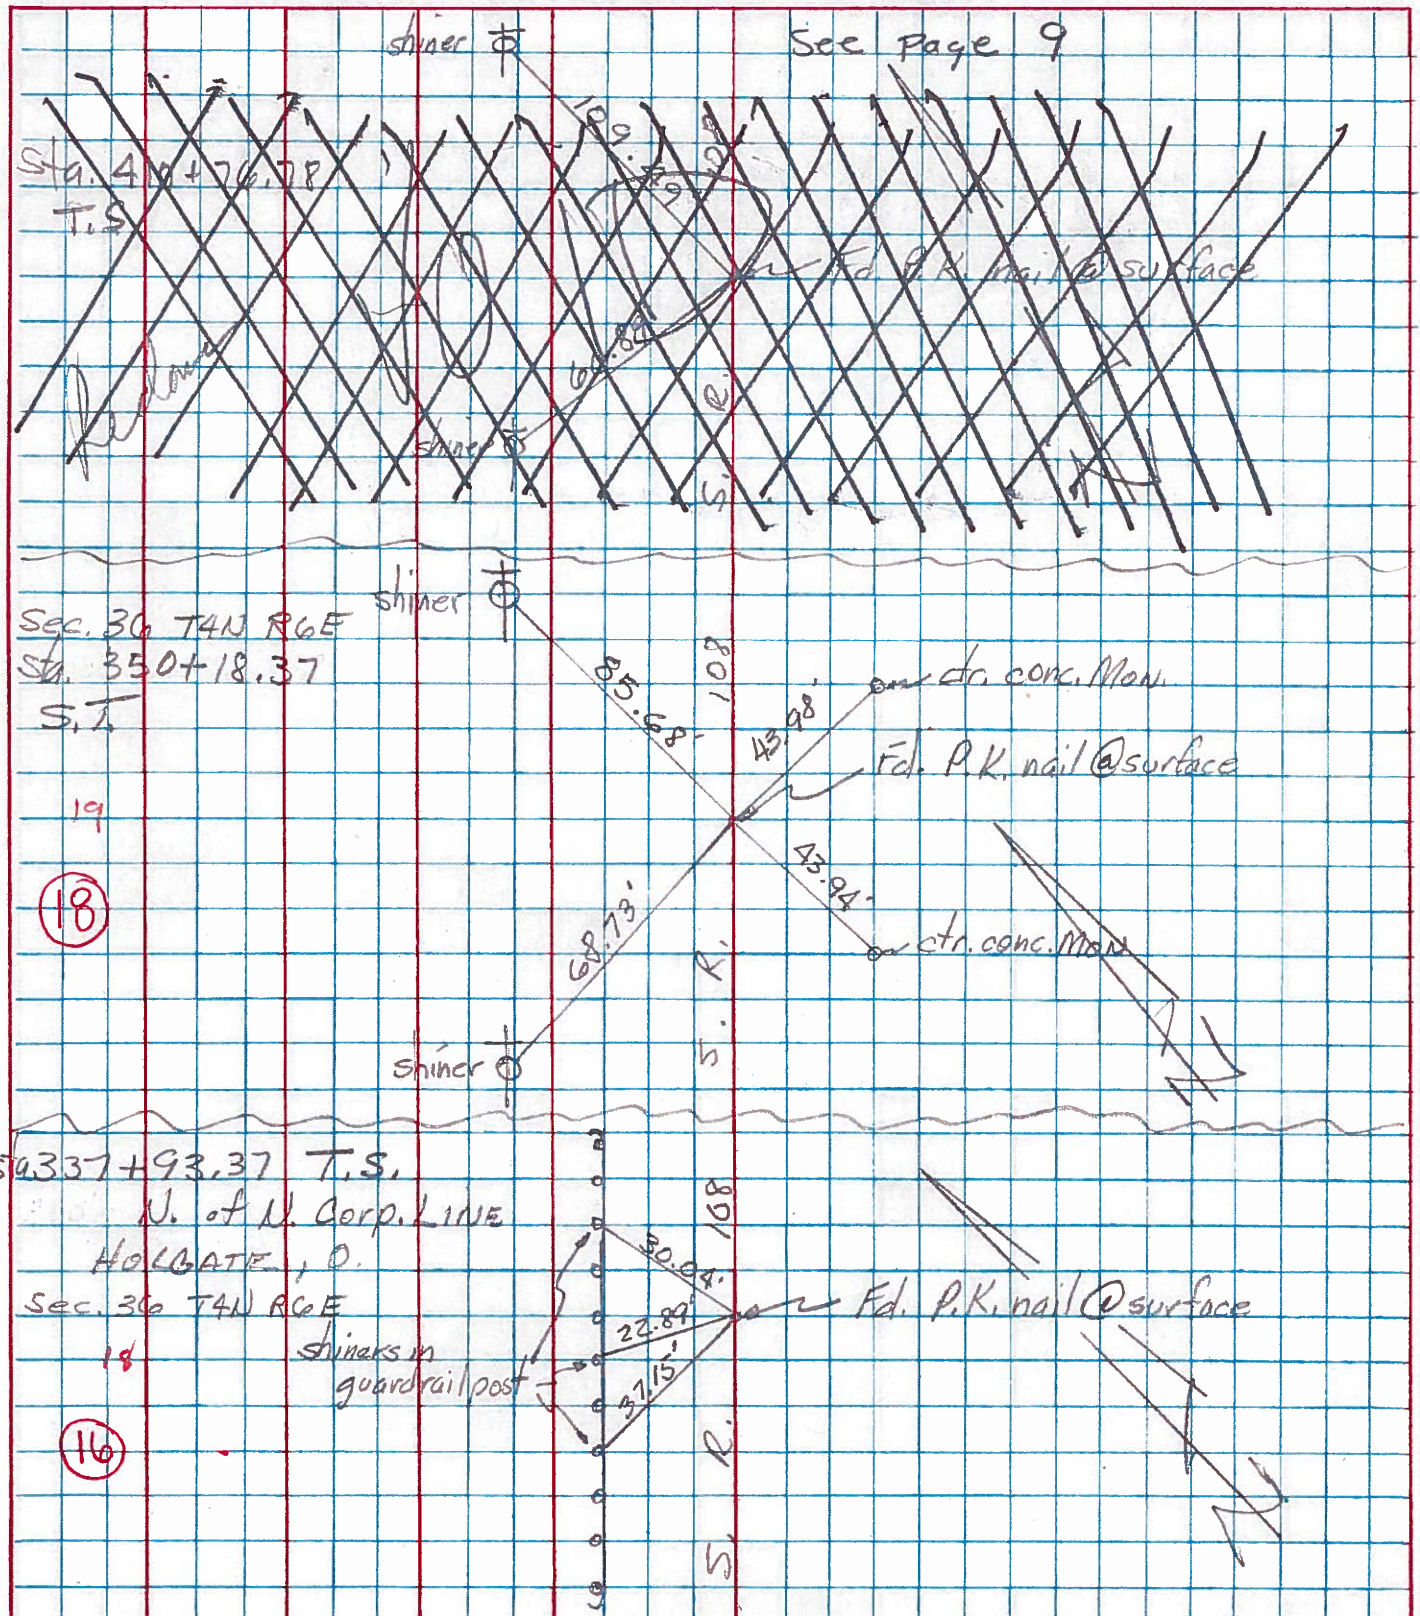

PERSONNEL TITLE PERSONNEL TITLE COUNTY Heit DATE 6/2/71
 Louys _____ Erikson Recorder S. R. # 108 WEATHER Cloudy Fog Rain
 Kov _____ Shaw _____ SEC. Halgate to Corral TEMP. 70°
 DESCRIPTION Ref. R/W Plan 1959 Ties JOB NO. _____

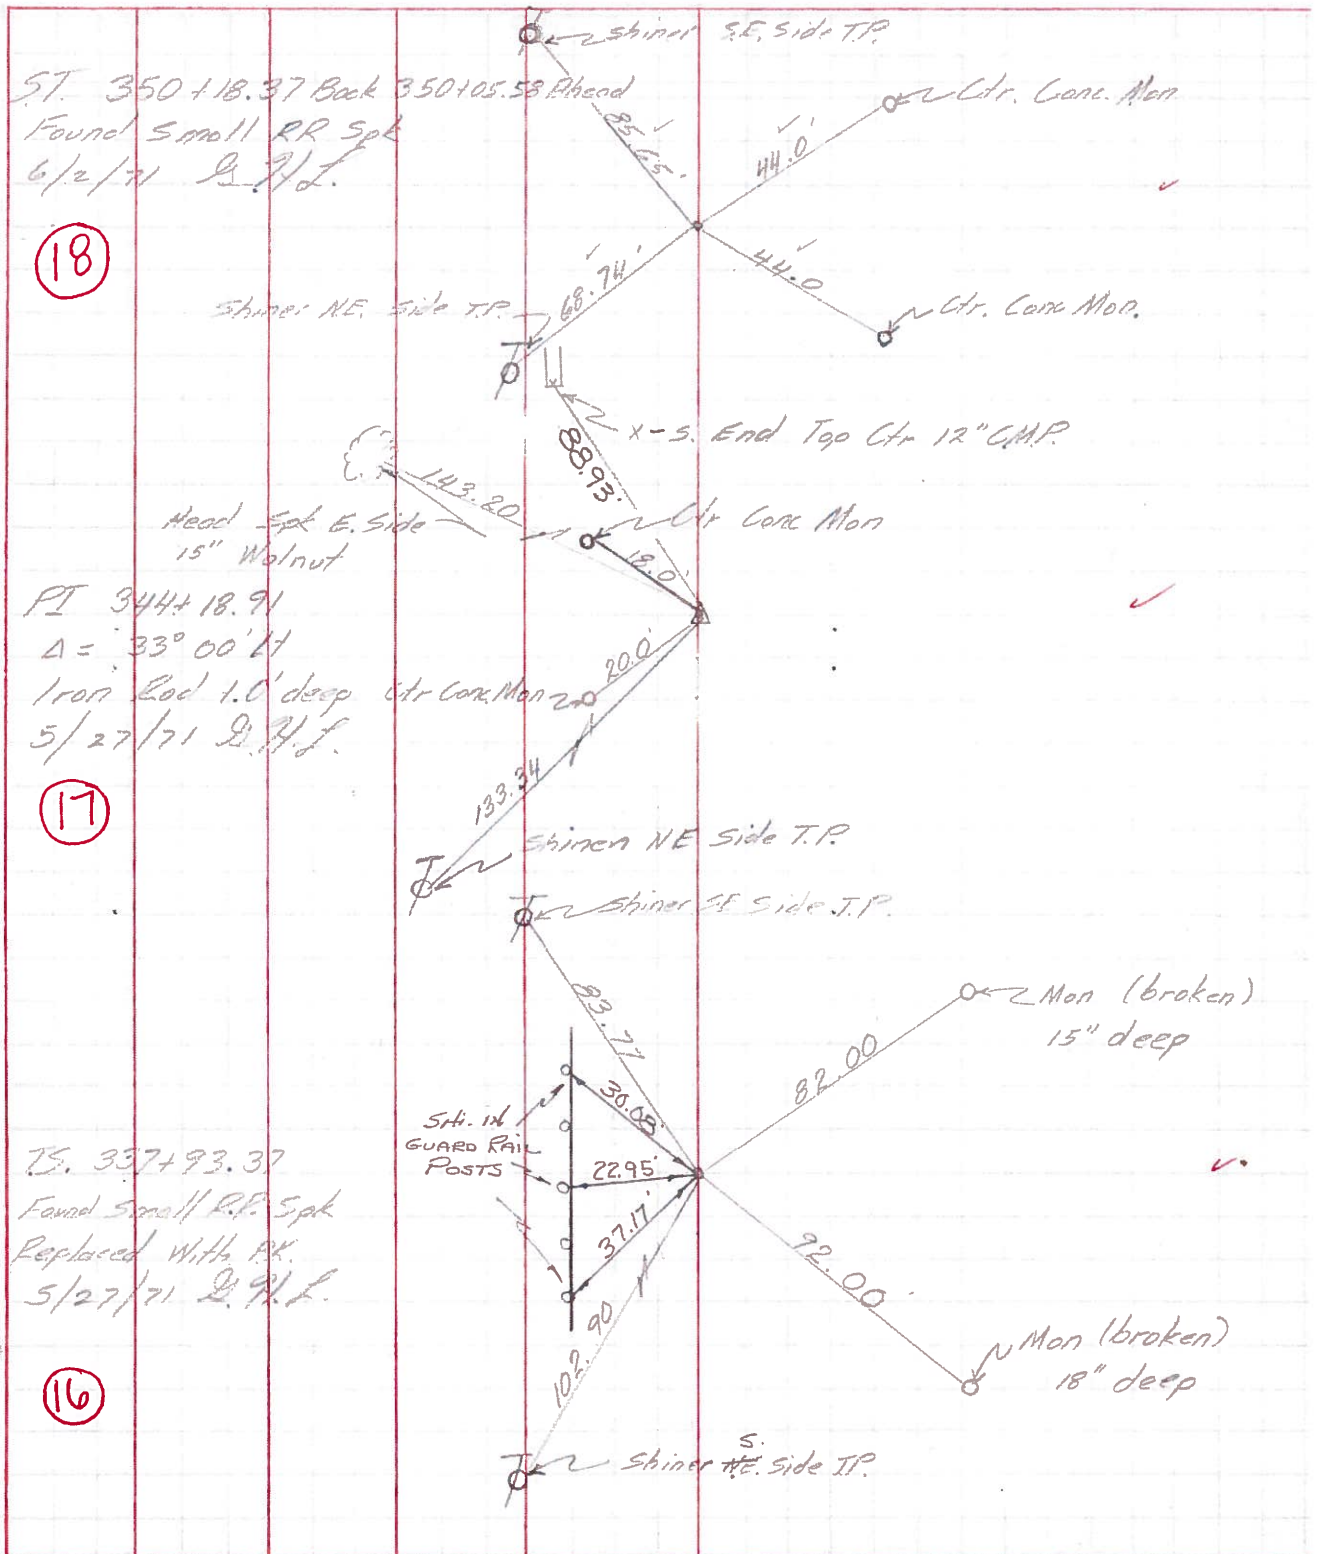

K
5-4-72

K
5-4-72

K
5-4-72