

O.D.O.T. DISTRICT 2 SURVEY OFFICE (USE ONLY)

PERSONNEL

REFERENCE NO. 19

SHEET 4 OF 48

NOTES ELKHECHEN

DATE 10/25/18

ROUTE SR 108

H.C. LEU

WEATHER CLOUDY

COUNTY HENRY

R.C. MILLER
RHOADES

TEMP. 40°

TOWNSHIP FLATROCK

DWG BY MILLER PID 94319

SECTION 36

T 4 N R 6 E

TYPE MONUMENT P.K.SHANK

~~ON SURFACE~~ - BELOW 3"

OFFSET \odot PAVEMENT 0.4' ~~LT~~ : RT

12.3' TO LT EDGE PAVEMENT


STATION: 354+04.63

HORIZ.DATUM: NAD83 (2011)


GEOID: 2012A

GRID: NORTHING: 584538.619

EASTING: 1521183.835

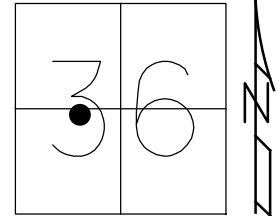

RECORD: T.S.
STA 353+92.64
FD P.K./WASHER
8/18/92, CL
SET P.K./WASHER
9-29-92, CL
FD P.K.SHANK
3" DOWN
REF19
10/25/18, JLL
SET MAG/WASHER
10-20-20, DSA

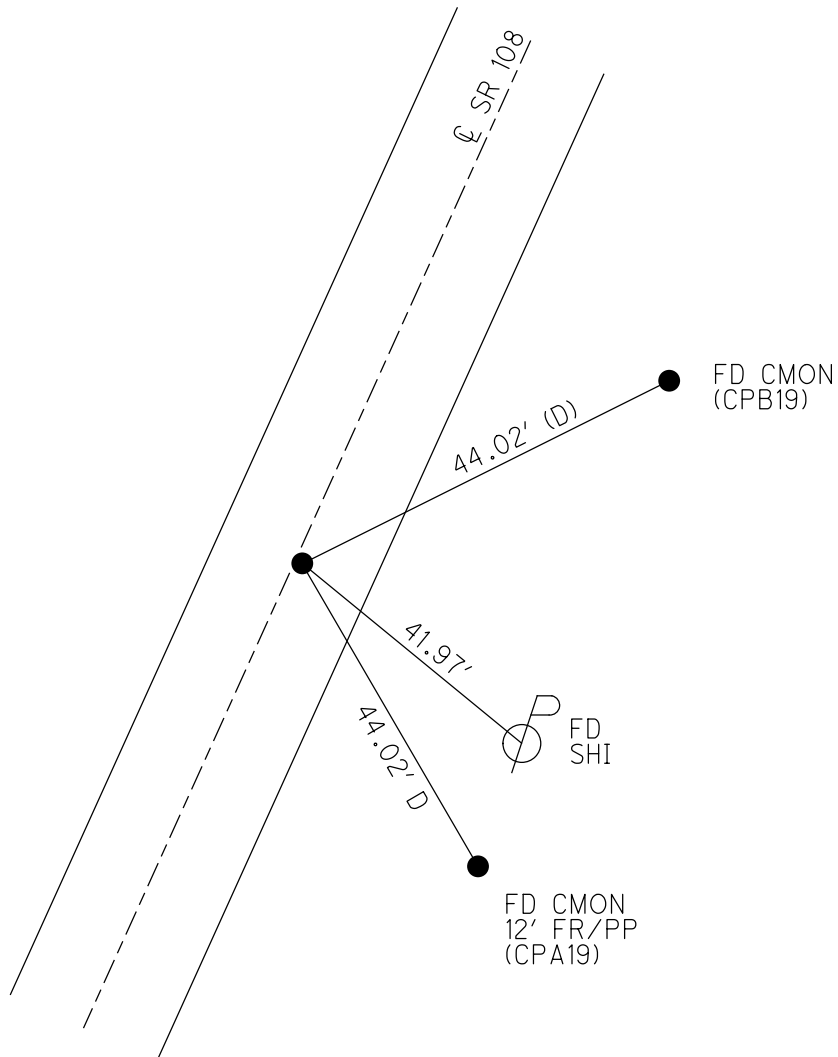

O.D.O.T. DISTRICT 2 SURVEY OFFICE

PERSONNEL

REFERENCE NO. 19

SHEET 24 OF 54

NOTES LOEHKE

H.C. CURTIS

DATE 8-18-92

ROUTE S.R. 108

R.C. FALKOWSKI

WEATHER CLOUDY

COUNTY HENRY

ROMERO

TEMP. +74

TOWNSHIP FLAT ROCK

SECTION 36

Reset 9-29-92

T 4 N R 6 E


TYPE MONUMENT P.K. / WASHER

ON SURFACE - BELOW Yes


LEFT - 0 PAV'T. - RIGHT 0.2

123 TO 4 EDGE PAVEMENT

S.L.M. 352798

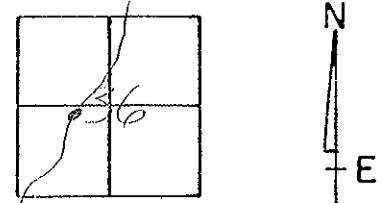

RECORD
 Sta 353+92.64
 T.S.

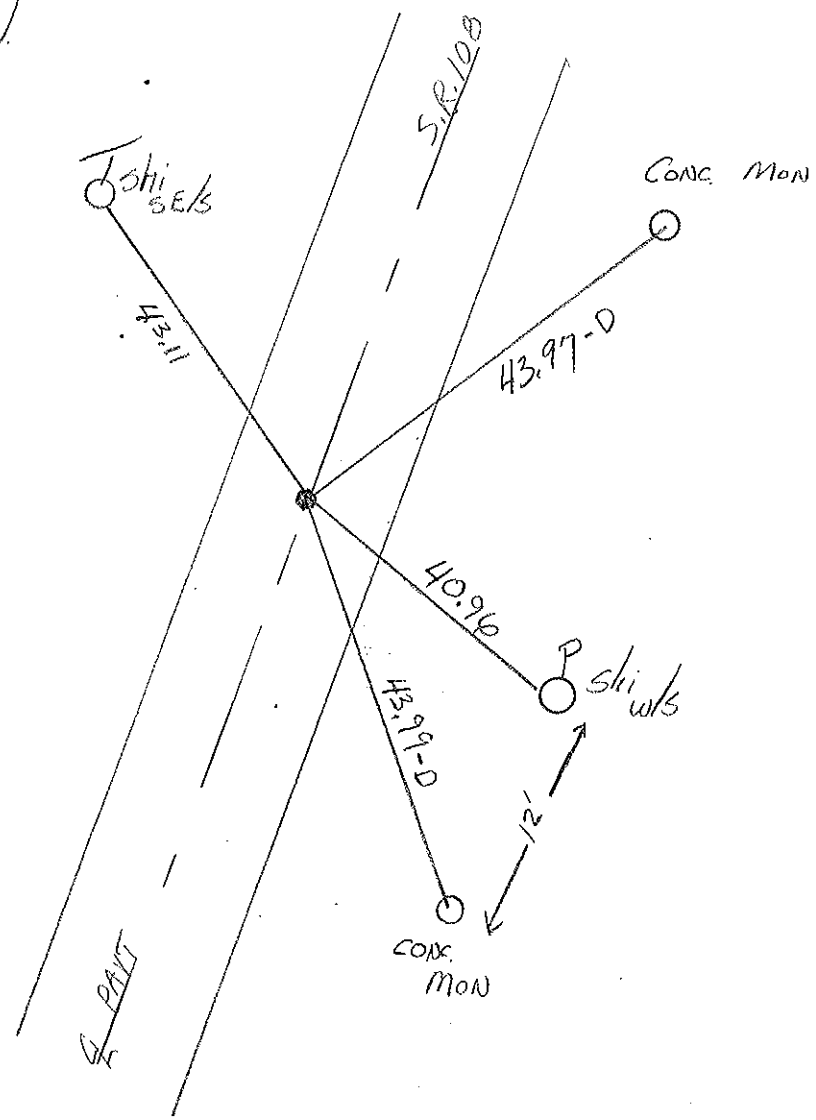

County HENRY S.R. 108

Township Flatrock

Section 36

T4N, R6E

Personnel Hoffman

Loehrke I.C.


Householder R.C.

Barnhiser Notes

Date 6-27-84

Weather Partly Cloudy

Temp. +77°

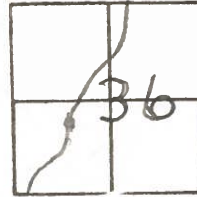


#19

SLM 353+74
FD PK @ SURFACE
on E of 108
11.7 RT EP
11.7 LT EP


8-27-84
SET PK/WASHER
M.D.B

Recorded
sta 353+92.64
T.S.

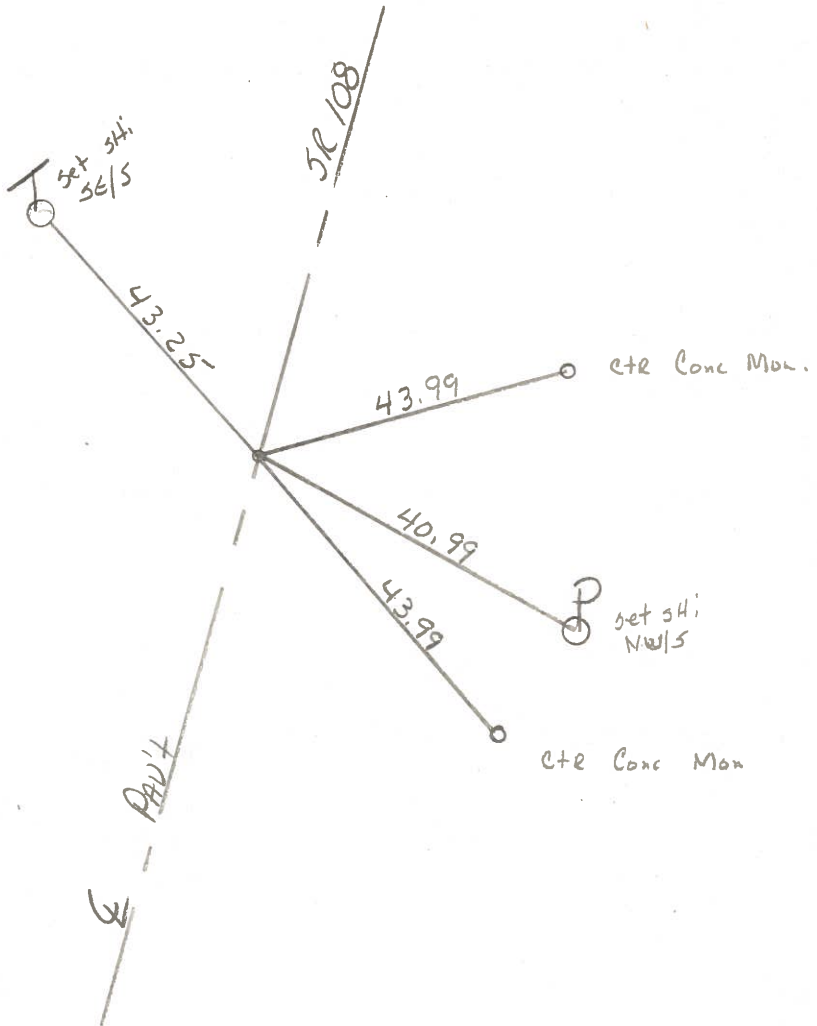

PERSONNEL	TITLE	PERSONNEL	TITLE	COUNTY	DATE	WEATHER	TEMP.
Tornsic				HENRY	July, 22, 1974		
Neuser				S. R. 108			
Vanvo				SEC. Flatrock TWP			
Grahata							

DESCRIPTION _____ LEFT _____ CENTER LINE _____ RIGHT _____ JOB NO. _____

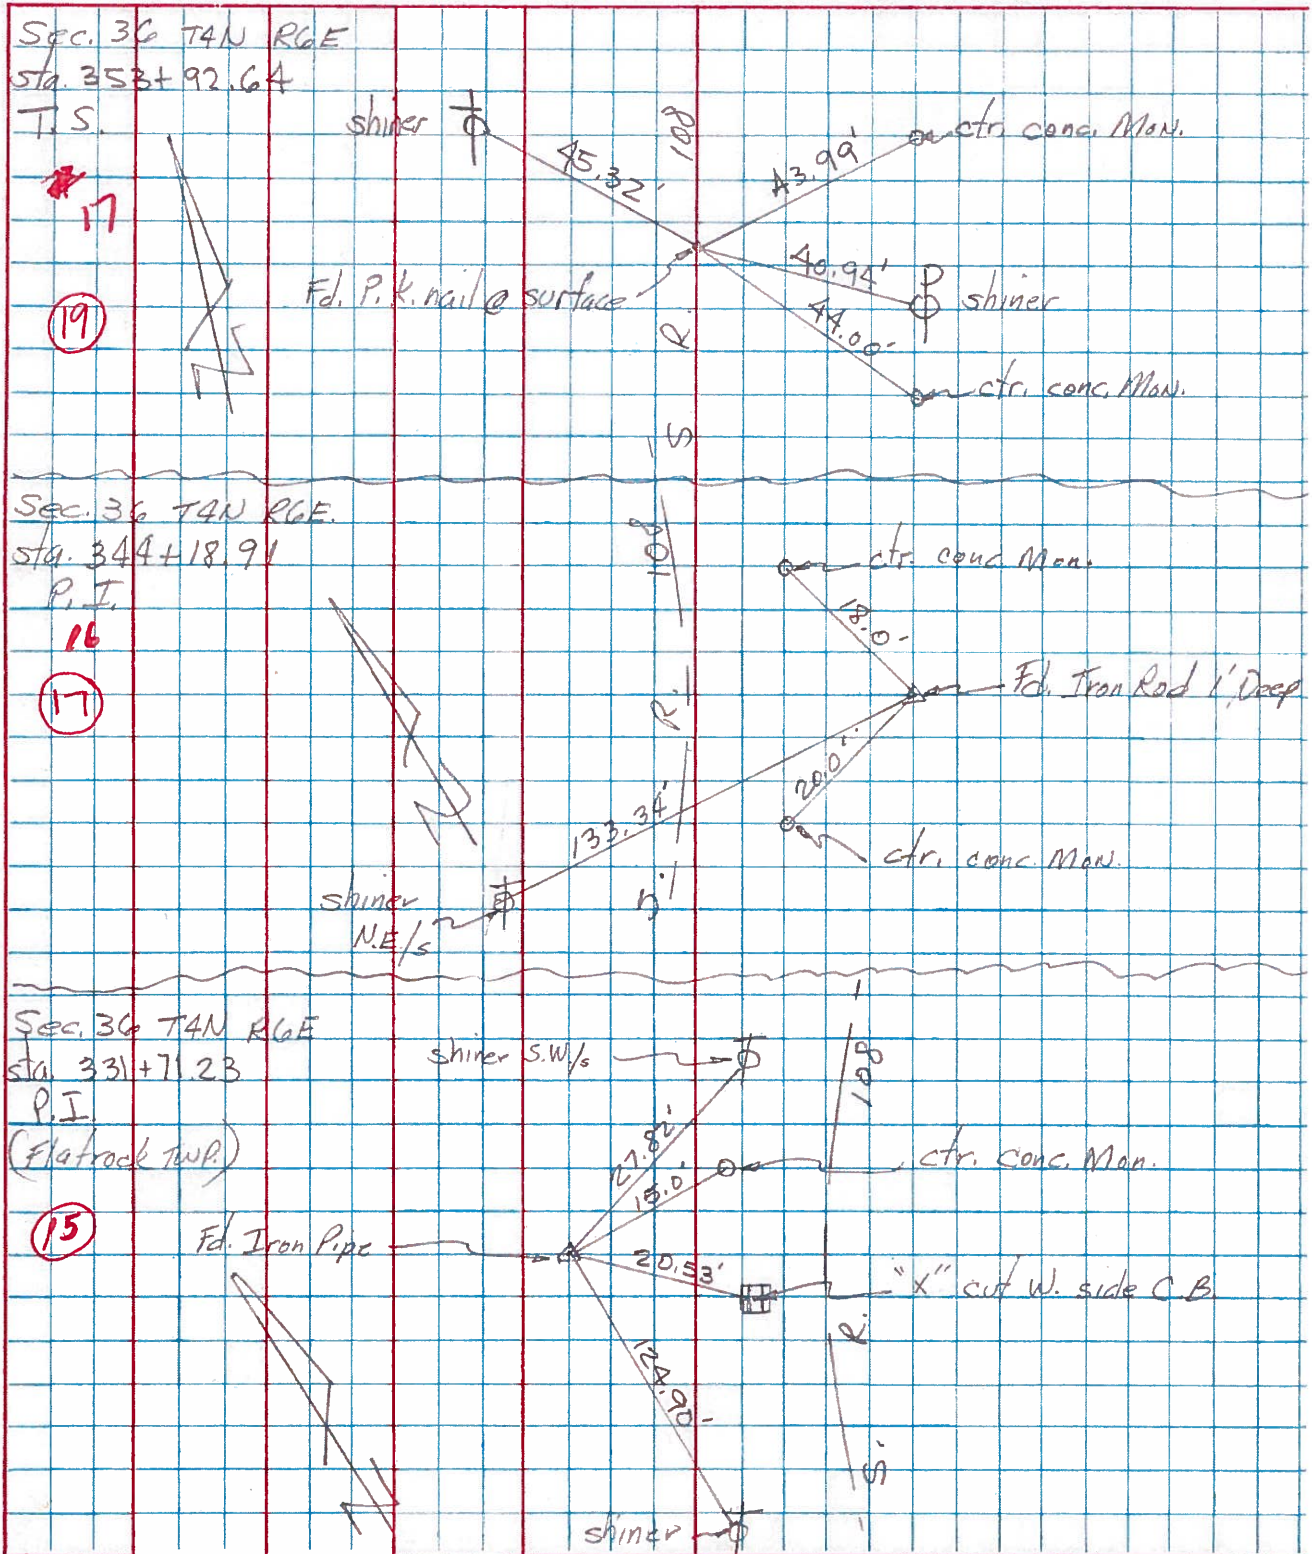

PERSONNEL	TITLE	PERSONNEL	TITLE	COUNTY	DATE
Louys				Hen	6/2/71
Frisson	Recorder			S. R. #108	WEATHER Cloud Rain
Rau				SEC. Holgate to Co Rd 1	TEMP. 70°
Shaw					

DESCRIPTION Ref R/W Plan 1958 Ties JOB NO. _____

OK 5-4-72

OK 5-4-72

OK 5-4-72

21

ST 363+50.56
 Sta Equation
 363+50.56 (Back)
 363+56.43 (Ahead)
 Found Small RR Spk
 6/2/71 D.H.L.

PI 358+75.97
 $\Delta = 22^\circ 19' RT$
 Found Mon Box
 6/2/71 D.H.L.

20' LT of LT. EDGE PAVE.

20

TS 353+92.64
 Found Small RR Spk
 6/2/71 D.H.L.

19

Shiner SE side TP

