

O.D.O.T. DISTRICT 2 SURVEY OFFICE (USE ONLY)

PERSONNEL

REFERENCE NO. 20

SHEET 5 OF 48

NOTES BALBAUGH

DATE 3/16/20

ROUTE SR 108

H.C. LEU

WEATHER PT CLOUDY

COUNTY HENRY

R.C. BALBAUGH

TEMP. 36°

TOWNSHIP FLATROCK

SECTION 36

DWG BY MILLER

PID 94319

T 4 N R 6 E

TYPE MONUMENT MONBOX W/1" IPIN

ON SURFACE - ~~BELOW~~ ON

OFFSET 33' \odot PAVEMENT LT : ~~RT~~

- TO - EDGE PAVEMENT


STATION: 358+83.69

HORIZ.DATUM: NAD83 (2011)


GEOID: 2012A

GRID: NORTHING: 585006.416

EASTING: 1521304.617

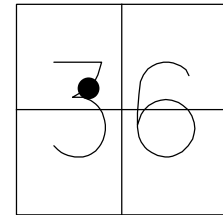

RECORD: P.I.
 STA 358+75.97
 $\Delta=22^{\circ}19'00''$
 FD MONBOX
 8/18/92, CL
 FD MONBOX
 W/ 3/4" IPIN
 REF20
 10-25-18, JLL

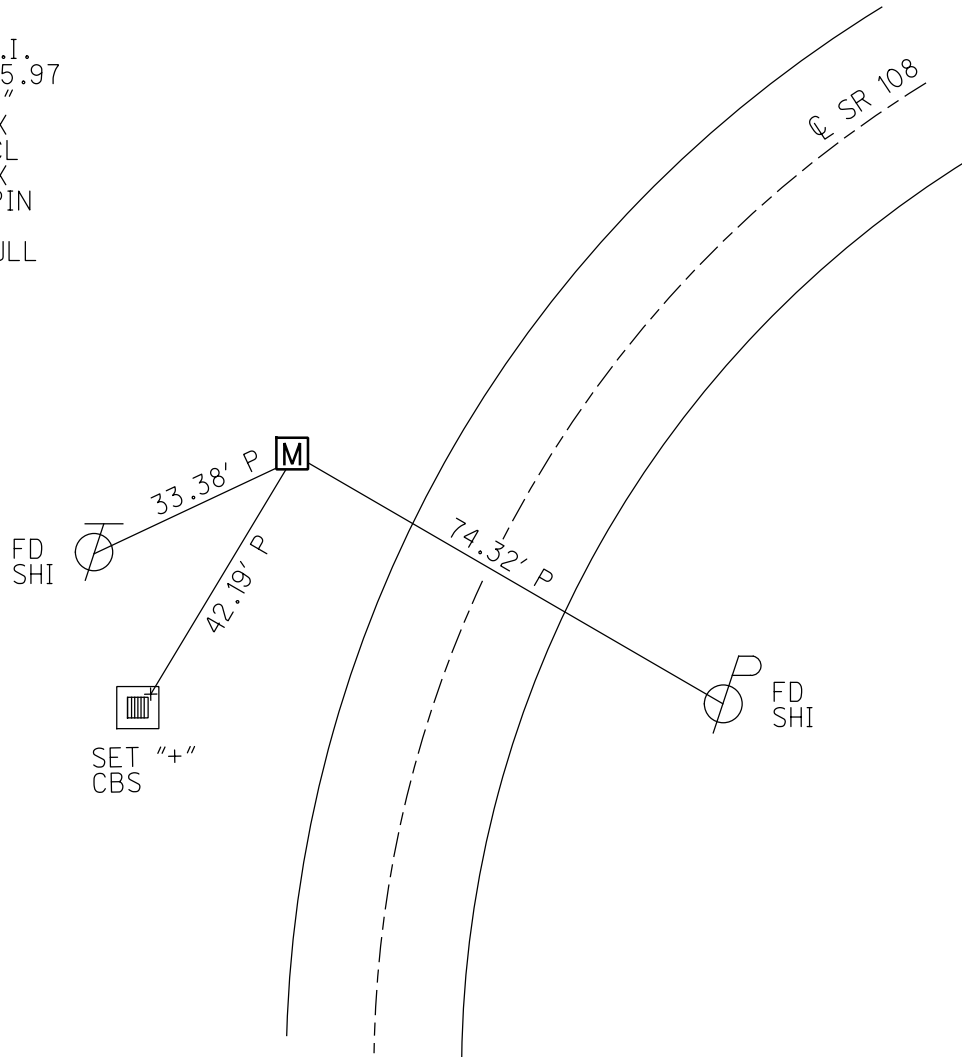

O.D.O.T. DISTRICT 2 SURVEY OFFICE

PERSONNEL

REFERENCE NO. 20

SHEET 25 OF 54

NOTES LOEHRKE

H.C. CURTIS

DATE 8-18-92

ROUTE S.R.108

R.C. FALKOWSKI

WEATHER pt Cloudy

COUNTY HENRY

ROMETO

TEMP. +76

TOWNSHIP FLAT Rock

SECTION 36

T 4 N R 6 E


TYPE MONUMENT Mon. Box

ON SURFACE - BELOW Yes


LEFT-☉ PAV'T. - RIGHT 33'

TO EDGE PAVEMENT

S.L.M. 357 + 75

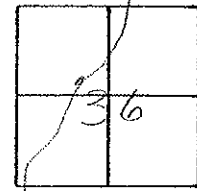

RECORD
 P.I.
 Sta 358 + 75.97

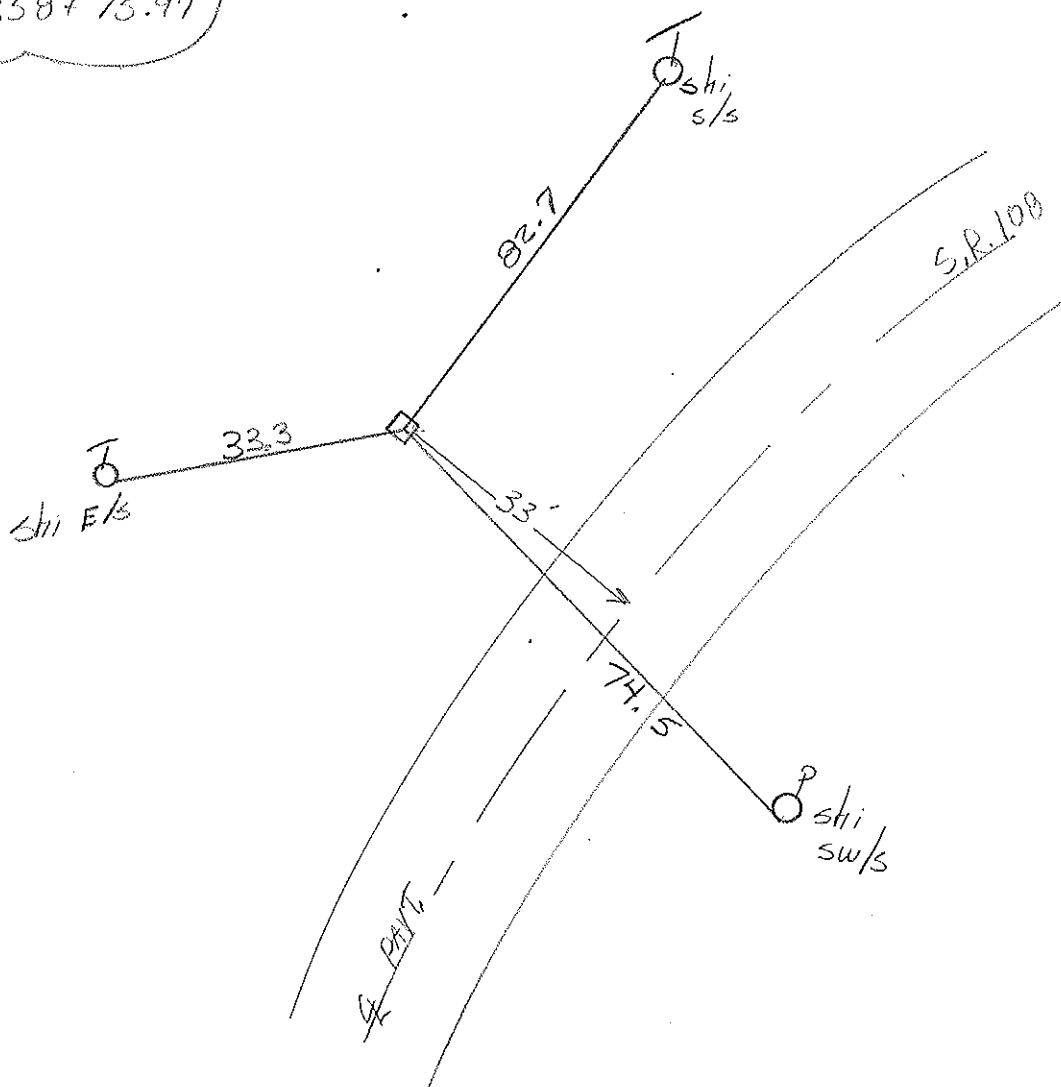

County Henry S.R. 108

Township Flatrock

Section 36

T4N, R6E

Personnel Hoffman

Loehrke HC


Householder RC

Barahisel Notes

Date 6.27-84

Weather Partly - Cloudy


Temp. +77°

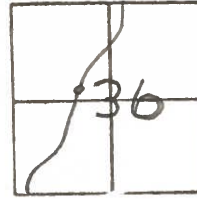

#20

SLM 358+54
FD Mon Box
33 Lt of E SR108

Recorded
Sta. 358+75.97
P.I.

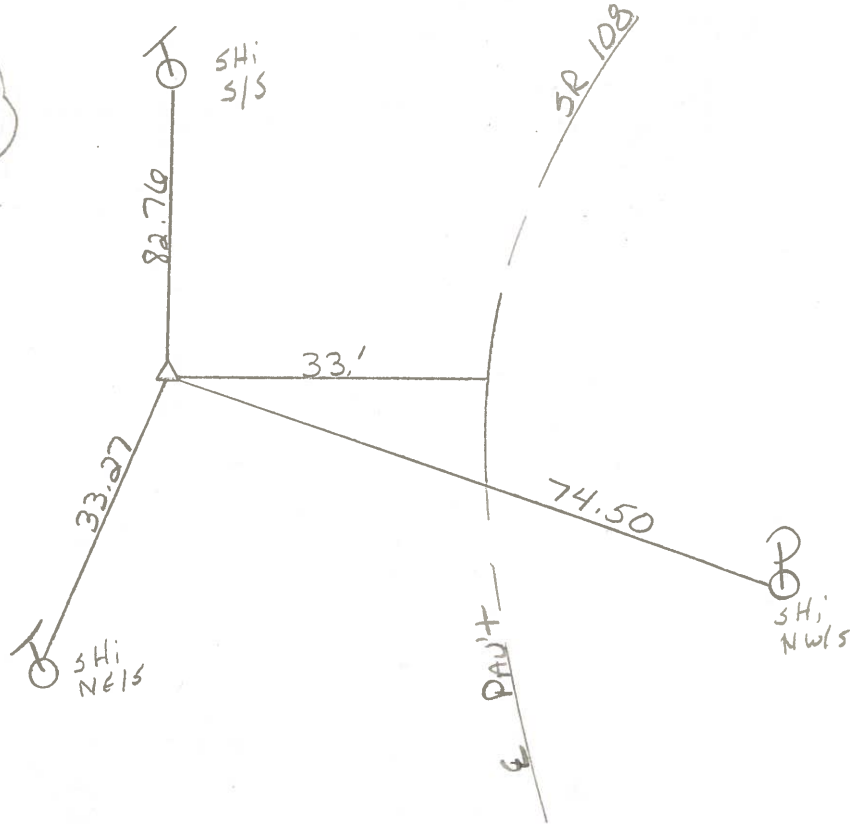


PERSONNEL TITLE PERSONNEL TITLE


Tomsic
Neuser
Vandy
Granata

COUNTY HENRY DATE July 22, 1974
S. R. 108 WEATHER _____
SEC. Flatrock TWP TEMP. _____

DESCRIPTION LEFT CENTER LINE RIGHT JOB NO.

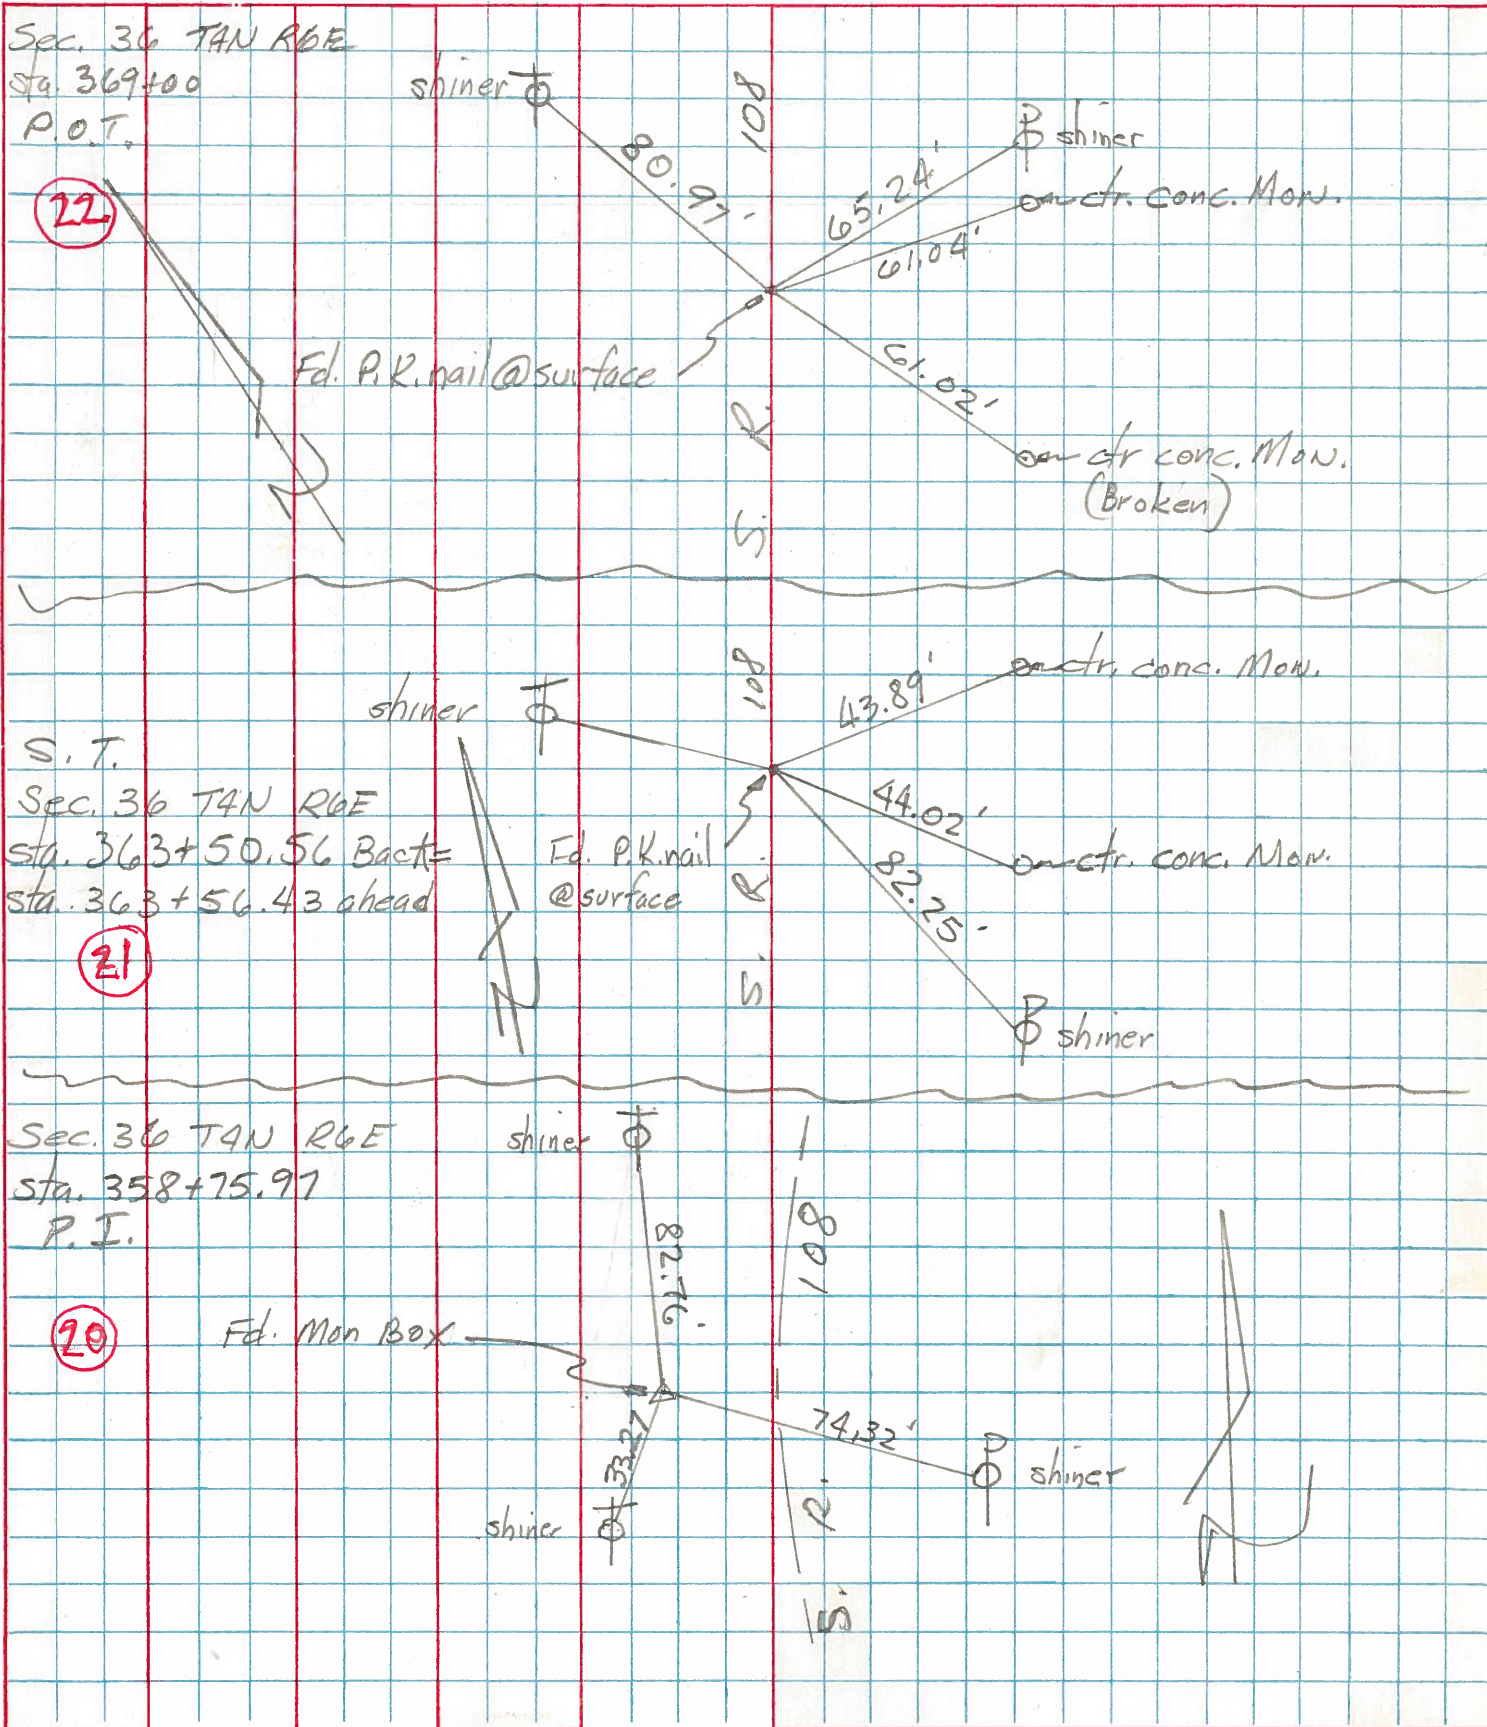

PERSONNEL	TITLE	PERSONNEL	TITLE	COUNTY	DATE
Louise				Hen	6/2/71
Ericksen	Recorder			S. R. #108	WEATHER Cloud Rain
Rau				SEC. Holgate to Co Rd L	TEMP 70°
Shaw					
DESCRIPTION	Ref R/W Plan 1958			TIME	JOB NO.
	LEFT	CENTER LINE	RIGHT		

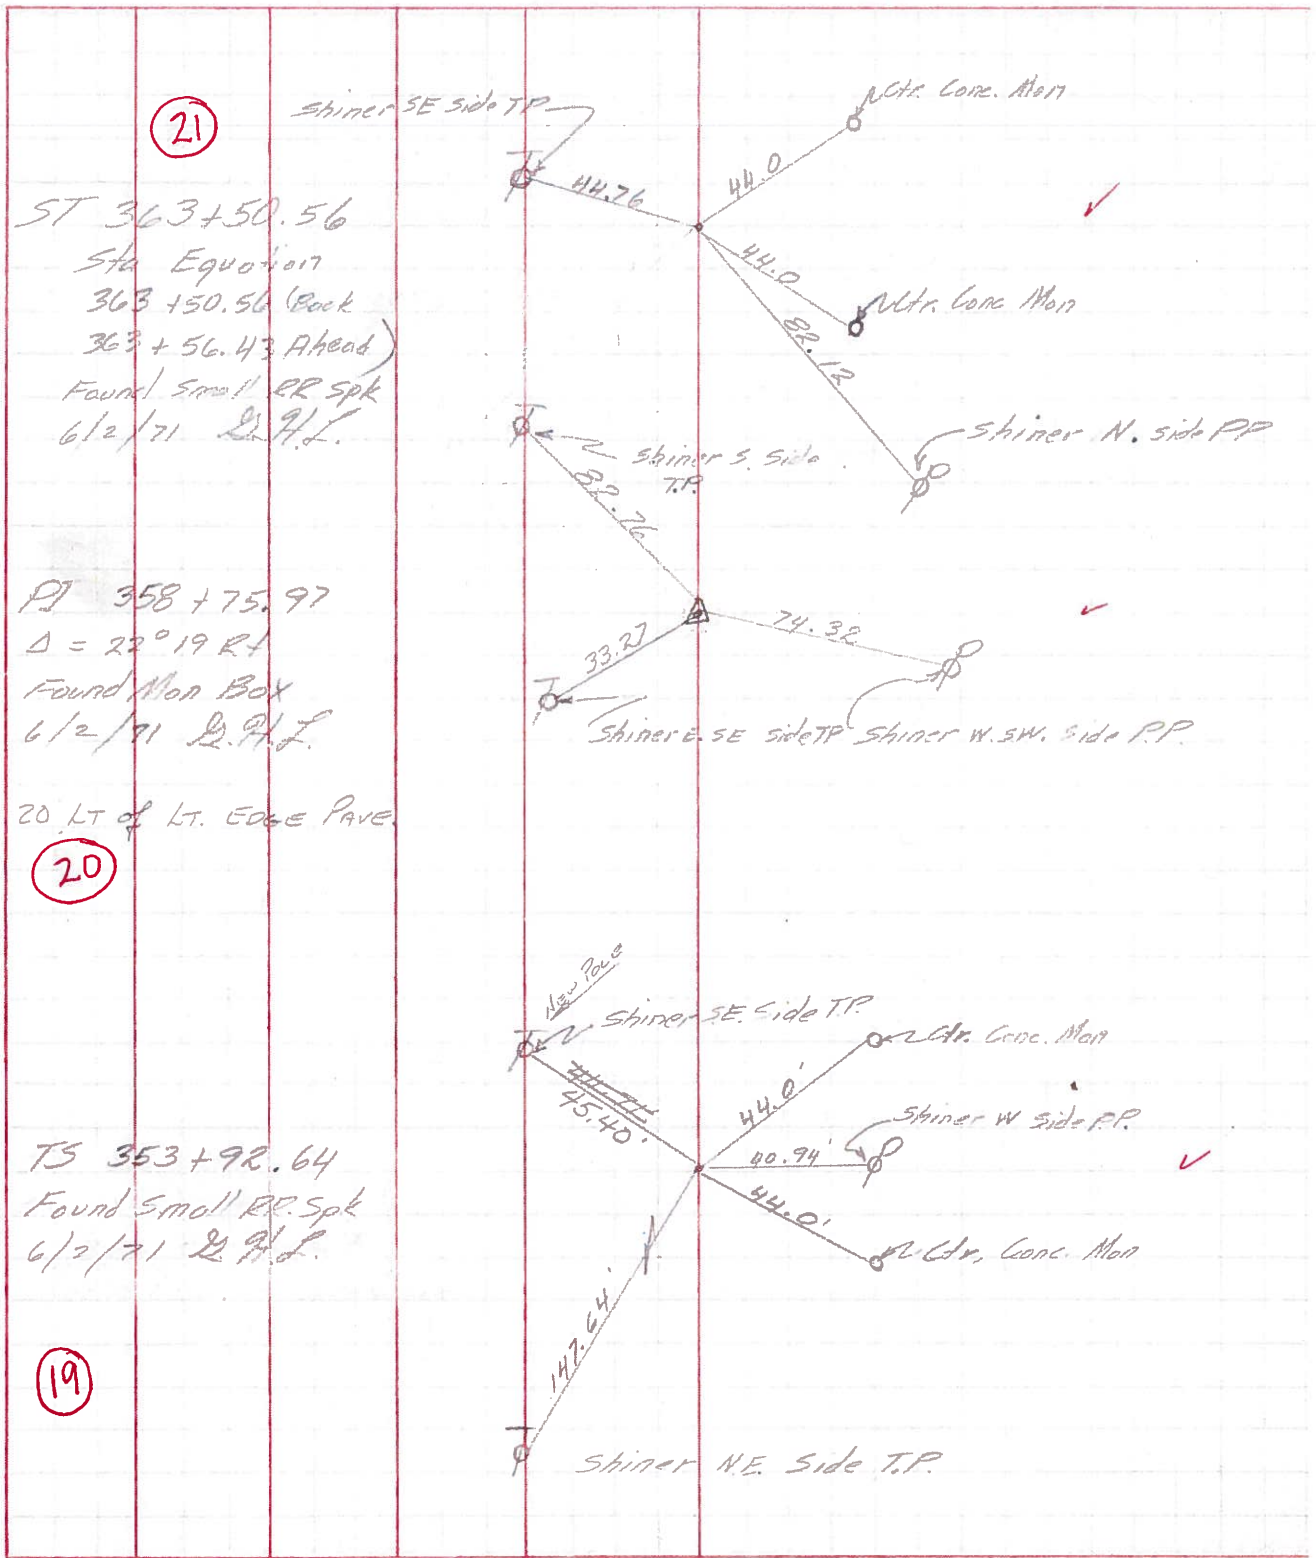

(21)

ST 363+50.56
 Sta Equation
 363 + 50.56 (Back)
 363 + 56.43 (Ahead)
 Found Small RR Spk
 6/2/71 R.H.L.

OK
5-4-72

PJ 358+75.97
 $\Delta = 22^\circ 19' R$
 Found Mon Box
 6/2/71 R.H.L.

OK
5-4-72

20 LT of Lt. Edge Pave

(20)

TS 353+92.64
 Found Small RR Spk
 6/2/71 R.H.L.

OK
5-4-72

(19)