


O.D.O.T. DISTRICT 2 SURVEY OFFICE (USE ONLY)


PERSONNEL _____ REFERENCE NO. 21 SHEET 6 OF 48
 NOTES LEU DATE 3/09/20 ROUTE SR 108
 H.C. LEU WEATHER CLOUDY/WINDY COUNTY HENRY
 R.C. BALBAUGH TEMP. 60° TOWNSHIP FLATROCK
 DWG BY BALBAUGH PID 94319 SECTION 36
 T 4 N R 6 E

TYPE MONUMENT P.K. NAIL
~~ON SURFACE~~ - BELOW 3"
 OFFSET \odot PAVEMENT 0.5' LT : ~~RT~~
12.1' TO LT EDGE PAVEMENT
 STATION: 363+62.59

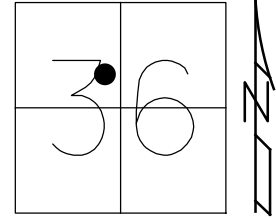

HORZ. DATUM: NAD83 (2011) GEOID: 2012A
 GRID: NORTHING: 585393.316 EASTING: 1521594.269

RECORD: S.T.
 STA 363+50.56 BACK
 STA 363+56.43 AHEAD
 FD P.K./WASHER
 8/18/92, CL
 SET P.K./WASHER
 9-29-92, CL
 FD P.K.NAIL
 3" DOWN
 REF21
 10-25-18, JLL
 SET MAG/WASHER
 10-20-20, DSA

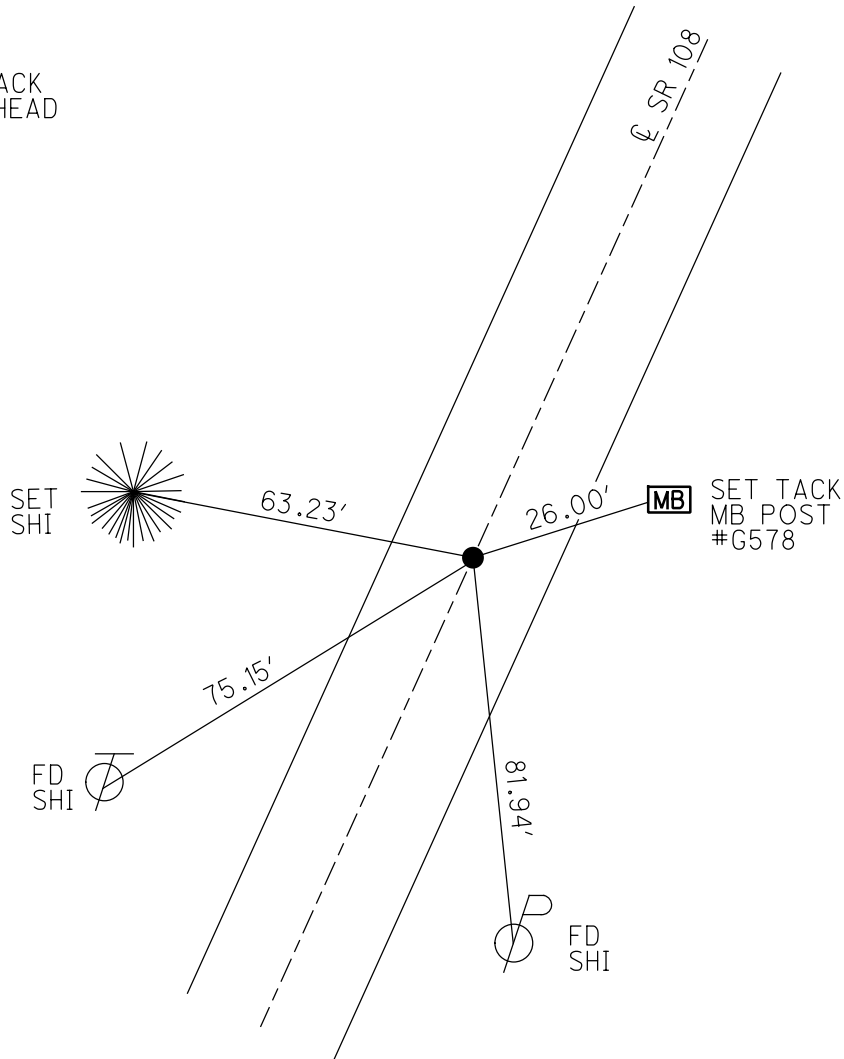

O.D.O.T. DISTRICT 2 SURVEY OFFICE

PERSONNEL _____

REFERENCE NO. 21

SHEET 26 OF 54

NOTES LOHRKE

H.C. CURTIS

DATE 8-18-92

ROUTE S.R. 108

R.C. FALKOWSKI

WEATHER PT Cloudy - Windy

COUNTY HENRY

TEMP. +76

TOWNSHIP FLAT Rock

SECTION 36

T 4 N R 6 E


TYPE MONUMENT P.K. / WASHER Reset 9-29-92

ON SURFACE - BELOW Yes

~~LEFT - & PAV'T. - RIGHT~~ Yes

12.1 JOINT EDGE PAVEMENT

S.L.M. 362 + 56

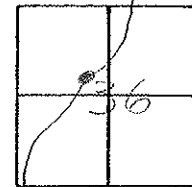


RECORD

Sta 363 + 50.56 Back =

Sta 363 + 56.43 Ahead

C.T.

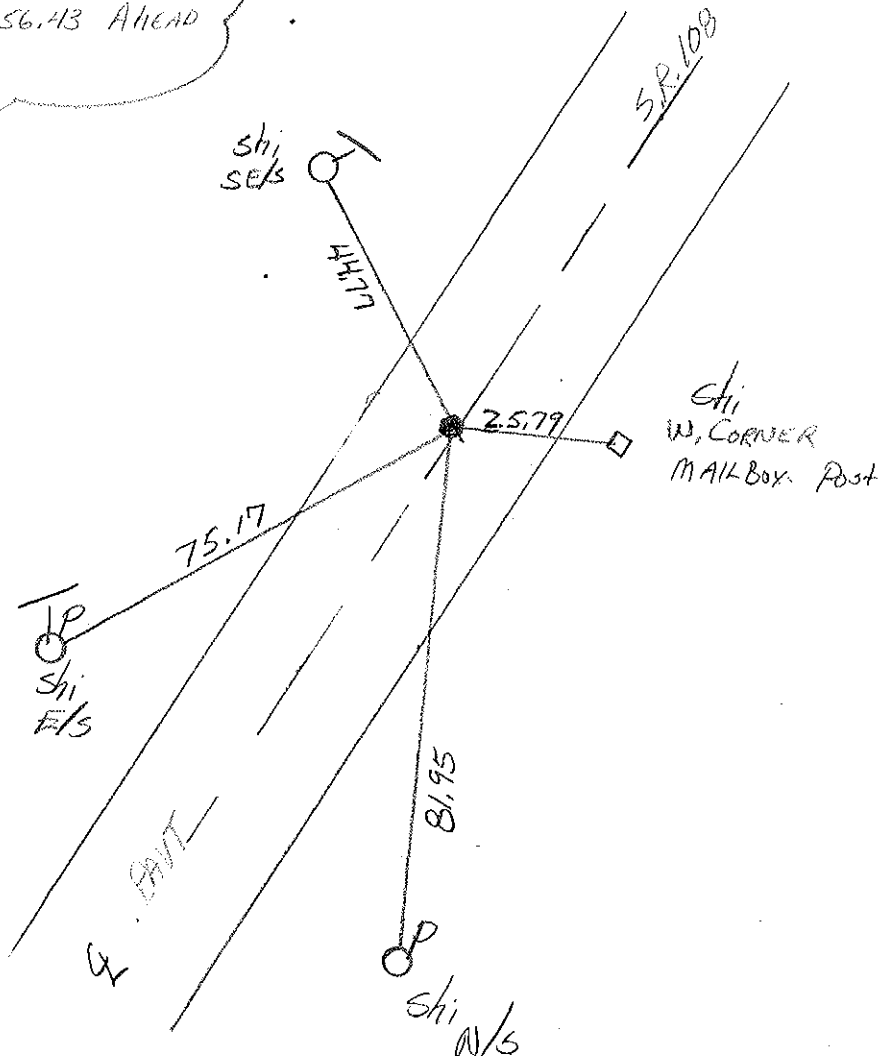

County Henry S.R. 108

Date 6-27-84

Township Flat Rock

Weather Partly Cloudy

Section 36

Temp. 177°


T4N, R6E

Personnel Hoffman

Loehrke HC

Householder RC

Barnhiser Notes

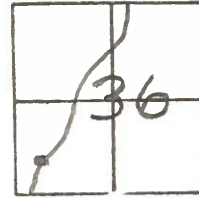


21

SLM 363+32
FD PK @ surface
on Q of 108
11.7 R+EP
11.7 Lt EP


8-27-84
SET PK/WASHER
M.D.B.

Recorded
sta 363+50.56 BACK =
sta 363+56.43 AHEAD
SIT.

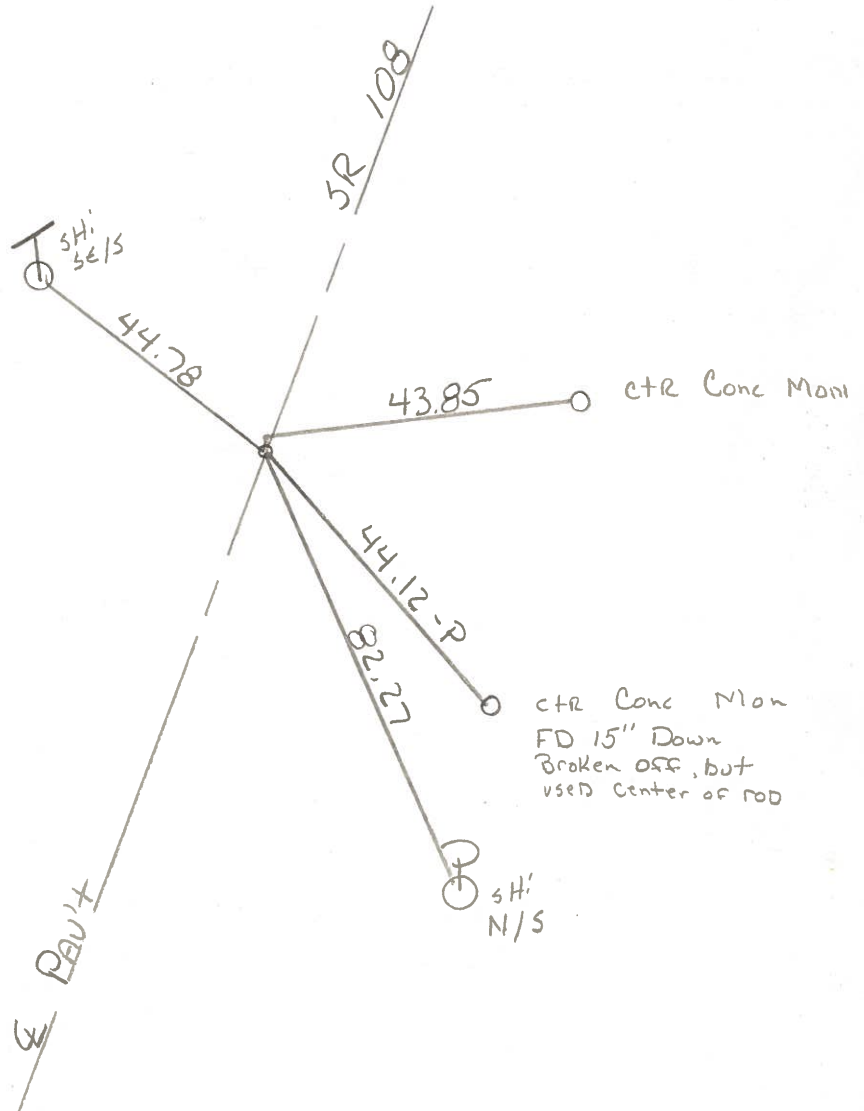


PERSONNEL	TITLE	PERSONNEL	TITLE	COUNTY	DATE	WEATHER	TEMP.
Tomsic				HENRY	July 22, 1974		
Neuser				S. R. 108			
Vandy				SEC. Flatrock TWP			
Granata							

DESCRIPTION	LEFT	CENTER LINE	RIGHT	JOB NO.
-------------	------	-------------	-------	---------

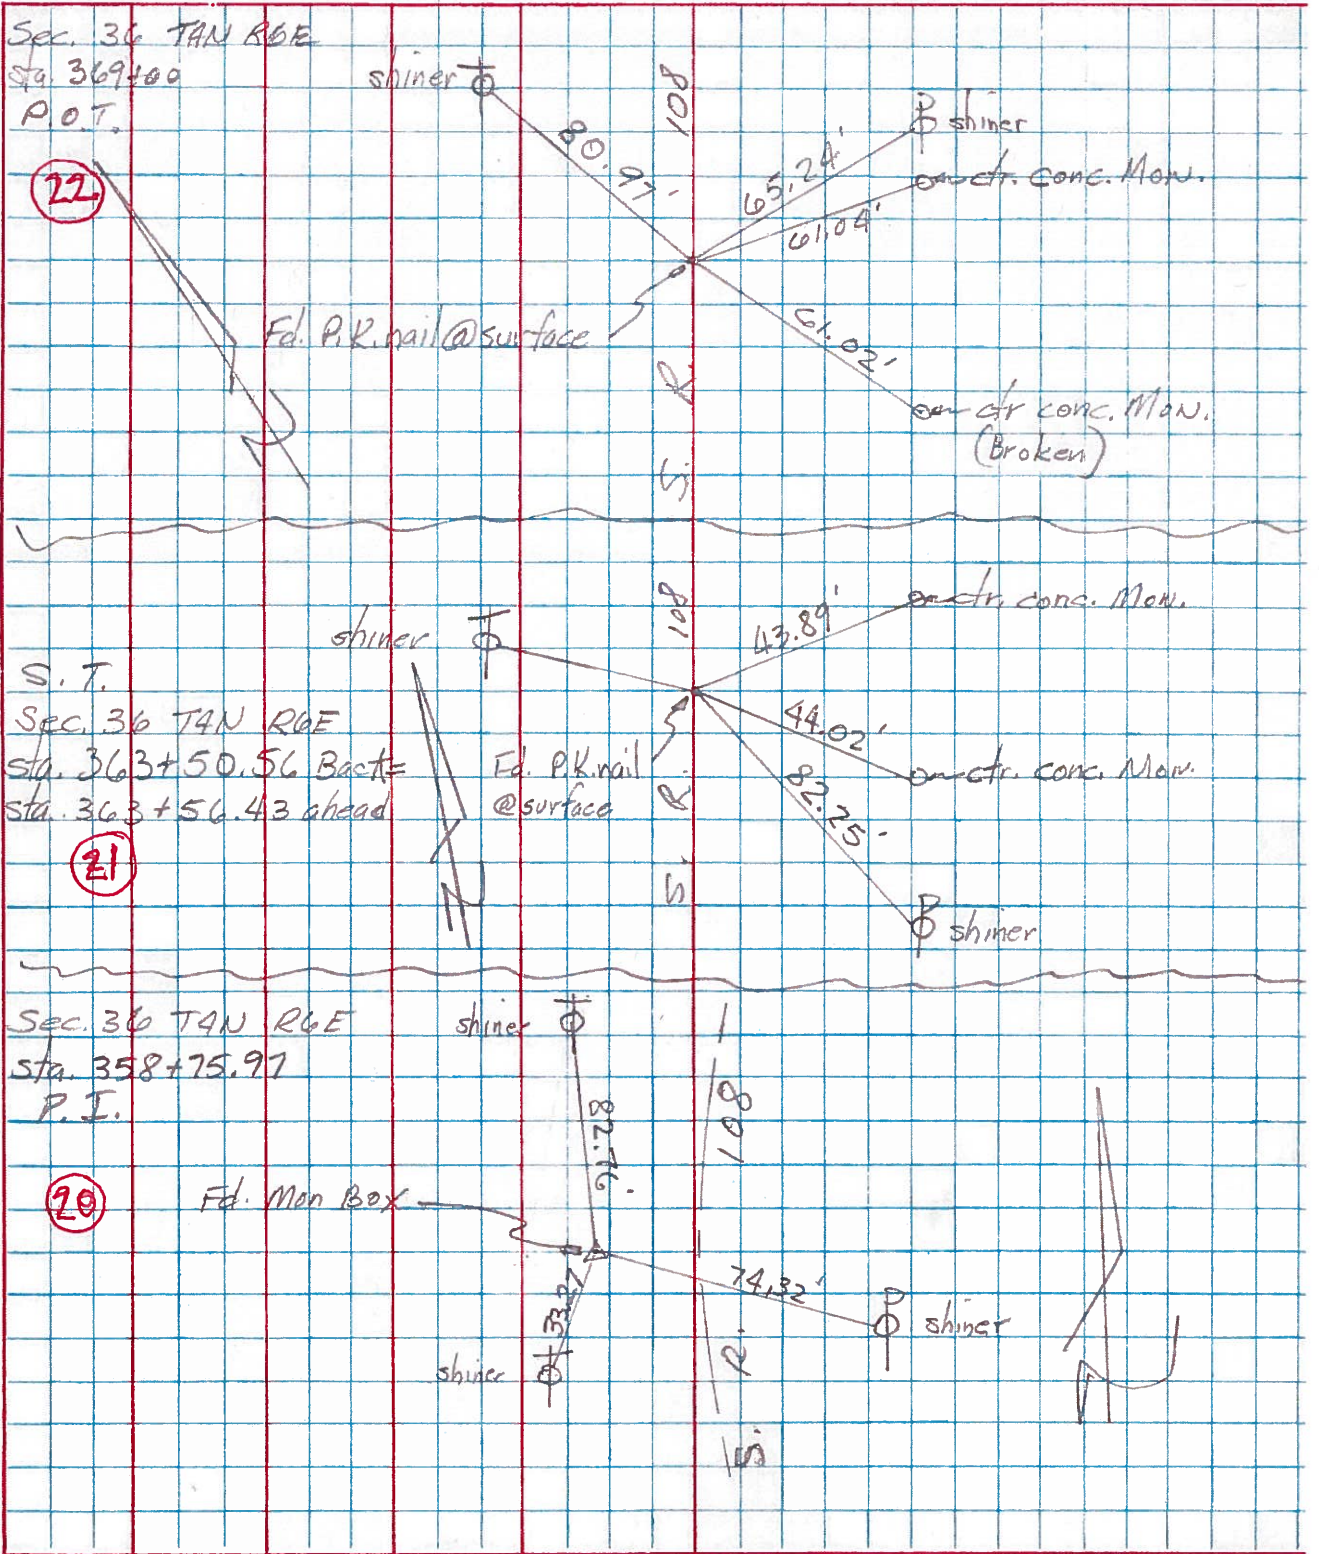

PERSONNEL TITLE PERSONNEL TITLE COUNTY Hen DATE 6/2/71
Louys _____
Erickson Recorder _____ S. R. # 108 WEATHER Cloud Rain
Pau _____
Shaw _____ SEC. Holgate to Co Rd 1 TEMP. 70°
 DESCRIPTION Ref R/W Plan P 58 ties JOB NO. _____

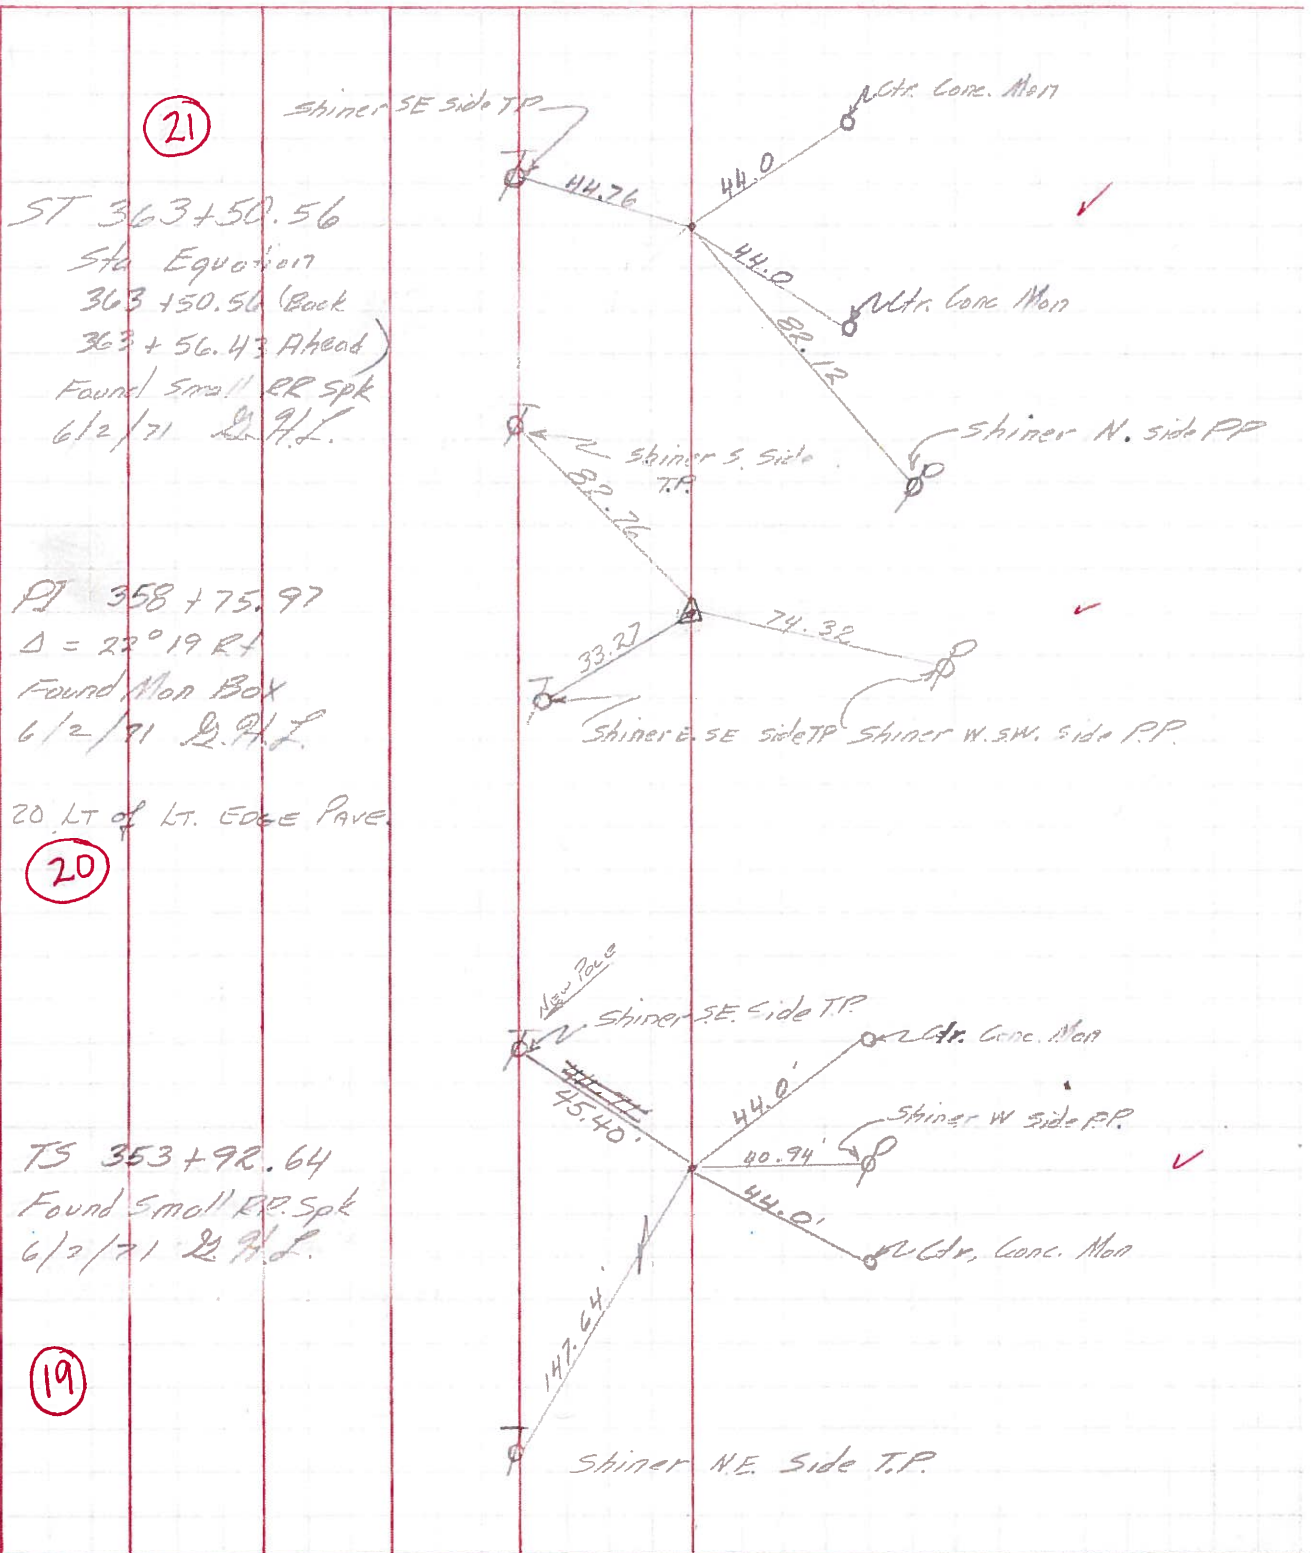

OK
5-4-72

OK
11-72

OK
4-72

21

ST 363+50.56
 Sta Equation
 363 + 50.56 (Back)
 363 + 56.43 (Ahead)
 Found small RR spk
 6/2/71 G.H.L.

PI 358+75.97
 $\Delta = 22^\circ 19' RT$
 Found Mon Box
 6/2/71 G.H.L.

20 LT of LT. EDGE PAVE.

20

TS 353+92.64
 Found small RR Spk
 6/2/71 G.H.L.

19

