


O.D.O.T. DISTRICT 2 SURVEY OFFICE (USE ONLY)


PERSONNEL	REFERENCE NO. <u>23</u>	SHEET <u>8</u> OF <u>48</u>
NOTES <u>ELKHECHEN</u>	DATE <u>11/5/18</u>	ROUTE <u>SR 108</u>
H.C. <u>LEU</u>	WEATHER <u>SUNNY</u>	COUNTY <u>HENRY</u>
R.C. <u>MILLER</u>	TEMP. <u>51°</u>	TOWNSHIP <u>FLATROCK</u>
DWG BY <u>MILLER</u>	PID <u>94319</u>	SECTION <u>36</u>
		T <u>4</u> N R <u>6</u> E

TYPE MONUMENT P.K.SHANK
~~ON SURFACE~~ - BELOW 3"
 OFFSET \varnothing PAVEMENT ON LT : RT
13.6' TO RT EDGE PAVEMENT
 STATION: 374+85.81

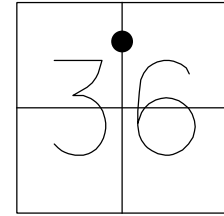

HORZ.DATUM: NAD83 (2011) GEOID: 2012A
 GRID: NORTHING: 586292.672 EASTING: 1522266.952

RECORD: T.S.
 STA 374+79.97
 FD P.K./WASHER
 8/18/92, MB
 SET P.K./WASHER
 9-17-92, MDB
 FD P.K.SHANK
 3" DOWN
 REF23
 11-5-18, JLL
 SET MAG/WASHER
 10-20-20, DSA

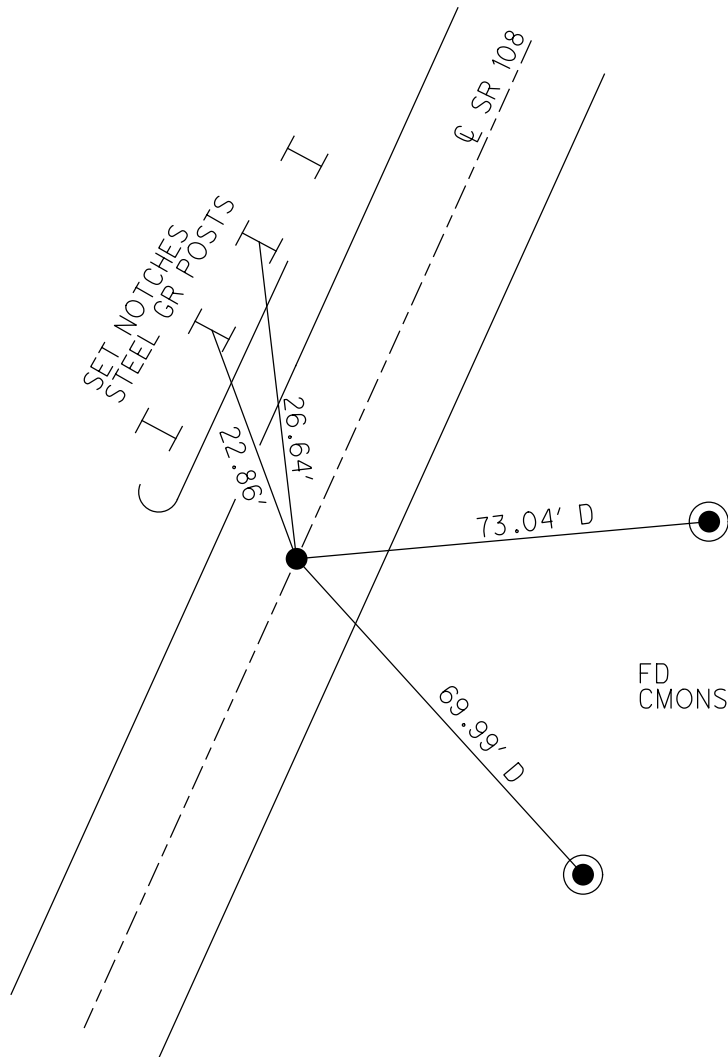

O.D.O.T. DISTRICT 2 SURVEY OFFICE

PERSONNEL

REFERENCE NO. 23

SHEET 28 OF 54

NOTES VAN DUSEN

H.C. KUSZ

R.C. BARNHISEL

DATE 8-18-92

WEATHER CLOUDY

TEMP. +75°F

ROUTE SR 108

COUNTY HENRY

TOWNSHIP FLAT ROCK

SECTION 36

T4 N R 6 E


TYPE MONUMENT PK & WASHER

ON SURFACE - BELOW YES

LEFT - & PAV'T. - RIGHT YES

13.6 TO RT. EDGE PAVEMENT

S.L.M. 373+77

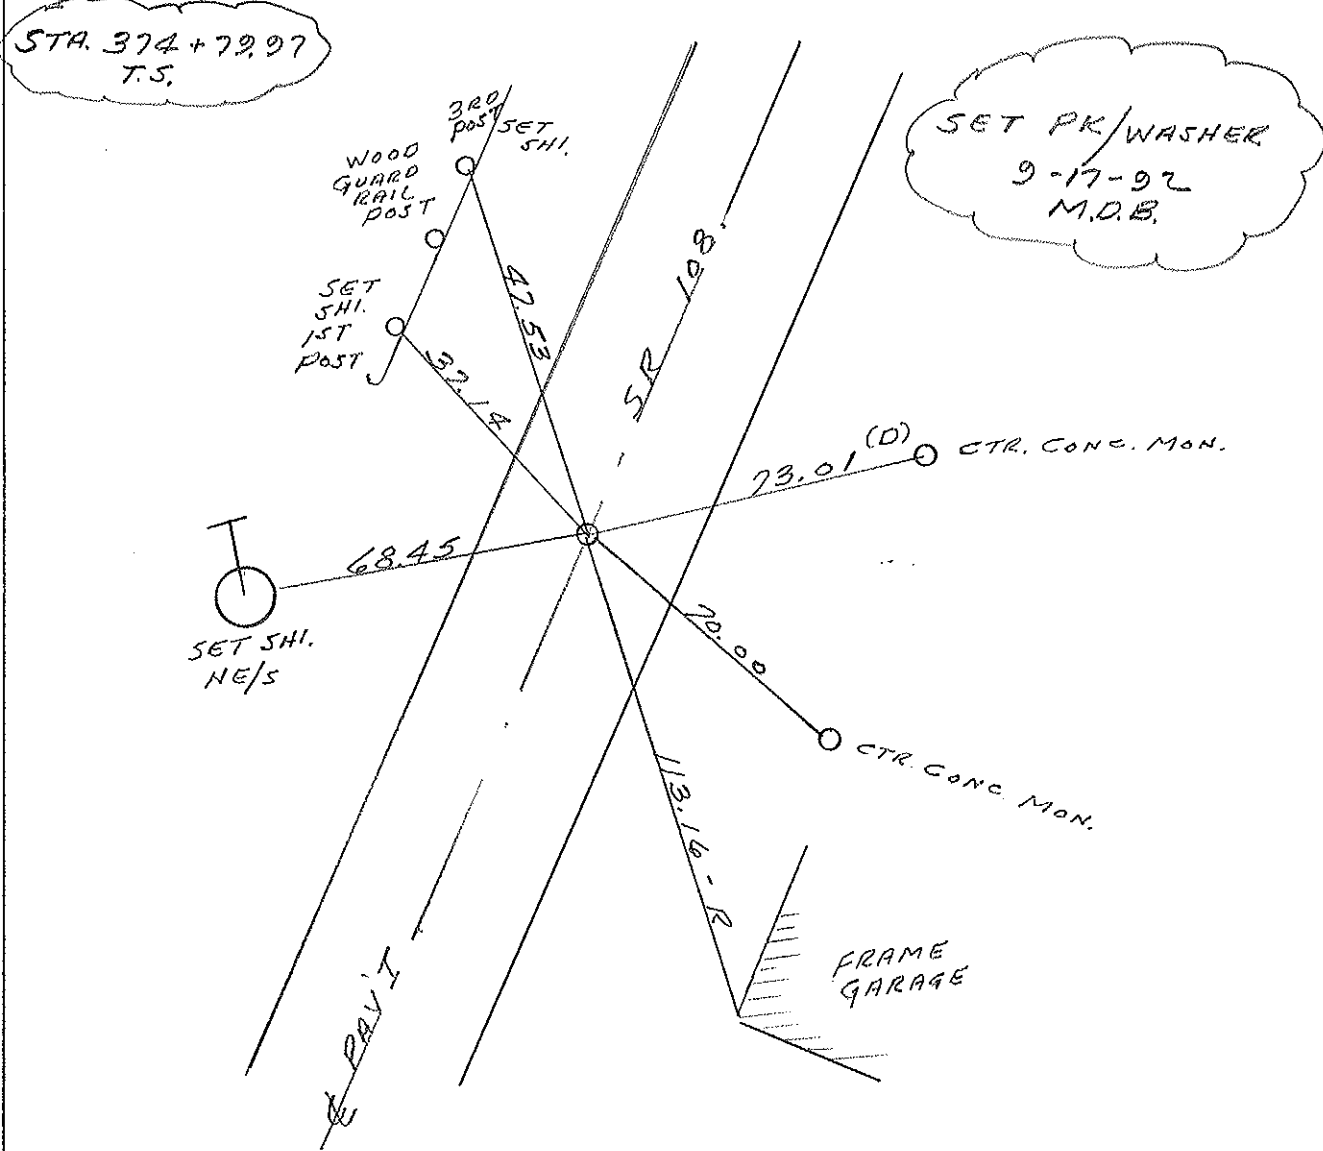

County HENRY S.R. 108

Township FLATROCK

Section 36

T4N, R6E

Personnel Hoffman

Loehrlke ITC


Houssholder RC

Barnhiser Notes

Date 6-27-84

Weather Partly Cloudy

Temp. +77°

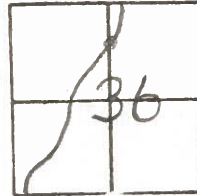


23

SLM 374+57
FD PK @ SURFACE
on E of 108
12.0 LT EP
11.5 RT EP


8-27-84
SET PK/WASHER
M.D.B.

Sta 374+79.97
T.S.

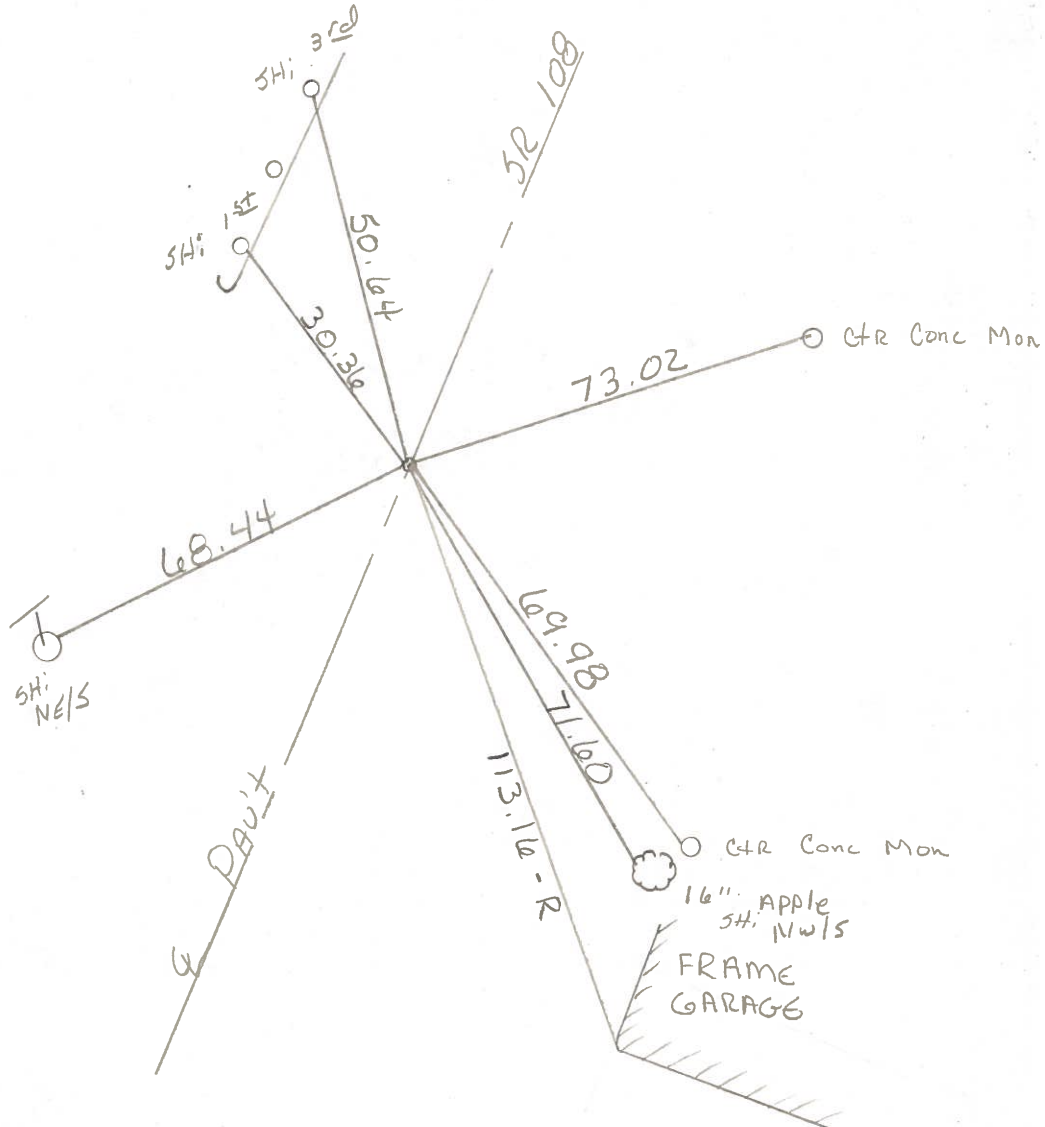


PERSONNEL	TITLE	PERSONNEL	TITLE	COUNTY	DATE
Tomsic				HENRY	July 24, 1974
Neuser				S. R. 108	WEATHER
Vandy				SEC. FLAT ROCK Twp.	TEMP.
Granata					

DESCRIPTION LEFT CENTER LINE RIGHT JOB NO.

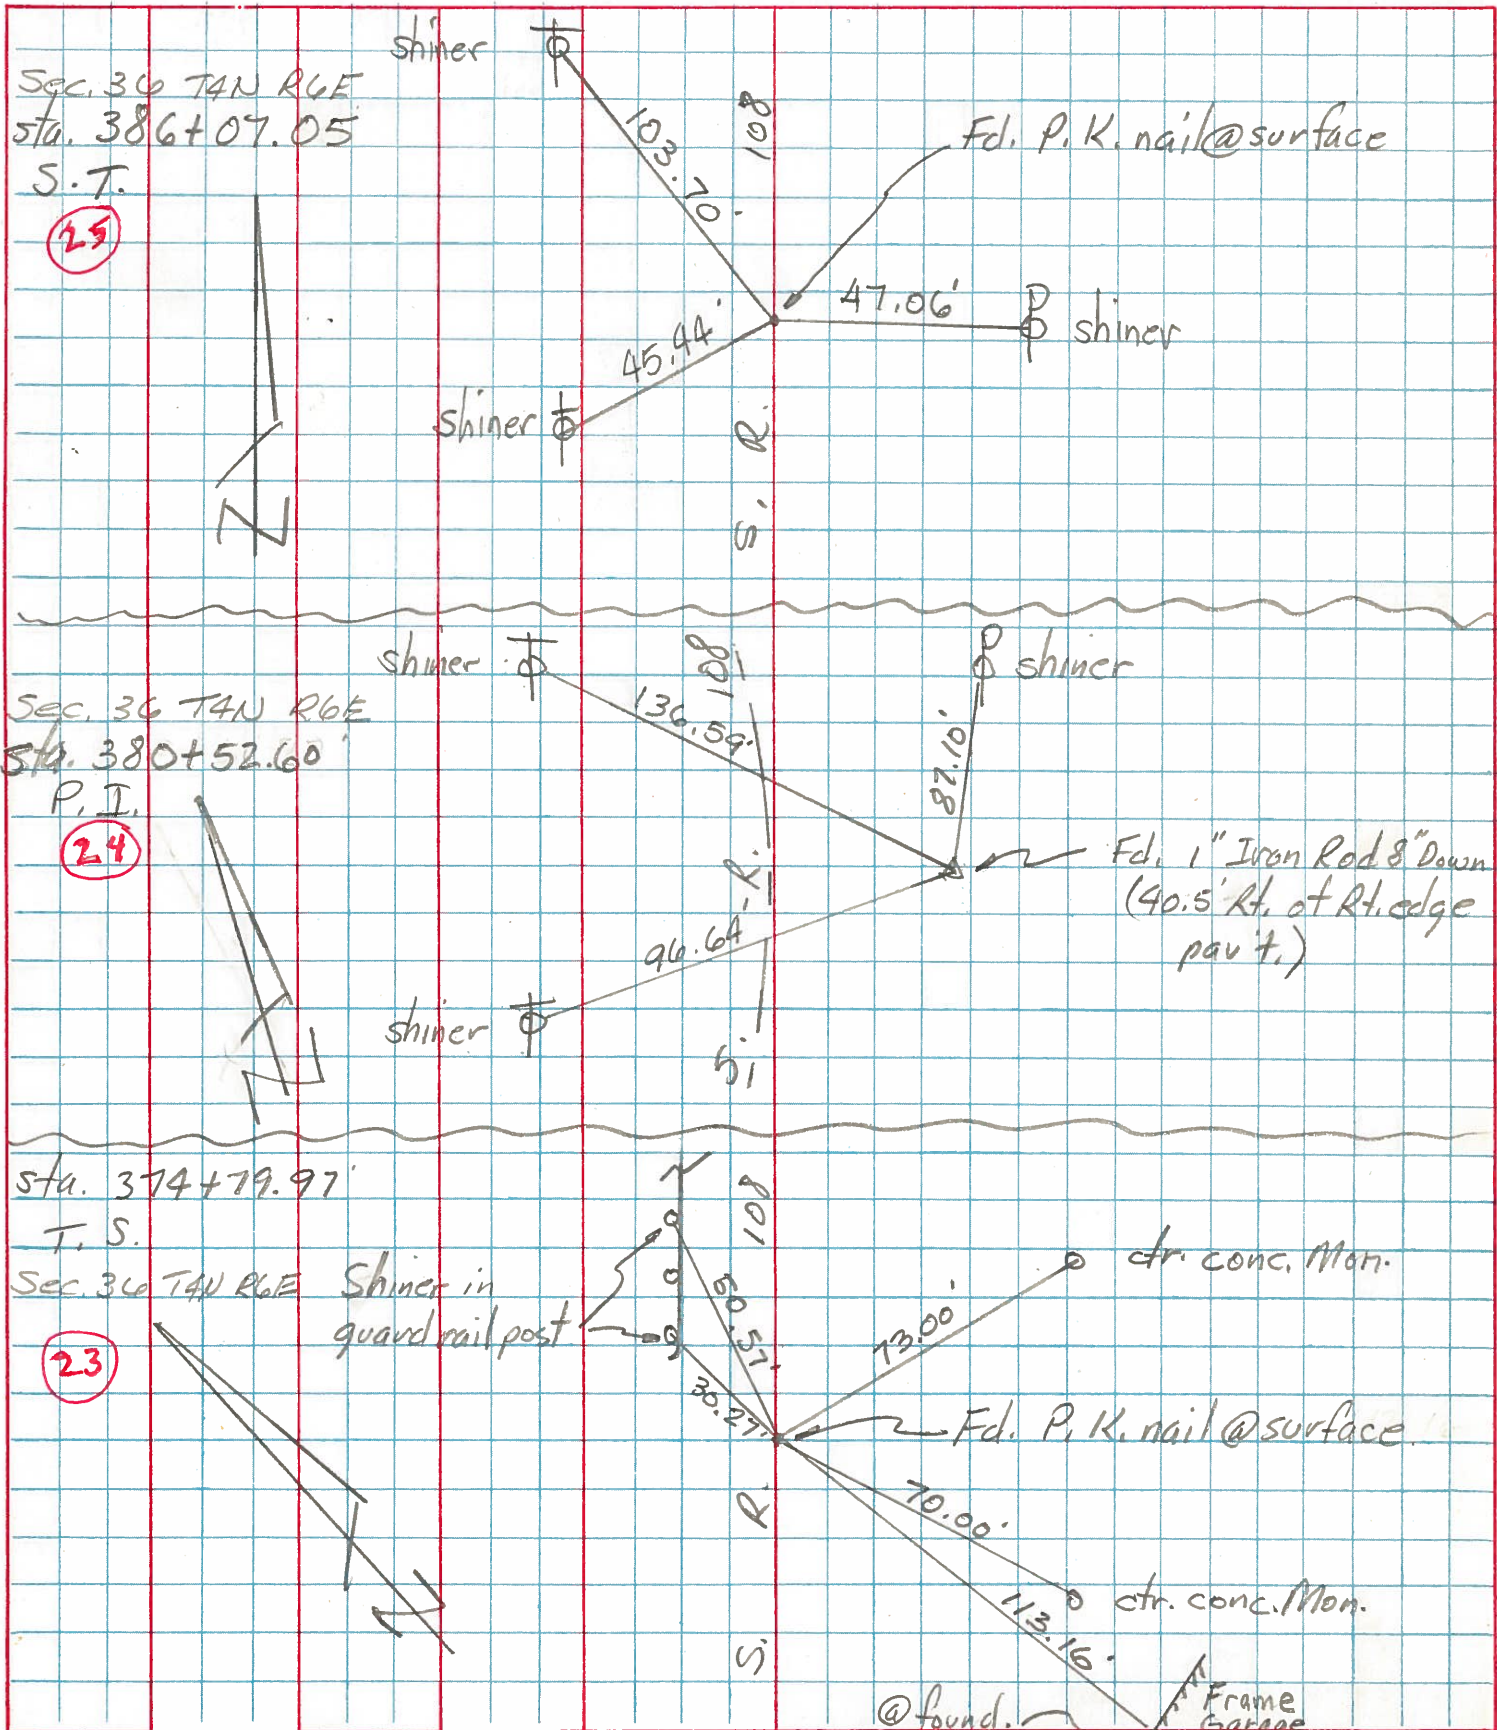

PERSONNEL Louys TITLE _____ PERSONNEL _____ TITLE _____ COUNTY Men DATE 6/2/71
Erikson Recorder _____ S. R. # 108 WEATHER Cloudy Fair
Rav _____ SEC. Halgat to Co Rd L TEMP. 70°
Shaw _____

DESCRIPTION Ref. P/W Plan 1958 Ties JOB NO. _____

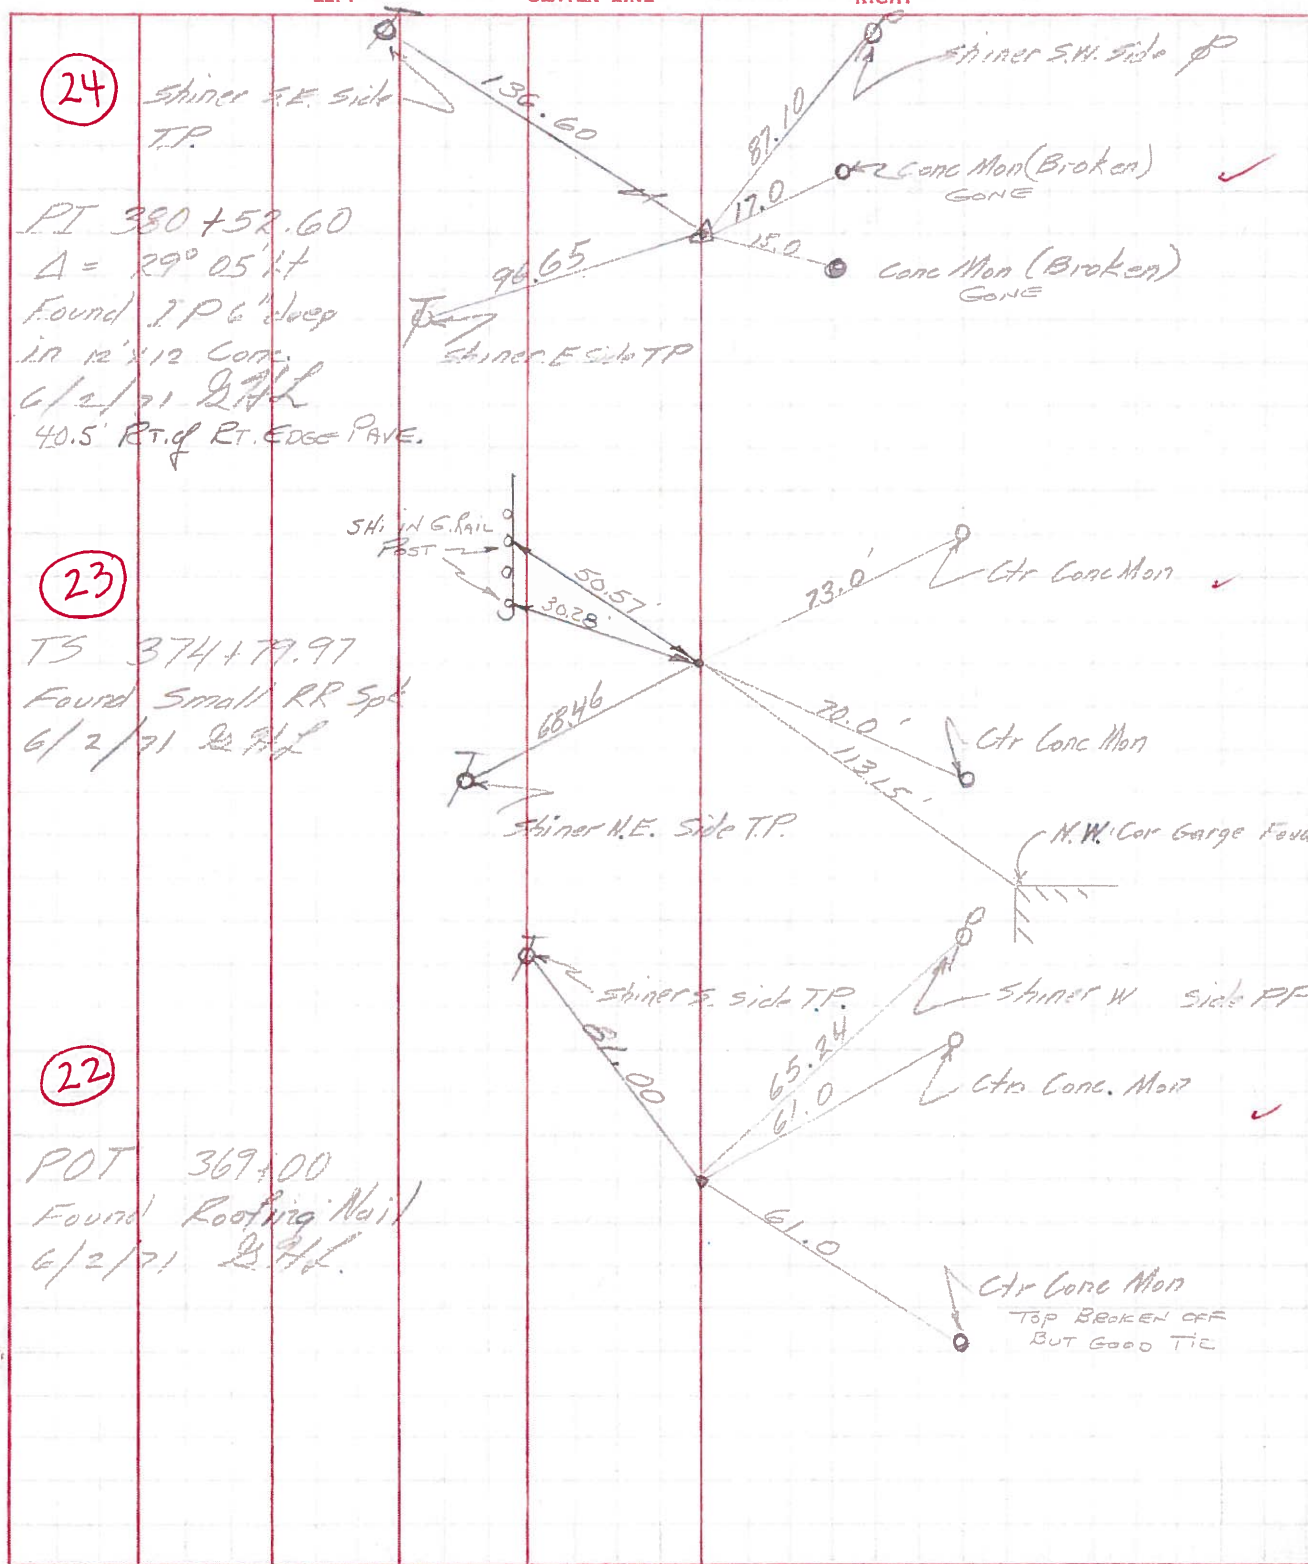

OK 5-4-72

OK 5-4-72

OK 5-4-72