

O.D.O.T. DISTRICT 2 SURVEY OFFICE (USE ONLY)

PERSONNEL

REFERENCE NO. 27

SHEET 13 OF 48

NOTES BALBAUGH

DATE 3/17/20

ROUTE SR 108

H.C. LEU

WEATHER CLOUDY

COUNTY HENRY

R.C. BALBAUGH

TEMP. 39°

TOWNSHIP FLATROCK

DWG BY BALBAUGH PID 94319

SECTION 25

T 4 N R 6 E

TYPE MONUMENT MONBOX W/ 1" IPIN

ON SURFACE - ~~BELOW~~ ON

OFFSET  $\text{C}$  PAVEMENT 2.5' LT : ~~RT~~

9.9' TO LT EDGE PAVEMENT


STATION: 396+68.71

HORZ.DATUM: NAD83 (2011)


GEOID: 2012A

GRID: NORTHING: 588356.556

EASTING: 1522879.044

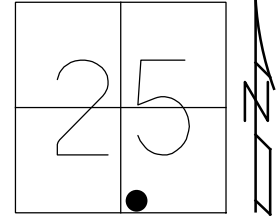

RECORD: P.I.  
 STA 396+84.19  
 FD MONBOX  
 DID NOT OPEN  
 8/18/92, MB  
 FD MONBOX  
 W/ 1" IPIN  
 REF27  
 11-5-18, JLL  
 FD MONBOX  
 W/1" IPIN  
 NEWREF27  
 10-20-20, DSA

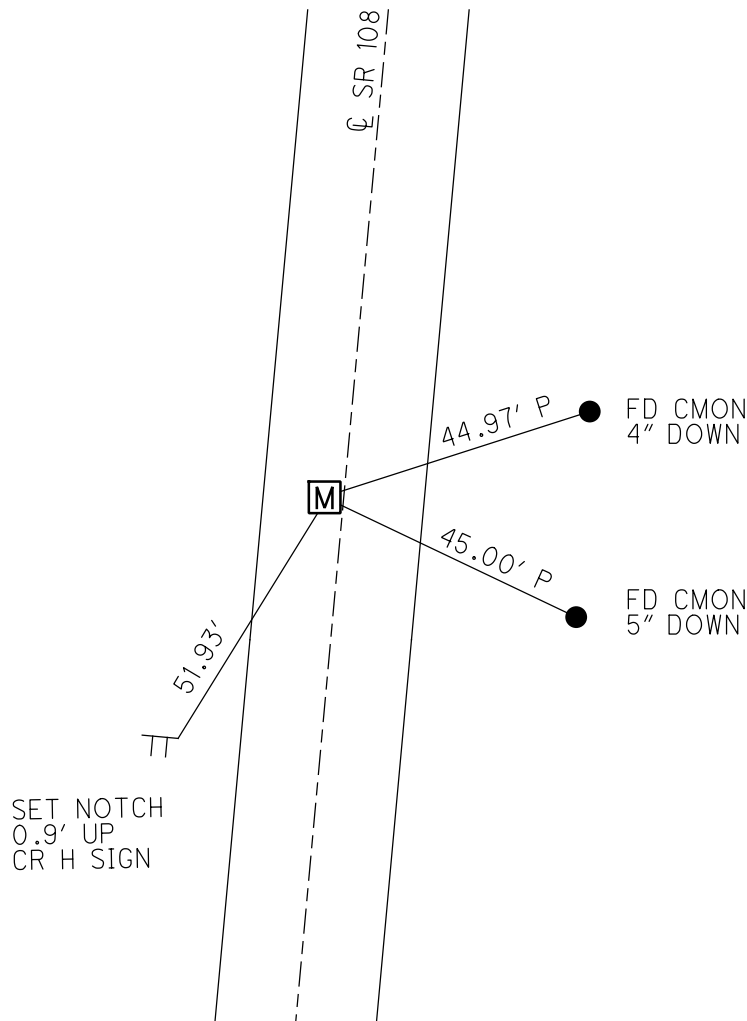

O.D.O.T. DISTRICT 2 SURVEY OFFICE

PERSONNEL

REFERENCE NO. 27

SHEET 32 OF 54

NOTES VAN DUJEN

H.C. KU52

DATE 8-18-92

ROUTE SR 108

R.C. BARNHISEL

WEATHER CLOUDY

COUNTY HENRY

TEMP. +75° F

TOWNSHIP FLAT ROCK

SECTION 25

T 4 N 6 E


TYPE MONUMENT Mon. Box

ON SURFACE - BELOW YES


LEFT - ℄ PAV'T. - RIGHT 1.3

2.2 TO LT EDGE PAVEMENT

S.L.M. 395+56

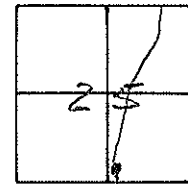

RECORDED  
STA. 394+84.19  
P.I.

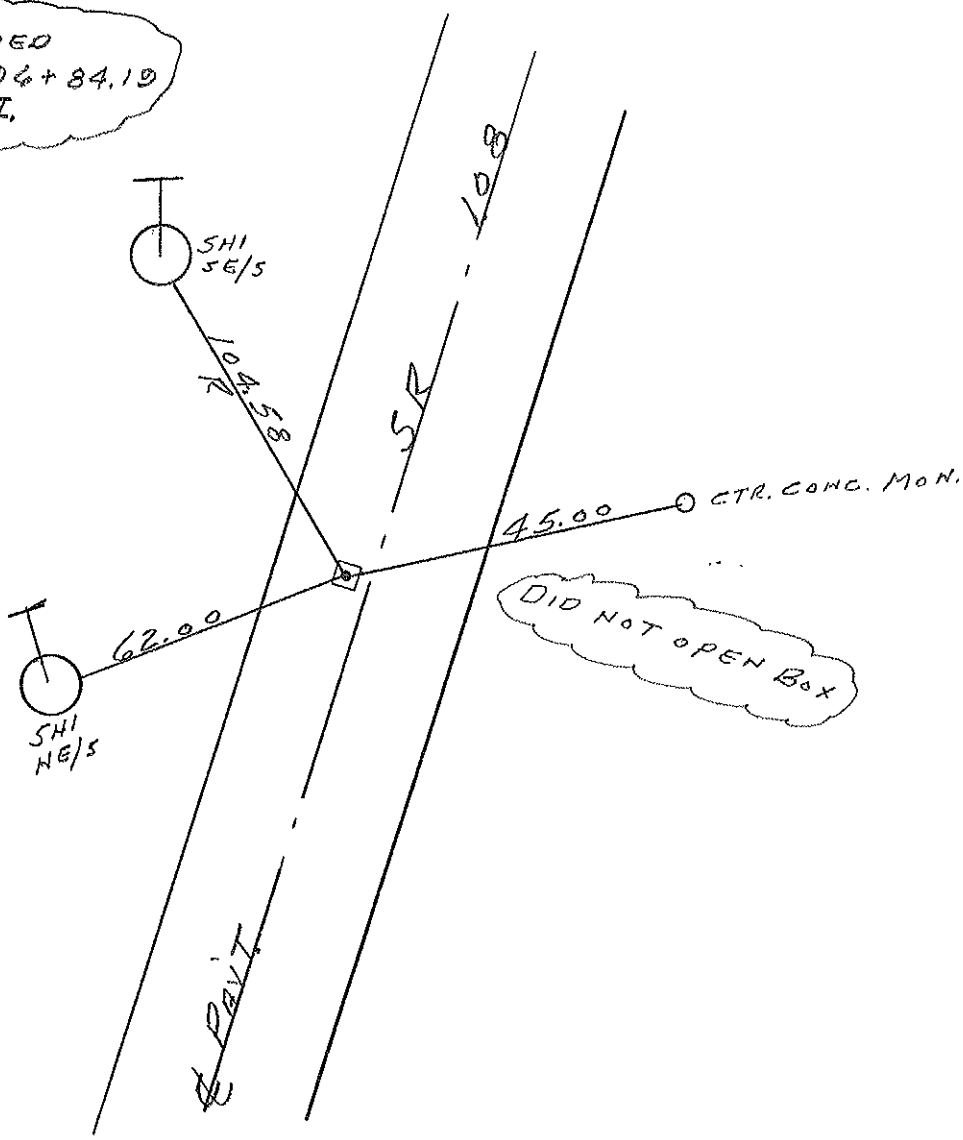

County HENRY S.R. 108

Township FLATROCK

Section 25


T4N, R6E

Personnel Hoffman  
Loehrke HC  
Householder RC  
Barnhisel Notes

Date 6-28-84

Weather Sunny

Temp. +82°

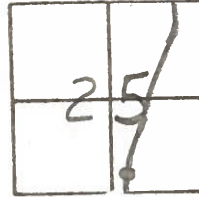


Mon Box

# 27


SLM 396+39  
 FD PIC @ SURFACE  
 2.6 LT OF E 108  
 13.8 RT EP  
 9.8 LT EP

Recorded  
 Sta 396+84.19  
 P.I.

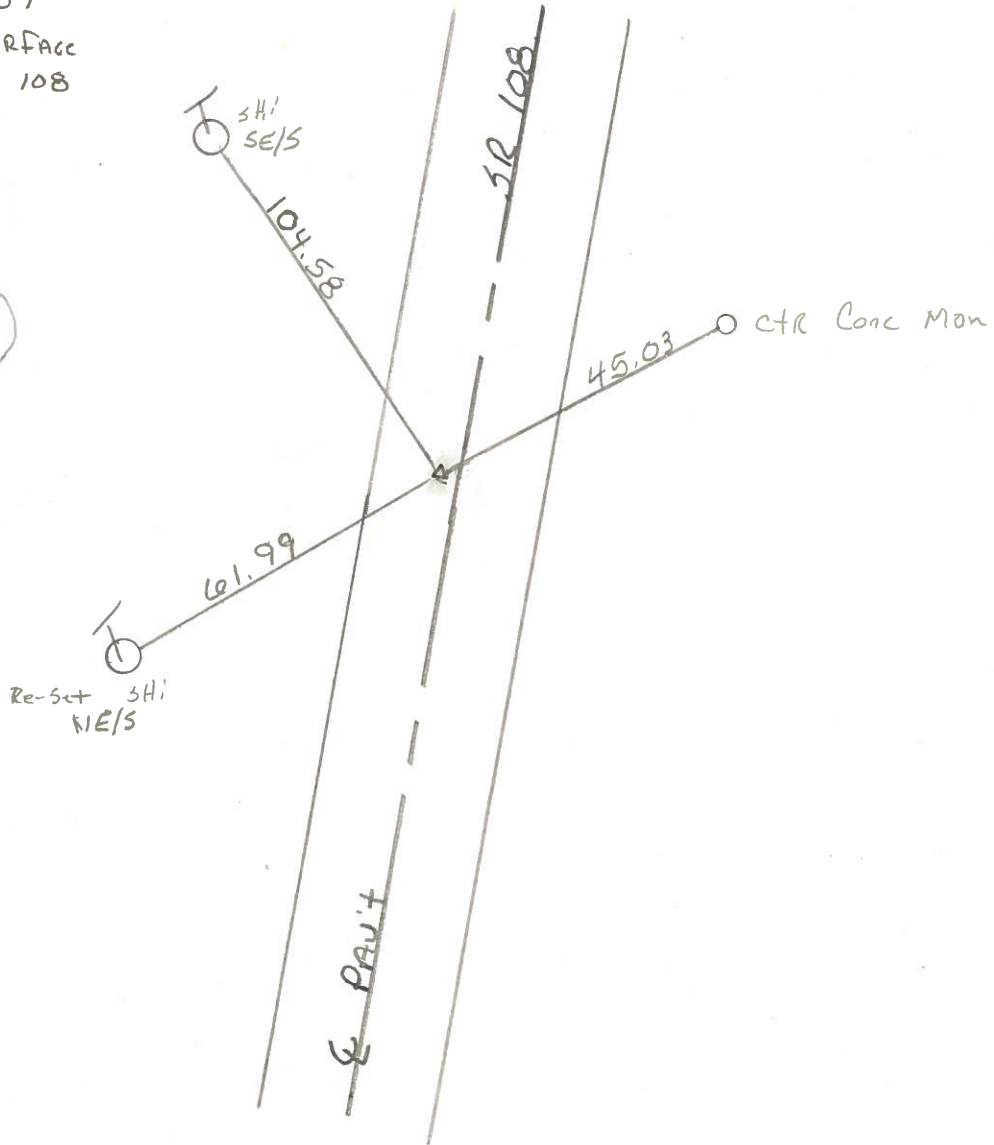

PERSONNEL	TITLE	PERSONNEL	TITLE	COUNTY	DATE	WEATHER	TEMP.
Tomsic				HENRY	July 24, 1974		
Neuser				S. R. 108			
Vanyo				SEC. Flatrock TWP.			
Granata							

DESCRIPTION	LEFT	CENTER LINE	RIGHT	JOB NO.
-------------	------	-------------	-------	---------

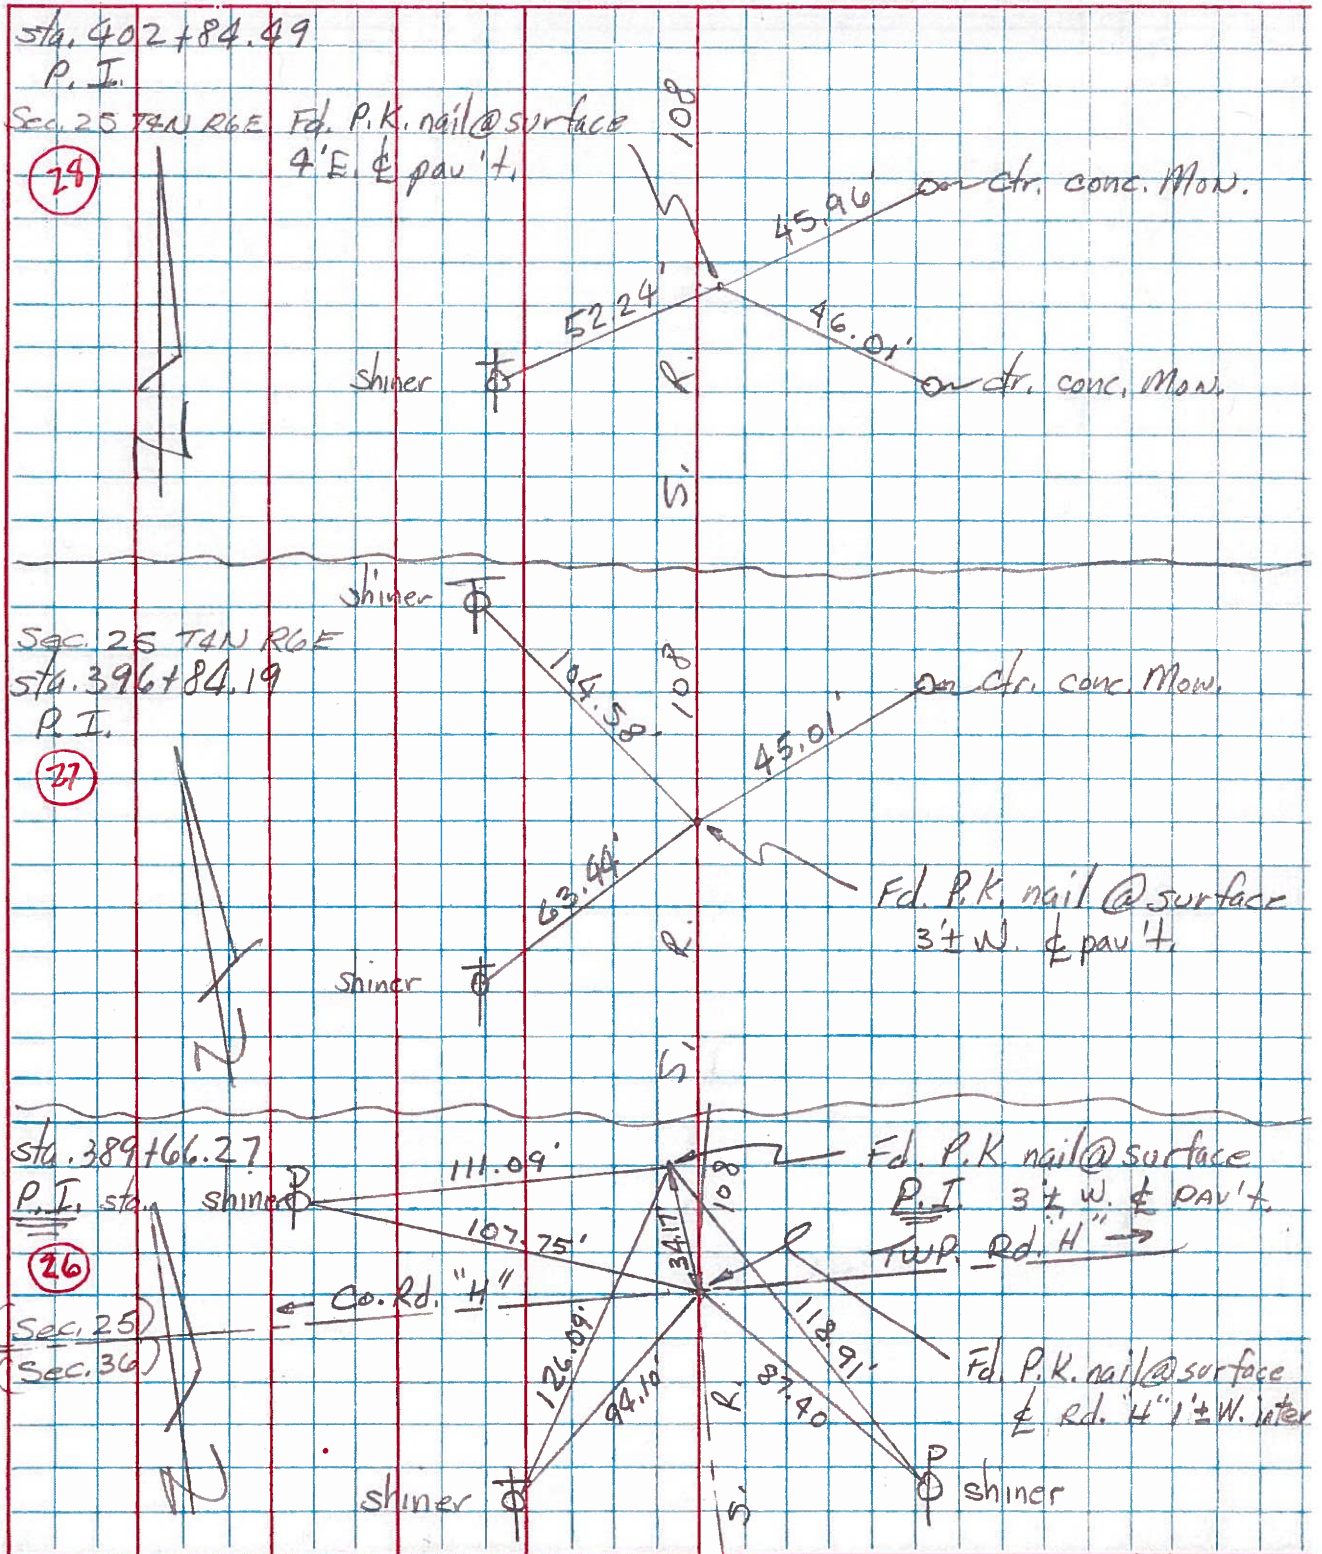

PERSONNEL TITLE PERSONNEL TITLE

Louvis

COUNTY Wi

DATE 6/3/71

Friksen Recorder

S. R. # 108

WEATHER Clear

Law

SEC. Holgate Co Rd L

TEMP. 80°

DESCRIPTION P.L. R/W Plan 1958

JOB NO.

