


O.D.O.T. DISTRICT 2 SURVEY OFFICE (USE ONLY)


PERSONNEL _____ REFERENCE NO. 28 SHEET 14 OF 48
 NOTES BALBAUGH DATE 3/17/20 ROUTE SR 108
 H.C. LEU WEATHER CLOUDY COUNTY HENRY
 R.C. BALBAUGH TEMP. 36° TOWNSHIP FLATROCK
 SECTION 25
 DWG BY BALBAUGH PID 94319 T 4 N R 6 E

TYPE MONUMENT MONBOX W/ 1" IPIN
 ON SURFACE - ~~BELOW~~ ON _____
 OFFSET \bar{C} PAVEMENT 4.4' ~~LT~~ : RT
8.5' TO RT EDGE PAVEMENT
 STATION: 402+68.71

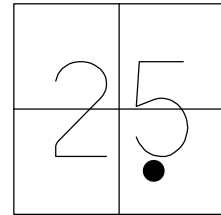

HORZ.DATUM: NAD83 (2011) GEOID: 2012A
 GRID: NORTHING: 588940.134 EASTING: 1523018.473

RECORD: P.I.
 STA 402+84.49
 $\Delta = 19^\circ 52' 30''$
 FD MONBOX
 DID NOT OPEN
 8/18/92, MB
 FD MONBOX
 W/ 1" IPIN
 REF28
 11-5-18, JLL
 FD MONBOX
 W/1" IPIN
 NEWREF28
 10-20-20, DSA

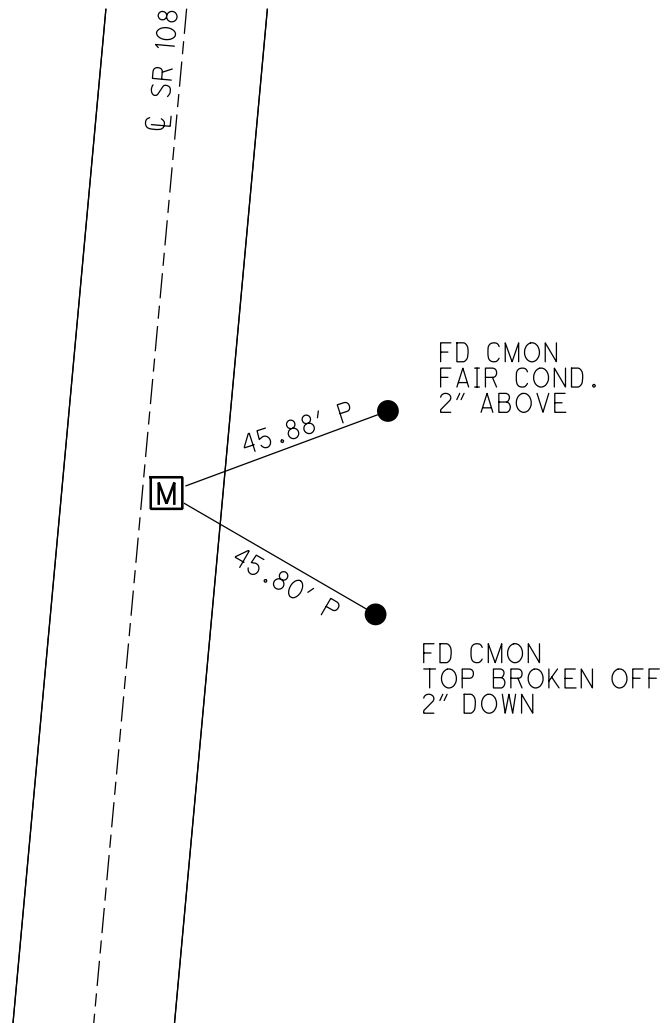

O.D.O.T. DISTRICT 2 SURVEY OFFICE

PERSONNEL

REFERENCE NO. 28

SHEET 33 OF 54

NOTES VAN DUSEN

H.C. KUSZ

R.C. BARNHISEL

DATE 8-18-92

WEATHER CLEAR

TEMP. +75°F

ROUTE SR 108

COUNTY HENRY

TOWNSHIP FLAT ROCK

SECTION 25

T4 NR 6 E


TYPE MONUMENT Man. Box

ON SURFACE - BELOW YES

LEFT - C PAV'T. - RIGHT 4.4


8.5 TO RT. EDGE PAVEMENT

S.L.M. 401 + 56

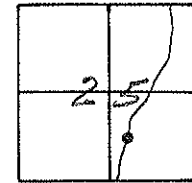

RECORDED
STA. 402 + 84.49
P.I.

DID NOT OPEN BOX

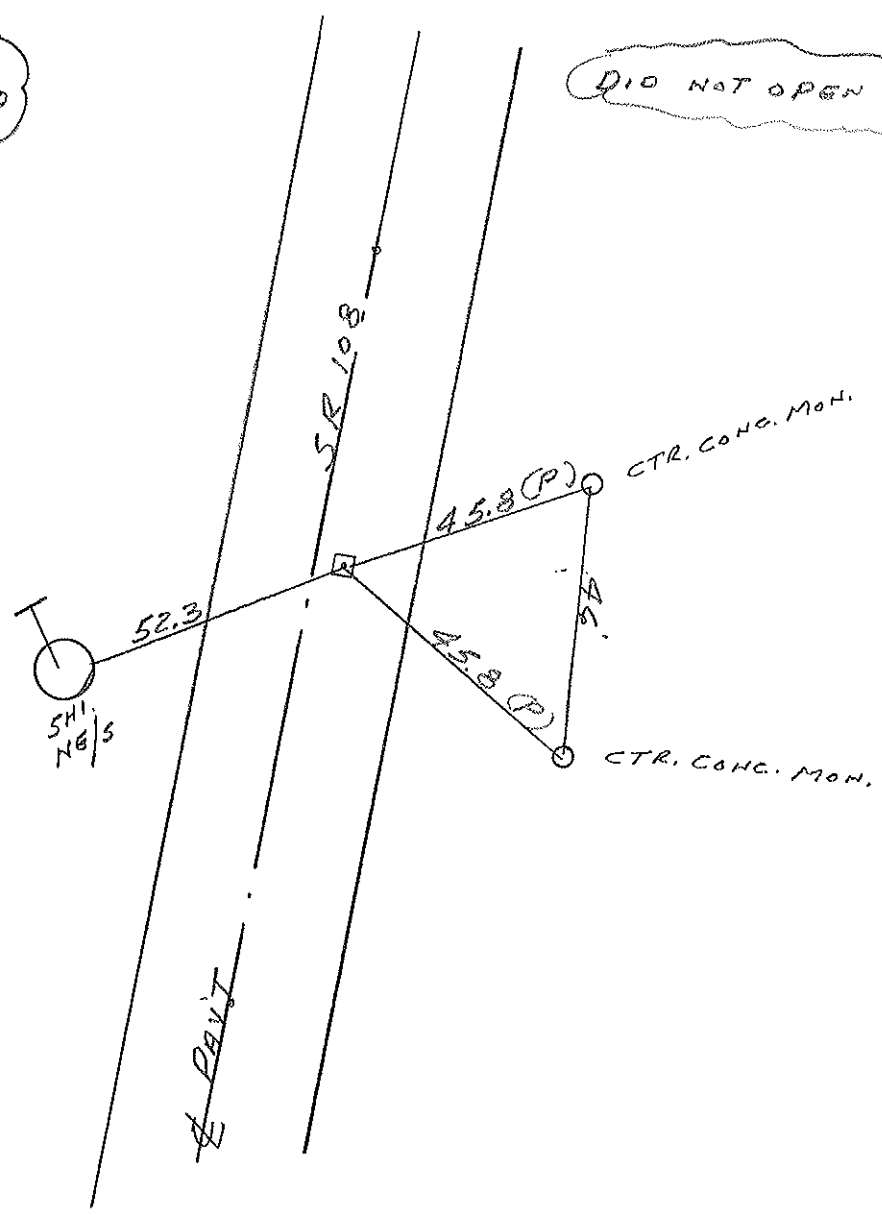

County Henry S.R. 108

Township Flatrock

Section 25

T4N, R6E

Personnel Hoffman

Loehrke HC


Householder RC

Barnhiser Notes

Date 6-28-84

Weather Sunny

Temp. +82°

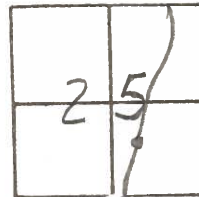

Mon Box

28

SLM 402+39

FD PK @ surface

4.1 Rt of E 108


7.5 Rt of EP

15.6 Lt of EP

Recorded


Sta. 402+84.49

P.I.

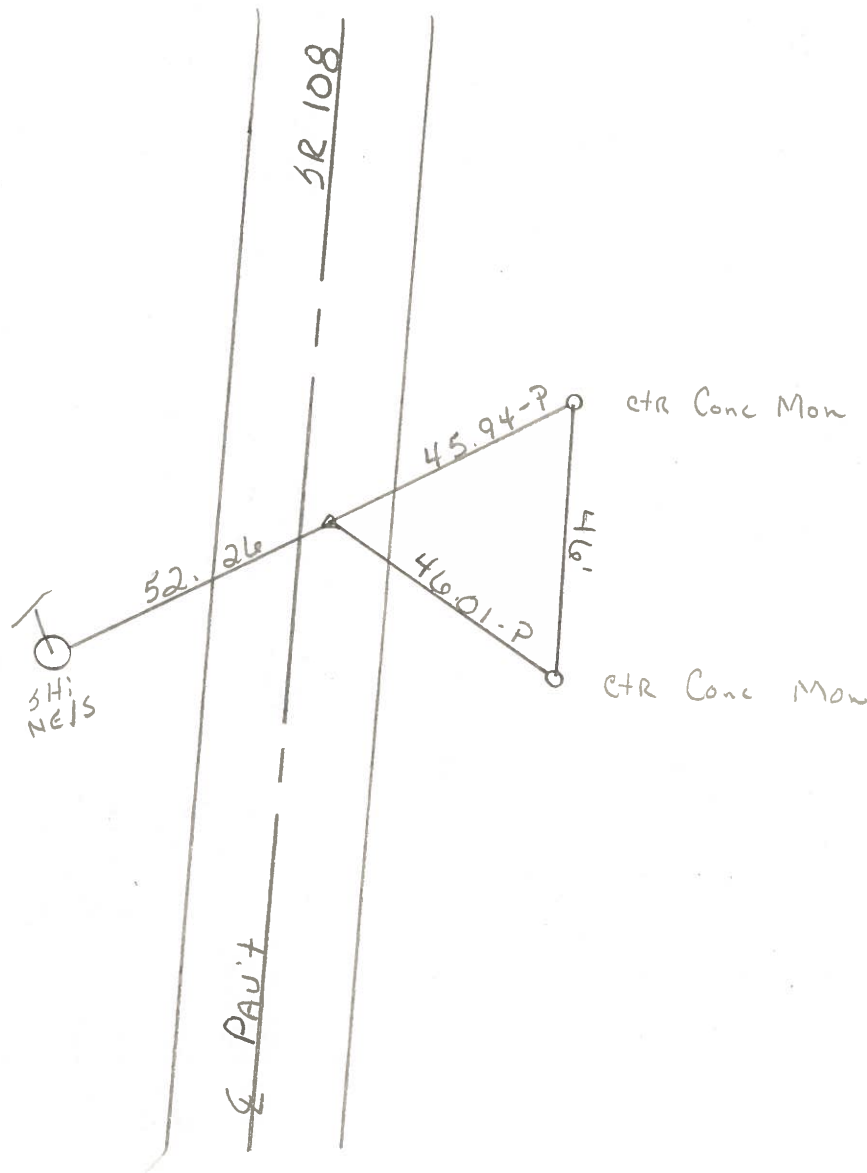


PERSONNEL	TITLE	PERSONNEL	TITLE	COUNTY	DATE	WEATHER	TEMP.
Tomsic				HENRY	July 24, 1974		
Neuser				S. R. 108			
Vanyo				SEC. Flatrock TWP.			
Granata							

DESCRIPTION LEFT CENTER LINE RIGHT JOB NO.

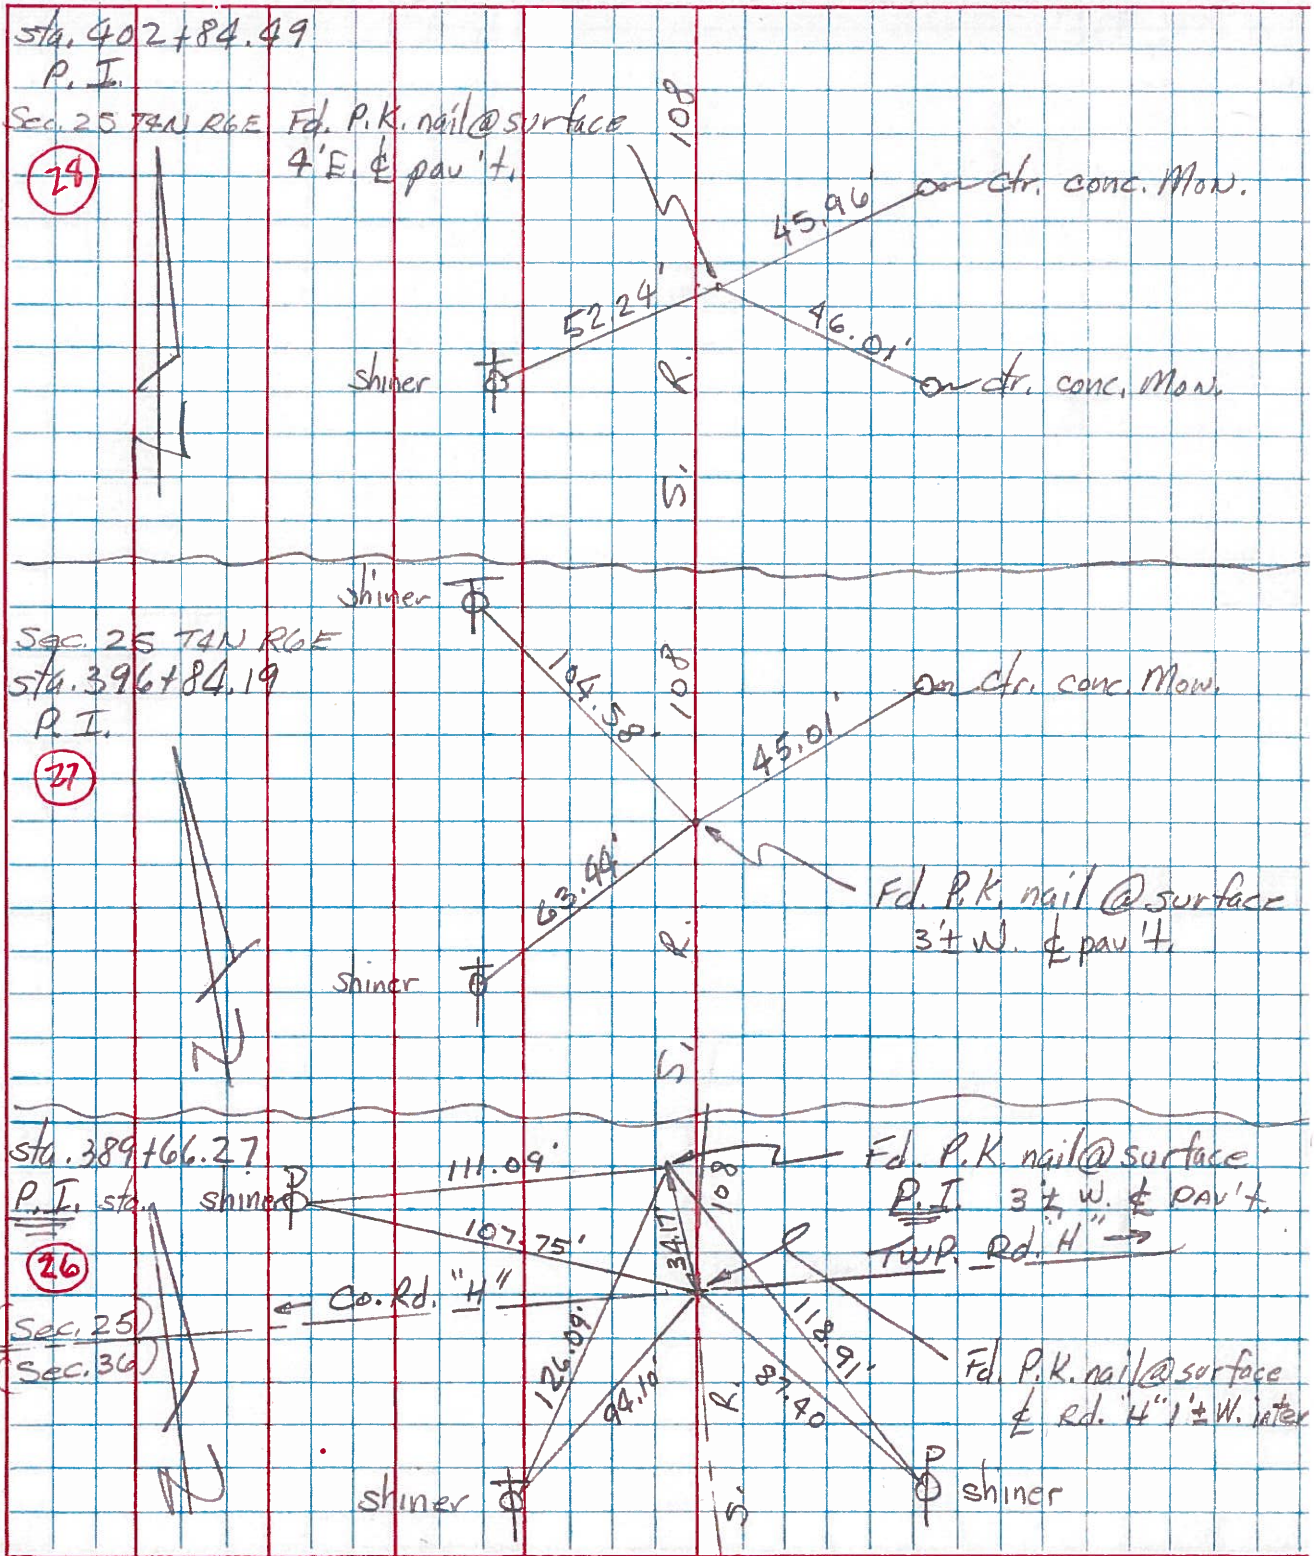

PERSONNEL	TITLE	PERSONNEL	TITLE	COUNTY	DATE
<u>Louys</u>				<u>Hen</u>	<u>6/3/71</u>
<u>Friksen</u>	<u>Recorder</u>			S. R. # <u>108</u>	WEATHER <u>Fair</u>
<u>Rav</u>				SEC. <u>Holgate to Co Rd 2</u>	TEMP. <u>80°</u>
<u>Shaw</u>					
DESCRIPTION	<u>Ref R/W Plan 1958</u>			JOB NO.	
	LEFT	CENTER LINE	RIGHT		

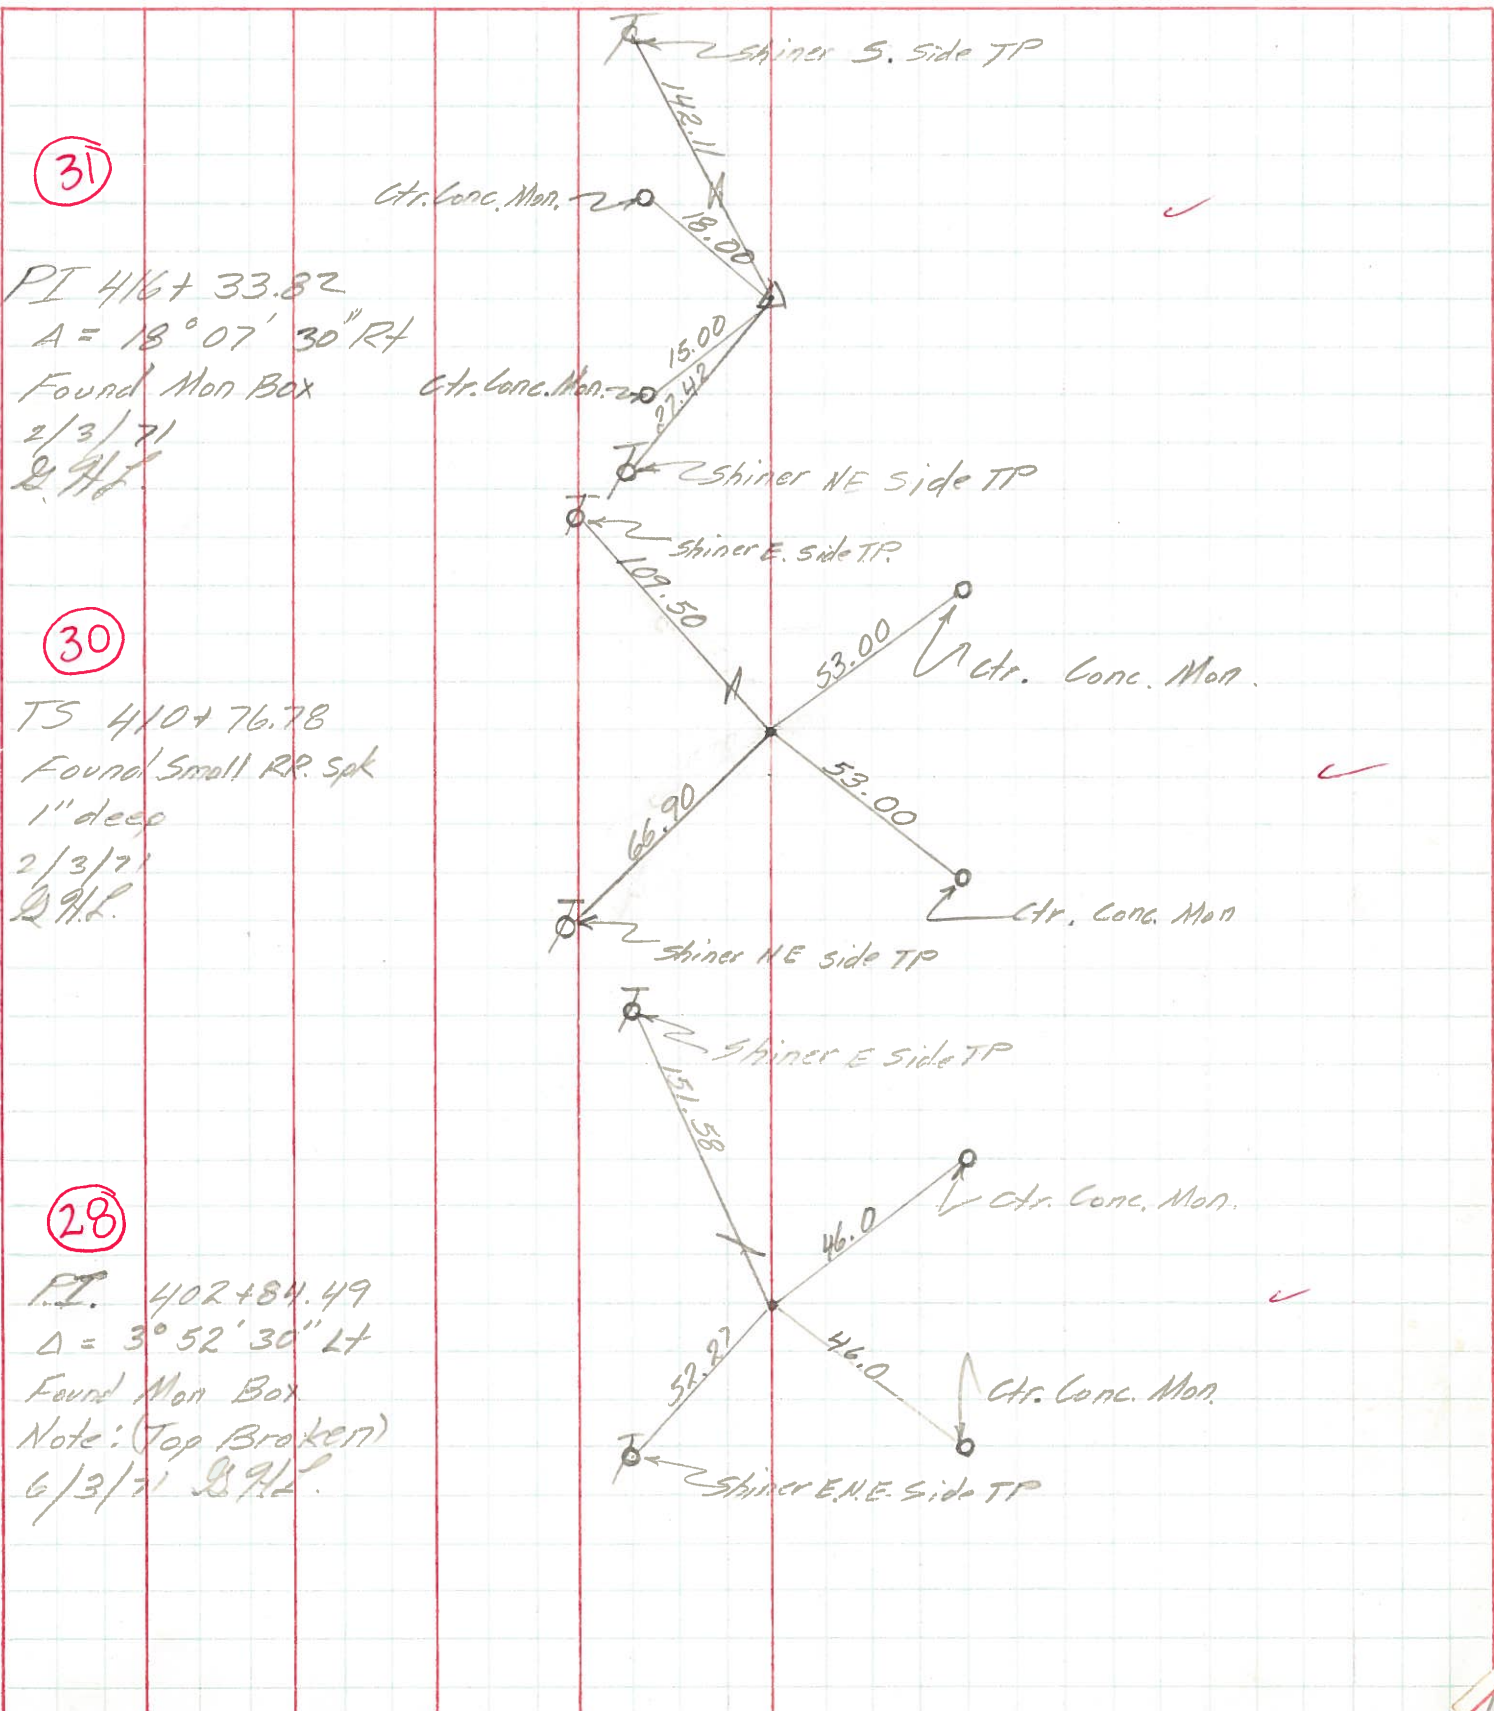

(31)

PI 416+33.82
 A = 18°07'30" RT
 Found Mon Box
 2/3/71
 2 9/16

(30)

TS 410+76.78
 Found Small RR Spk
 1" deep
 2/3/71
 2 9/16

(28)

P.I. 402+84.49
 Δ = 3°52'30" LT
 Found Mon Box
 Note: (Top Broken)
 6/3/71 2 9/16