


O.D.O.T. DISTRICT 2 SURVEY OFFICE (USE ONLY)


PERSONNEL _____ REFERENCE NO. 30 SHEET 15 OF 48
 NOTES VAN DUSEN DATE 8/18/92 ROUTE SR 108
 H.C. KUSZ WEATHER CLEAR COUNTY HENRY
 R.C. BARNHISEL TEMP. 75° TOWNSHIP FLATROCK
 SECTION 25
 DWG BY MILLER PID 94319 T 4 N R 6 E

TYPE MONUMENT P.K./WASHER
 ON SURFACE - ~~BELOW~~ ON _____
 OFFSET Q PAVEMENT 0.7' LT : ~~RT~~
11.6' TO LT EDGE PAVEMENT
 STATION: 410+60.14

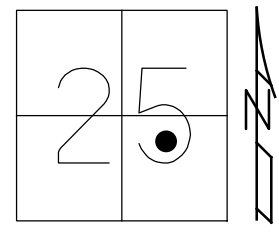

HORZ.DATUM: _____ GEOID: _____
 GRID: NORTHING: _____ EASTING: _____

RECORD: T.S.
 STA 410+76.78
 FD P.K./WASHER
 8/18/92, MB
 SET P.K./WASHER
 9-17-92, MB
 D.N.F.
 11-5-18, JLL

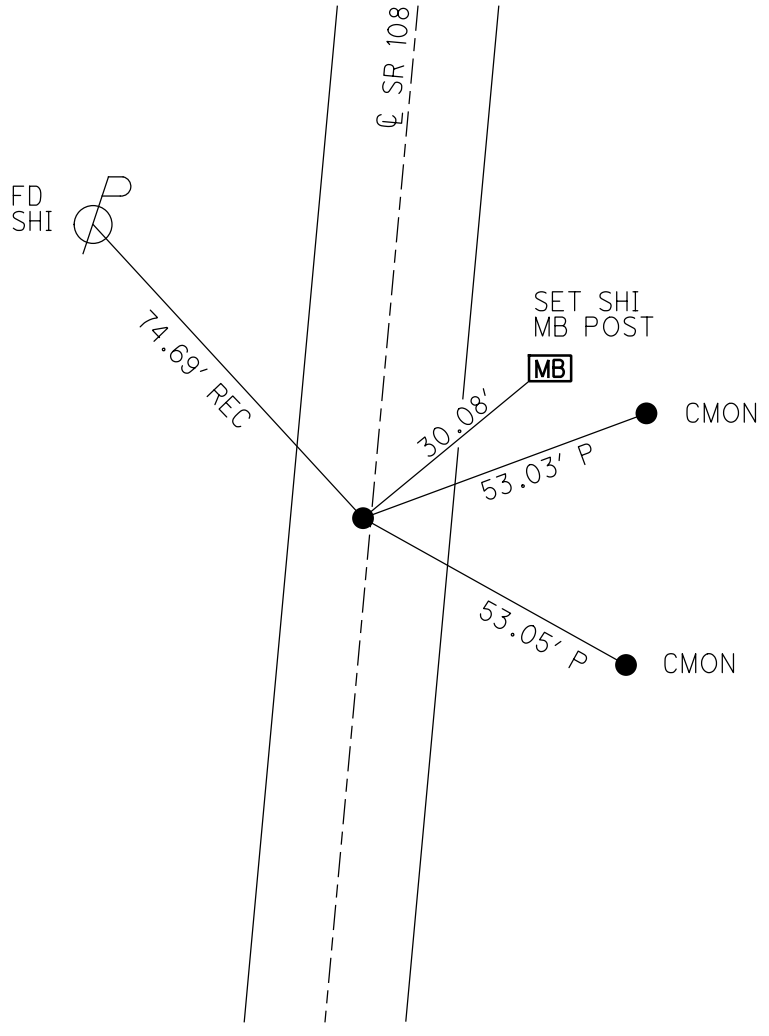

O.D.O.T. DISTRICT 2 SURVEY OFFICE

PERSONNEL

REFERENCE NO. 30

SHEET 34 OF 54

NOTES VAN DUEN

H.C. KUSZ

R.C. BARNHISEL

DATE 8-18-92

WEATHER CLEAR

TEMP. +75°F

ROUTE SR 108

COUNTY HENRY

TOWNSHIP FLATROCK

SECTION 25

T4 N R 6 E


TYPE MONUMENT PK/WASHER

ON SURFACE - BELOW YES

LEFT - € PAV'T. - RIGHT 0.7


116 TO LT. EDGE PAVEMENT

S.L.M. 409+53

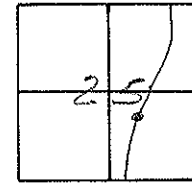

RECORDED
STA. 410+76.78
T.S.

SET PK/WASHER
9-17-02
M.B.

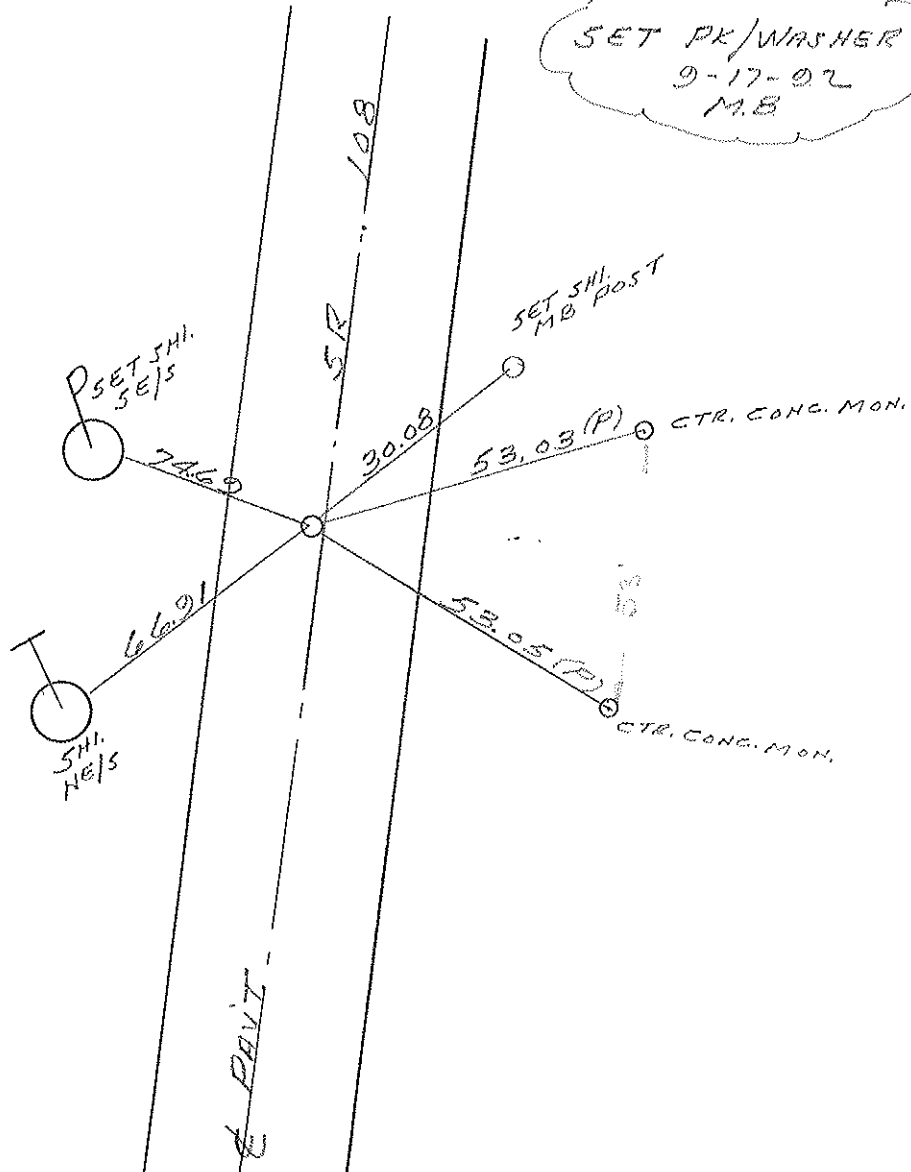

County HENRY S.R. 108

Township FLATROCK

Section 25

T4N, R6E

Personnel HOFFMAN

Loehrke HC


Householder RG

Barnissel Notes

Date 6-28-84

Weather Sunny

Temp. +82°

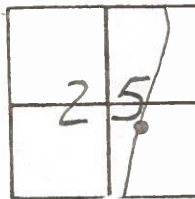

30

SLM 410+31

on E of 108

11.8 Rt of EP


11.7 Lt of EP

8-28-84
SET PK/WASHER
M.D.B.

Recorded

Sta. 410+74.78


T.S.

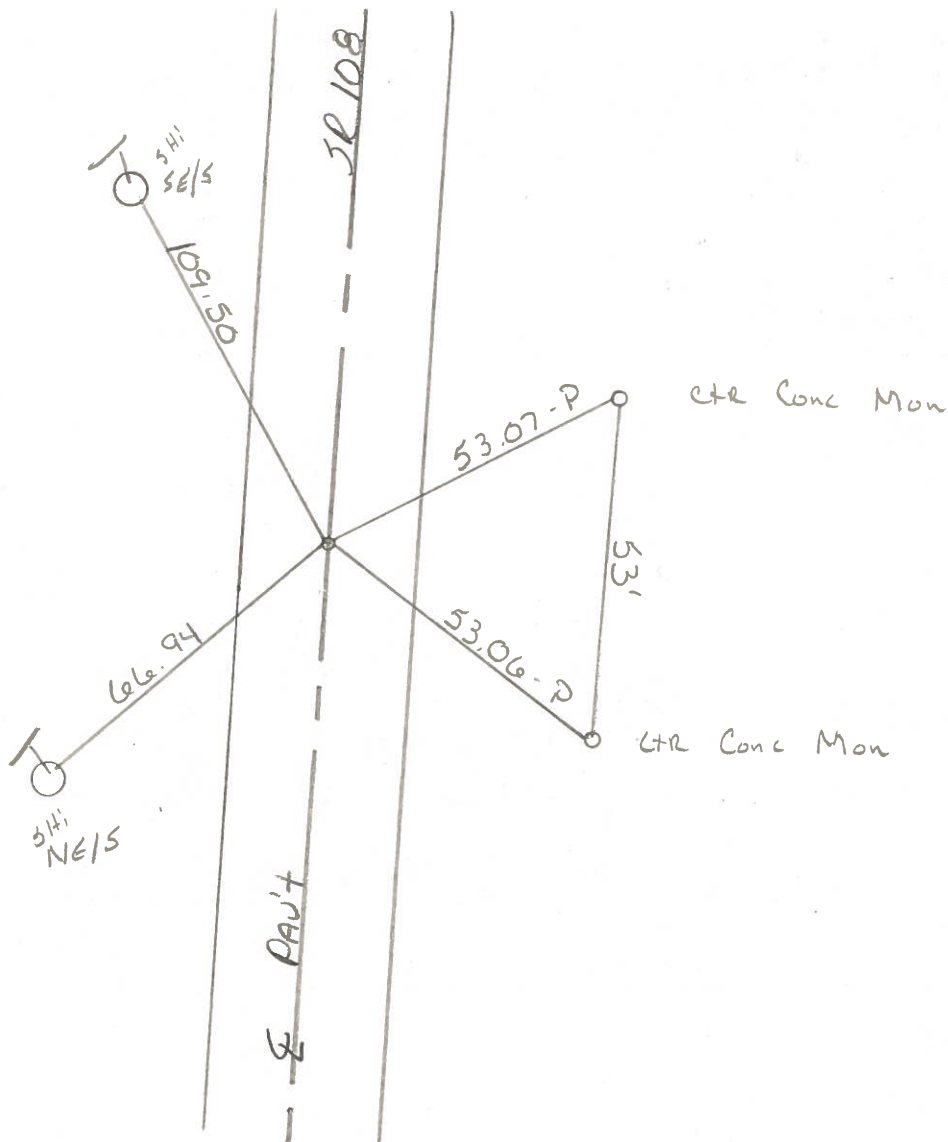

PERSONNEL	TITLE	PERSONNEL	TITLE
Tamsie			
Neuser			
Vanyo			
Granata			

COUNTY HENRY DATE July 25, 1974
 S. R. 108 WEATHER _____
 SEC. Flatrock TWP. TEMP. _____

DESCRIPTION _____ LEFT _____ CENTER LINE _____ RIGHT _____ JOB NO. _____

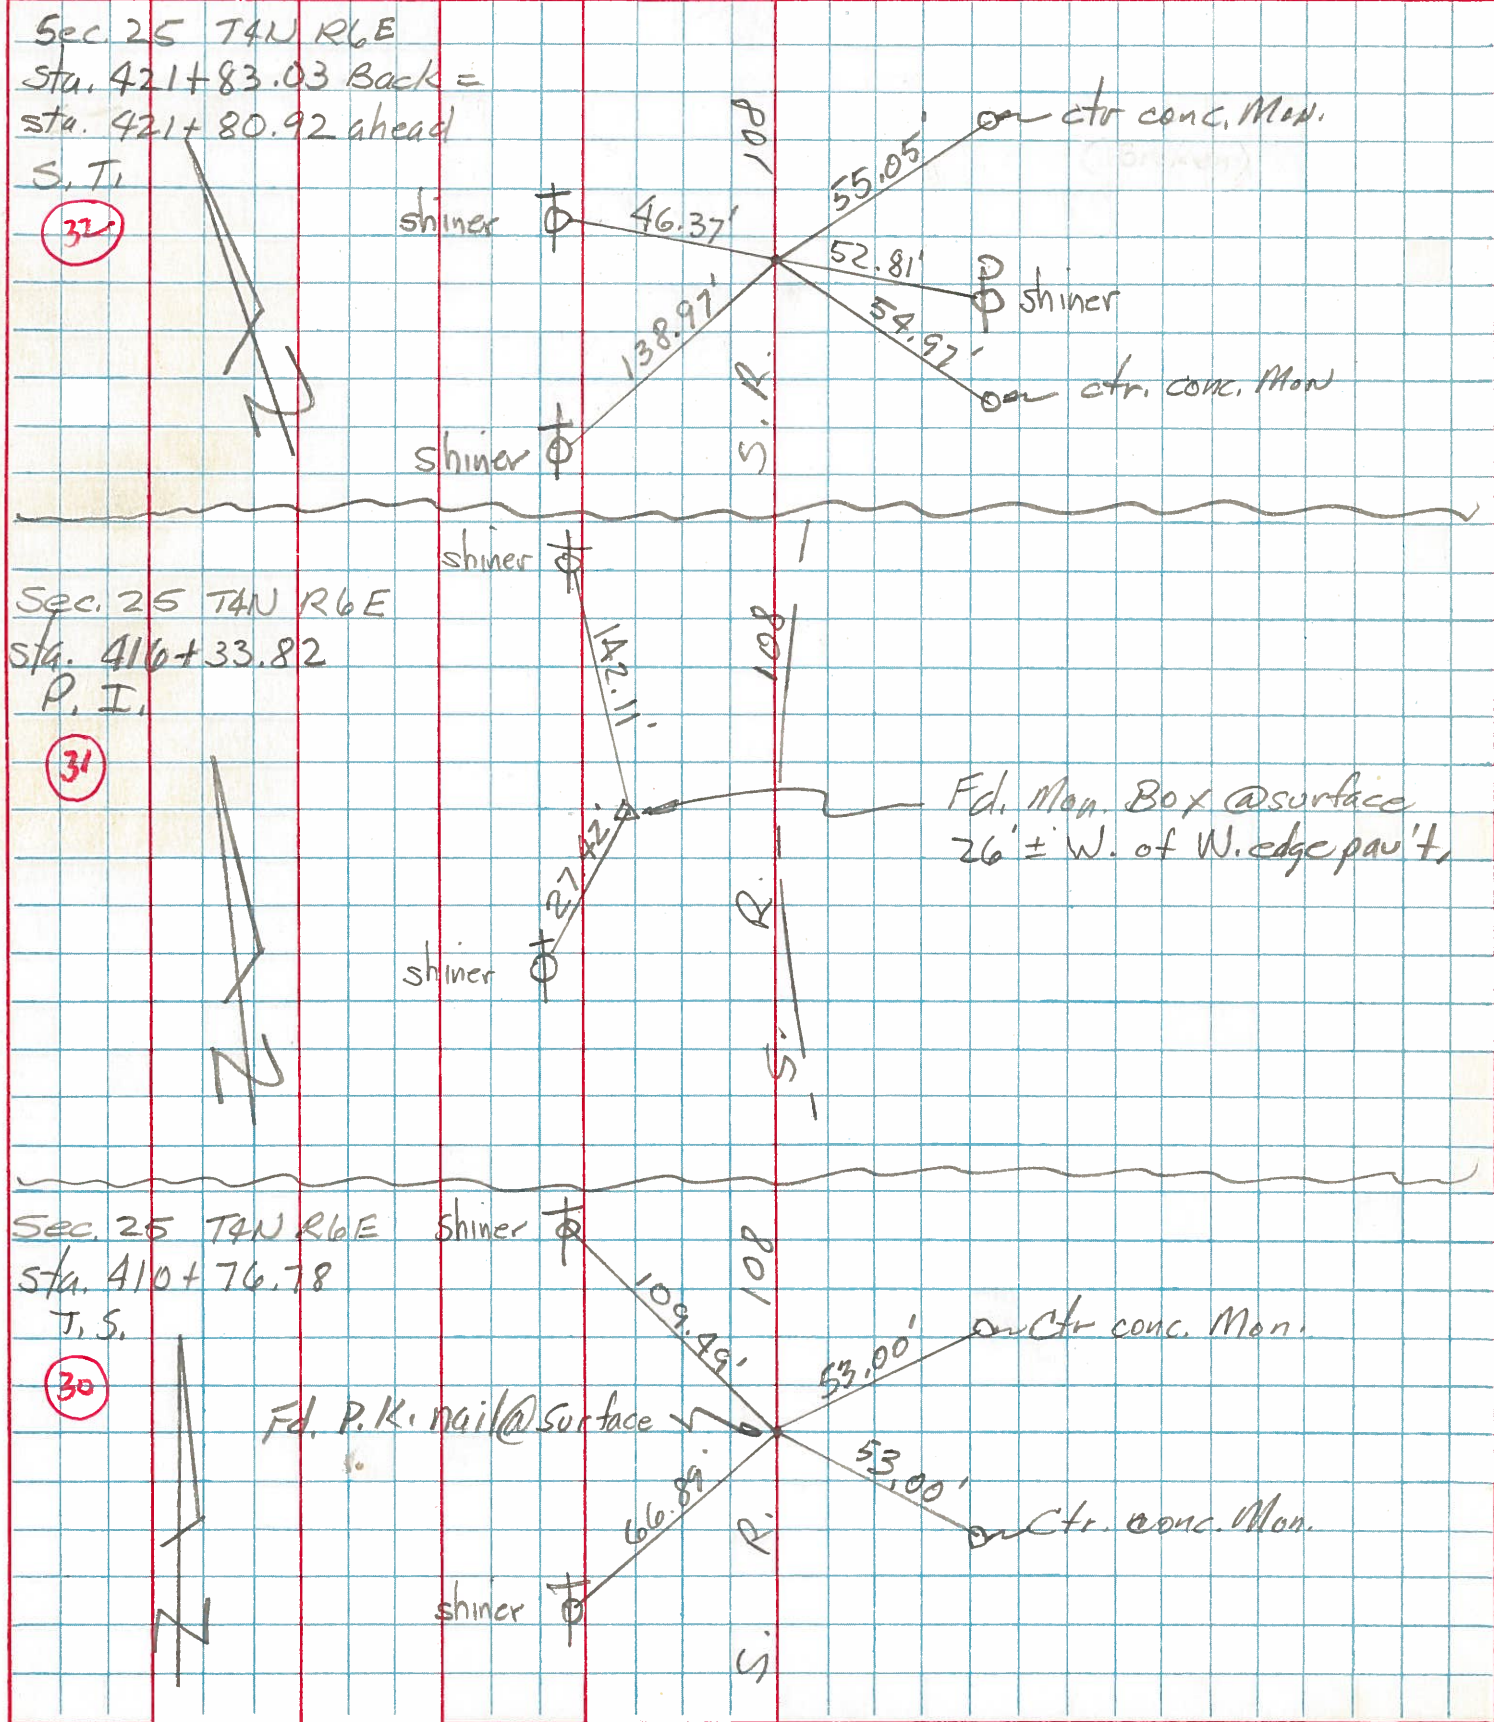

PERSONNEL TITLE PERSONNEL TITLE COUNTY Hen DATE 6/3/71

Louys Recorder S. R. # 108 WEATHER Fair

Ray SEC. Holgate to Co Rd 2 TEMP. 80°

Shaw DESCRIPTION R-1 R/W Plan 1958 JOB NO. _____

LEFT CENTER LINE RIGHT

