


O.D.O.T. DISTRICT 2 SURVEY OFFICE (USE ONLY)


PERSONNEL _____ REFERENCE NO. 31 SHEET 16 OF 48
 NOTES BALBAUGH DATE 3/17/20 ROUTE SR 108
 H.C. LEU WEATHER CLOUDY COUNTY HENRY
 R.C. BALBAUGH TEMP. 36° TOWNSHIP FLATROCK
 SECTION 25
 DWG BY BALBAUGH PID 94319 T 4 N R 6 E

TYPE MONUMENT MONBOX W/ 1" IPIN
 ON SURFACE - ~~BELOW~~ ON
 OFFSET Q PAVEMENT 37.5' LT : ~~RT~~
- TO - EDGE PAVEMENT
 STATION: 416+15.66

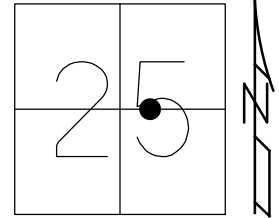

HORZ. DATUM: NAD83 (2011) GEOID: 2012A
 GRID: NORTHING: 590270.675 EASTING: 1523242.371

RECORD: P.I.
 STA 416+33.82
 $\Delta = 18^\circ 07' 30''$
 FD MONBOX
 DID NOT OPEN
 8/18/92, MB
 FD MONBOX
 W/1" IPIN
 REF31
 11-5-18, JLL

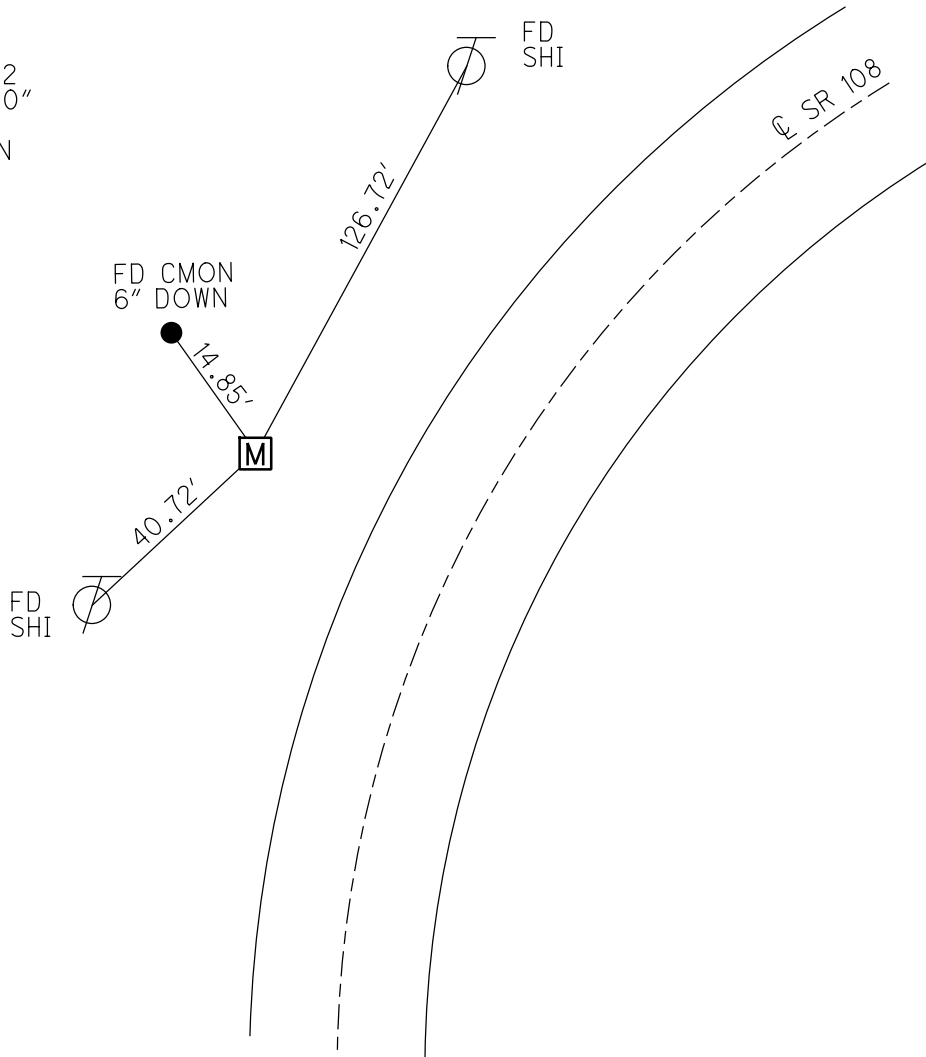

O.D.O.T. DISTRICT 2 SURVEY OFFICE

PERSONNEL

REFERENCE NO. 31

SHEET 35 OF 54

NOTES VAN DUSEN

H.C. KUSZ

R.C. BARNHISEL

DATE 8-18-92

WEATHER CLEAR

TEMP. +75° F

ROUTE SR 108

COUNTY HENRY

TOWNSHIP FLAT ROCK

SECTION 25

T4 N R 6 E


TYPE MONUMENT MON. BOX

ON SURFACE - BELOW YES


LEFT - CL PAV'T. - RIGHT 37.5

TO EDGE PAVEMENT

S.L.M. 414+98

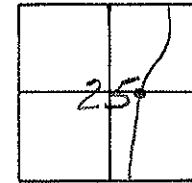

RECORDED
STA. 414+33.82
P.I.

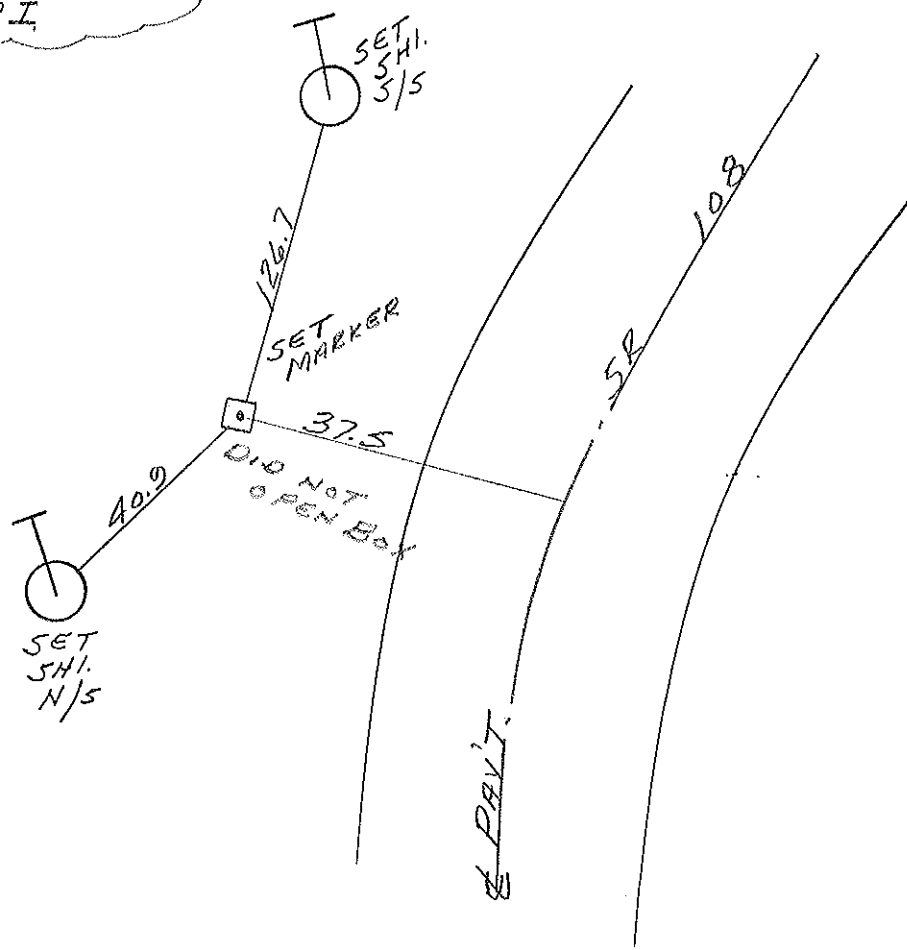

County Henry S.R. 108

Township Flatrock

Section 25

T4N, R6E

Personnel Hoffman

Lochrke HC


Householder RC

Barnhisel Notes

Date 6-28-84


Weather Sunny

Temp. +82°

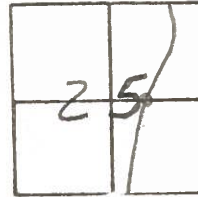


31 SLM 415+83
 37.5 Lt of E 108
 FD Man. Box @ Surface

Recorded
 Sta 416+33.82
 P.I.

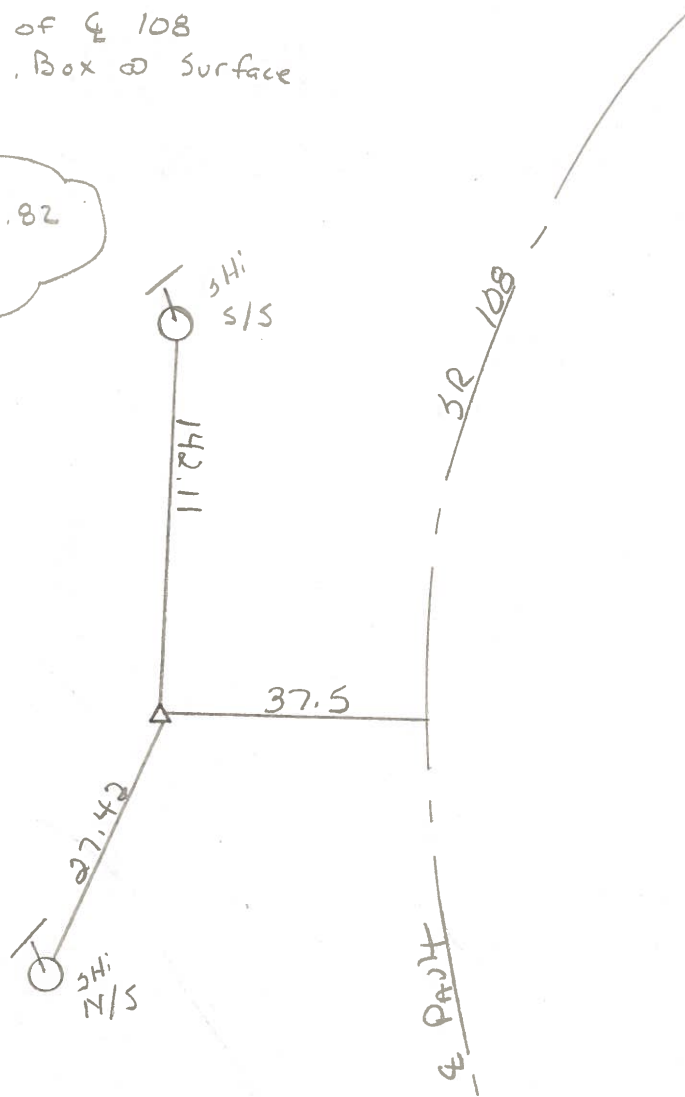

PERSONNEL	TITLE	PERSONNEL	TITLE	COUNTY	DATE
Tamsie				HENRY	July 25, 1974
Neuser				S. R. 108	WEATHER
Vanyo				SEC. Flatrock TWP.	TEMP.
Granata					

DESCRIPTION	LEFT	CENTER LINE	RIGHT	JOB NO.
-------------	------	-------------	-------	---------

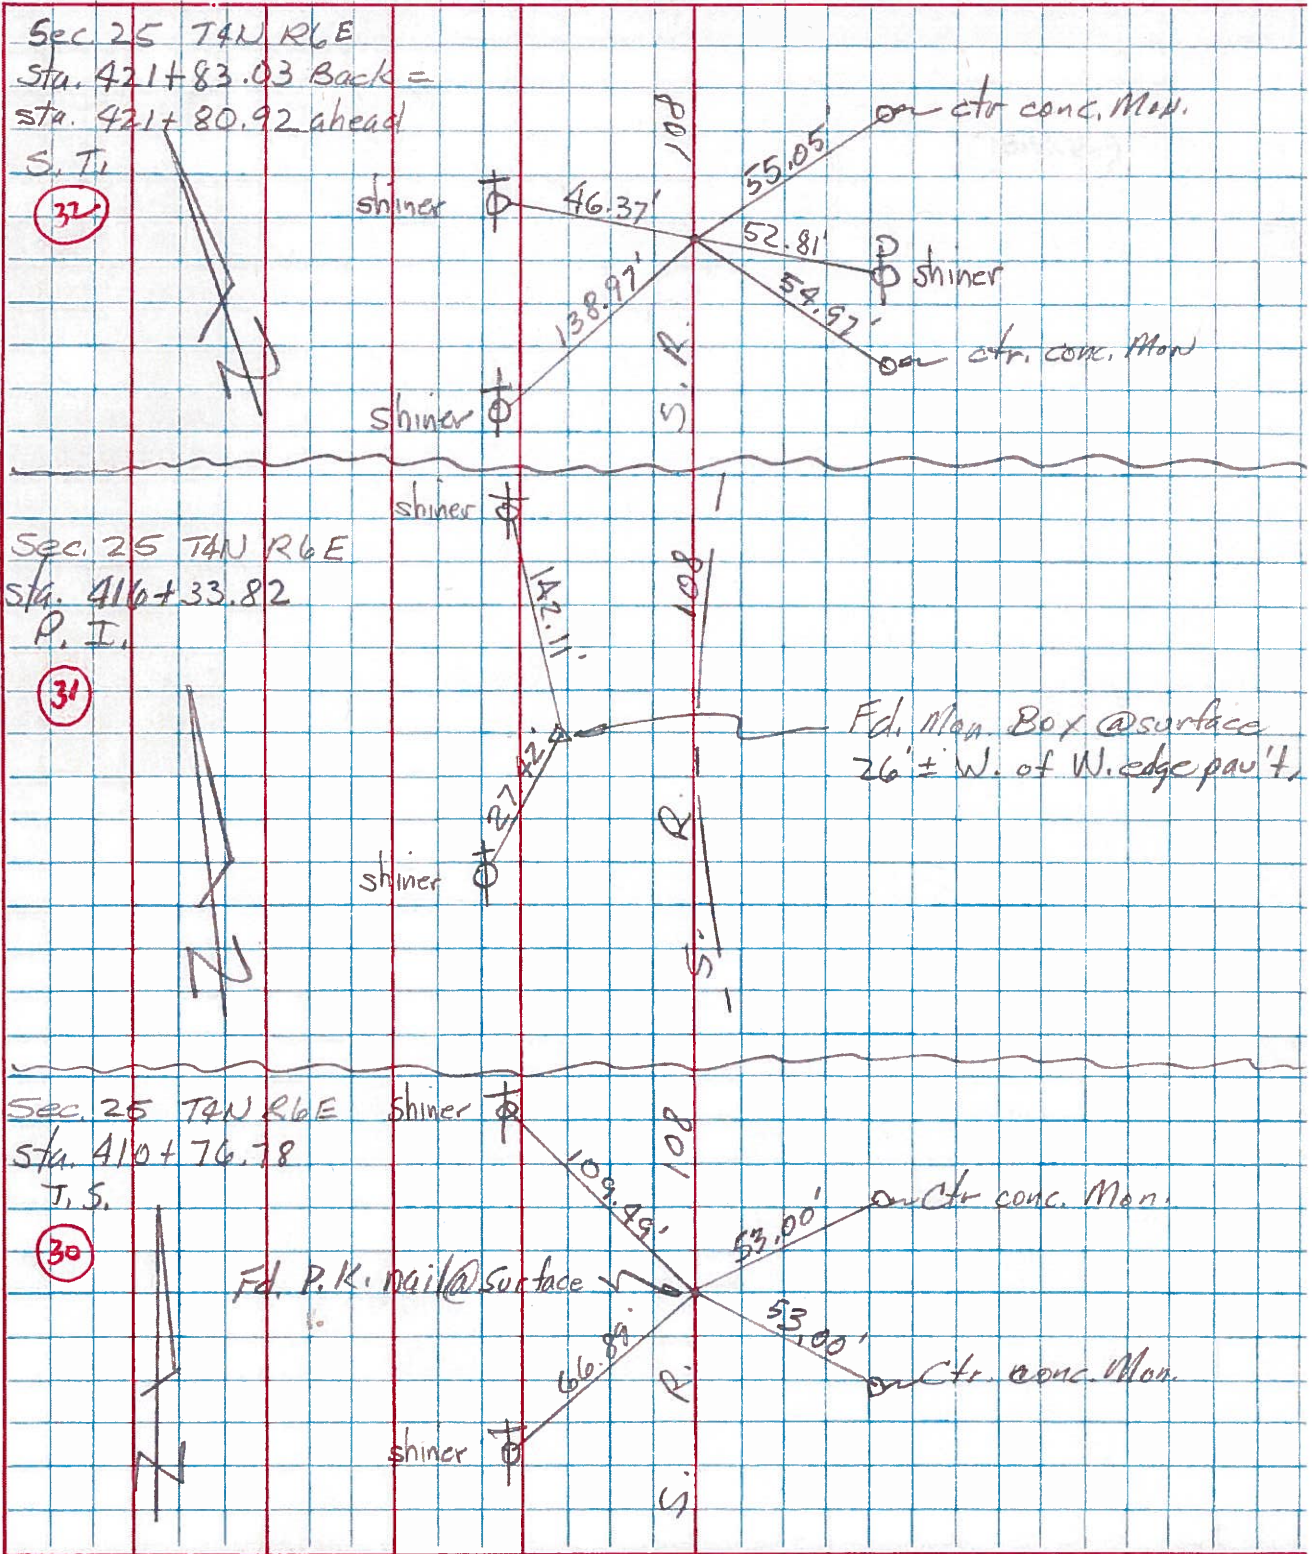

PERSONNEL TITLE PERSONNEL TITLE COUNTY Hen DATE 6/3/71
Louws _____
Friksen Recorder _____ S. R. # 108 WEATHER Fair
Rov _____
Shaw _____ SEC. Holgate to Co Rd 6 TEMP. 80°
 DESCRIPTION Red R/W Plan 1958 JOB NO. _____

