


O.D.O.T. DISTRICT 2 SURVEY OFFICE (USE ONLY)


PERSONNEL _____ REFERENCE NO. 33 SHEET 18 OF 48
 NOTES LEU DATE 3/17/20 ROUTE SR 108
 H.C. LEU WEATHER CLOUDY COUNTY HENRY
 R.C. BALBAUGH TEMP. 41° TOWNSHIP FLATROCK
 DWG BY BALBAUGH PID 94319 SECTION 25
 T 4 N R 6 E

TYPE MONUMENT MONBOX W/ 1" IPIN
 ON SURFACE - ~~BELOW~~ ON
 OFFSET Q PAVEMENT 7.5' ~~LT~~ : RT
4.7' TO RT EDGE PAVEMENT
 STATION: 431+03.76

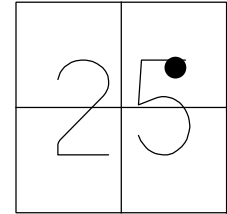

HORIZ.DATUM: NAD83 (2011) GEOID: 2012A
 GRID: NORTHING: 591593.286 EASTING: 1523936.829

RECORD: P.I.
 STA 431+18.13
 $\Delta=08^{\circ}52'$ LT
 FD MONBOX
 DID NOT OPEN
 PK @ SURFACE
 8-18-92, MB
 FD MON BOX
 W/ 1" IPIN
 REF33
 11-5-18, JLL
 FD MONBOX
 W/1" IPIN
 NEWREF33
 10-20-20, DSA

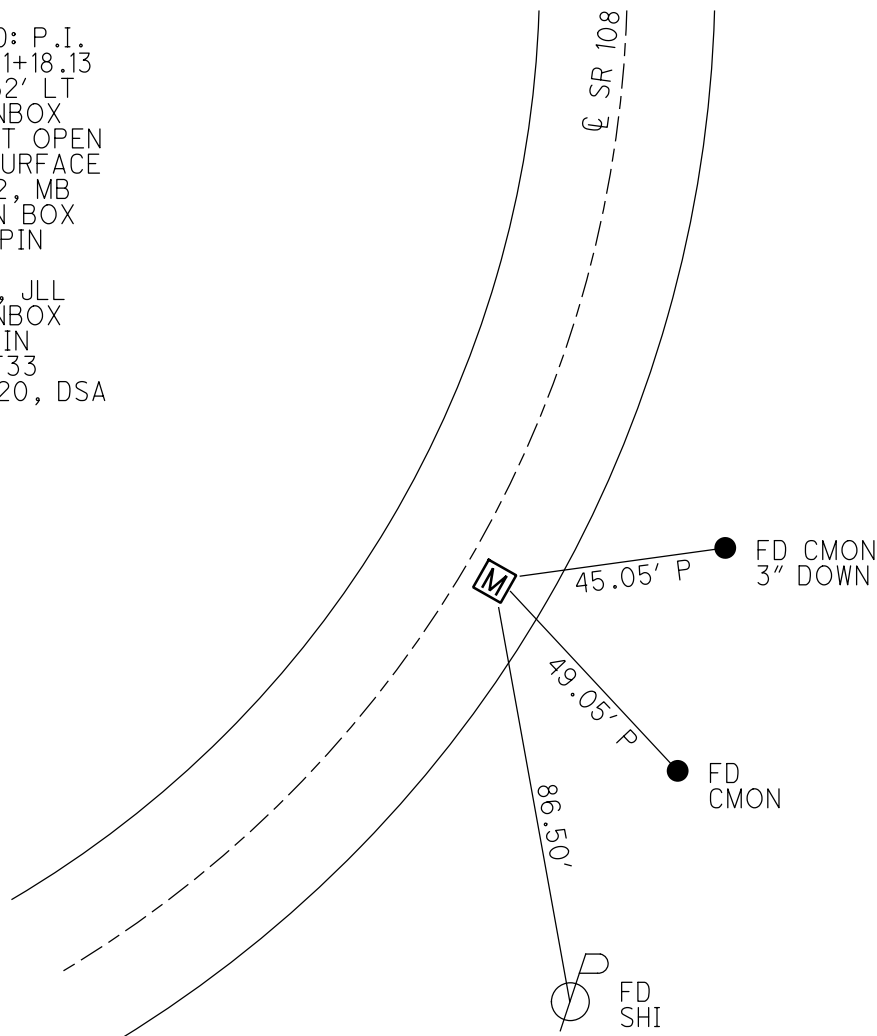

County Henry S.R. 108

Township Flatrock

Section 25

T4N, R6E

Personnel Hoffman

Loehrke HC


Householder RC

Barnhiser Notes

Date 6-28-84

Weather Sunny


Temp. +82°

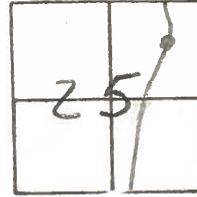

33

Mon Box
 SLM 430+75
 6.8 Rt of Q 108
 5.0 Rt to EP
 18.6 Lt to EP
 FD PK @ Surface


Recorded
 sta. 431+18.13
 P.I.

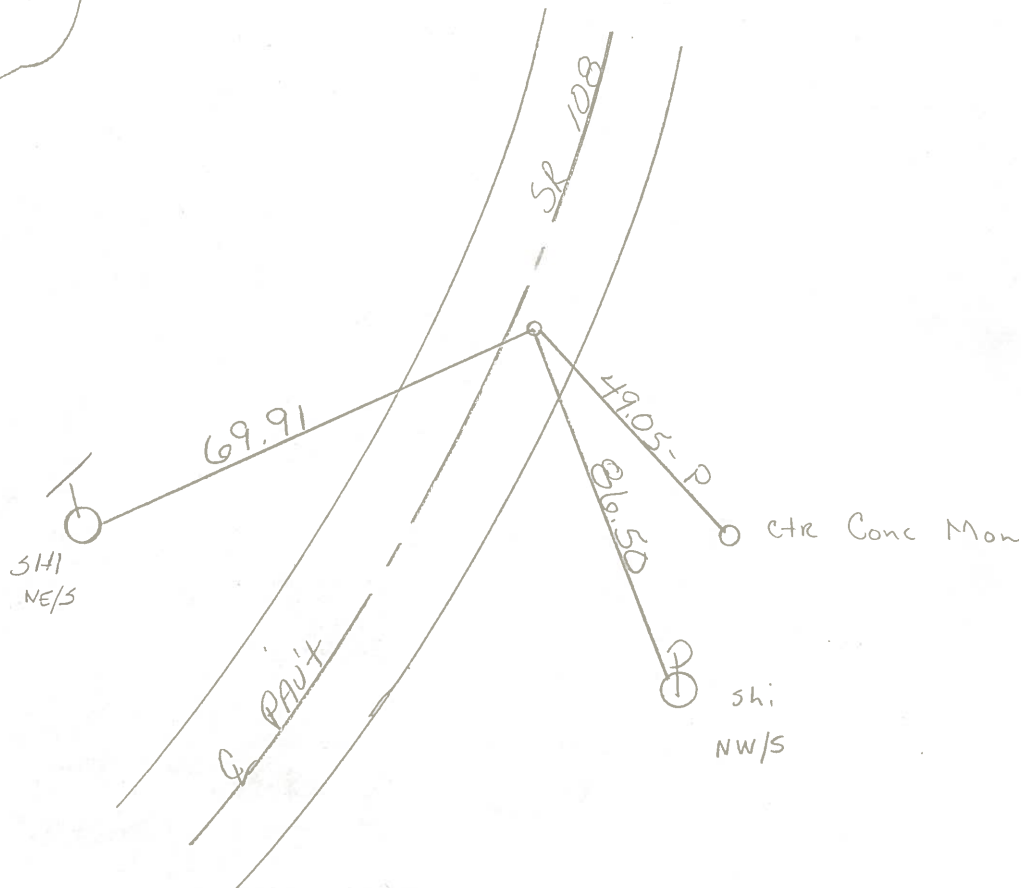

PERSONNEL	TITLE	PERSONNEL	TITLE
Tomsic			
Nauser			
Vanyo			
Granata			

COUNTY HENRY DATE July 25, 1974
 S. R. 108 WEATHER _____
 SEC. Flatrock Twp P. TEMP. _____

DESCRIPTION _____ LEFT _____ CENTER LINE _____ RIGHT _____ JOB NO. _____

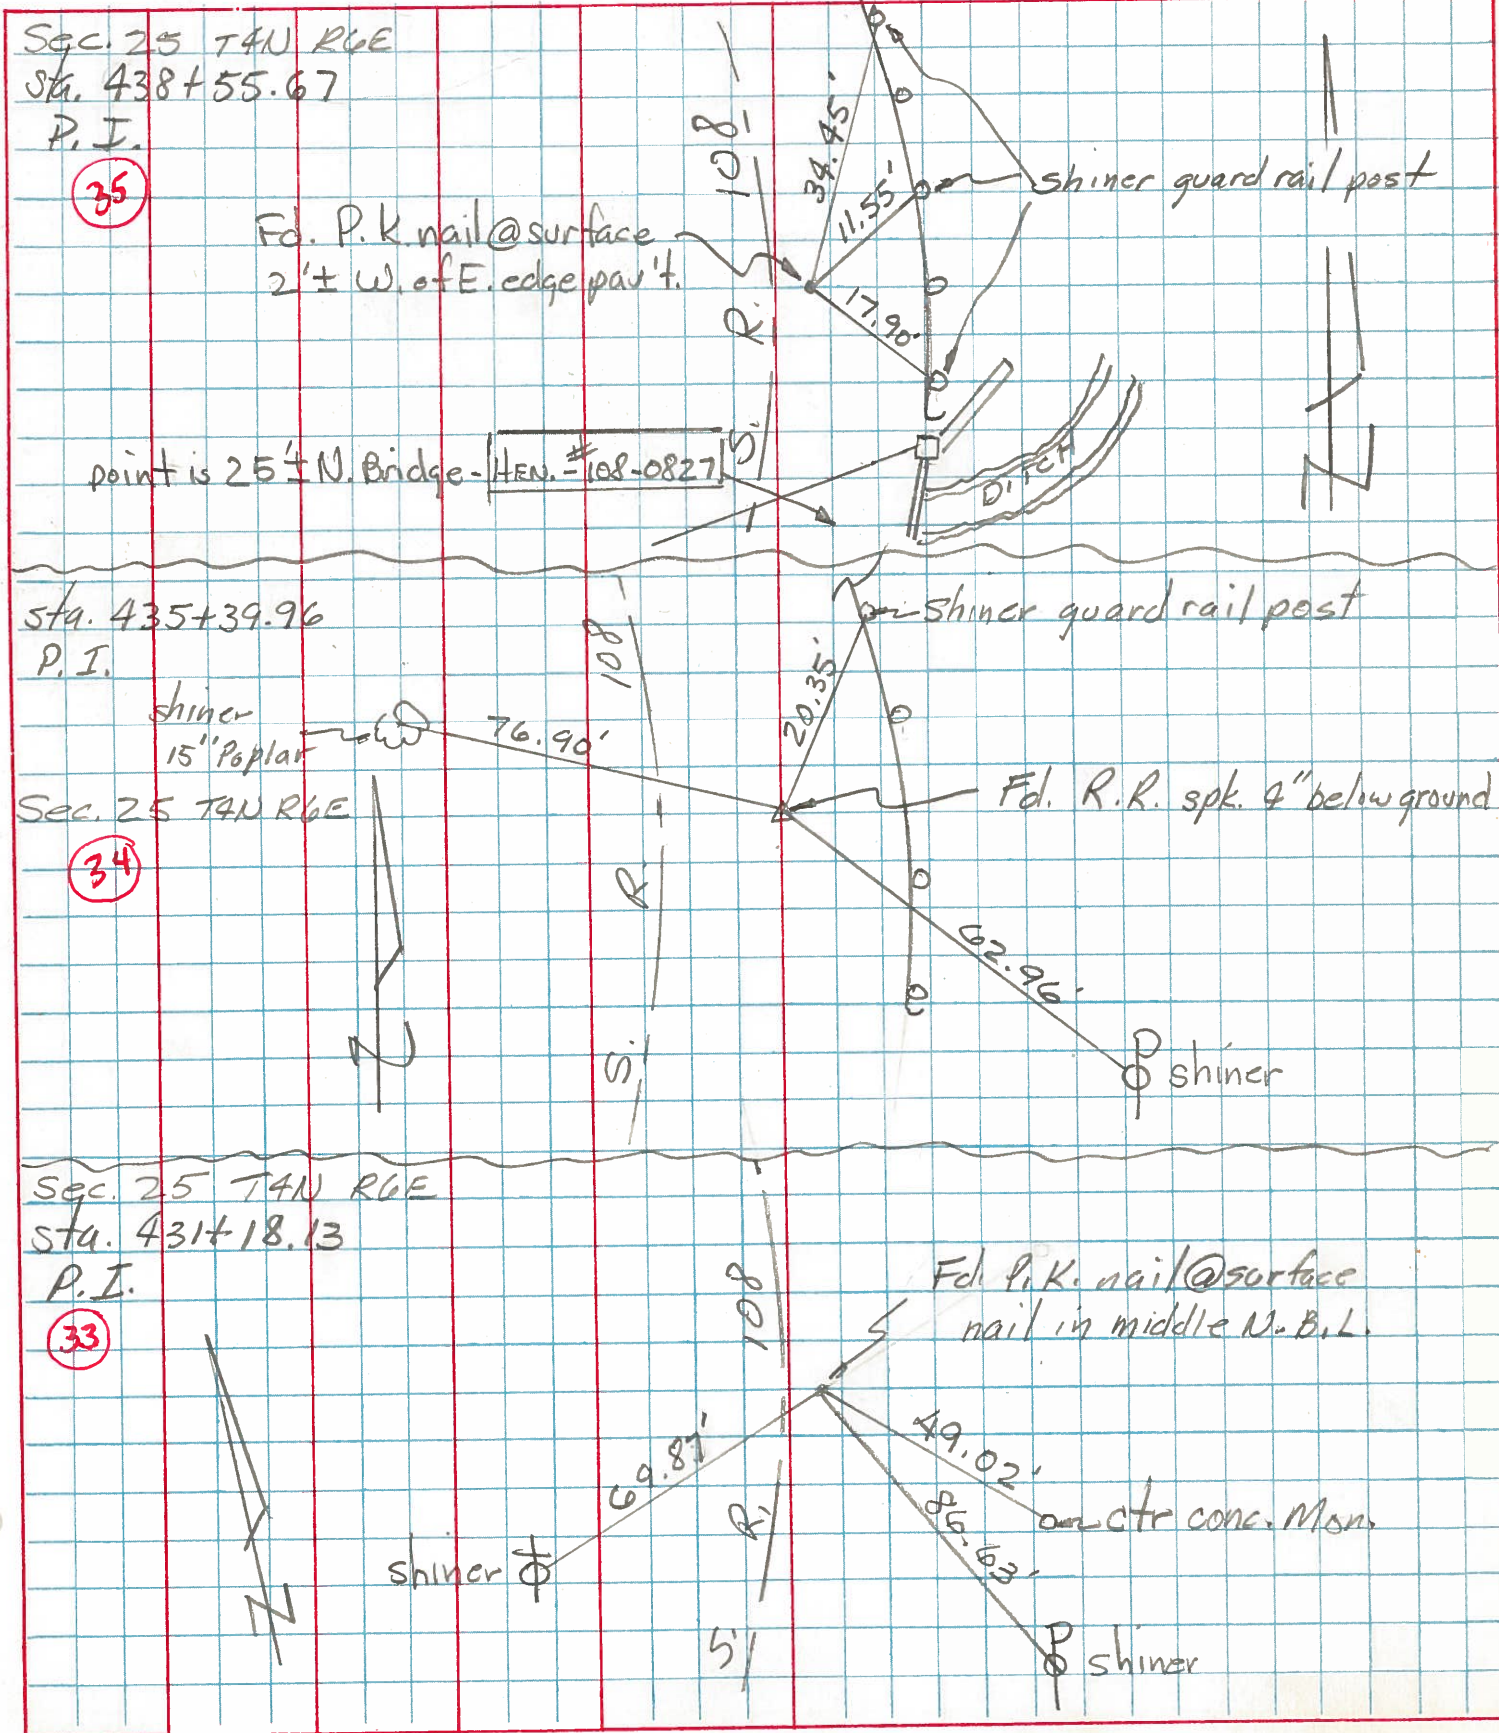

PERSONNEL	TITLE	PERSONNEL	TITLE	COUNTY	DATE
<u>Lovys</u>				<u>Henn</u>	<u>6/3/71</u>
<u>Eriksen</u>	<u>Recorder</u>			S. R. <u>#108</u>	WEATHER <u>Fair</u>
<u>Rau</u>				SEC. <u>Holgate to Co. Rd L</u>	TEMP. <u>80°</u>
<u>Spaw</u>					
DESCRIPTION	<u>Ref R/W Plan 1958</u>			JOB NO.	

