


O.D.O.T. DISTRICT 2 SURVEY OFFICE (USE ONLY)


PERSONNEL _____ REFERENCE NO. 34 SHEET 19 OF 48
 NOTES LEU DATE 3/17/20 ROUTE SR 108
 H.C. LEU WEATHER CLOUDY COUNTY HENRY
 R.C. BALBAUGH TEMP. 41° TOWNSHIP FLATROCK
 _____ SECTION 25
 DWG BY BALBAUGH PID 94319 T 4 N R 6 E

TYPE MONUMENT LG.R.R.SPIKE
~~ON SURFACE - BELOW~~ 6.75"
 OFFSET C PAVEMENT 15.7' ~~LT~~ : RT
 _____ TO _____ EDGE PAVEMENT
 STATION: 435+25.57

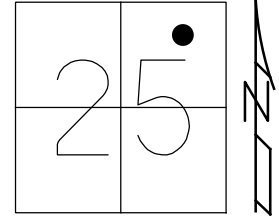

HORZ.DATUM: NAD83 (2011) GEOID: 2012A
 GRID: NORTHING: 591993.211 EASTING: 1524073.108

RECORD: P.I.
 STA 435+39.96
 FD LG.R.R.SPIKE
 4" DOWN
 8/18/92, MB
 FD LG.R.R.SPIKE
 6 3/4" DOWN
 REF 34
 11-6-18, JLL
 SET MAG/WASHER
 10-20-20, DSA

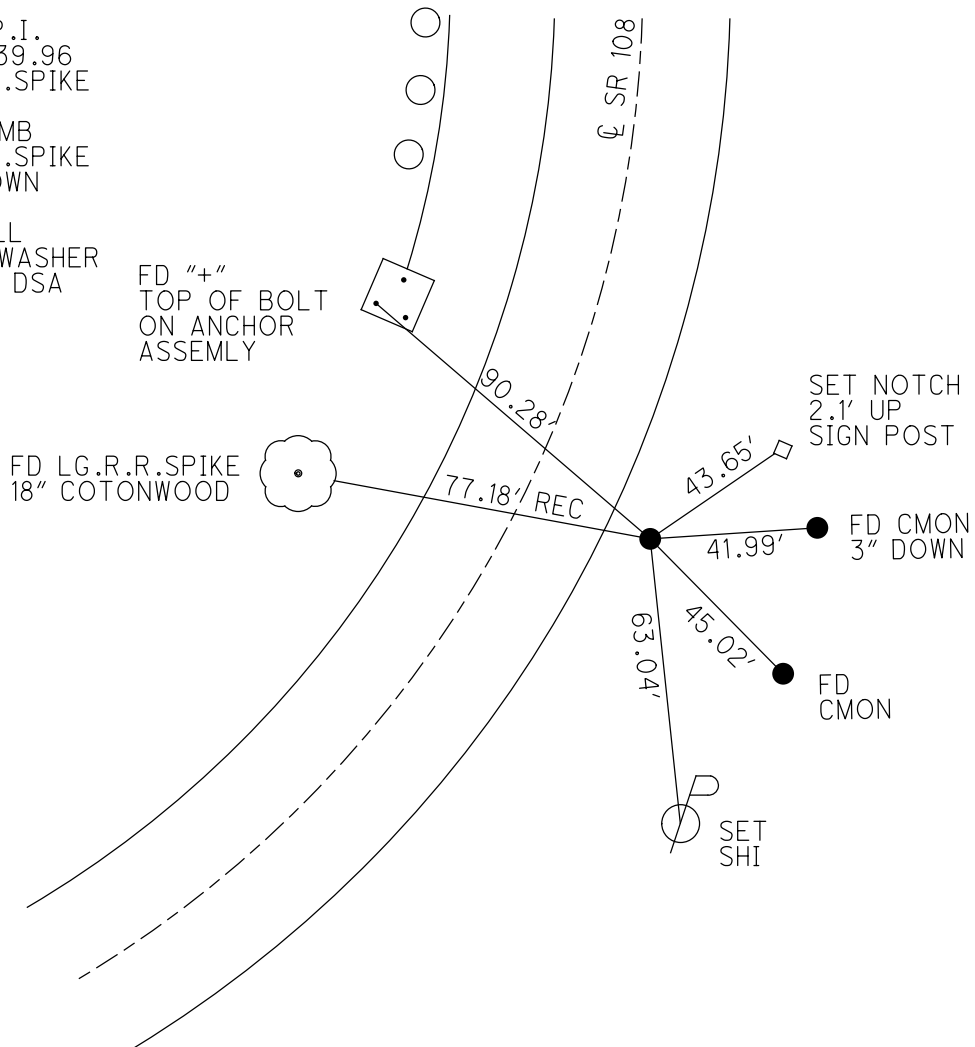

O.D.O.T. DISTRICT 2 SURVEY OFFICE

PERSONNEL

REFERENCE NO. 34

SHEET 38 OF 54

NOTES VAN DUSEN

H.C. KUSZ

R.C. BARNHISEL

DATE 8-18-92

WEATHER CLEAR

TEMP. +75°F

ROUTE SR 108

COUNTY HENRY

TOWNSHIP FLAT ROCK

SECTION 25

T. 4 N. R. 6 E.



TYPE MONUMENT LARGE R.R. SPK

ON SURFACE - BELOW 4"


LEFT - CL PAV'T. - RIGHT 16'

TO EDGE PAVEMENT

S.L.M. 434+08

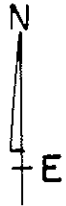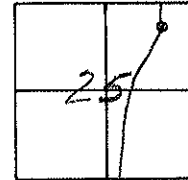

RECORDED
STA. 435+39.96
P.I.

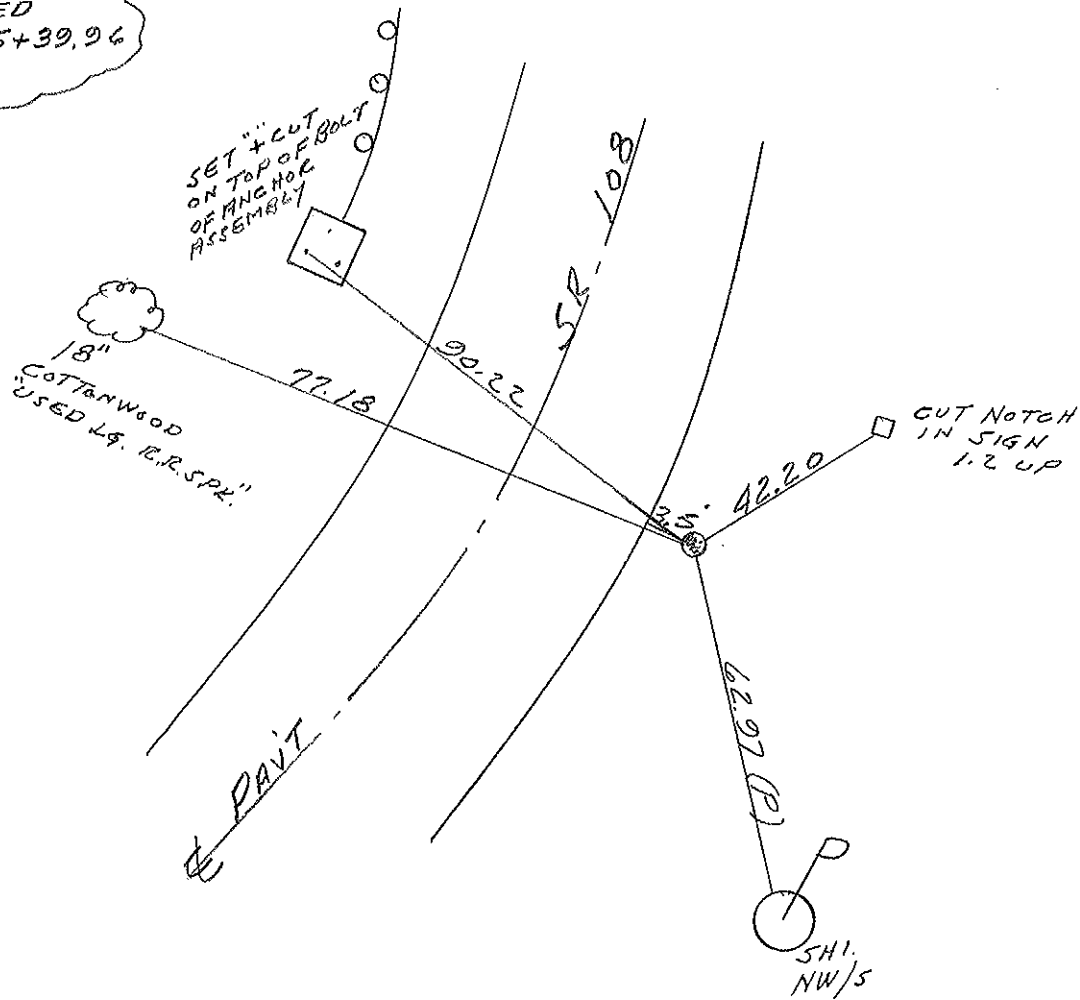

County Henry S.R. 108

Township Flatrock

Section 25

T4N, R6E

Personnel Hoffman

Loehrke HC


Householder RC

Barnhise l Notes

Date 6-28-84

Weather Sunny

Temp. +82°

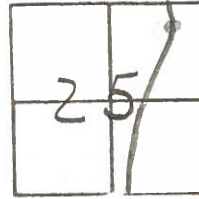

34

SLM 434+97

FD Lg RR/spk

4" below surface

16.0 Rt of & 108

3.95 Rt of Rt EP

8-28-84

LOCATED IN STONE BERM


DIDN'T SET ANYTHING ON

SURFACE

PAINTED ARROW 0.3 RT OF R.T.E.P.

M.D.B.

Recorded
Sta. 435 + 39.96
P.I.

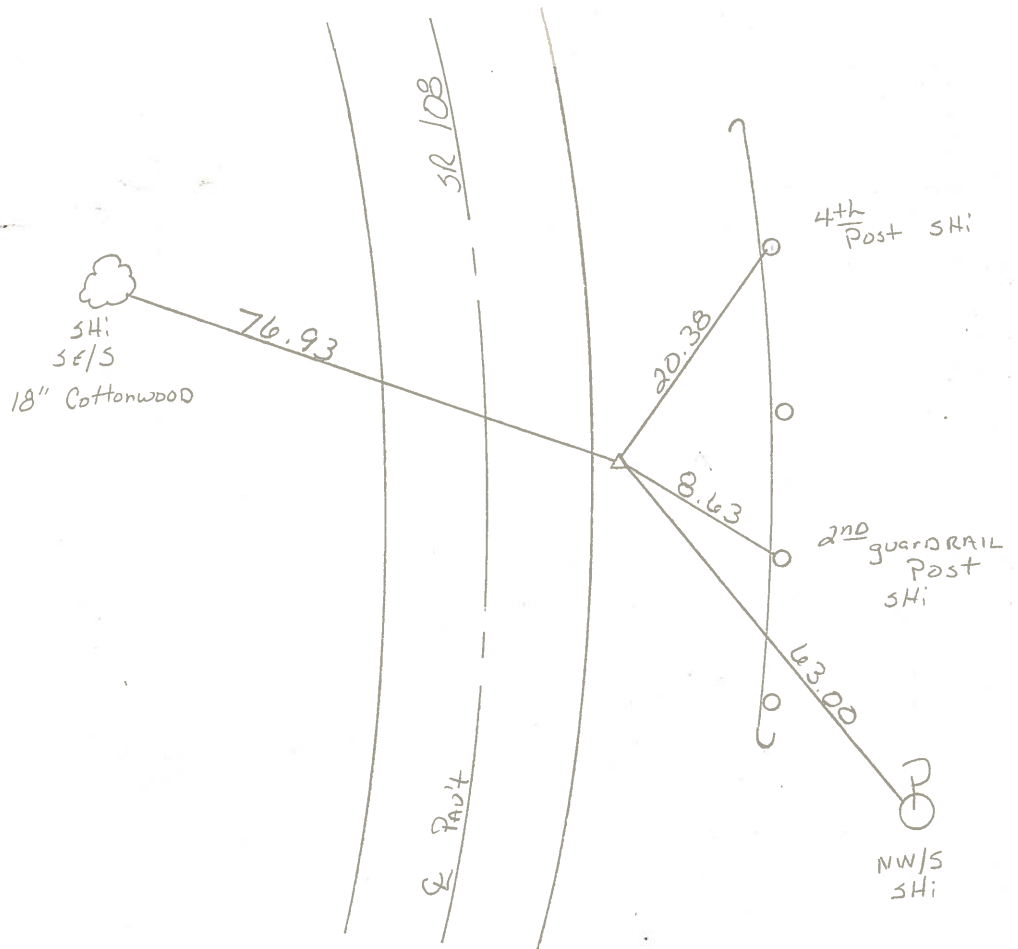


PERSONNEL	TITLE	PERSONNEL	TITLE
Tomsic			
Nauser			
Vanyo			
Granata			

COUNTY HENRY DATE July 25, 1979

S. R. 108 WEATHER _____

SEC. Flatrock TWP. TEMP. _____

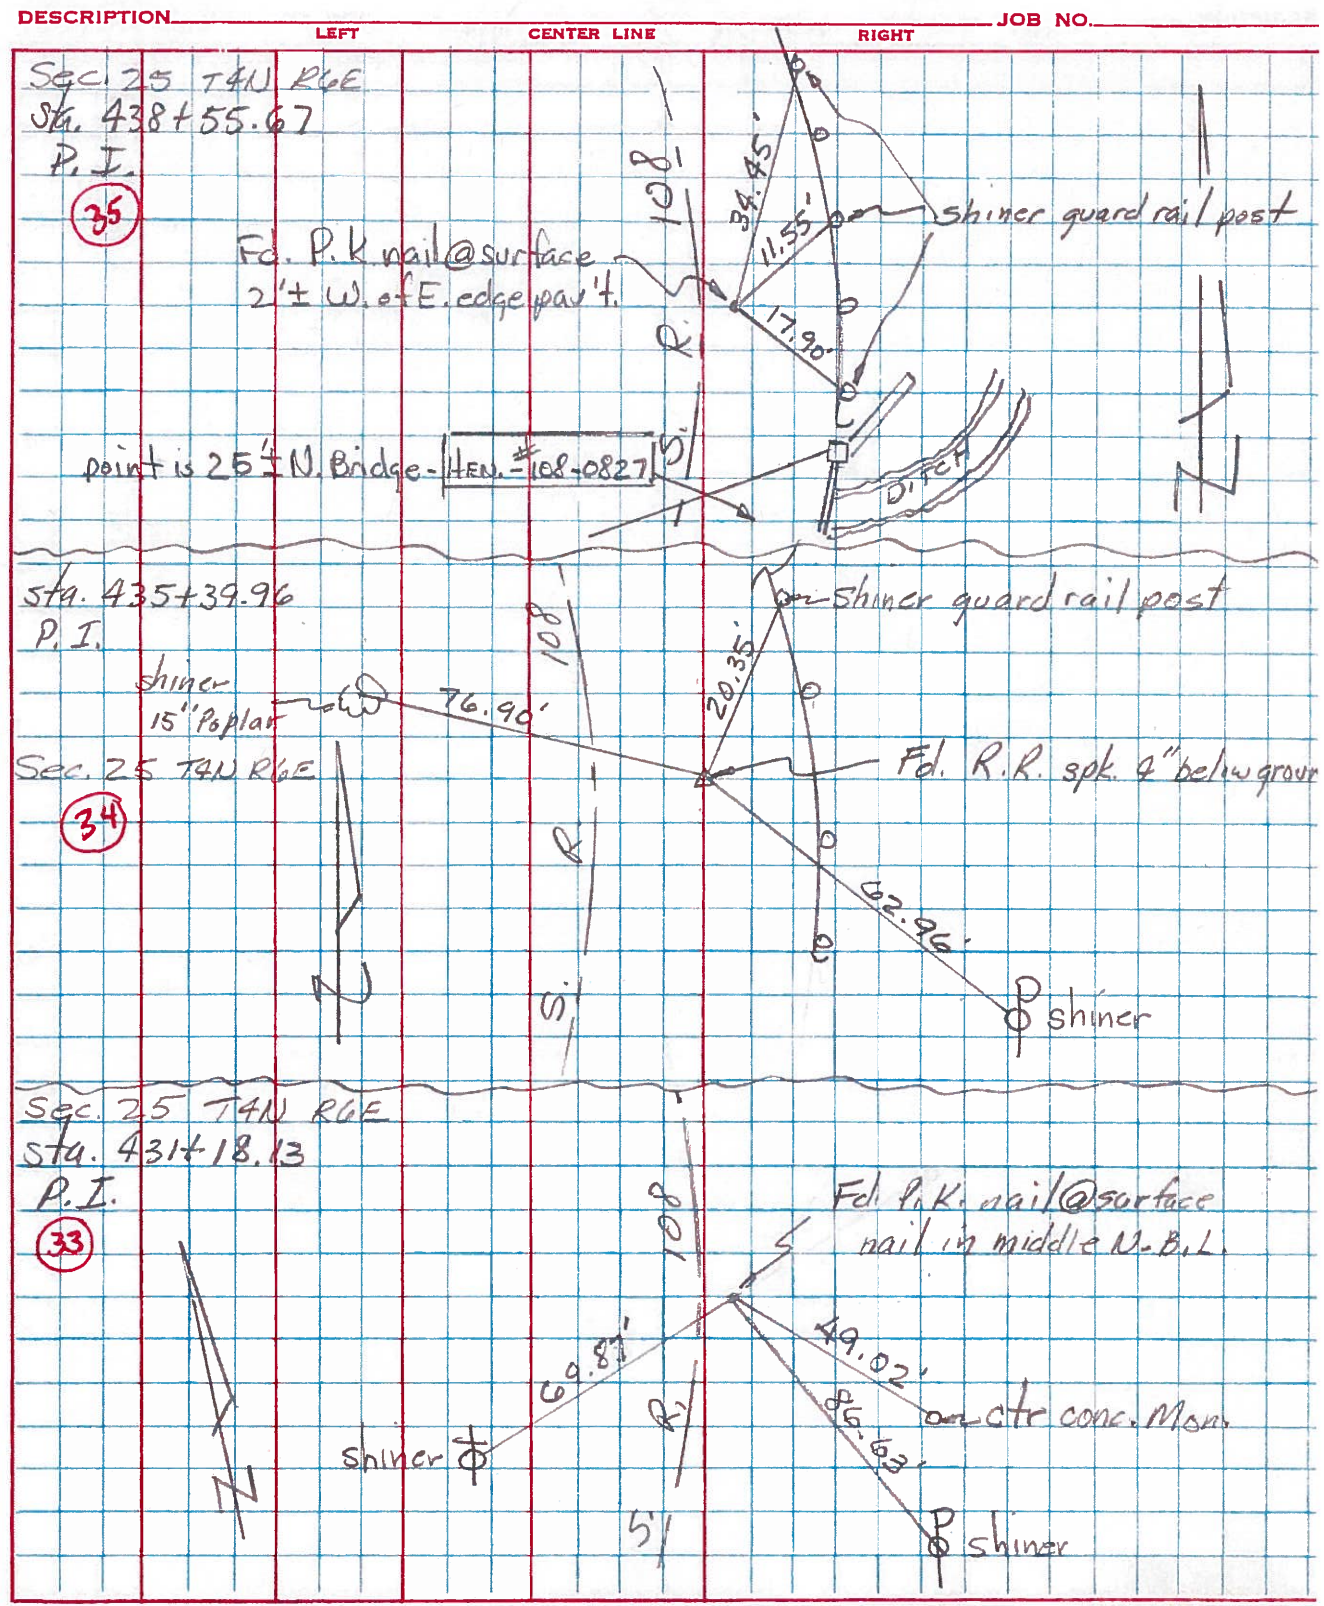

PERSONNEL TITLE PERSONNEL TITLE COUNTY Henn DATE 6/3/71

Louys _____ Erikson Recorder _____ S. R. #108 WEATHER Fair

Rov _____ Spaw _____ SEC. Holgate to Co Rd L TEMP. 80°

DESCRIPTION Ref R/W Plan 1958 JOB NO. _____

LEFT CENTER LINE RIGHT

