

O.D.O.T. DISTRICT 2 SURVEY OFFICE (USE ONLY)

PERSONNEL

REFERENCE NO. 35

SHEET 20 OF 48

NOTES BALBAUGH

DATE 3/17/20

ROUTE SR 108

H.C. LEU

WEATHER CLOUDY

COUNTY HENRY

R.C. BALBAUGH

TEMP. 41°

TOWNSHIP FLATROCK

DWG BY BALBAUGH PID 94319

SECTION 25

T 4 N R 6 E

TYPE MONUMENT MONBOX W/ 1" IPIN

ON SURFACE - ~~BELOW~~ ON

OFFSET ☉ PAVEMENT 10.2' ~~LT~~ : RT

1.8' TO RT EDGE PAVEMENT


STATION: 438+41.92

HORIZ. DATUM: NAD83 (2011)

GEOID: 2012A


GRID: NORTHING: 592311.609

EASTING: 1524083.336

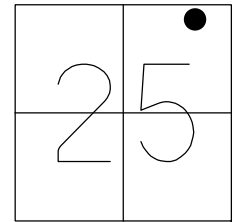

RECORD: P.I.
 STA 438+55.67 LT
 $\Delta = 14^\circ 24'$
 FD MONBOX
 DID NOT OPEN
 8-18-92, MB
 FD MONBOX
 W/ 1" IPIN
 REF 35
 11-6-18, JLL
 FD MONBOX
 COVERED W/ ASPHALT
 10-22-20, DSA
 SET MAG/W
 12-14-20, DSA


SET NOTCH
 2.5' UP
 SIGN

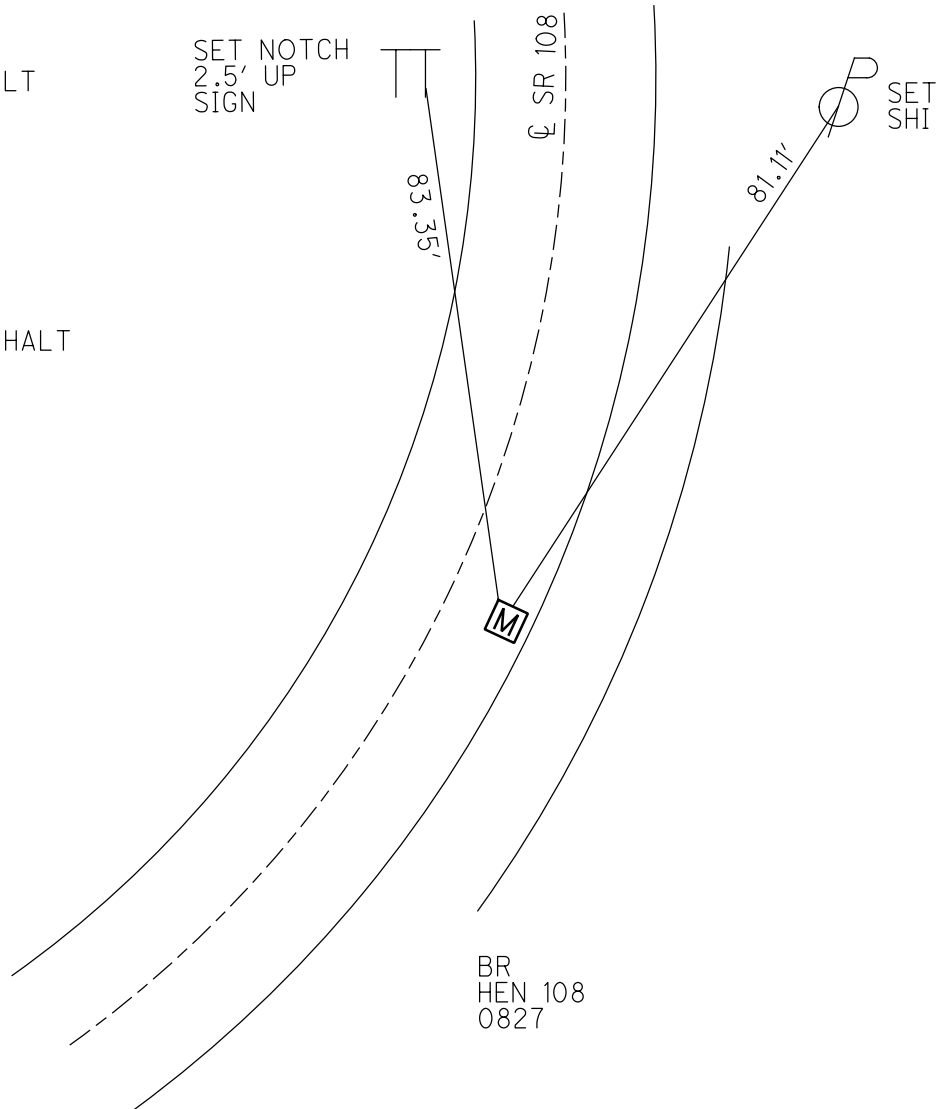

O.D.O.T. DISTRICT 2 SURVEY OFFICE (USE ONLY)

PERSONNEL _____ REFERENCE NO. 35 SHEET 20 OF 48
 NOTES BALBAUGH DATE 3/17/20 ROUTE SR 108
 H.C. LEU WEATHER CLOUDY COUNTY HENRY
 R.C. BALBAUGH TEMP. 41° TOWNSHIP FLATROCK
 _____ SECTION 25
 DWG BY BALBAUGH PID 94319 T 4 N R 6 E


TYPE MONUMENT MONBOX W/ 1" IPIN
 ON SURFACE - ~~BELOW~~ ON _____
 OFFSET 10.2' Pavement LT : RT
1.8' TO RT EDGE PAVEMENT
 STATION: 438+41.92

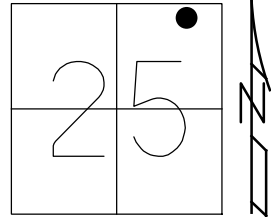

HORIZ. DATUM: NAD83 (2011) GEOID: 2012A
 GRID: NORTHING: 592311.609 EASTING: 1524083.336

RECORD: P.I.
 STA 438+55.67 LT
 $\Delta = 14^\circ 24'$
 FD MONBOX
 DID NOT OPEN
 8-18-92, MB
 FD MONBOX
 W/ 1" IPIN
 REF35
 11-6-18, JLL
 FD MONBOX
 COVERED W/ ASPHALT
 10-22-20, DSA

SET NOTCH
 2.5' UP
 SIGN

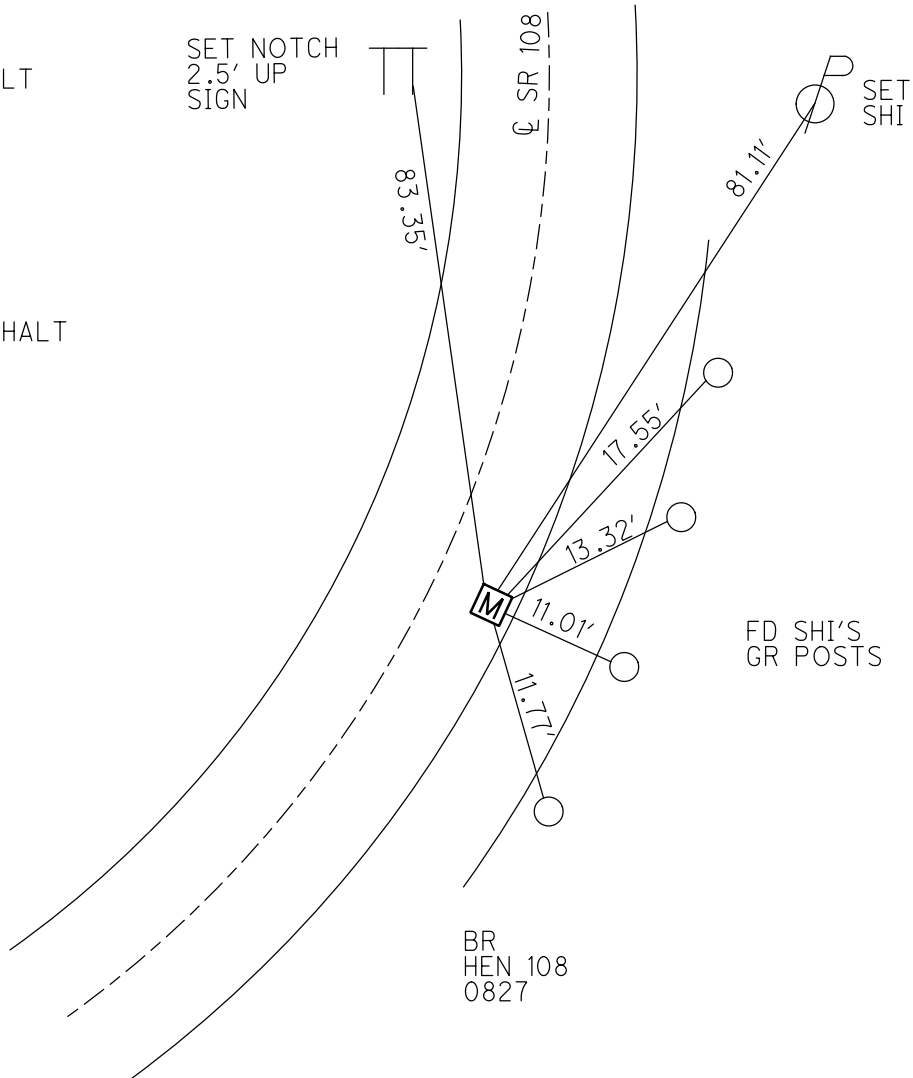

O.D.O.T. DISTRICT 2 SURVEY OFFICE

PERSONNEL

REFERENCE NO. 35

SHEET 39 OF 54

NOTES VAN DUSEN

H.C. KUSZ

DATE 8-18-92

ROUTE SR 108

R.C. BARNHISEL

WEATHER CLEAR

COUNTY HENRY

TEMP. +75°F

TOWNSHIP FLAT ROCK

SECTION 25

T R


TYPE MONUMENT Mon. Box

ON SURFACE - BELOW YES

EFT - ☉ PAV'T. - RIGHT 10.2


1.8 TO RT. EDGE PAVEMENT

S.L.M. 437+23

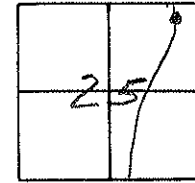

RECORDED
STA. 438+55.67
P.I.

"DID NOT OPEN BOX"

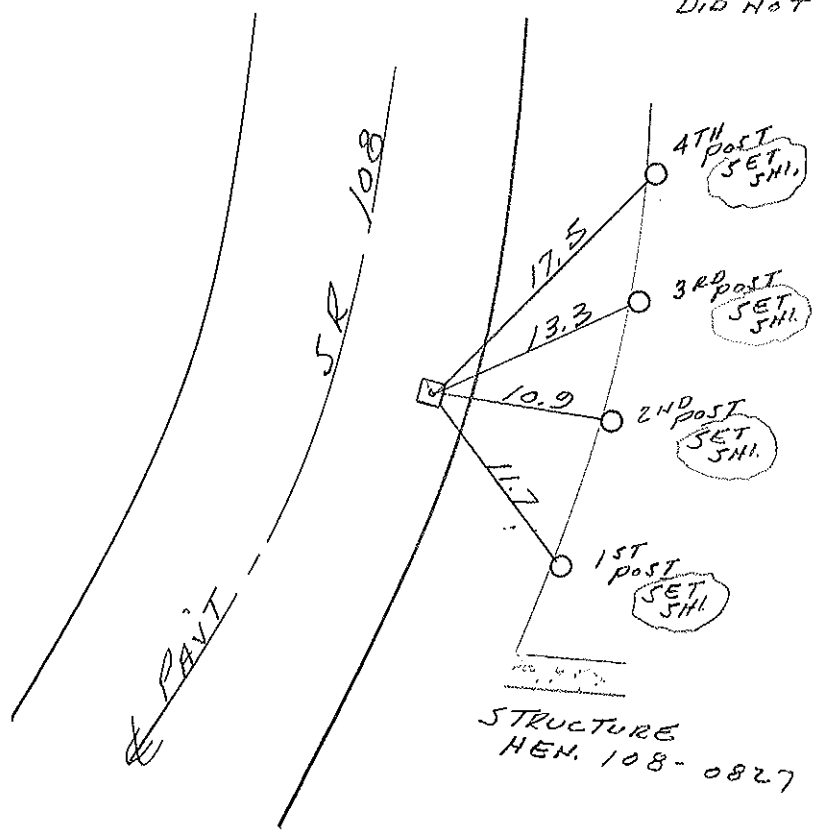

County HENRY S.R. 108

Date 6-28-84

Township FLATROCK

Weather Sunny

Section 25

Temp. +82°


T4N, R6E

Personnel Hoffman

Loehrke HC

Householder RC

Barnhisel Notes

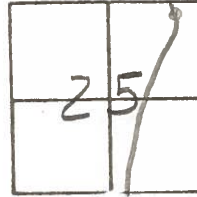

35


man Box

SLM 438+10
 FD PK @ surface
 1.4 Lt of Rt EP
 10.3 Rt of E 108
 21.4 to Lt EP


Recorded
 sta 438+55.67
 P.I.

Point is 25' N of Bridge

Hen. #108.0827

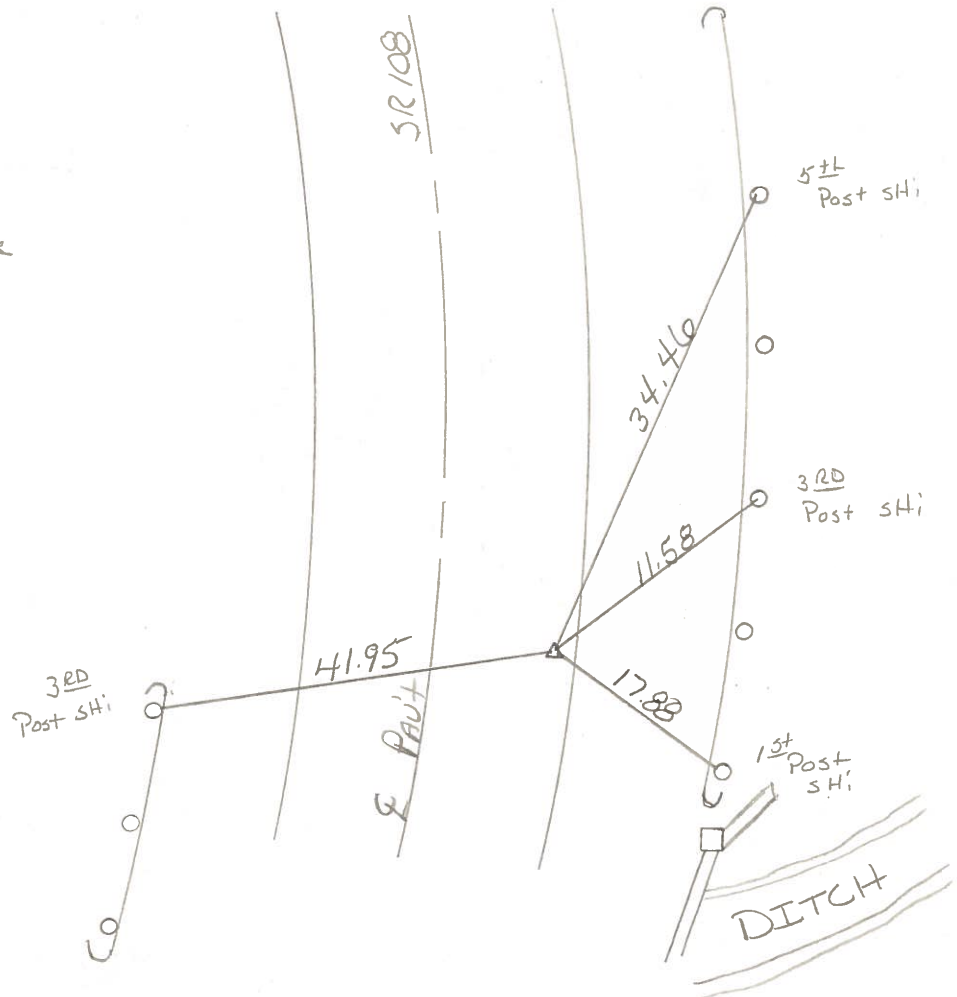

PERSONNEL	TITLE	PERSONNEL	TITLE	COUNTY	DATE	WEATHER	TEMP.
Tomsic				HENRY	July 25, 1979		
Neuser				S. R. 108			
Vanyo				SEC. Flatrock 7W P.			
Granata							

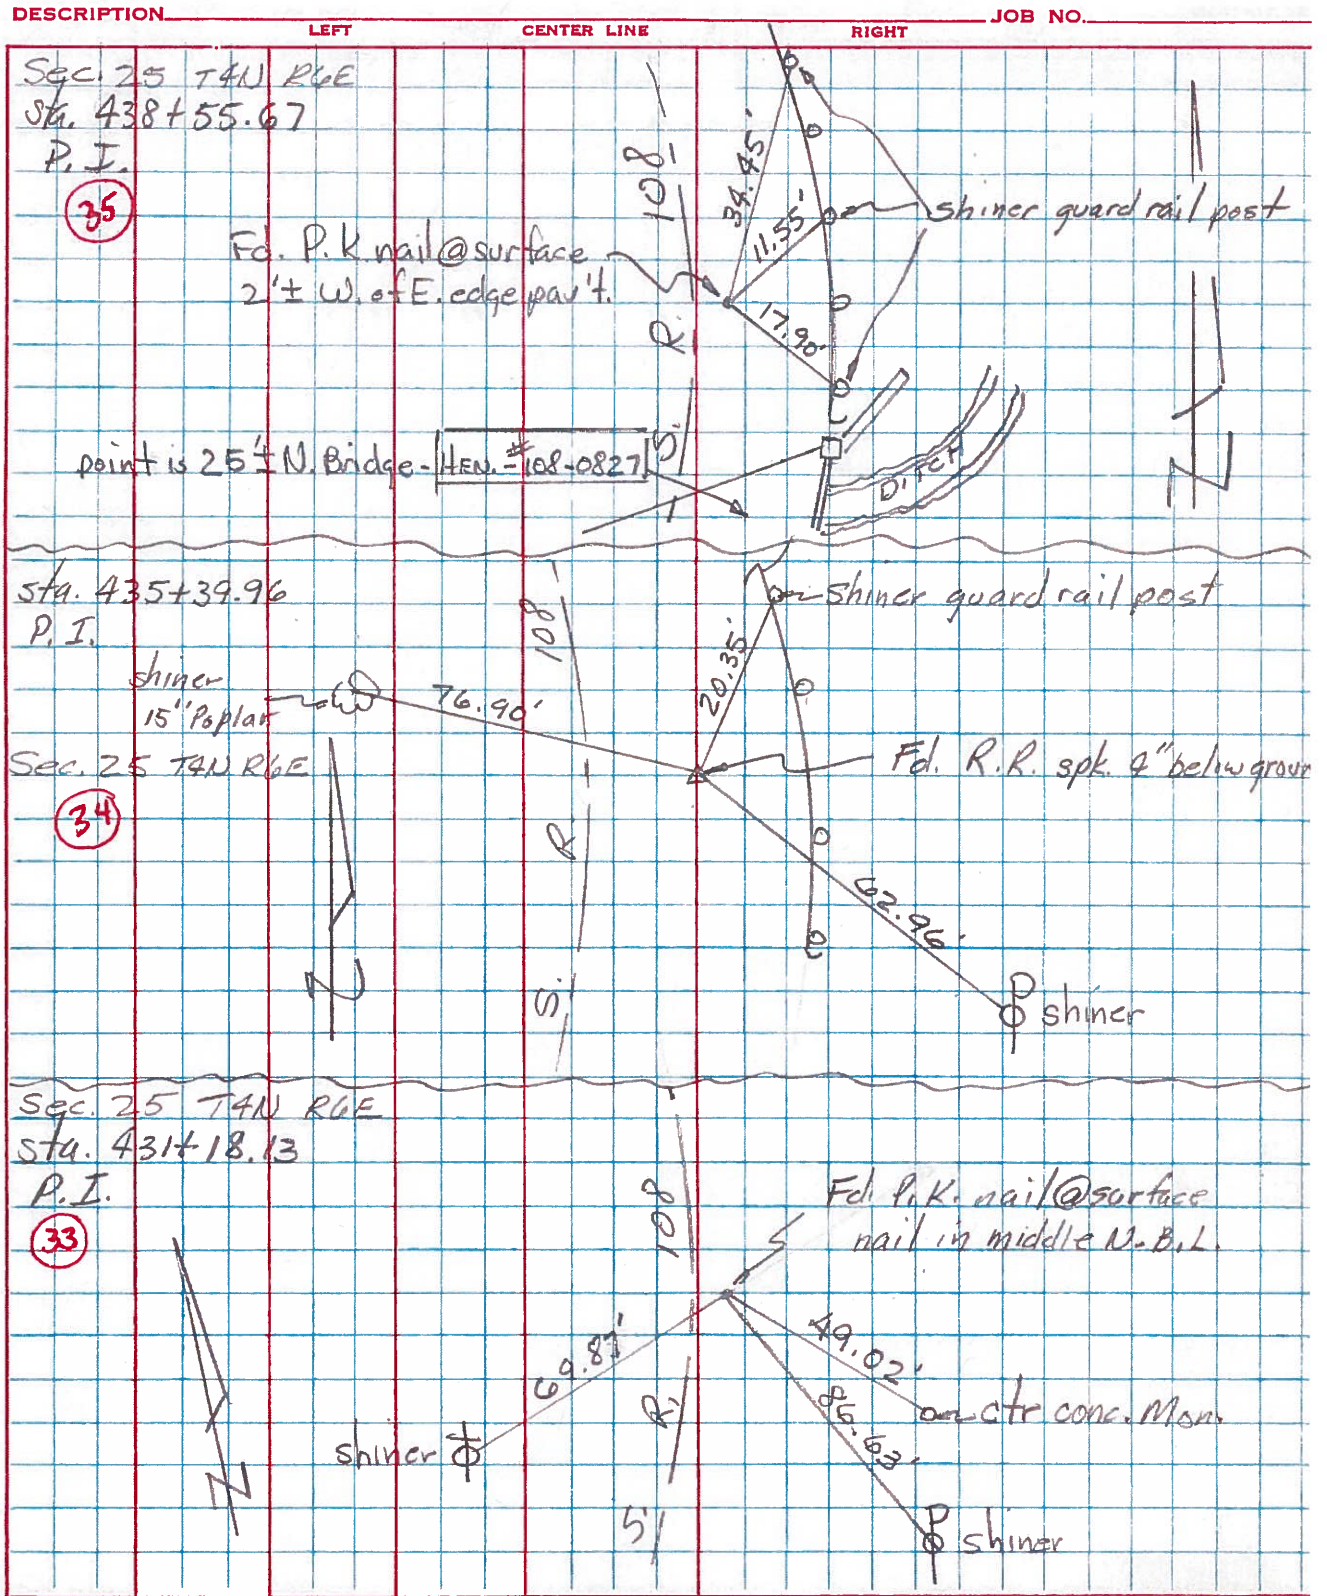

PERSONNEL	TITLE	PERSONNEL	TITLE	COUNTY	DATE	WEATHER	TEMP.
Louise Erikson	Recorder			Hen	6/4/71	Fair	85°
Rev Shaw				S. R. # 108			
				SEC. From Habate N. Cor'd			

DESCRIPTION Ref Const. Plan Dated 1958 JOB NO. _____

