


O.D.O.T. DISTRICT 2 SURVEY OFFICE (USE ONLY)


PERSONNEL _____ REFERENCE NO. 37 SHEET 23 OF 48
 NOTES VAN DUSEN DATE 8/18/92 ROUTE SR 108
 H.C. KUSZ WEATHER CLEAR COUNTY HENRY
 R.C. BARNHEISEL TEMP. 75° TOWNSHIP FLATROCK
 DWG BY MILLER PID 94319 SECTION 24
 T 4 N R 6 E

TYPE MONUMENT P.K./WASHER
 ON SURFACE - ~~BELOW~~ ON
 OFFSET 0.5' LT : RT
12.3' TO LT EDGE PAVEMENT
 STATION: 449+25.12

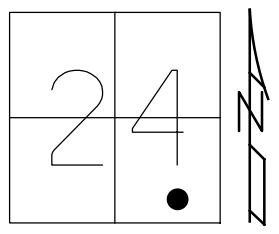

HORZ. DATUM: NAD83 (2011) GEOID: 2012A
 GRID: NORTHING: 593442.670 EASTING: 1523998.396

RECORD: P.O.T.
 STA 450+00
 FD P.K./WASHER
 8/18/92, MB
 SET P.K./WASHER
 9-17-92, MB
 SHOT TIE XING
 REF37
 11-6-18, JLL
 DID NOT SET
 10-22-20, DSA

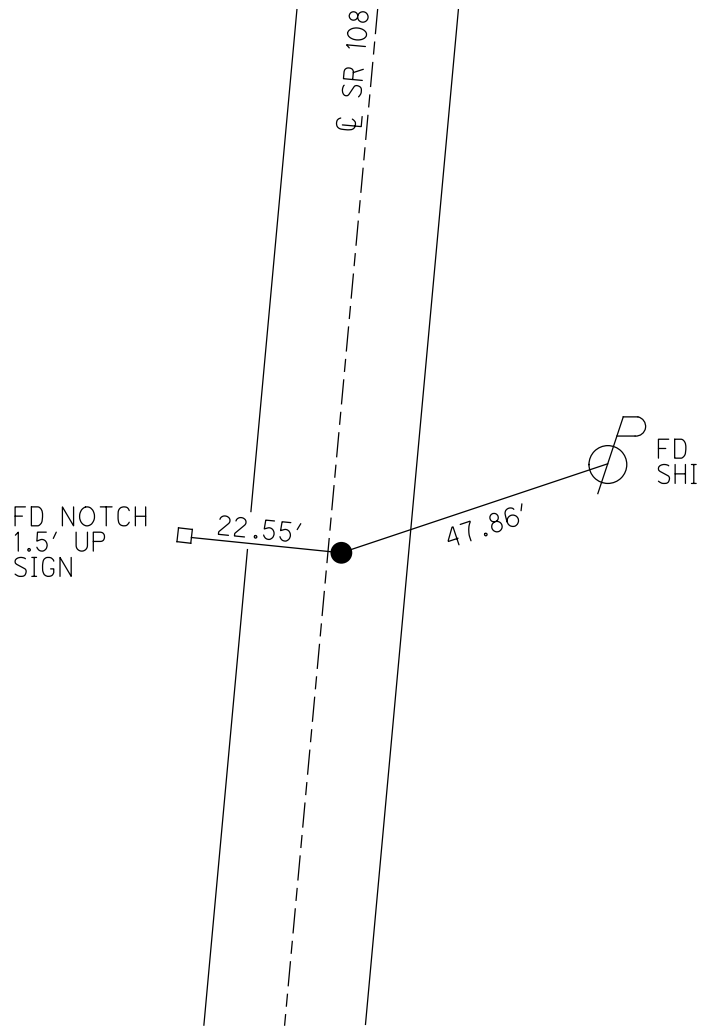

O.D.O.T. DISTRICT 2 SURVEY OFFICE

PERSONNEL

REFERENCE NO. 37

SHEET 41 OF 54

NOTES VAN DUSEN

H.C. KUSZ

DATE 8-18-92

ROUTE SR 108

R.C. BARNHISEL

WEATHER CLEAR

COUNTY HENRY

TEMP. +75°F

TOWNSHIP FLAT ROCK

SECTION 24

T4 N R 6 E


TYPE MONUMENT PK/WASHER

ON SURFACE - BELOW YES

LEFT - 0 PAV'T. - RIGHT 0.5


12.3 TO LT. EDGE PAVEMENT

S.L.M. 448+68

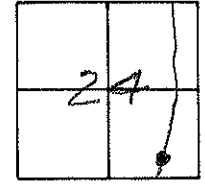

RECORDED
STA. 450+00
P.O.T.

SET PK/WASHER
9-17-92
M.B.

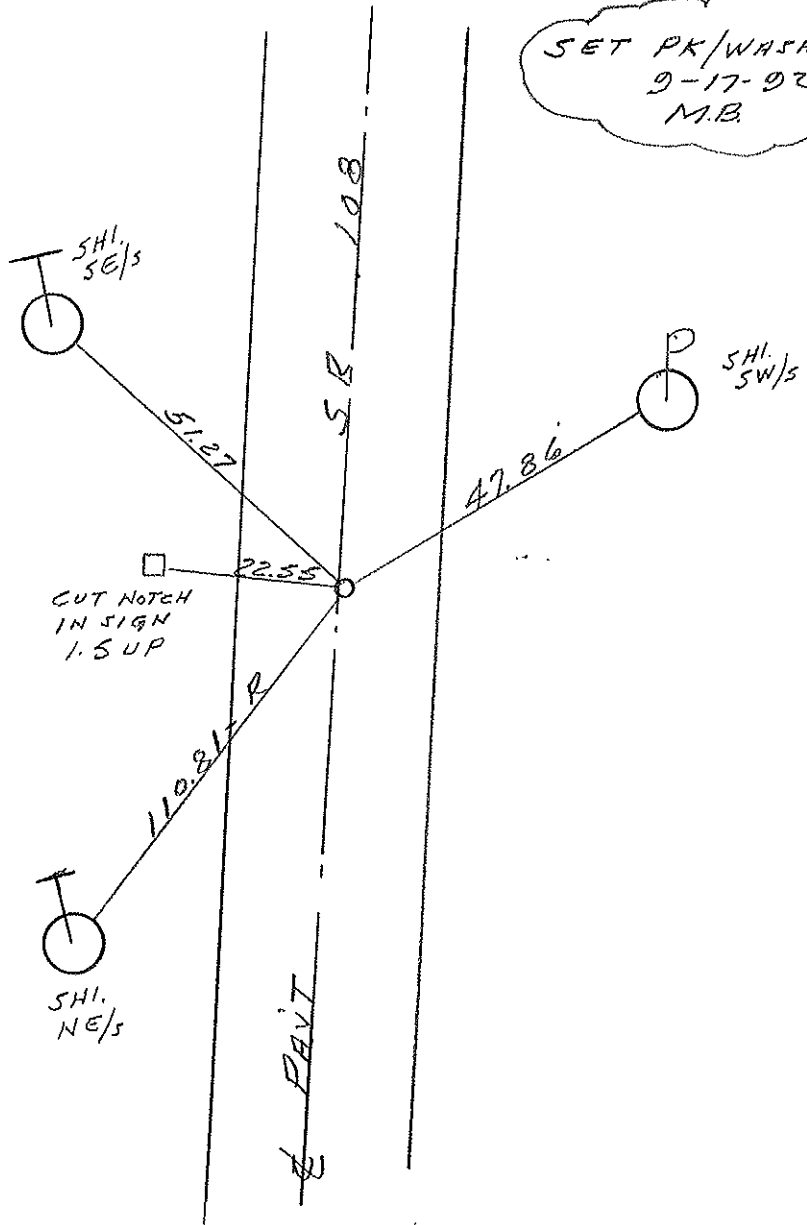

County Henry S.R. 108

Date 6-28-84

Township FLATROCK

Weather Sunny

Section 24

Temp. +82°


T4N, R6E

Personnel Hoffman

Loehrke HC

Householder RC

Barnhisel Notes

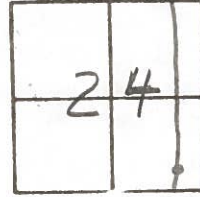

37

SLM 449+55

FL PK @ surface

On E of 108

11.8 Rt of EP


12.0 Lt of EP

8-28-84

SET PK/WASHER

M.P.B.


Recorded
sta. 450+00
P.O.T.

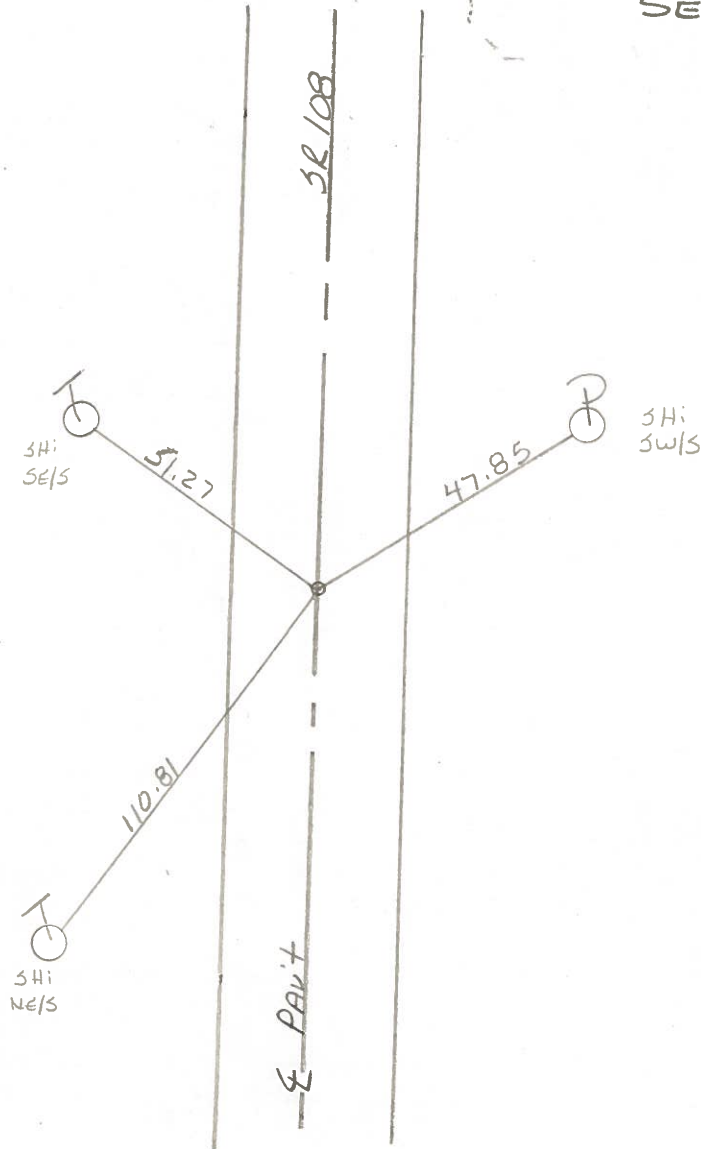

PERSONNEL	TITLE	PERSONNEL	TITLE
Tomsic			
Nesser			
Vanoy			
Granata			

COUNTY HENRY DATE July 25, 1974
 S. R. 108 WEATHER _____
 SEC. Flatrock TWP. TEMP. _____

DESCRIPTION LEFT CENTER LINE RIGHT JOB NO.

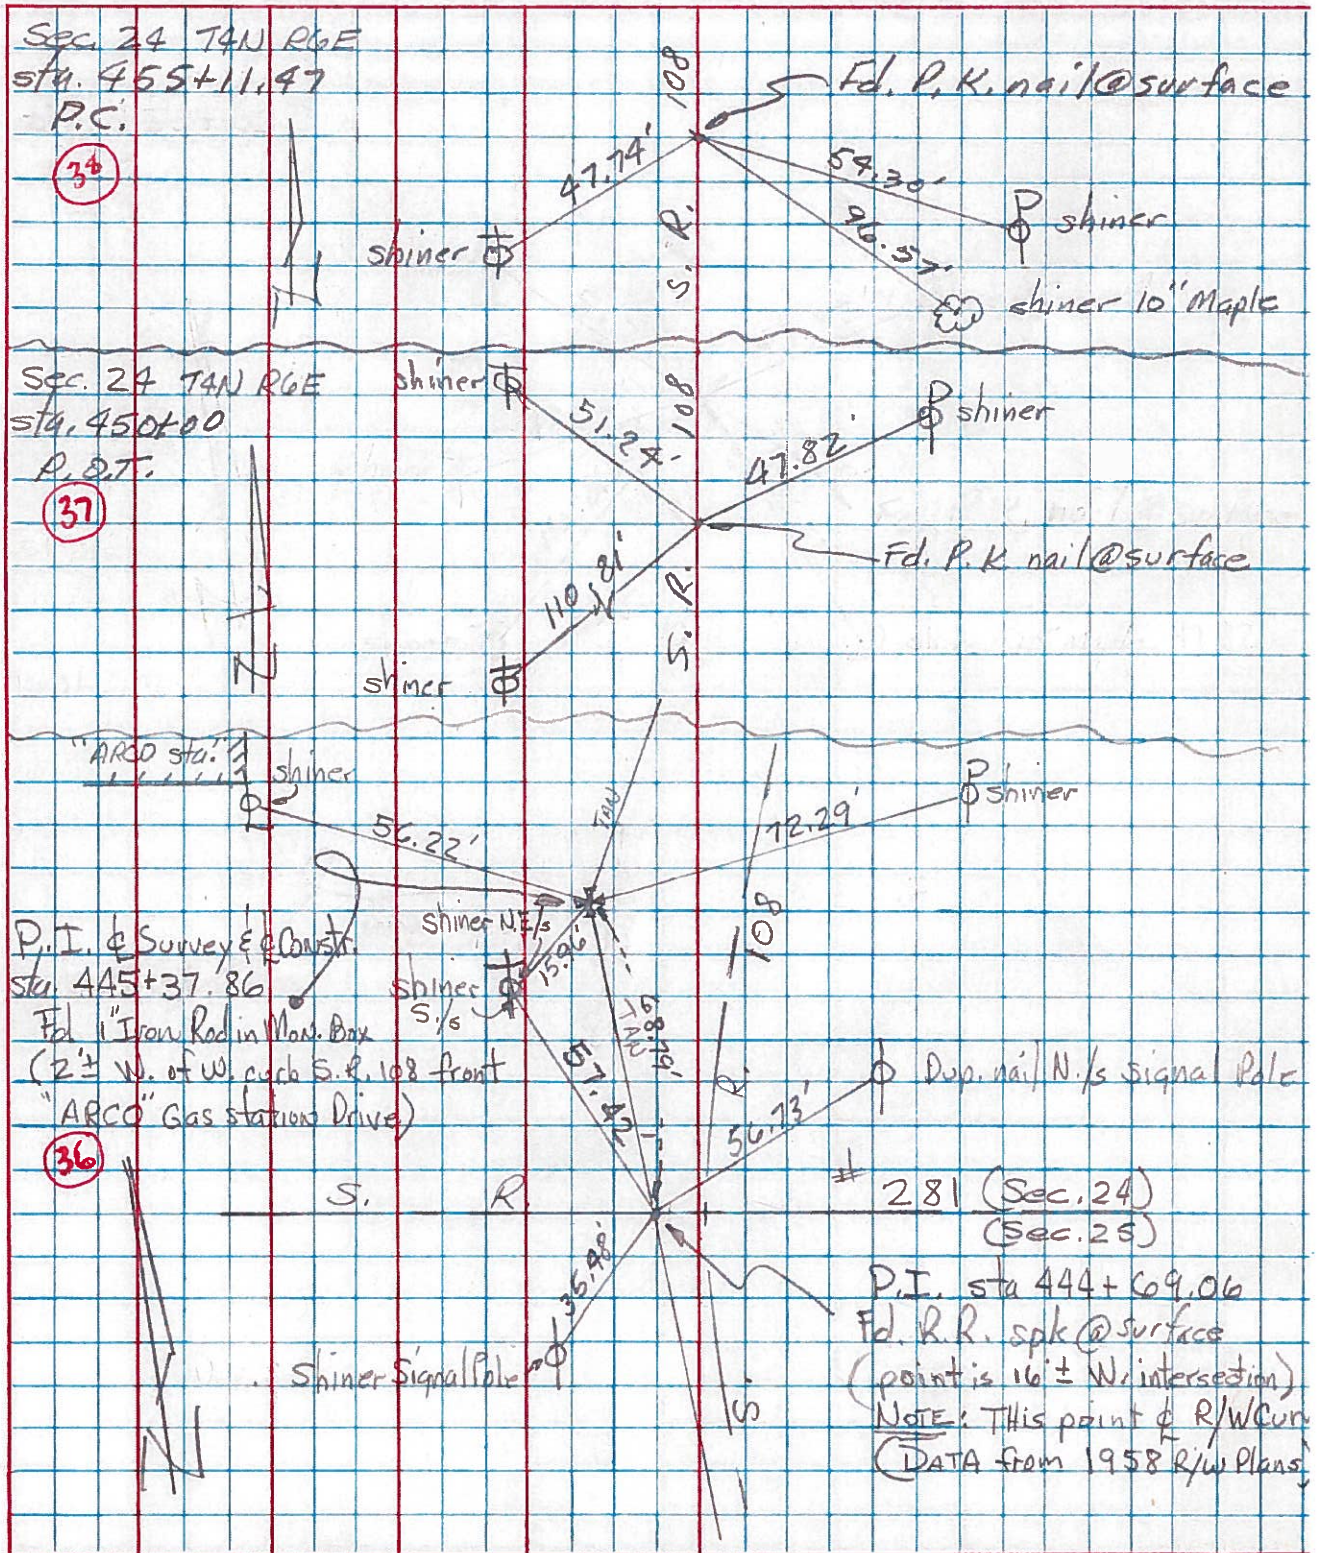

PERSONNEL TITLE PERSONNEL TITLE COUNTY Hen DATE 6/4/71
Louis _____
Erikson Researcher S. R. # 108 WEATHER Fair
Lov _____
Spaw _____ SEC. From Habate N. Card TEMP. 85°
 DESCRIPTION Ref Const. Plan Dated 1958 JOB NO. _____

