


O.D.O.T. DISTRICT 2 SURVEY OFFICE (USE ONLY)


PERSONNEL \_\_\_\_\_ REFERENCE NO. 38 SHEET 24 OF 48  
 NOTES VAN DUSEN DATE 8/18/92 ROUTE SR 108  
 H.C. KUSZ WEATHER CLOUDY COUNTY HENRY  
 R.C. BARNHISEL TEMP. 75° TOWNSHIP FLATROCK  
 SECTION 24  
 DWG BY MILLER PID 94319 T 4 N R 6 E

TYPE MONUMENT P.K./WASHER  
 ON SURFACE - ~~BELOW~~ ON  
 OFFSET 0.7' ± : RT  
12.2' TO RT EDGE PAVEMENT  
 STATION: 454+96.81

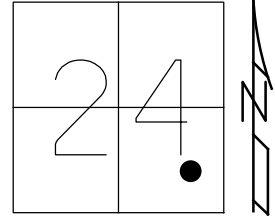

HORZ. DATUM: NAD83 (2011) GEOID: 2012A  
 GRID: NORTHING: 593949.485 EASTING: 1524068.022

RECORD: P.C.  
 STA 455+11.47  
 FD P.K./WASHER  
 8/18/92, MB  
 SET P.K./WASHER  
 9-17-92, MB  
 SHOT TIE XING  
 REF38  
 11-6-18, JLL  
 DID NOT SET  
 10-22-20, DSA

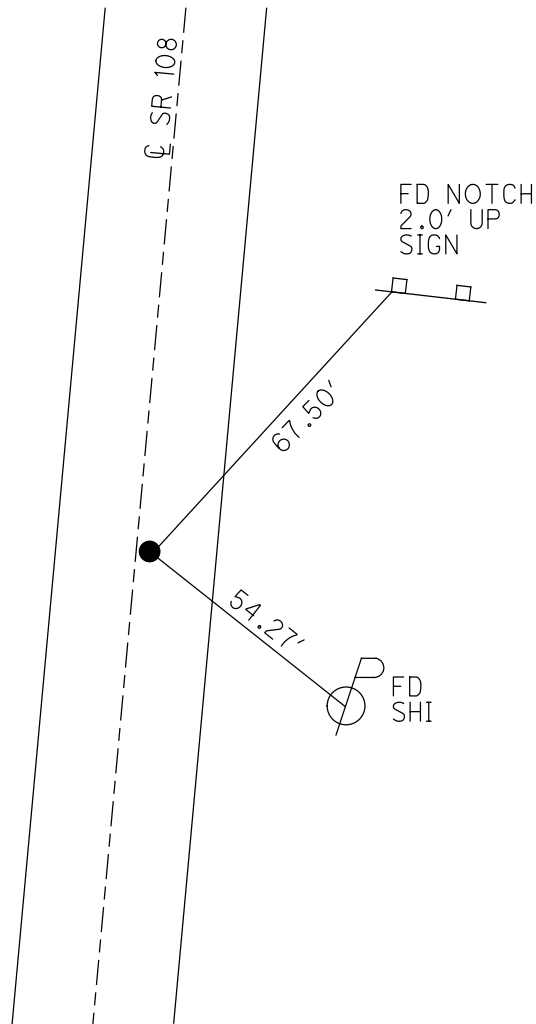

# O.D.O.T. DISTRICT 2 SURVEY OFFICE

PERSONNEL

REFERENCE NO. 38

SHEET 42 OF 54

NOTES VAN DUSEN

H.C. KUSE

R.C. BARNHISEL

DATE 8-18-92

WEATHER CLOUDY

TEMP. +75° F

ROUTE 5R 108

COUNTY HENRY

TOWNSHIP FLATROCK

SECTION 24

T4 N R 6 E


TYPE MONUMENT PK/WASHER

ON SURFACE - BELOW YES

LEFT - 0 PAV'T. - RIGHT 0.7


12.2 TO RT. EDGE PAVEMENT

S.L.M. 453+78

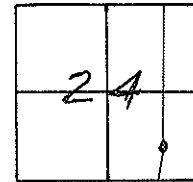

RECORDED  
STA. 455+11.97  
P.C.

SET P.K./WASHER  
9-17-92  
MB

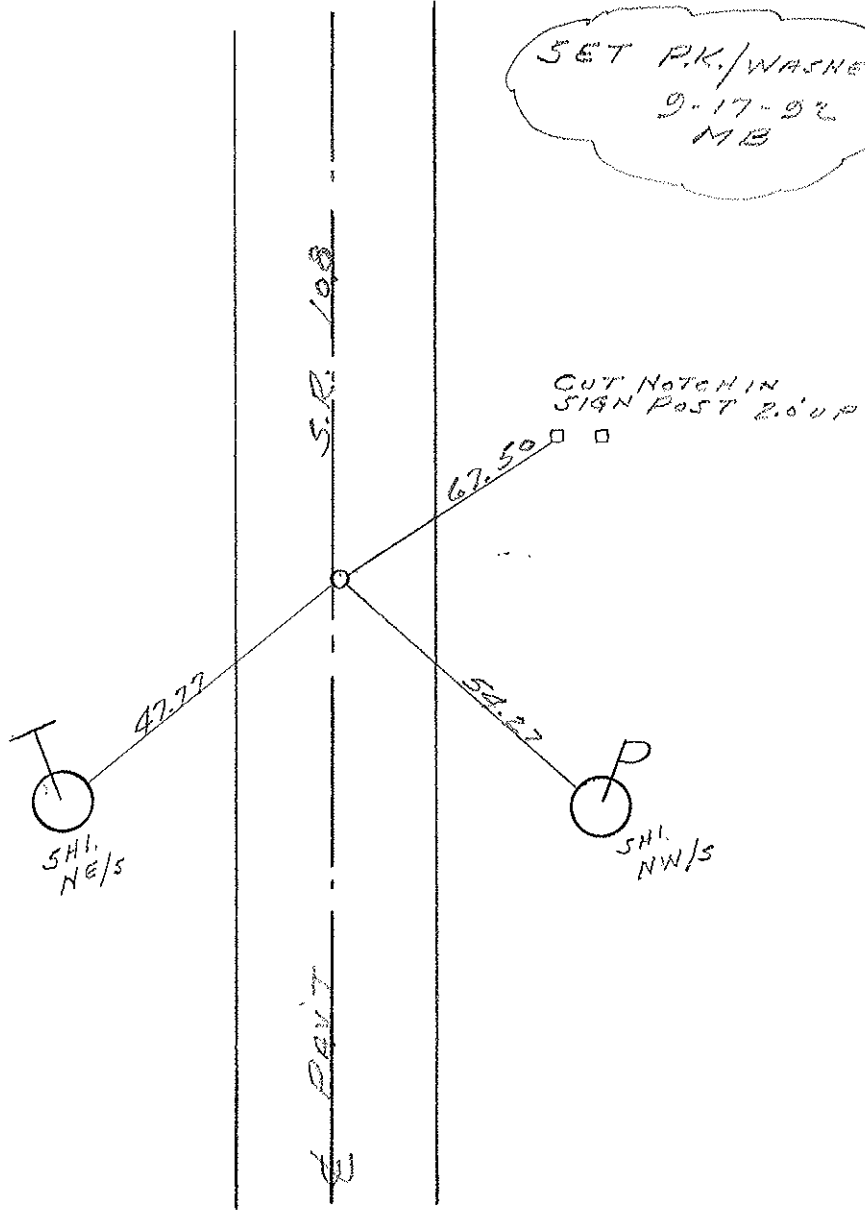

County Henry S.R. 108

Township Flatrock

Section 24

T4N, R6E

Personnel Hoffman

Loehke HC


Householder RC

Barnhisel Notes

Date 6-28-84

Weather Sunny

Temp. +82°

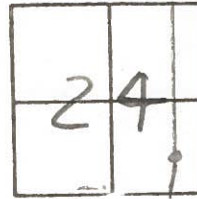

# 38

SLM 454+67

Fd 3m/RR SPK

1" Down

On  $\angle$  of 108

12.2 Lt of EP


10.8 Rt of EP

8-28-84

SET PK/WASHER


M.D.B.

Recorded  
Sta. 455+11.47  
P.C.

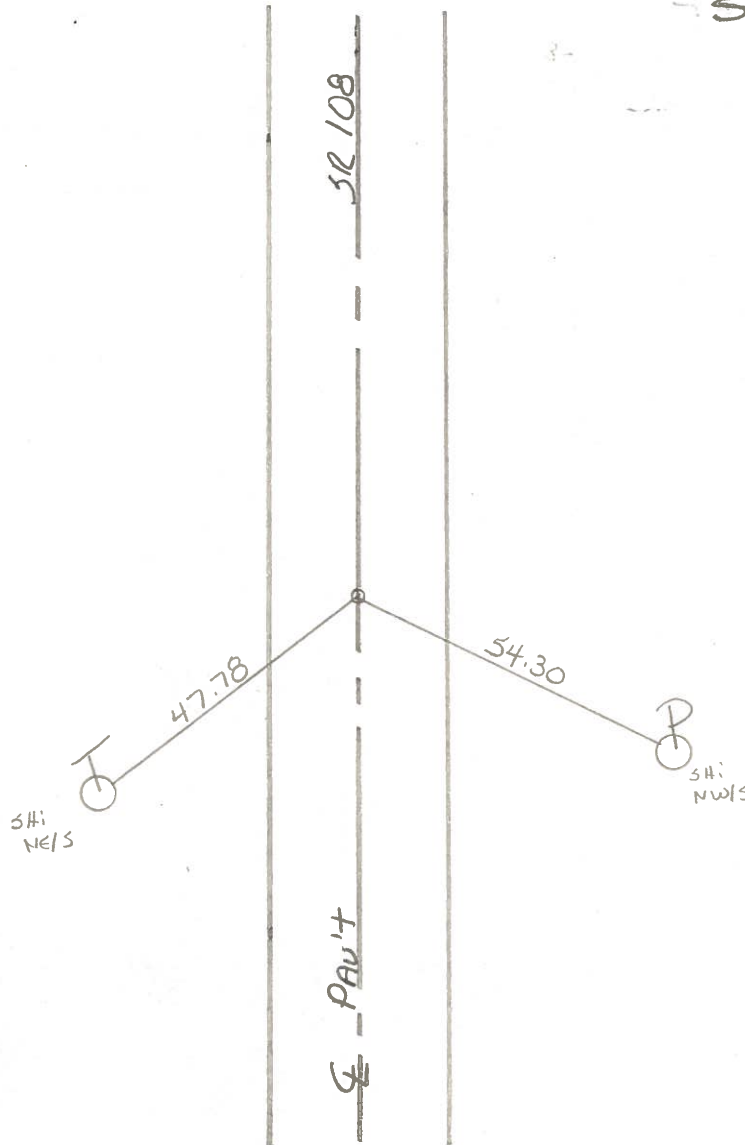

PERSONNEL	TITLE	PERSONNEL	TITLE	COUNTY	DATE	WEATHER	TEMP
Tomsic				HENRY	July 25, 1974		
Neuser				S. R. 108			
Janyo				SEC. Flotrack Twp.			
Granata							

DESCRIPTION	LEFT	CENTER LINE	RIGHT	JOB NO.
-------------	------	-------------	-------	---------

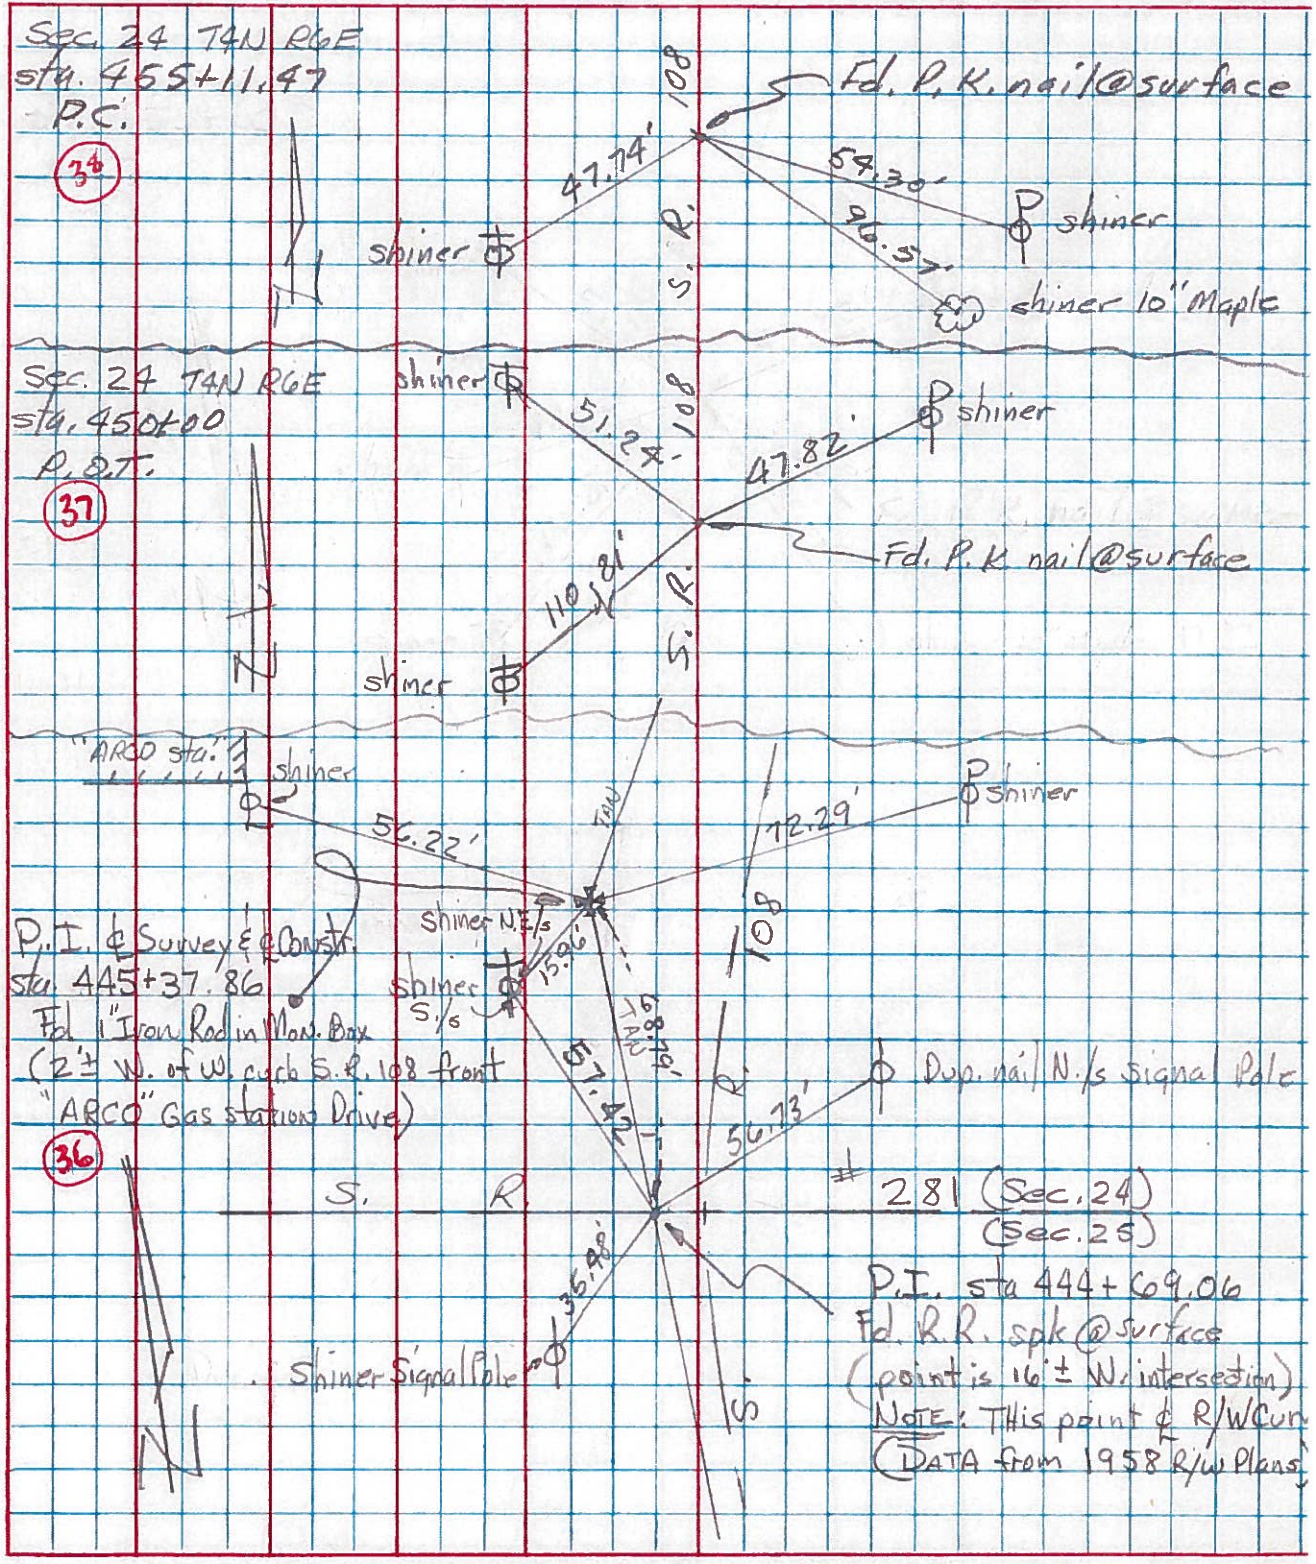

PERSONNEL	TITLE	PERSONNEL	TITLE	COUNTY	DATE
<u>Louise</u>				<u>Hen</u>	<u>6/4/71</u>
<u>Friksen</u>				S. R. # <u>108</u>	WEATHER <u>Fair</u>
<u>Rov</u>				SEC.	TEMP. <u>85°</u>
<u>Shaw</u>					

DESCRIPTION Ref Const Plan Dated 1958 JOB NO. \_\_\_\_\_

