


O.D.O.T. DISTRICT 2 SURVEY OFFICE (USE ONLY)


PERSONNEL _____ REFERENCE NO. 39 SHEET 25 OF 48
 NOTES LEU DATE 3/19/20 ROUTE SR 108
 H.C. LEU WEATHER CLOUDY COUNTY HENRY
 R.C. BALBAUGH TEMP. 41° TOWNSHIP FLATROCK
 DWG BY BALBAUGH PID 94319 SECTION 24
 T 4 N R 6 E

TYPE MONUMENT MONBOX W/ 1" IPIN
 ON SURFACE - ~~BELOW~~ ON _____
 OFFSET 0.8' TO RT EDGE PAVEMENT
 STATION: 458+10.06

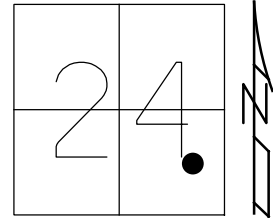

HORZ. DATUM: NAD83 (2011) GEOID: 2012A
 GRID: NORTHING: 594259.372 EASTING: 1524110.330

RECORD: P.I.
 STA 458+24.52 LT
 $\Delta = 08^\circ 20'$
 FD MONBOX
 8/17/92
 FD MONBOX
 W/ 1" IPIN
 REF39
 11-6-18, JLL
 FD MONBOX
 W/1" IPIN
 NEWREF39
 10-22-20, DSA

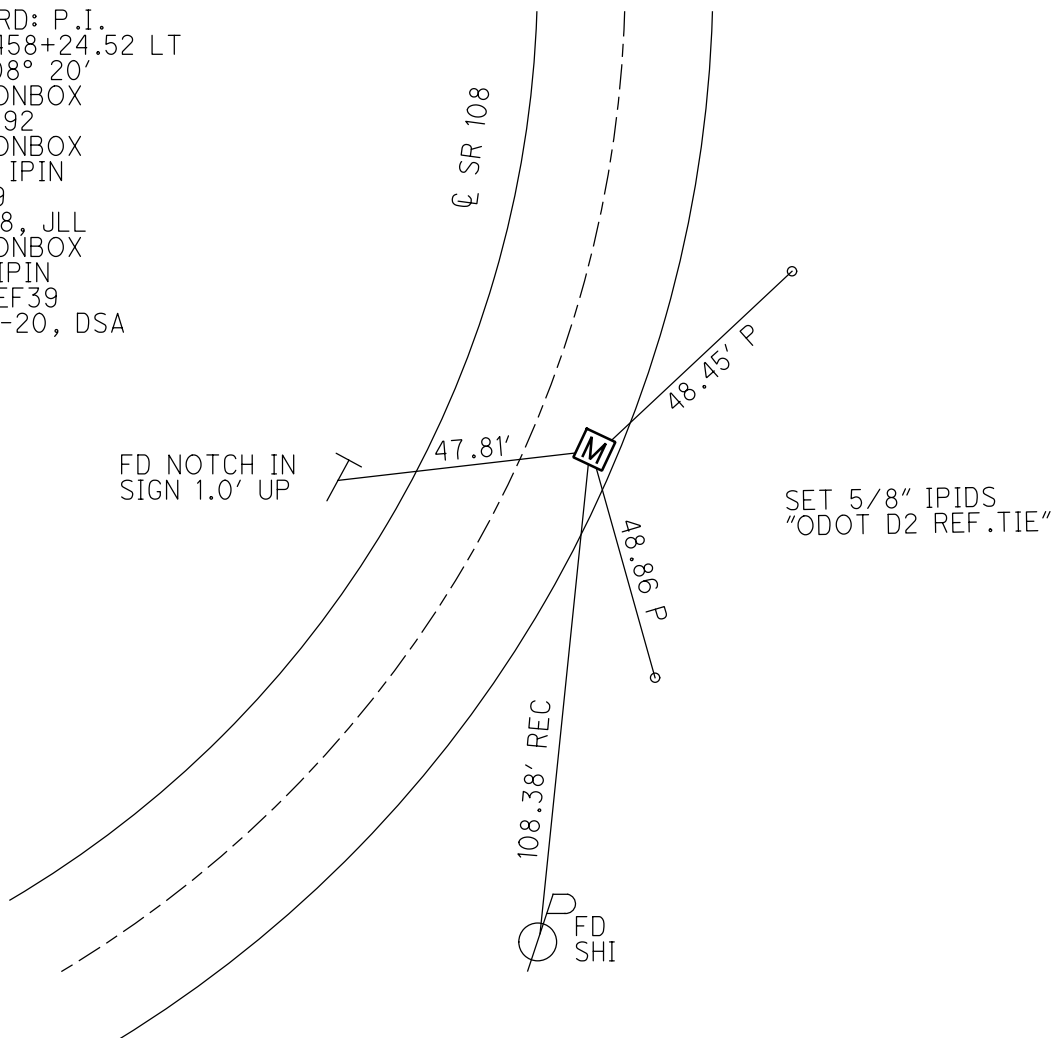

O.D.O.T. DISTRICT 2 SURVEY OFFICE

PERSONNEL

REFERENCE NO. 39

SHEET 43 OF 54

NOTES VAN DUSEN

H.C. KUSZ

R.C. BARNHISEL

DATE 8-17-92

WEATHER CLOUDY

TEMP. +75° F.

ROUTE S.R. 108

COUNTY HENRY

TOWNSHIP FLAT ROCK

SECTION 24

T4 N R 6 E


TYPE MONUMENT PK NAIL

ON SURFACE - BELOW YES


LEFT - C PAV'T. - RIGHT 11.9

0.8 TO RT. EDGE PAVEMENT

S.L.M. 456 + 90

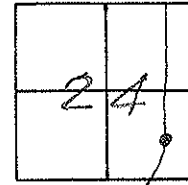

RECORDED
 STA. 458+24.52
 P.I.

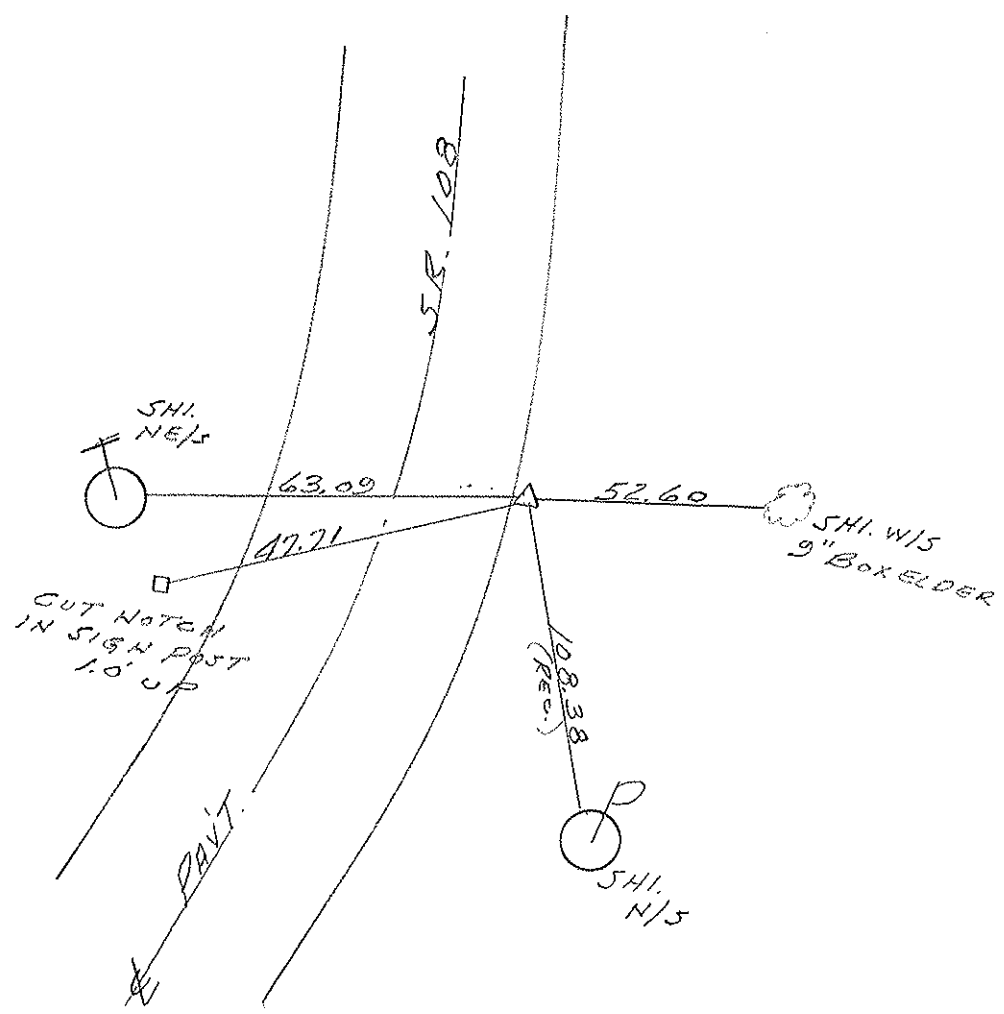

County Henry S.R. 108

Township Flatrock

Section 24

T4N, R6E

Personnel Hoffman

Loehrke HC


Householder RC

Barnhisel Notes

Date 6-28-84

Weather Sunny

Temp. +82°

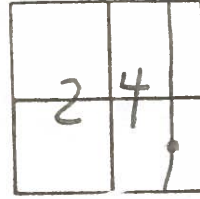


39

Mon Box
 SLM 457+79
 Fd PK @ Surface
 0.6 Rt of Rt EP
 11.9 Rt of & 108

8-28-84
 MON BOX WASN'T RAISED
 SET PK ABOVE
 M.D.B.




Recorded
 sta. 458+24.52
 P.I.

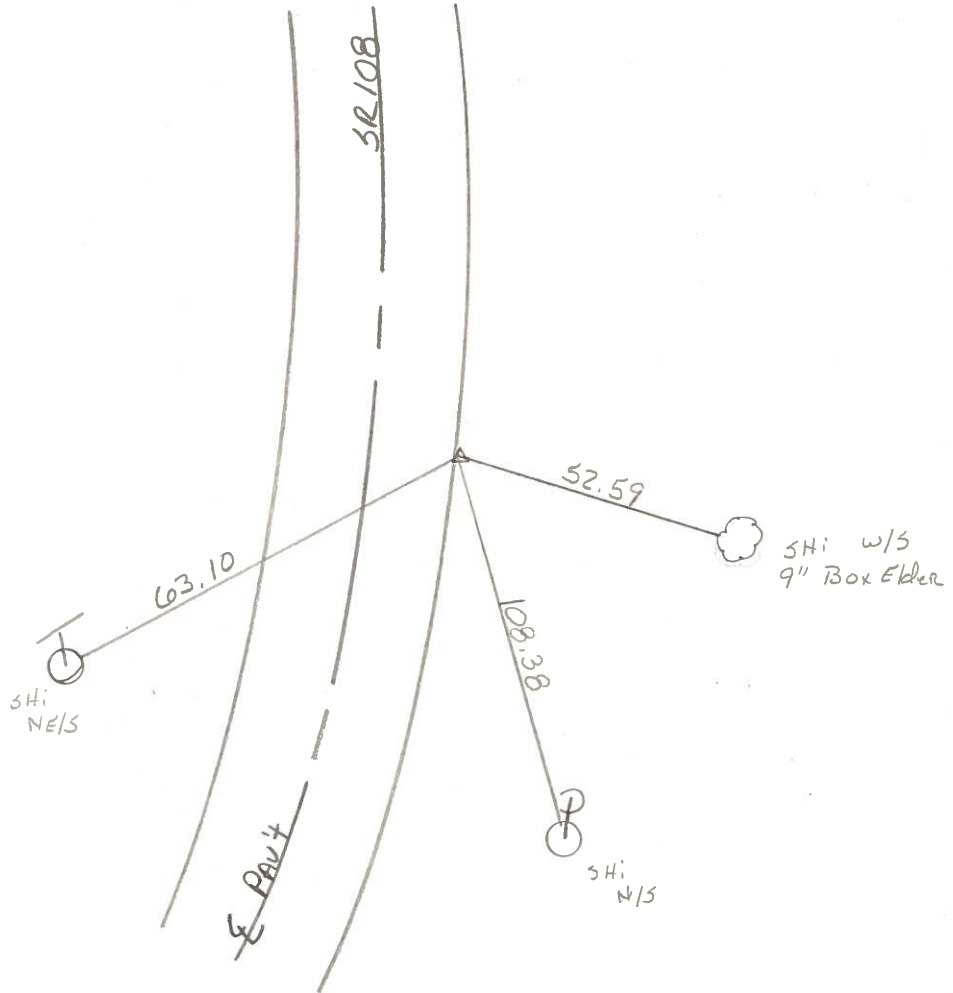

PERSONNEL	TITLE	PERSONNEL	TITLE
Tomsic			
Neuser			
Janyo			
Granata			

COUNTY HENRY DATE July 17, 1974
 S. R. 108 WEATHER _____
 SEC. FLAT ROCK TWP. TEMP. _____

DESCRIPTION _____ LEFT _____ CENTER LINE _____ RIGHT _____ JOB NO. _____

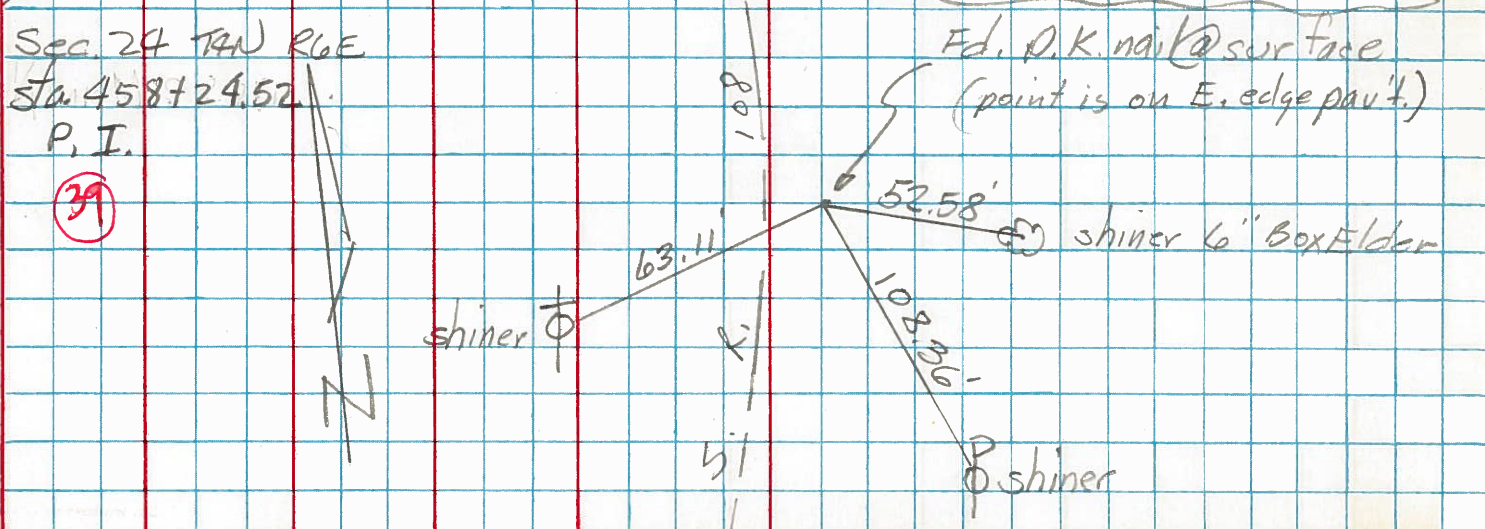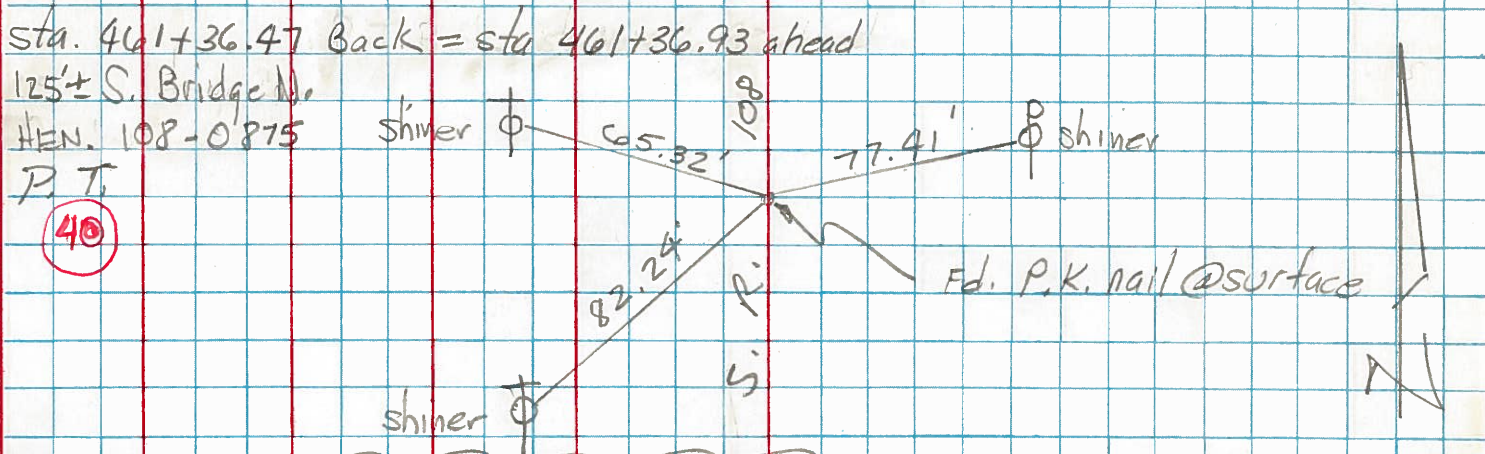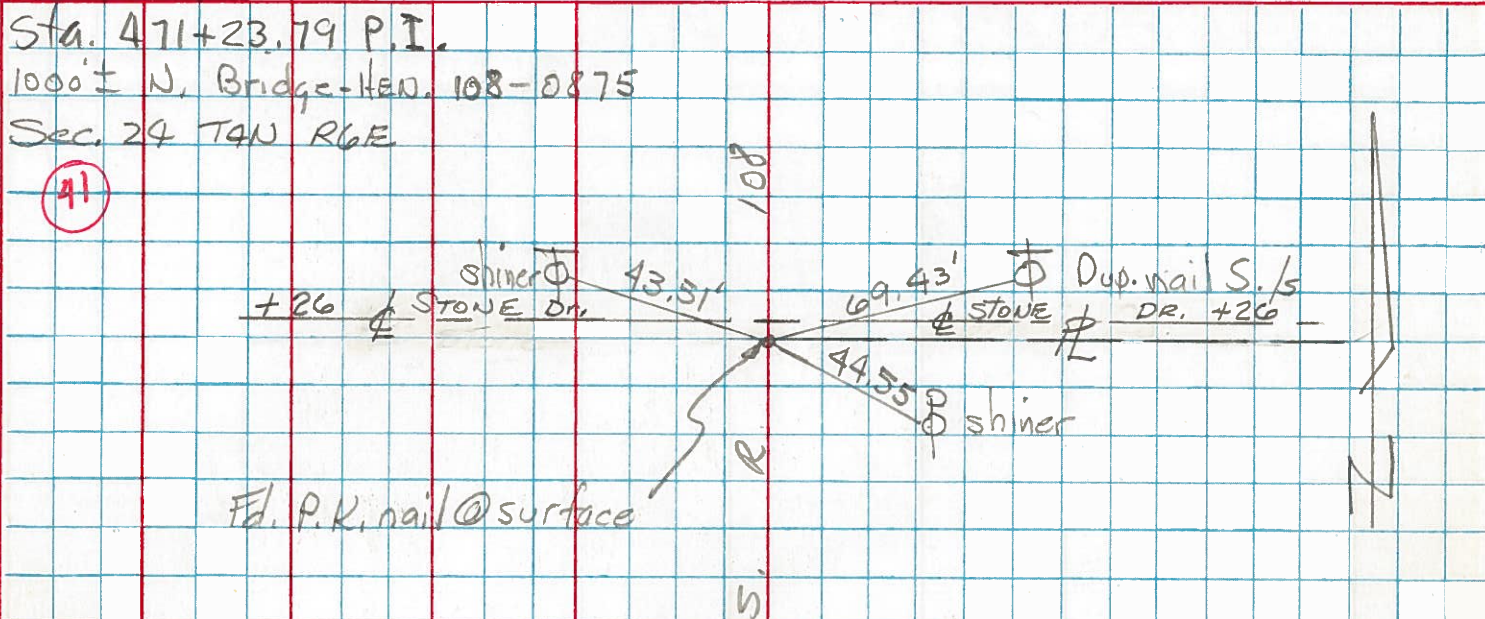

PERSONNEL	TITLE	PERSONNEL	TITLE	COUNTY	DATE
<u>Louws</u>				<u>Han</u>	<u>6/4/71</u>
<u>Cikson</u>				<u>S. R. # 108</u>	<u>Weather Fair</u>
<u>Ray</u>				<u>SEC.</u>	<u>TEMP. 85°</u>
<u>Shaw</u>					

DESCRIPTION Ref Const Plan Dated 1958 JOB NO. _____

