

O.D.O.T. DISTRICT 2 SURVEY OFFICE (USE ONLY)

PERSONNEL _____ REFERENCE NO. 41 SHEET 27 OF 48
 NOTES LEU DATE 3/19/20 ROUTE SR 108
 H.C. LEU WEATHER CLOUDY COUNTY HENRY
 R.C. BALBAUGH TEMP. 41° TOWNSHIP FLATROCK
 DWG BY BALBAUGH PID 94319 SECTION 24
 T 4 N R 6 E

TYPE MONUMENT MONBOX W/ 1" IPIN

ON SURFACE - ~~BELOW~~ ON


OFFSET \varnothing PAVEMENT ON LT : RT

13.0' TO LT EDGE PAVEMENT


STATION: 471+08.43

HORZ. DATUM: NAD83 (2011) GEOID: 2012A

GRID: NORTHING: 595558.789 EASTING: 1524098.248

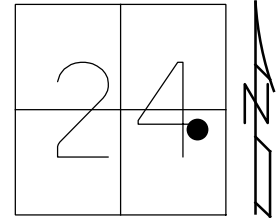

RECORD: P.I.
 STA 471+23.79
 $\Delta = 00^\circ 04'$
 FD MONBOX
 8/17/92, MB
 FD MONBOX
 W/ 1" IPIN
 REF41
 11-6-18, JLL
 FD MONBOX
 W/1" IPIN
 NEWREF41
 10-22-20, DSA

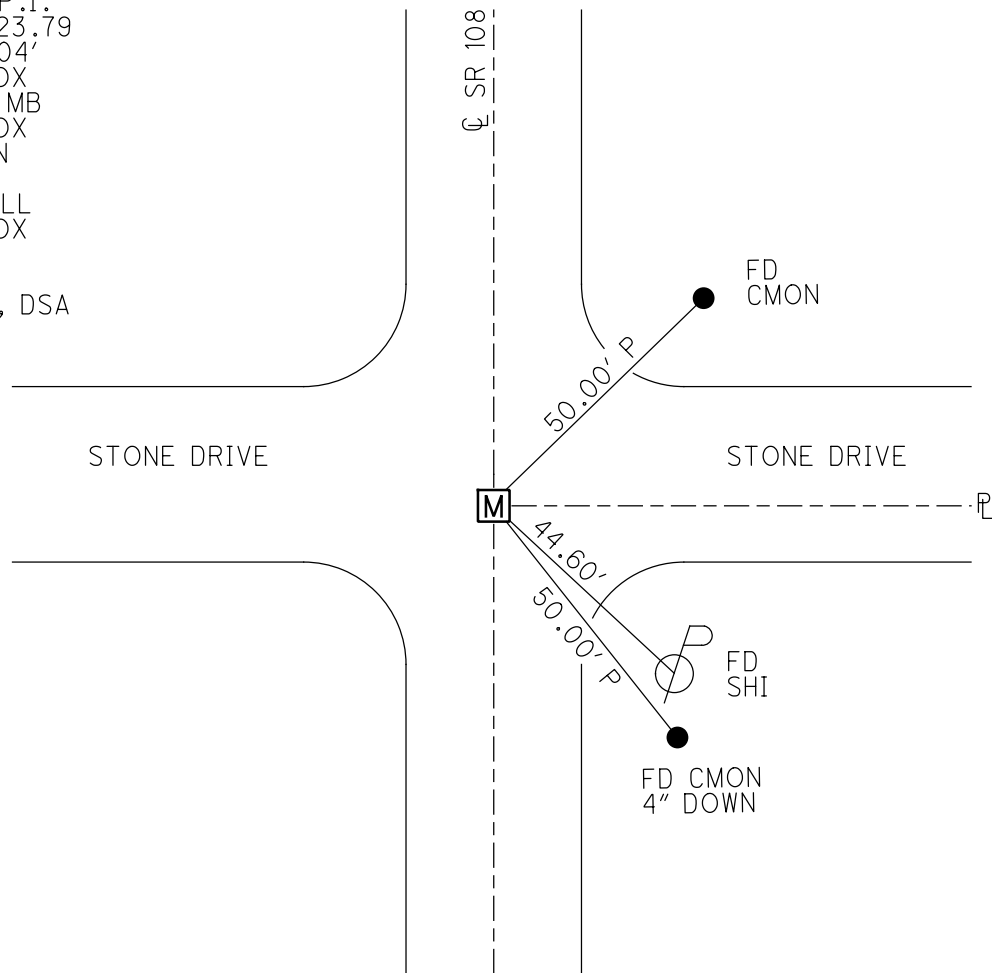

O.D.O.T. DISTRICT 2 SURVEY OFFICE

PERSONNEL _____ REFERENCE NO. 41 SHEET 45 OF 54

NOTES VAN DUSSAN

H.C. KUSZ DATE 8-17-92 ROUTE S.R. 108

R.C. BARNHISEL WEATHER Cloudy COUNTY HENRY

_____ TEMP. + 75° F. TOWNSHIP FLAT ROCK

_____ SECTION 24

_____ T. 4 N. R 6 E

TYPE MONUMENT Mon. Box

ON SURFACE - BELOW YES


LEFT - ¢ PAV'T. - RIGHT YES

13.0 TO LT. EDGE PAVEMENT

S.L.M. 469 + 9 @



Recorded P.E.
 STA. 471+23.79
 1000' N. of BRIDGE
 HEN-108-0875

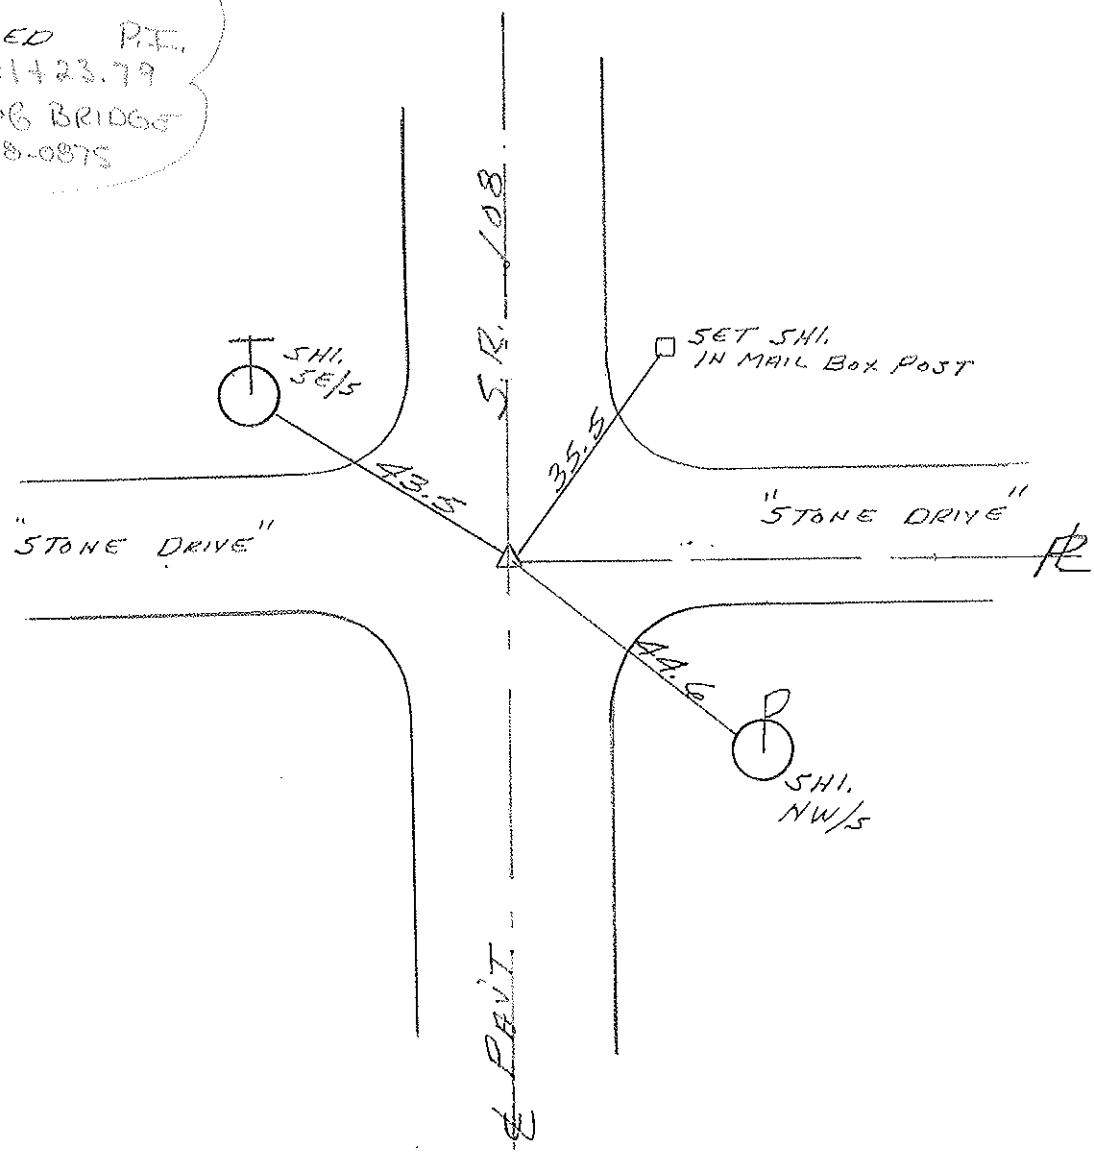

County Henry S.R. 108

Township Flatrock

Section 24

T4N, R6E

Personnel Hoffman

Loehrle HC


Householder RC

Barnhisel Notes

Date 6-28-84

Weather Sunny

Temp. +82°

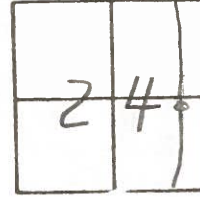


41

SLM 470+78 *Mon Box*
 Fd Mon Box 1" Down
 on E of 108
 11.7 Rt of 108
 11.7 Lt of 108

6-28-84


Recorded
 sta 471+23.79
 1000' N Bridge-Hen 108-0875
 P.I.

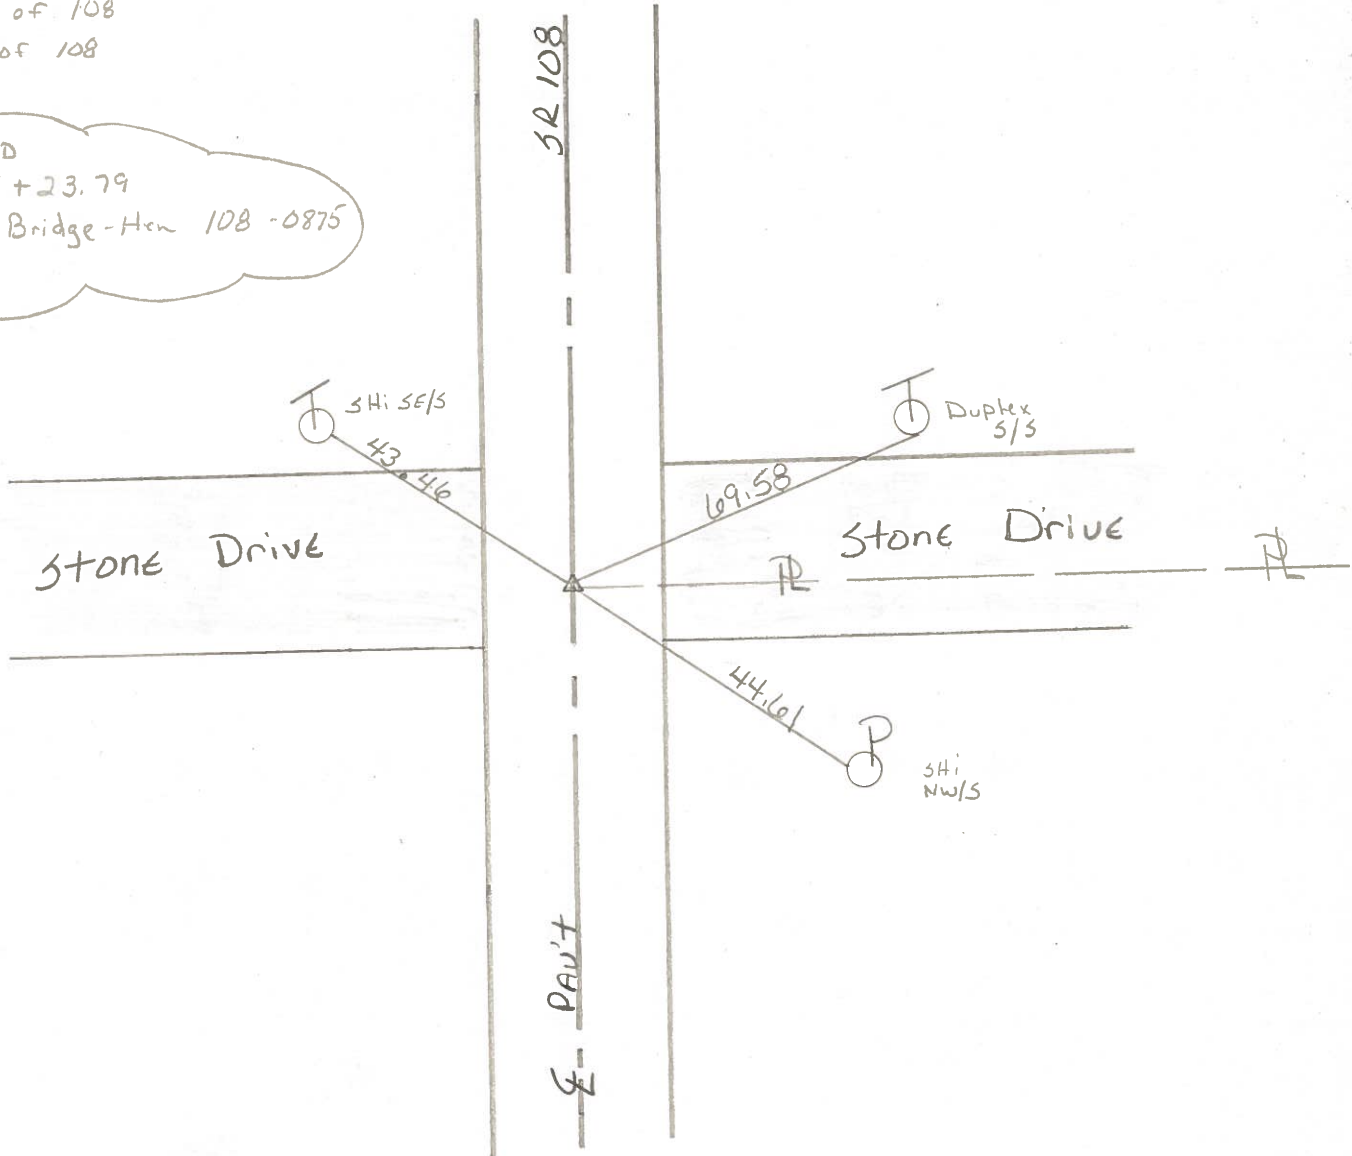

PERSONNEL	TITLE	PERSONNEL	TITLE
Tomsic			
Neuser			
Janyo			
Granata			

COUNTY HENRY DATE July 17, 1974
 S. R. 108 WEATHER _____
 SEC. FLAT ROCK TWP. TEMP. _____

DESCRIPTION LEFT CENTER LINE RIGHT JOB NO.

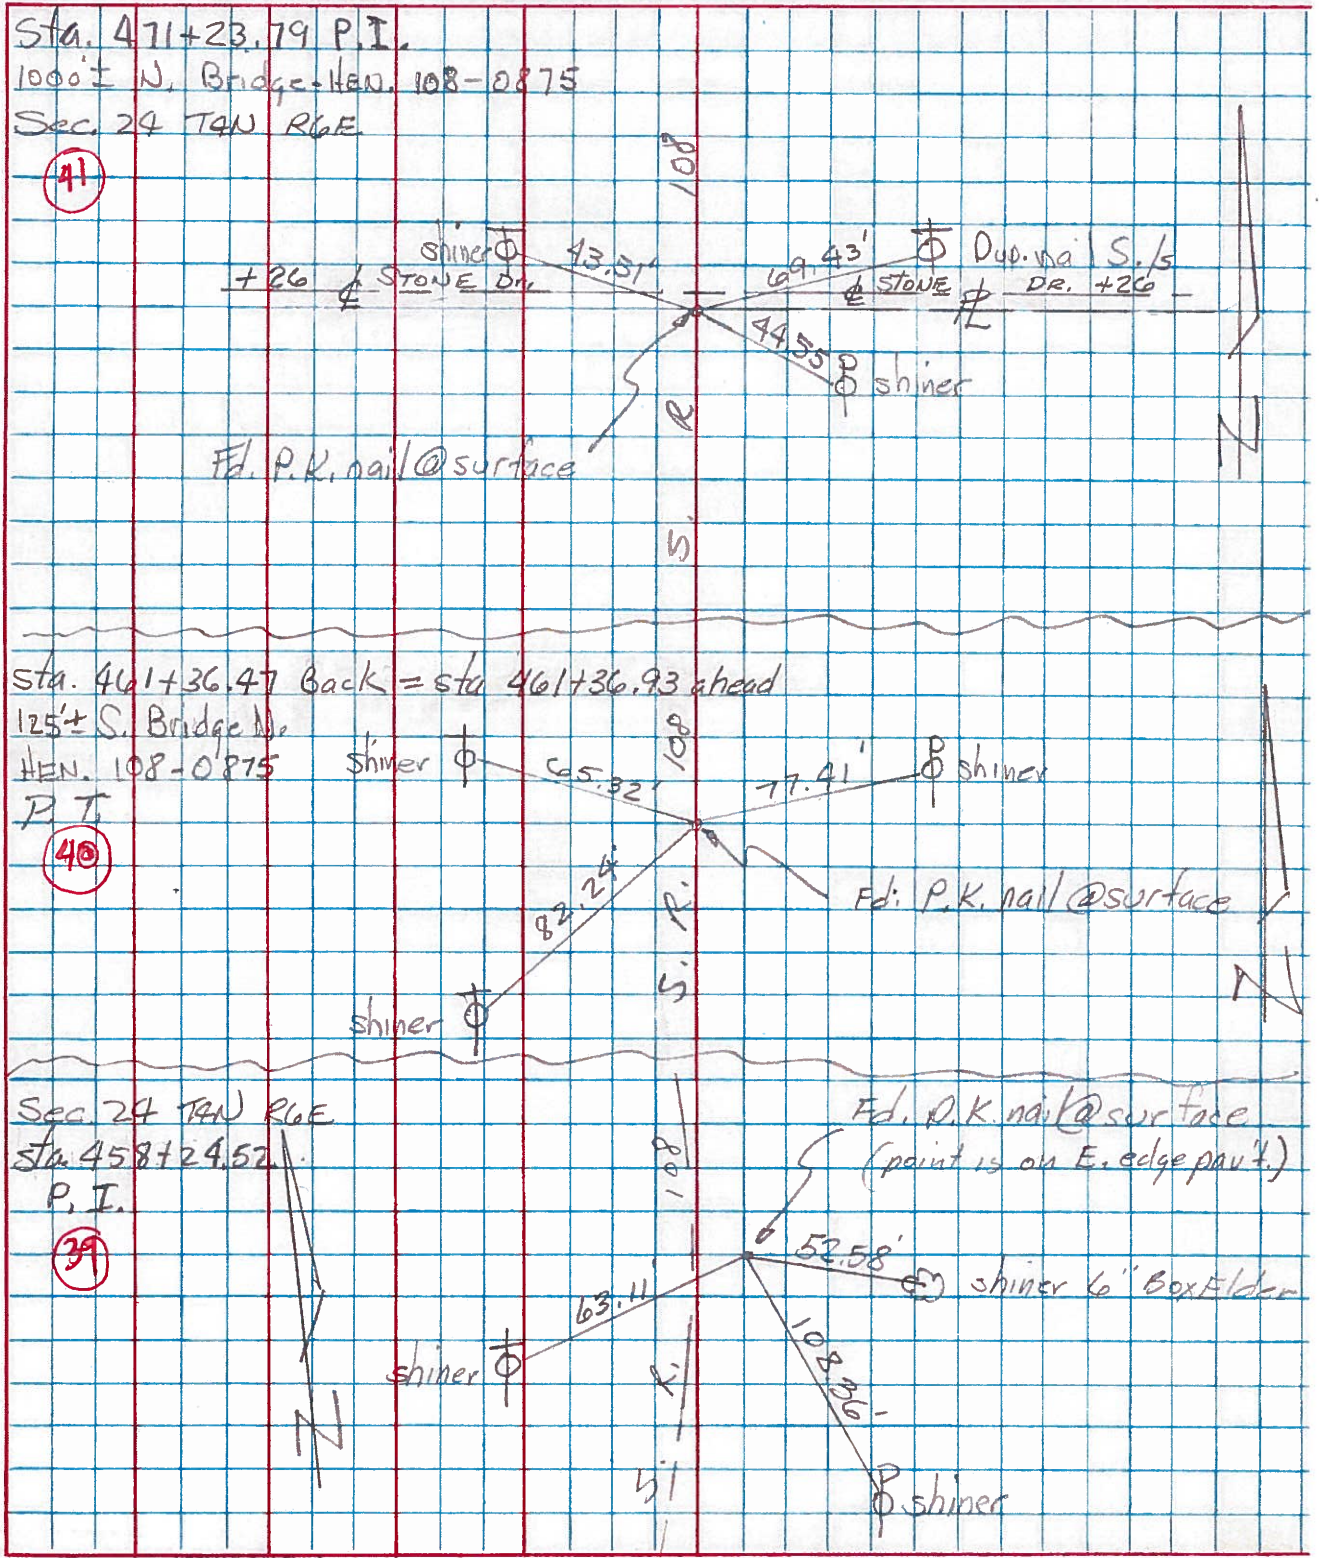

PERSONNEL TITLE PERSONNEL TITLE COUNTY Hen DATE 6/7/71
 Erikson Recorder S. R. # 108 WEATHER Clearly Windy
 Ray SEC. Holgate N. 6. Rd. TEMP. 80°
 Shaw
 DESCRIPTION Ref Const. Plan Dated 1958 JOB NO.

