

O.D.O.T. DISTRICT 2 SURVEY OFFICE (USE ONLY)

PERSONNEL \_\_\_\_\_ REFERENCE NO. 43 SHEET 29 OF 48  
 NOTES VAN DUSEN DATE 8/17/92 ROUTE SR 108  
 H.C. KUSZ WEATHER CLOUDY COUNTY HENRY  
 R.C. BARNHISEL TEMP. 75° TOWNSHIP FLATROCK  
 DWG BY MILLER PID 94319 SECTION 13  
 T 4 N R 6 E

TYPE MONUMENT P.K./WASHER

ON SURFACE - ~~BELOW~~ ON \_\_\_\_\_


OFFSET  $\varnothing$  PAVEMENT ON \_\_\_\_\_ LT : RT

12.4' TO RT EDGE PAVEMENT


STATION: 511+82

HORZ.DATUM: \_\_\_\_\_ GEOID: \_\_\_\_\_

GRID: NORTHING: \_\_\_\_\_ EASTING: \_\_\_\_\_

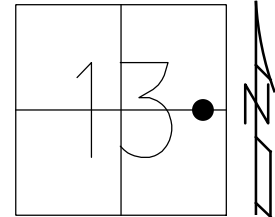

RECORD: P.O.T  
 STA 512+00  
 FD P.K./WASHER  
 8/17/92, MB  
 SET P.K./WASHER  
 9-17-92, MD  
 DNF  
 11-6-18, JLL  
 DID NOT SET  
 10-22-20, DSA

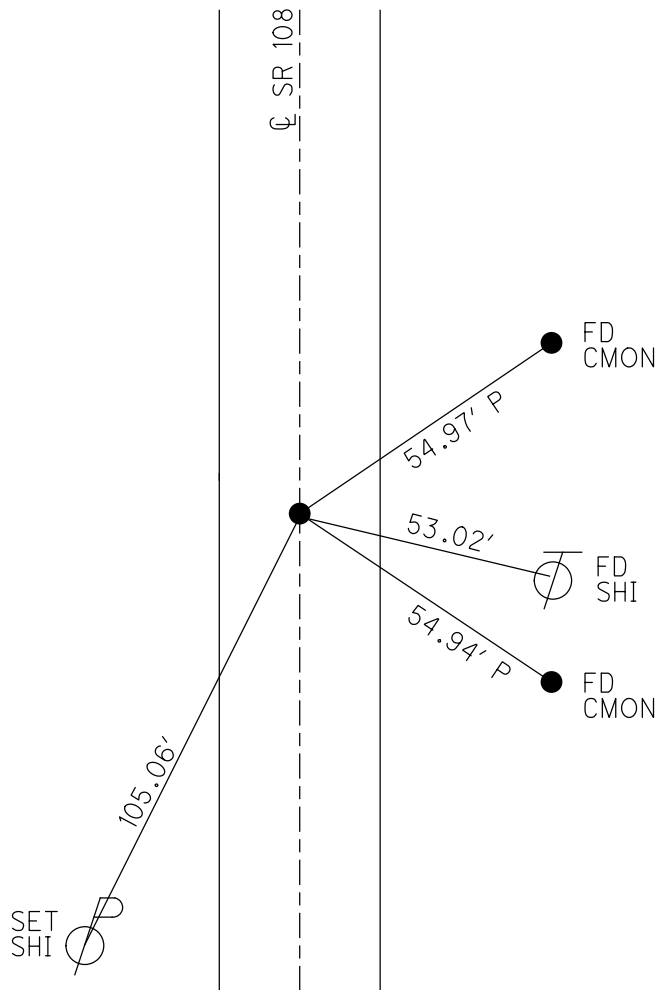

# O.D.O.T. DISTRICT 2 SURVEY OFFICE

PERSONNEL

REFERENCE NO. 43

SHEET 47 OF 54

NOTES VAN DUSEN

H.C. KUSE

R.C. BARNHISEL

DATE 17 AUG 92

WEATHER cloudy

TEMP. 75°

ROUTE 108

COUNTY HENRY

TOWNSHIP FIATROCK

SECTION 13

T 4 N R 6 E


TYPE MONUMENT PK & WASHER

ON SURFACE - BELOW YES

LEFT - C PAV'T. - RIGHT YES


12.4 TO RT EDGE PAVEMENT

S.L.M. 510 + 63

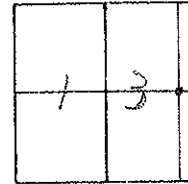

RECORDED  
STA 512+00  
P.O.T.  
USED ON 1958  
R/W PLANS

SET PK & WASHER  
9-17-92  
MB

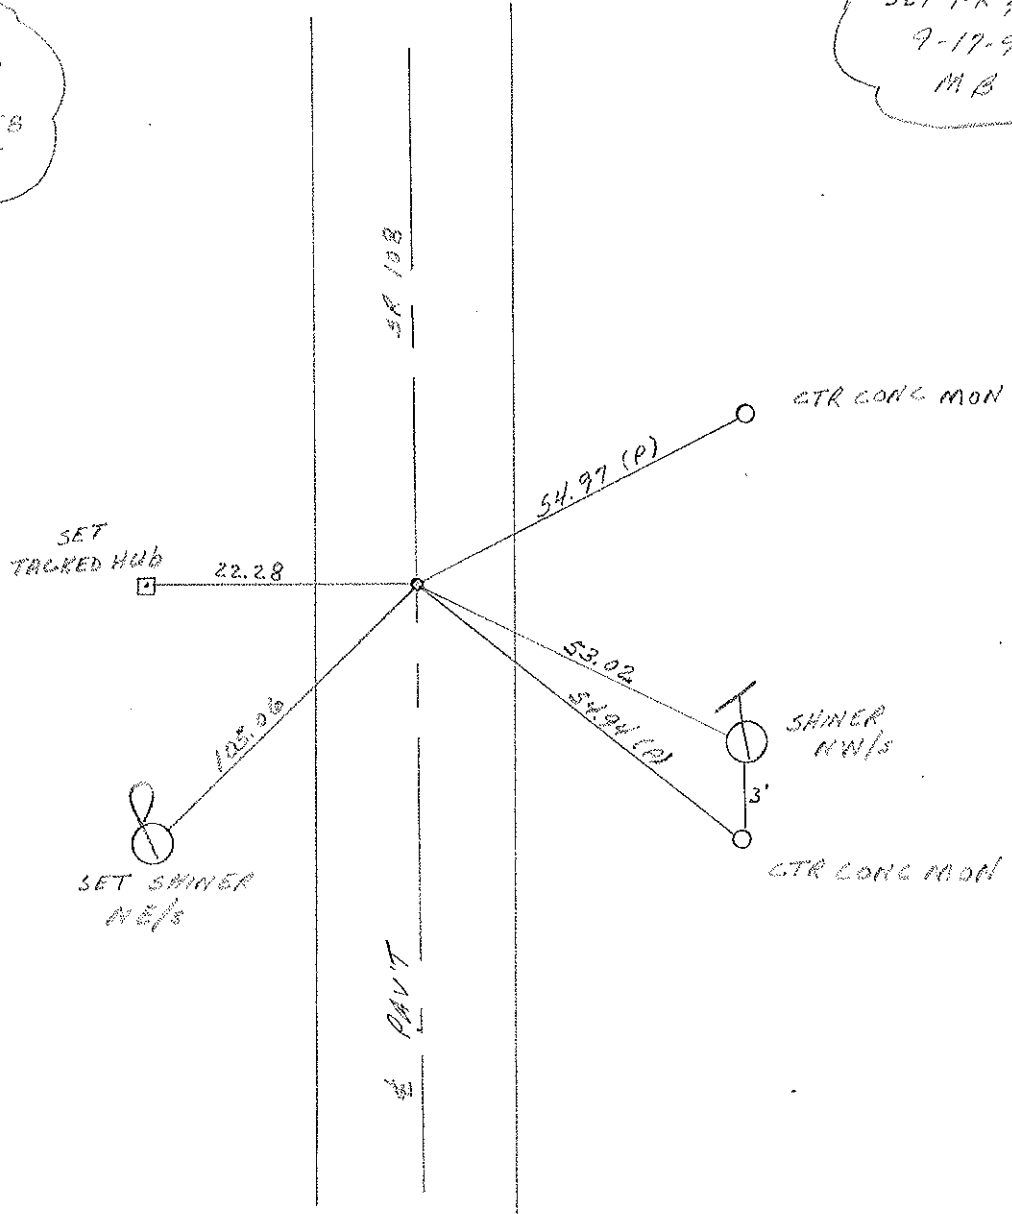

County HENRY S.R. 108

Township FLATROCK

Section 13

T4N, R6E

Personnel Hoffman

Loehrke IC


Householder RC

Barahisel Notes

Date 6-28-84

Weather Sunny

Temp. +82°

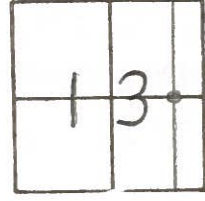


# 43

SLM 511+53

fd nail  
 on E of 108  
 11.6 Rt of EP  
 12.5 Lt of 6P  
 55 ft between monuments


Recorded  
 Sta 512+00  
 P.O.T.  
 (used old 1958  
 R/W Plans)

8-28-84  
 SET PK/WASHER  
 M, D, B

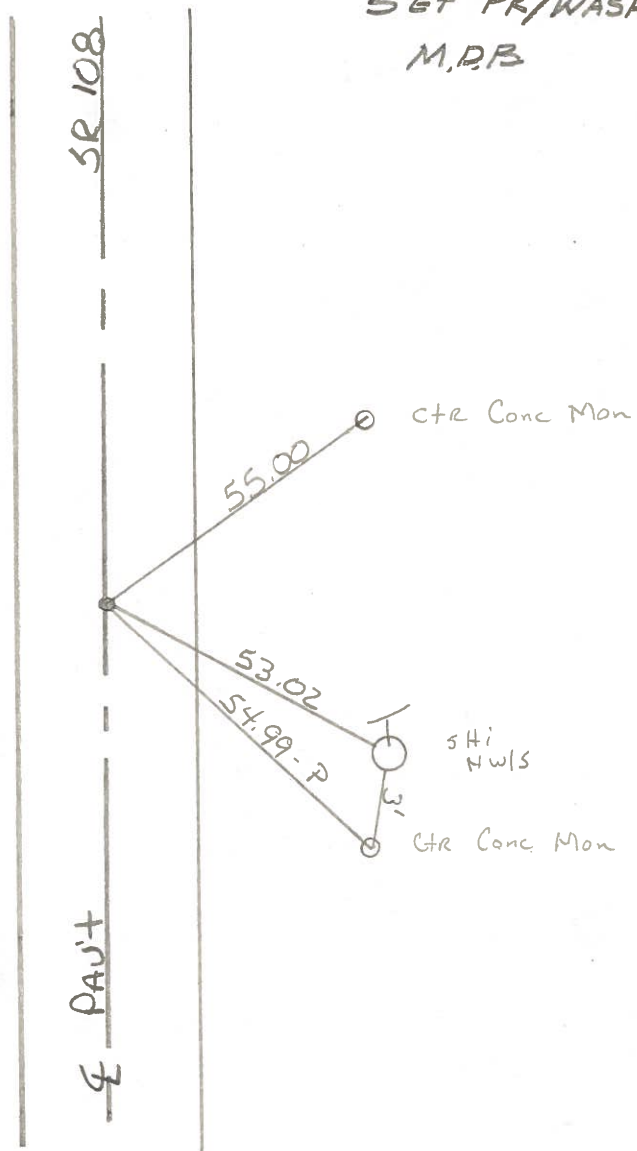

PERSONNEL TOMSIK TITLE \_\_\_\_\_ PERSONNEL \_\_\_\_\_ TITLE \_\_\_\_\_ COUNTY HENRY DATE July-17-1974  
NEUSER \_\_\_\_\_ \_\_\_\_\_ \_\_\_\_\_ S. R. 108 WEATHER \_\_\_\_\_  
VANYO \_\_\_\_\_ \_\_\_\_\_ \_\_\_\_\_ SEC. FLATROCK TWP. TEMP. \_\_\_\_\_  
Granata \_\_\_\_\_ \_\_\_\_\_ \_\_\_\_\_

DESCRIPTION \_\_\_\_\_ LEFT \_\_\_\_\_ CENTER LINE \_\_\_\_\_ RIGHT \_\_\_\_\_ JOB NO. \_\_\_\_\_

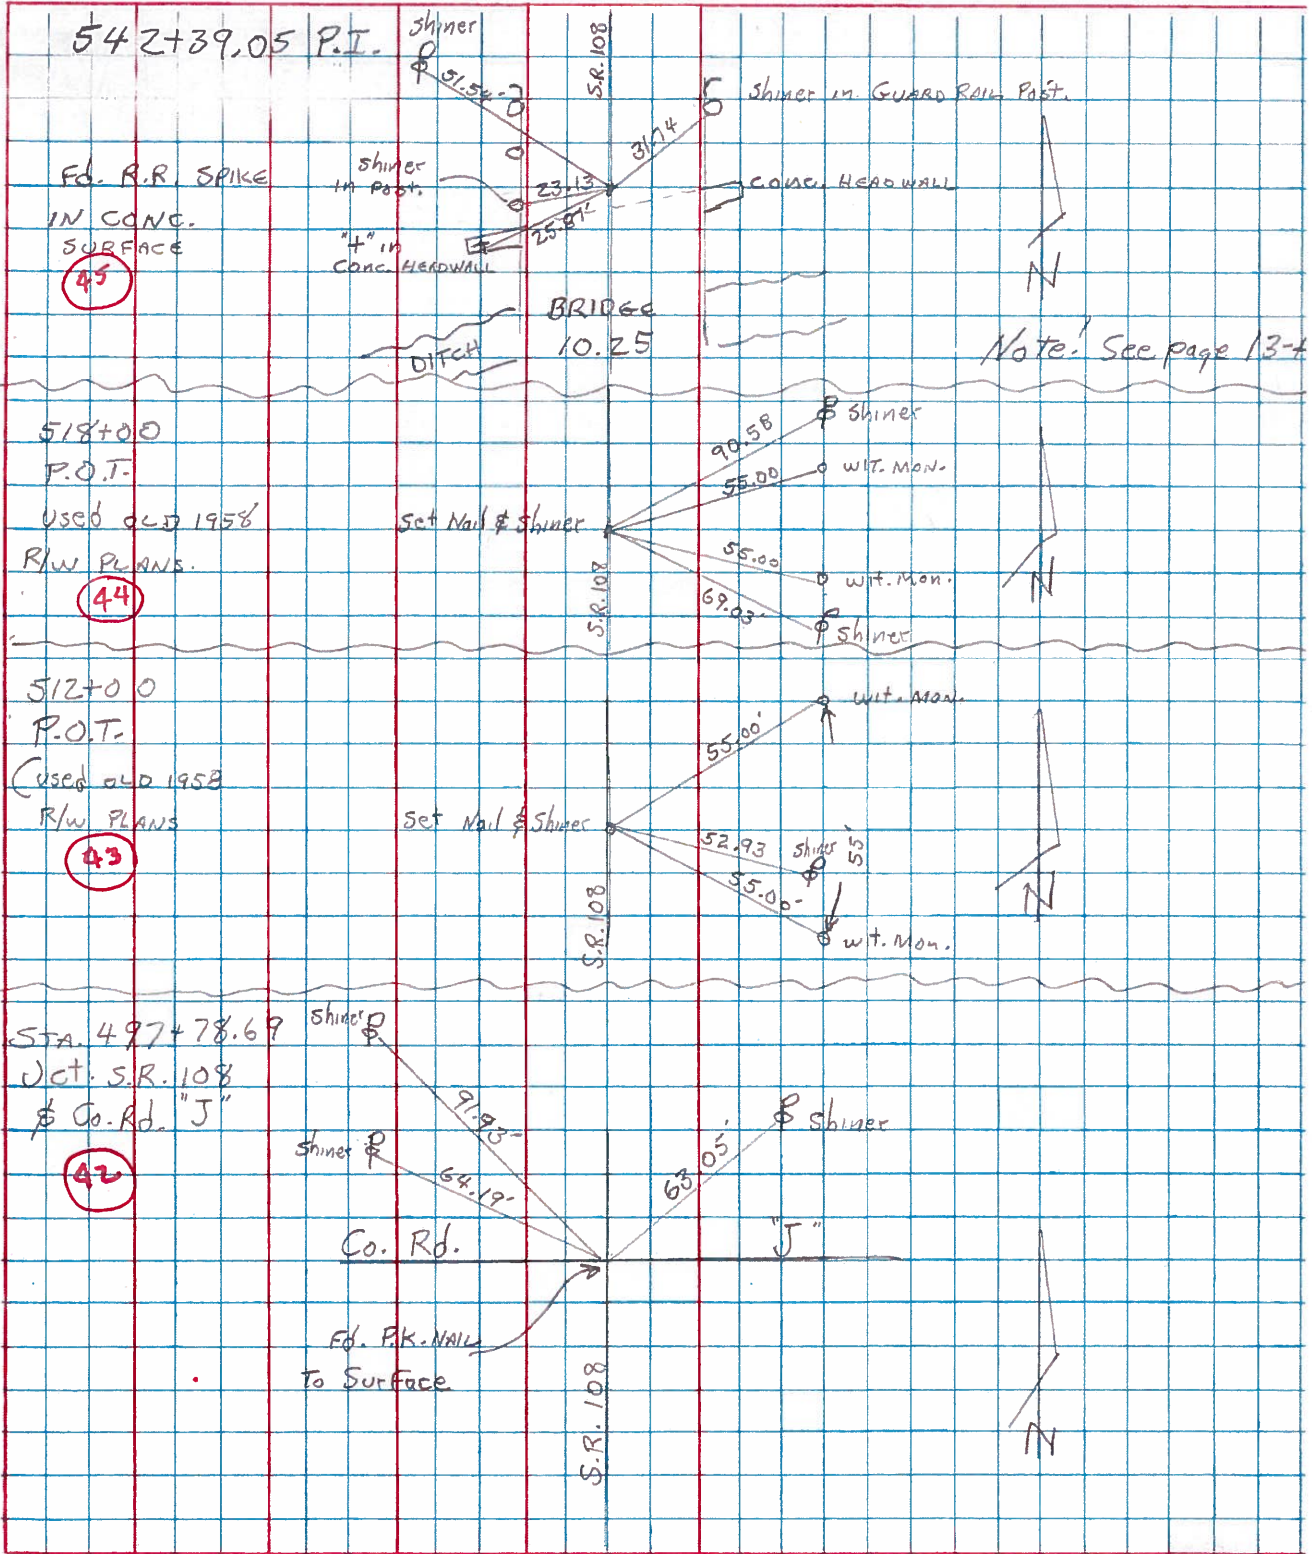

PERSONNEL TITLE PERSONNEL TITLE

Louys  
Eriksen Recorder  
Rau  
Shaw

COUNTY Hen DATE 6/8/71

S. R. #108 WEATHER Cloudy Windy


SEC. Holgate to N. Co Rd. TEMP. 70°

DESCRIPTION Reference Const Plan Dated 1958 JOB NO.

LEFT CENTER LINE RIGHT


44

POT 518+00  
Found Mon's  
6/8/71

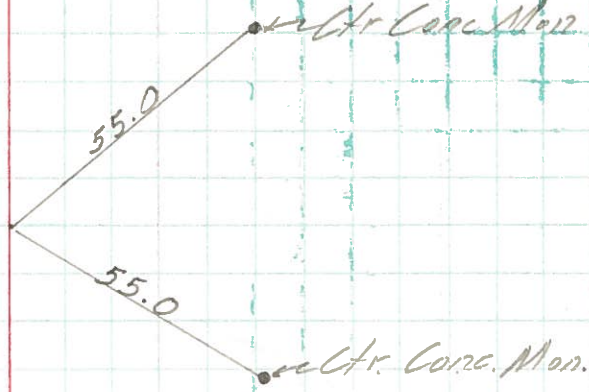

43

POT 512+00  
Found Mon's  
6/8/71  
S.H.L.

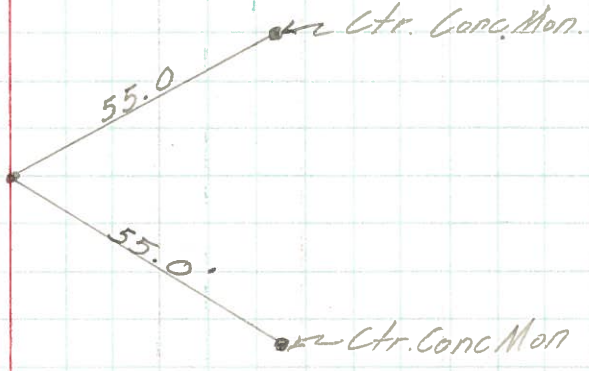

POT 505+00  
Found Mon's  
6/8/71  
S.H.L.

