


O.D.O.T. DISTRICT 2 SURVEY OFFICE (USE ONLY)


PERSONNEL \_\_\_\_\_ REFERENCE NO. 45 SHEET 31 OF 48  
 NOTES BALBAUGH DATE 3/18/20 ROUTE SR 108  
 H.C. LEU WEATHER CLOUDY COUNTY HENRY  
 R.C. BALBAUGH TEMP. 38° TOWNSHIP FLATROCK  
 SECTION 13  
 DWG BY BALBAUGH PID 94319 T 4 N R 6 E

TYPE MONUMENT MONBOX W/ 1" IPIN  
 ON SURFACE - ~~BELOW~~ ON  
 OFFSET 0.5' LT : ~~RT~~  
12.8' TO RT EDGE PAVEMENT  
 STATION: 524+14.23

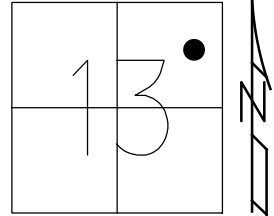

HORZ. DATUM: NAD83 (2011) GEOID: 2012A  
 GRID: NORTHING: 600864.431 EASTING: 1524056.142

RECORD: P.I.  
 STA 524+39.05  
 $\Delta = 00^\circ 28'$   
 FD MONBOX  
 8/17/92, MB  
 FD MONBOX  
 W/ 1" IPIN  
 REF45  
 11-6-18, JLL  
 FD MONBOX  
 W/1" IPIN  
 NEWREF45  
 10-22-20, DSA

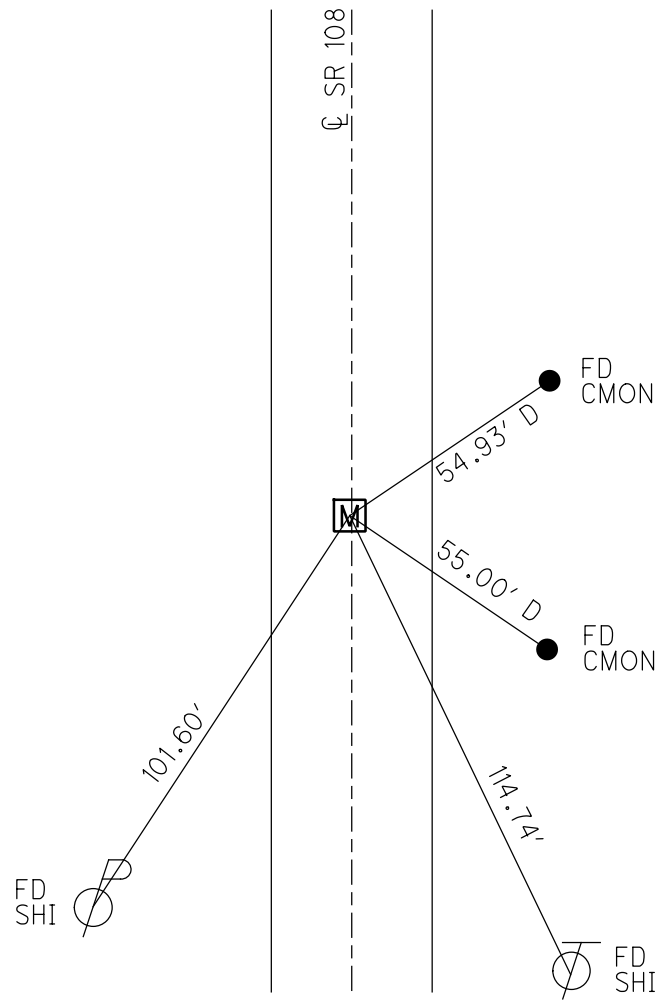

# O.D.O.T. DISTRICT 2 SURVEY OFFICE

PERSONNEL

REFERENCE NO. 46

SHEET 50 OF 54

NOTES VAN DUSEN

H.C. KUSZ

R.C. BARNHISEL

DATE 17 AUG 92

WEATHER CLEAR

TEMP. 75°

ROUTE 108

COUNTY HENRY

TOWNSHIP FIATROCK

SECTION 13

T 4 N R 6 E


TYPE MONUMENT MON BOX

ON SURFACE - ~~BELOW~~ YES


~~LEFT - & PAV'T. - RIGHT~~ YES

12.8 TO RT EDGE PAVEMENT

S.L.M. 522 + 94

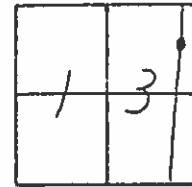

RECORDED  
 STA. 524+39.05  
 P.I.  
 1/2 MILE N. OF RD "J"

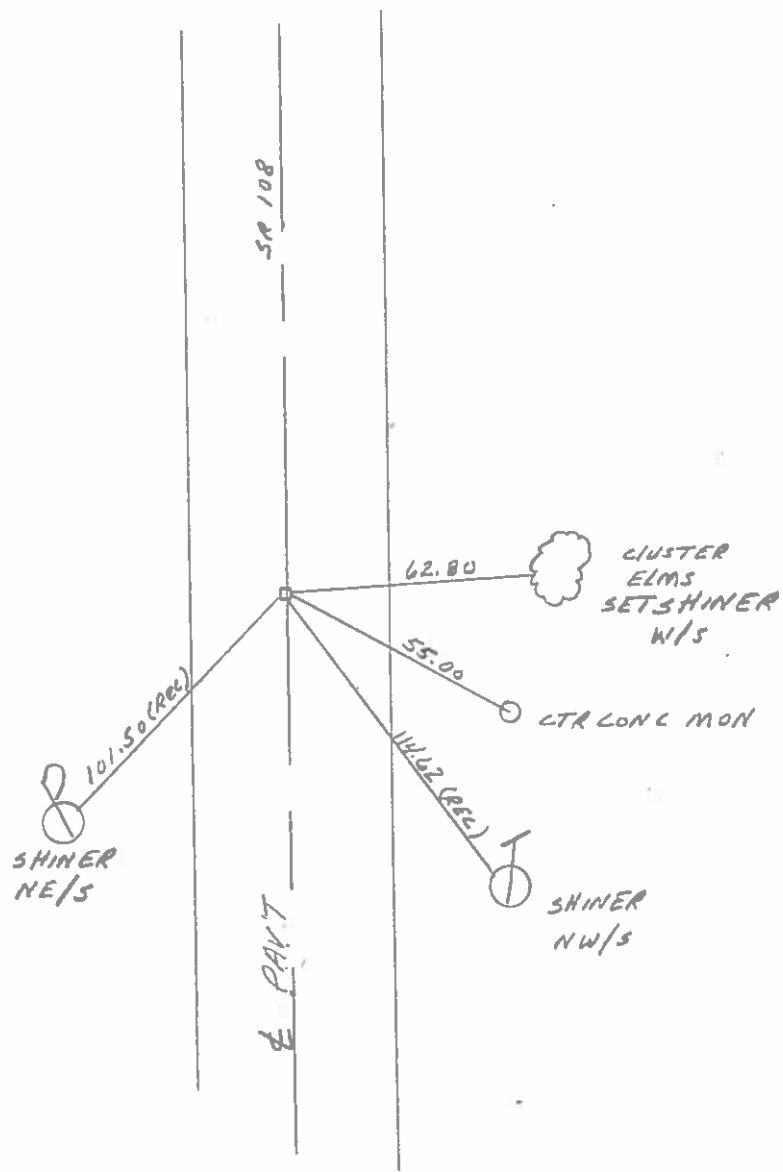

County HENRY S.R. 108

Township Flatrock

Section 13

T4N, R6E

Personnel Hoffman

Lochrke HC


Householder RC

Barnhisel Notes

Date 6-28-84

Weather Sunny

Temp. +82°

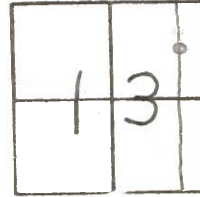

#46

SLM 523+84

Fd Mon Box

1 1/2" Down

on E of 108

11.7 Lt of EP

11.7 Rt of EP

Mon Box


8-28-84

SET PK/WASHER

M.D.B.

Recorder  
Sta 524+39.05

P.I.  
1/2 mile N. of Rd "J"

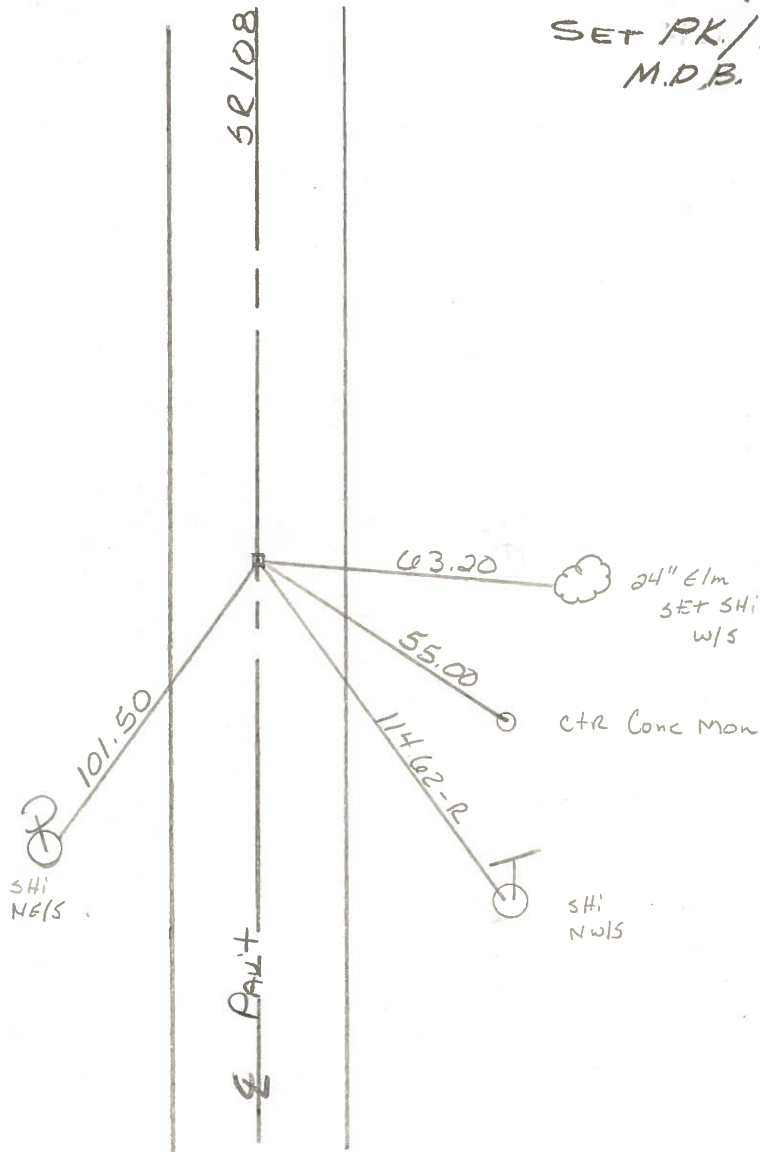

PERSONNEL	TITLE	PERSONNEL	TITLE
Tomsic			
Neuser			
Vanyo			
Grahata			

COUNTY Henry DATE July-17-74


S. R. 108 WEATHER

SEC. FLAT ROCK Twp. TEMP.

DESCRIPTION	LEFT	CENTER LINE	RIGHT	JOB NO.
-------------	------	-------------	-------	---------

524+31.15 P.I.  
1/2 mile N. Co. "J"

46

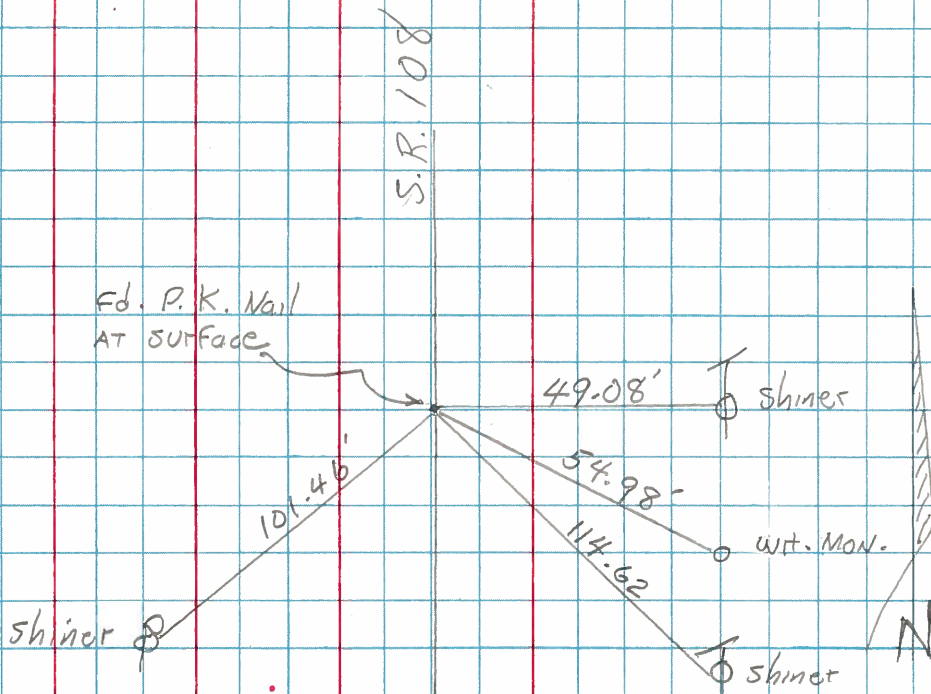


PERSONNEL TITLE PERSONNEL TITLE

Louys Erikson Recorder  
Dow  
Shaw

COUNTY Hen DATE 6/8/71  
S. R. #108 WEATHER Cloudy Windy  
SEC. Holgate to N.W. Cor TEMP. 70°

DESCRIPTION Ref Const Plan Dated 1958 JOB NO.

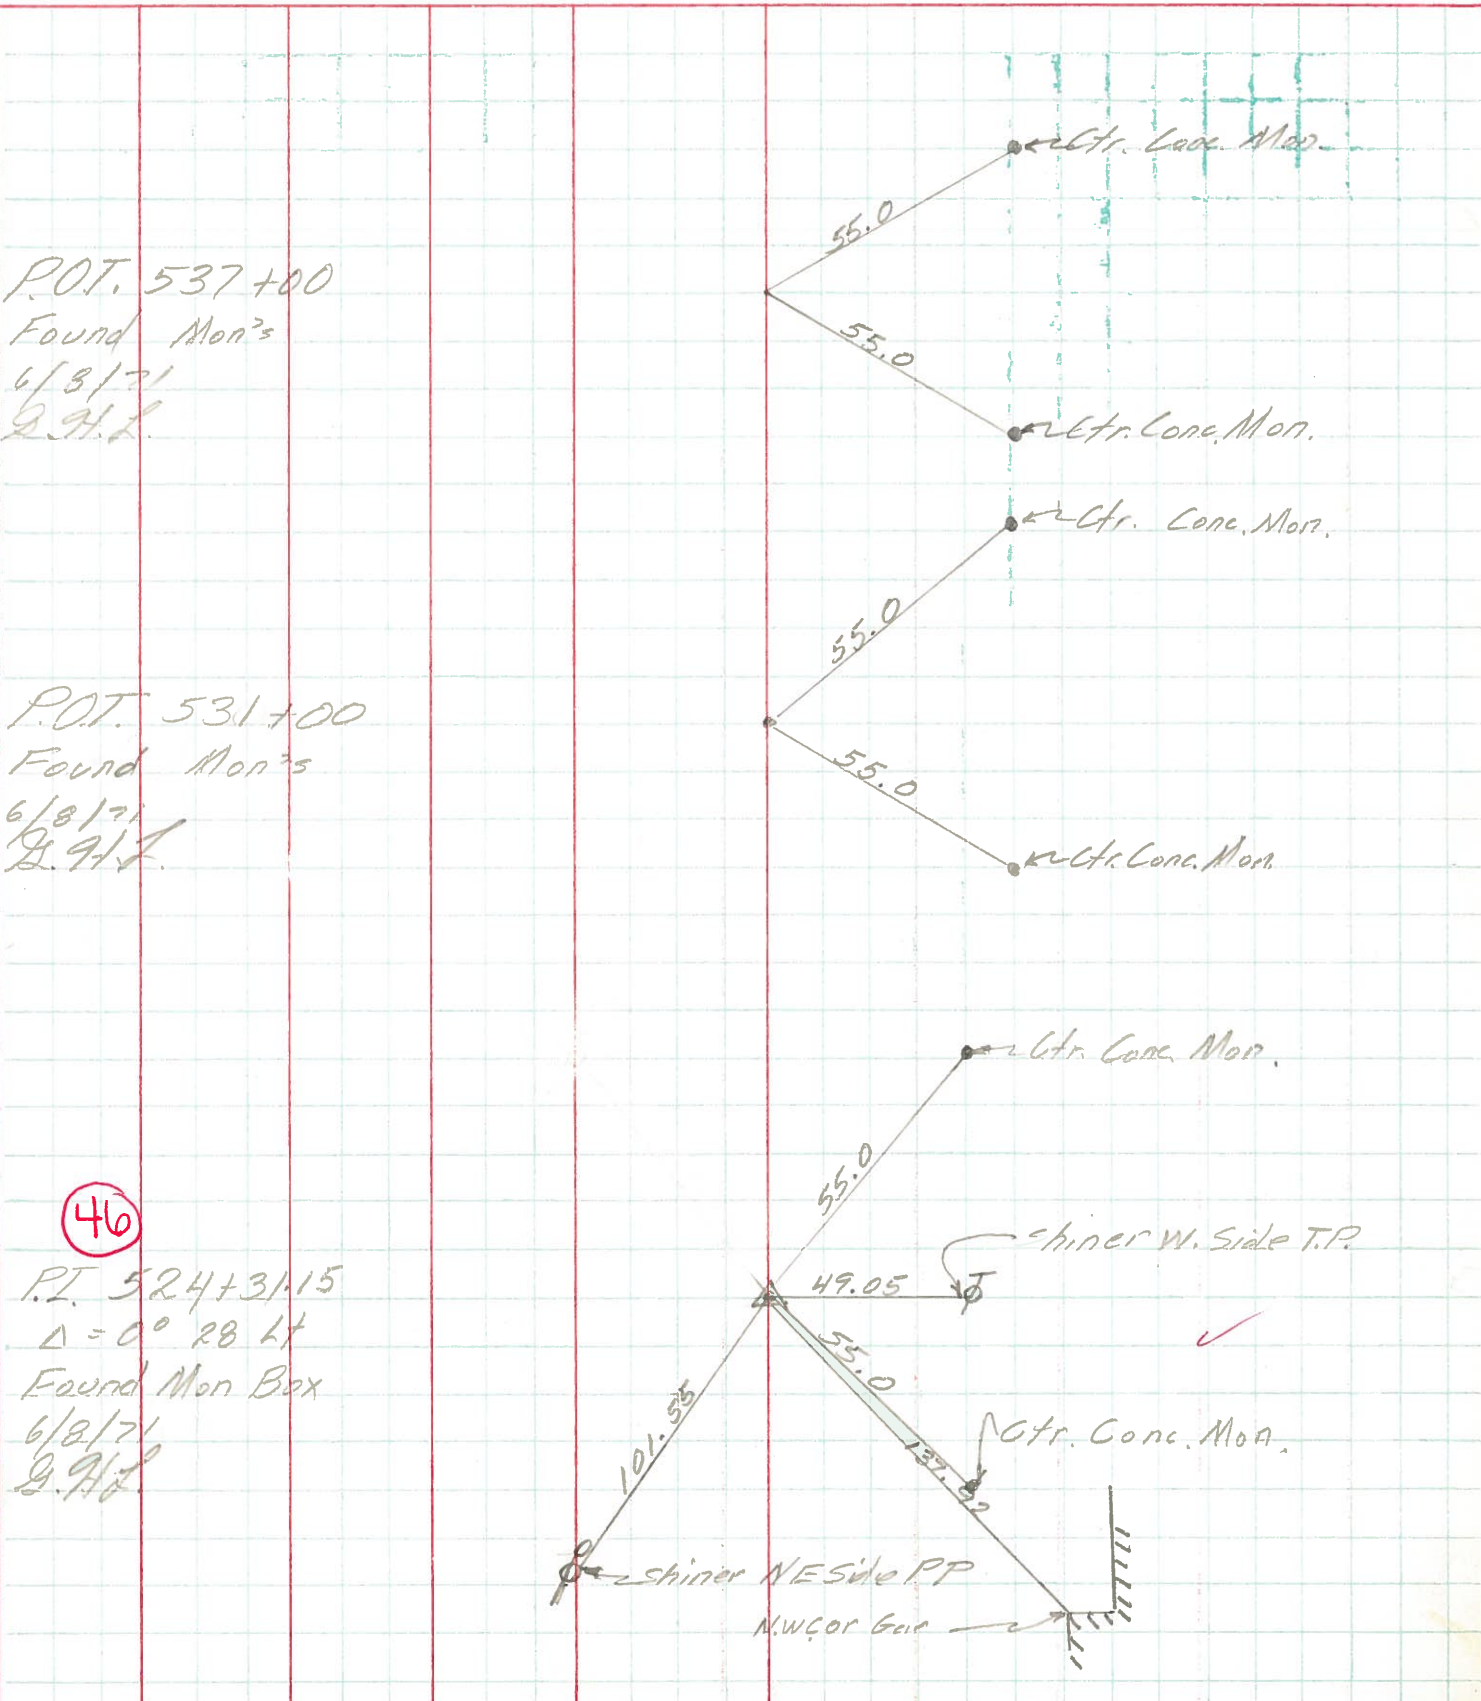

P.O.T. 537+00  
Found Mon's  
6/8/71  
G.H.L.

P.O.T. 531+00  
Found Mon's  
6/8/71  
G.H.L.

46

P.I. 524+31.15  
 $\Delta = 0^\circ$  28 Lt  
Found Mon Box  
6/8/71  
G.H.L.

Shiner NE Side PP  
N.W. Cor G.C.P.