

O.D.O.T. DISTRICT 2 SURVEY OFFICE (USE ONLY)

PERSONNEL

REFERENCE NO. 46

SHEET 32 OF 48

NOTES VAN DUSEN

DATE 8/17/92

ROUTE SR 108

H.C. KUSZ

WEATHER CLEAR

COUNTY HENRY

R.C. BARNHISEL

TEMP. 75°

TOWNSHIP FLATROCK

SECTION 13

DWG BY MILLER

PID 94319

T 4 N R 6 E

TYPE MONUMENT P.K./WASHER

ON SURFACE - ~~BELOW~~ ON

OFFSET \varnothing PAVEMENT ON LT : RT

12.9' TO RT EDGE PAVEMENT


STATION: 542+21.56

HORZ.DATUM: NAD83 (2011)


GEOID: 2012A

GRID: NORTHING: 602671.535

EASTING: 1524027.975

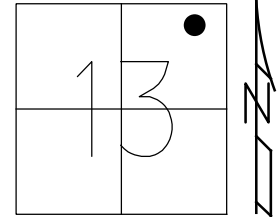

RECORD: P.I.
 STA 542+39.05
 $\Delta = 00^\circ 31' RT$
 FD P.K./WASHER
 8/17/92, MB
 SET P.K./WASHER
 9-17-92, MB
 FD LG.R.R.SPIKE
 2" BELOW
 REF45
 11-6-18, JLL
 SET MAG NAIL
 IN CONC. APPROACH
 10-22-20, DSA

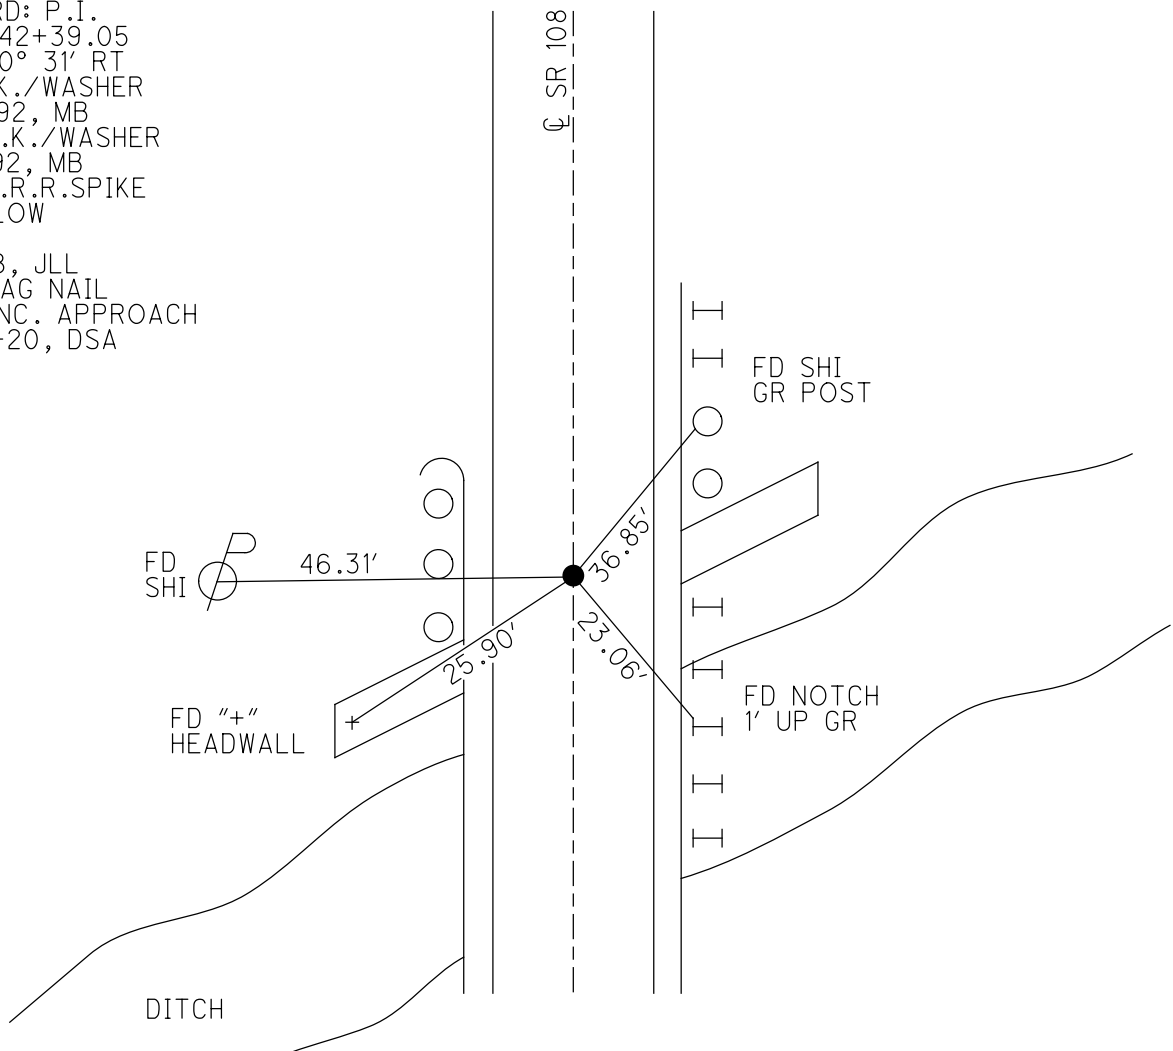

O.D.O.T. DISTRICT 2 SURVEY OFFICE

PERSONNEL

REFERENCE NO. 45

SHEET 49 OF 54

NOTES VAN DUSEN

H.C. KUSZ

R.C. BARN HISEL

DATE 17-AUG 92

WEATHER CLEAR

TEMP. 75°

ROUTE 108

COUNTY HENRY

TOWNSHIP FIATROCK

SECTION 13

T 4 N R 6 E


TYPE MONUMENT PK & WASHER

ON SURFACE - BELOW YES

LEFT - & PAV'T. - RIGHT YES

12.9 TO RT EDGE PAVEMENT


S.L.M. 541+02

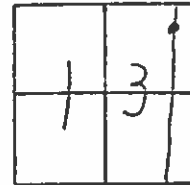

RECORDED
STA. 542+39.05
P.I.

SET PK & WASHER
9-17-92
MB

Ed Lg RR Spk & SURFACE
IN CONL SURFACE
ON & of 108

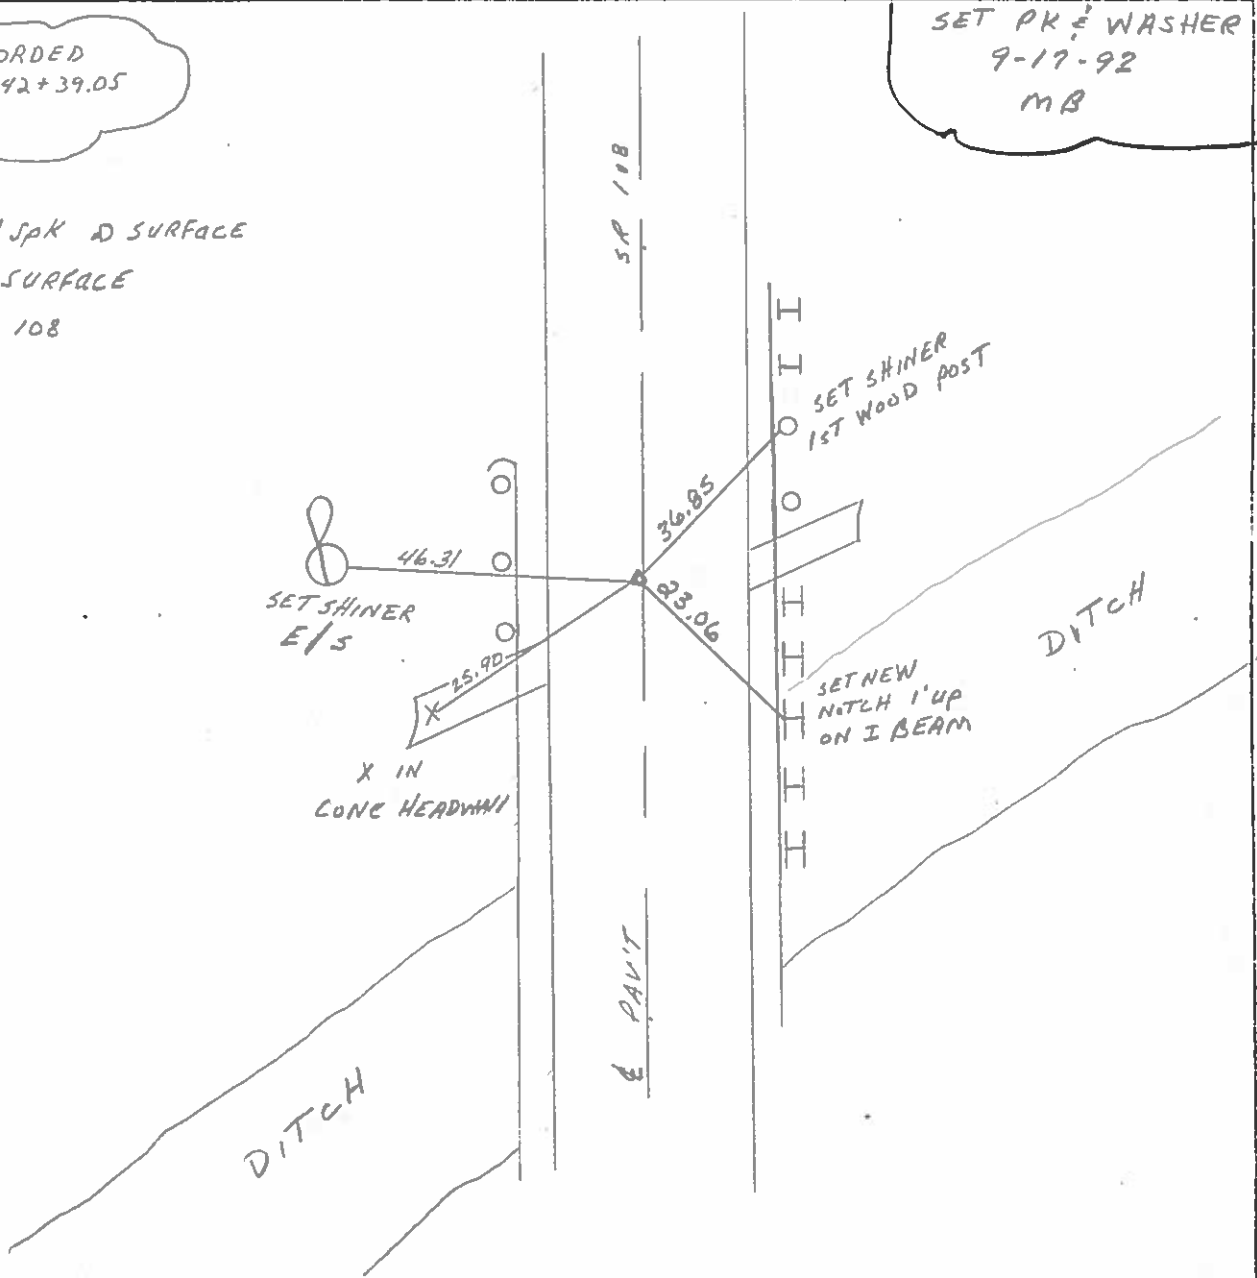

County Henry S.R. 108

Date 6-28-84

Township Flatrock

Weather Sunny

Section 13

Temp. +82°

T4N, R6E


Personnel Hoffman

Loehrke HC

Householder RC

Barnhisel Notes

#45

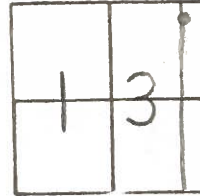

SLM 541+91

Mon Box

Fd lg RR/spk @ surface

in Conc Surface


on C of 108

12.0 H of EP

22.0 Rt to E edge of Bridge


2.5 N of N end of Indam

Recorded
Sta 542+39.05
P.I.

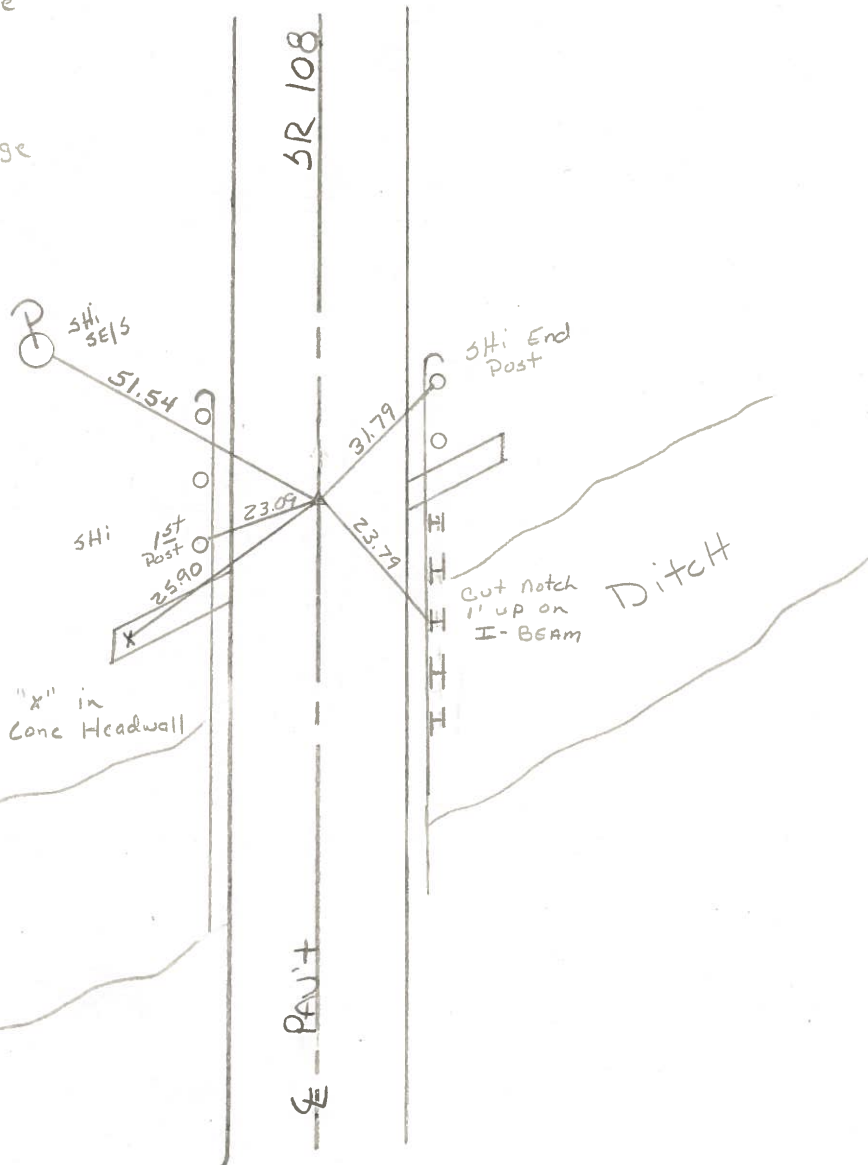

PERSONNEL	TITLE	PERSONNEL	TITLE	COUNTY	DATE
<u>Tomsic</u>				<u>HENRY</u>	<u>July-17-1974</u>
<u>Neuser</u>				S. R.	WEATHER
<u>VANYO</u>				<u>108</u>	
<u>Granata</u>				SEC. <u>FLATROCK TWP.</u>	TEMP.

DESCRIPTION _____ LEFT _____ CENTER LINE _____ RIGHT _____ JOB NO. _____

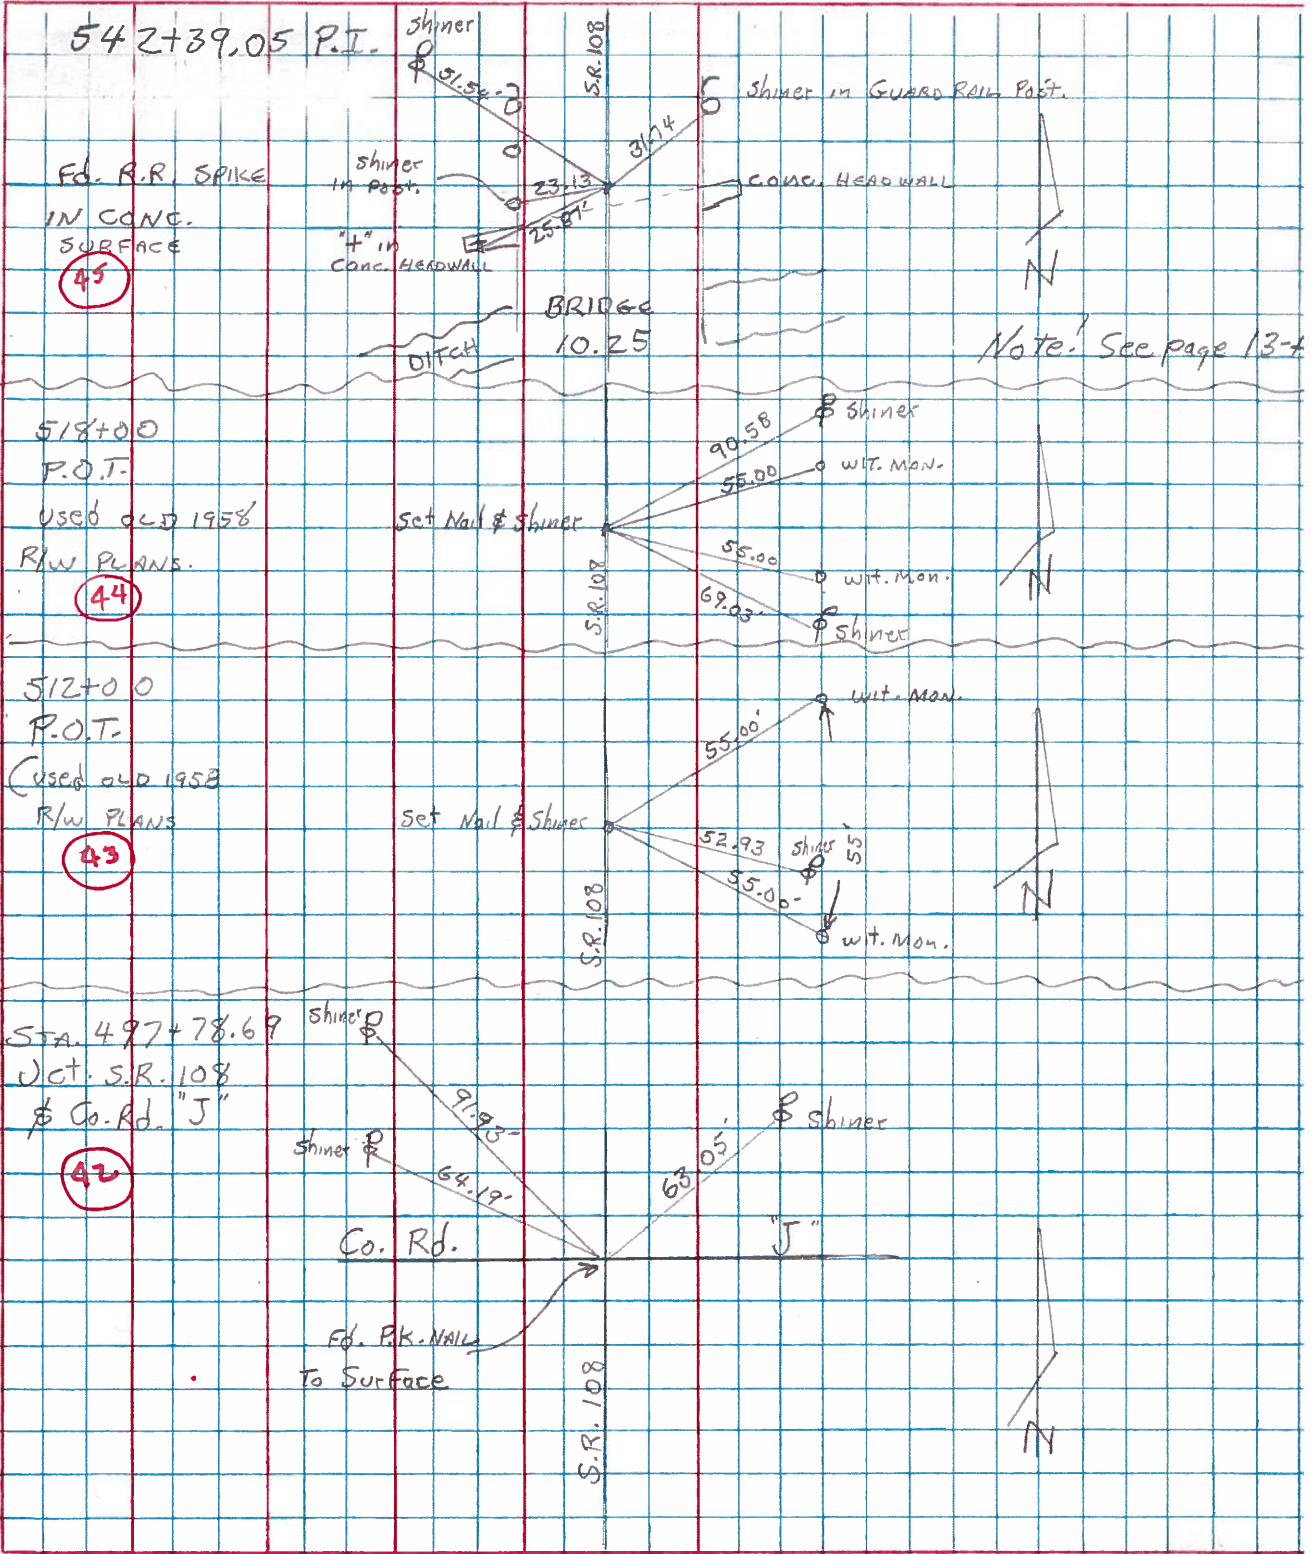

PERSONNEL TITLE PERSONNEL TITLE

Lovys
 Eriksen Recorder
 Pav
 Shaw

COUNTY Men DATE 6/8/71
 S. R. #108 WEATHER Cloud Windy
 SEC. Helgate to N. Coroll TEMP. 70°

DESCRIPTION Ref Const Plan Dated 1958 JOB NO.

