


O.D.O.T. DISTRICT 2 SURVEY OFFICE (USE ONLY)


PERSONNEL \_\_\_\_\_ REFERENCE NO. 47 SHEET 33 OF 48  
 NOTES BALBAUGH DATE 3/18/20 ROUTE SR 108  
 H.C. LEU WEATHER CLOUDY COUNTY HENRY  
 R.C. BALBAUGH TEMP. 34° TOWNSHIP FLATROCK  
 SECTION 13  
 DWG BY BALBAUGH PID 94319 T 4 N R 6 E

TYPE MONUMENT MONBOX W/ 3/4" IPIN  
 ON SURFACE - ~~BELOW~~ ON  
 OFFSET Q PAVEMENT ON LT : RT  
12' TO RT EDGE PAVEMENT  
 STATION: 550+48.75

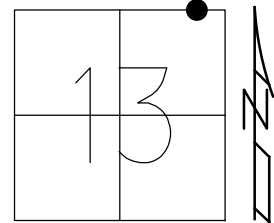

HORZ. DATUM: NAD83 (2011) GEOID: 2012A  
 GRID: NORTHING: 603498.707 EASTING: 1524022.918

RECORD: P.I.  
 STA 550+66.77  
 $\Delta = 00^\circ 13' \text{ LT}$   
 FD MONBOX  
 8/17/92, MB  
 FD MONBOX  
 W/ 1" IPIN  
 REF 47  
 11-6-18, JLL  
 FD MONBOX  
 W/ 1" IPIN  
 NEWREF 47  
 10-22-20, DSA

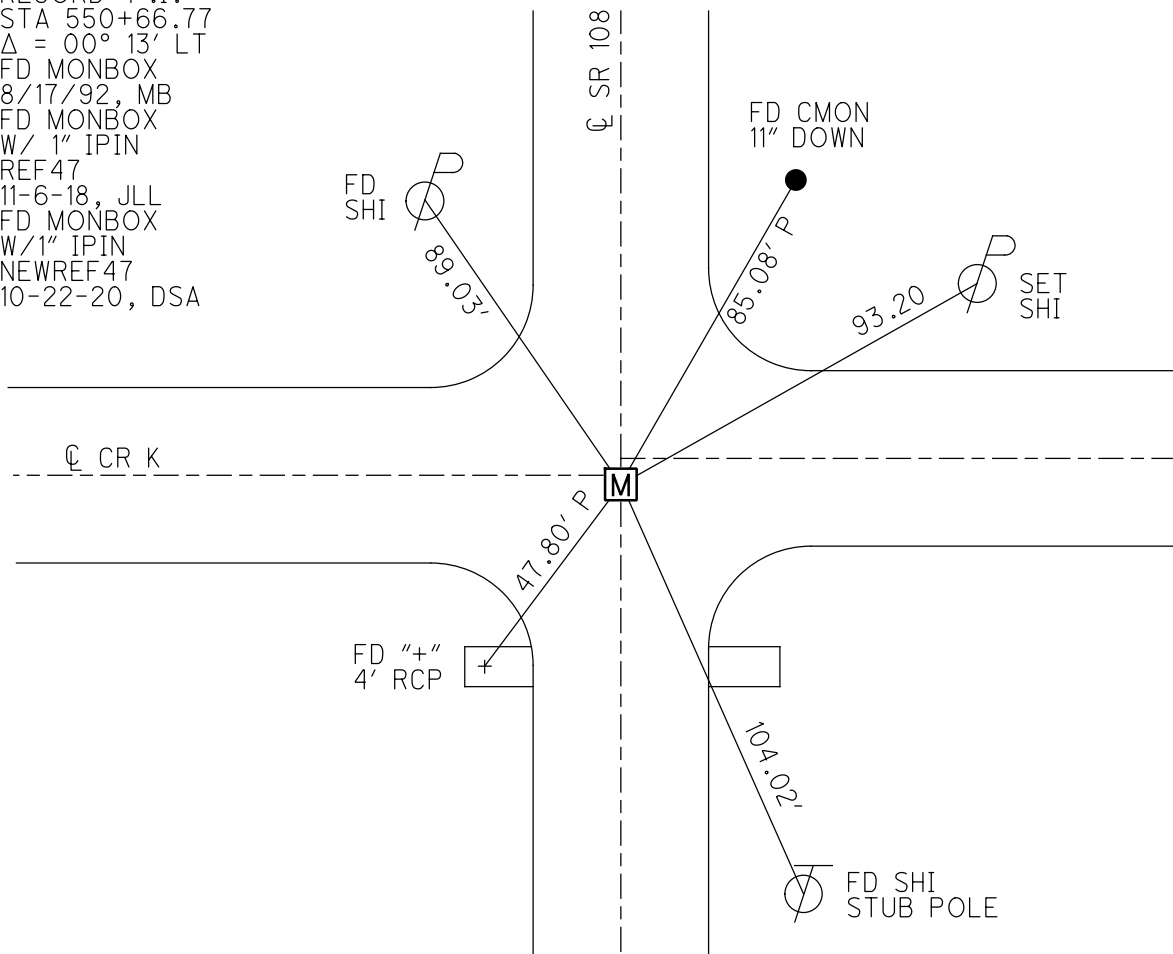

# O.D.O.T. DISTRICT 2 SURVEY OFFICE

PERSONNEL

REFERENCE NO. 47

SHEET 51 OF 54

NOTES VAN DUSEN

H.C. KUSZ

R.C. BARNHISEL

DATE 17 AUG 92

WEATHER CLEAR

TEMP. 75°

ROUTE 108

COUNTY HENRY

TOWNSHIP FLATROCK

SECTION 13

T 4 N R 6 E



TYPE MONUMENT MON BOX

ON SURFACE - BELOW YES

LEFT- & PAV'T. - RIGHT YES

12' TO RT. EDGE PAVEMENT

S.L.M. 549+29

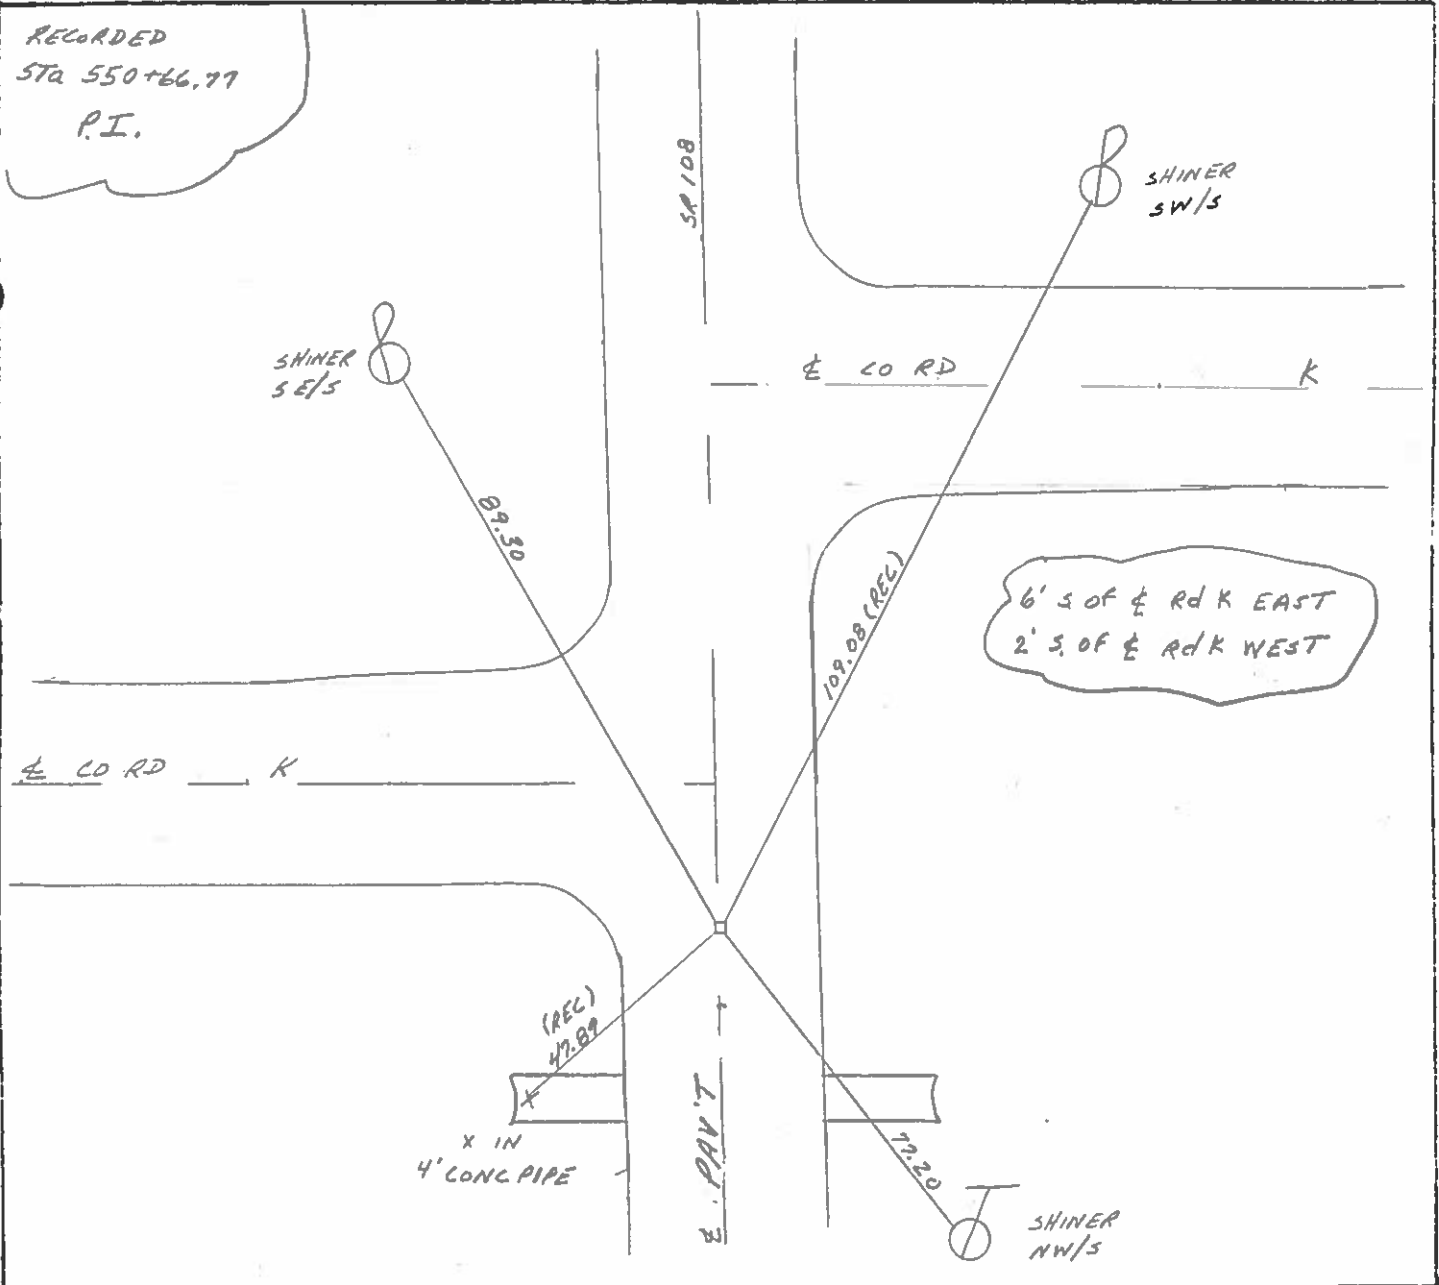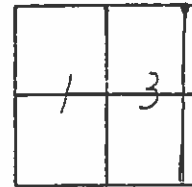

County Henry S.R. 108

Township Flatrock

Section 13

T4N, R6E

Personnel Hoffman

Loehrke HC

Householder RC


Barnhisel Motos

# 47

Date 6-28-84


Weather Sunny

Temp. +82°

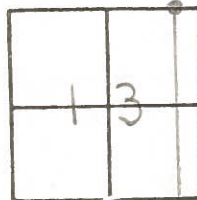

SLM 550+19 Man. Box  
 Fd PK @ Surface  
 on E of 108  
 12.0 Rt of EP  
 11.9 Lt of EP  
 6' S of E Rd "K" East  
 2' S of E Rd "K" West

Recorded  
 Sta. 550+66.77  
 P.I.

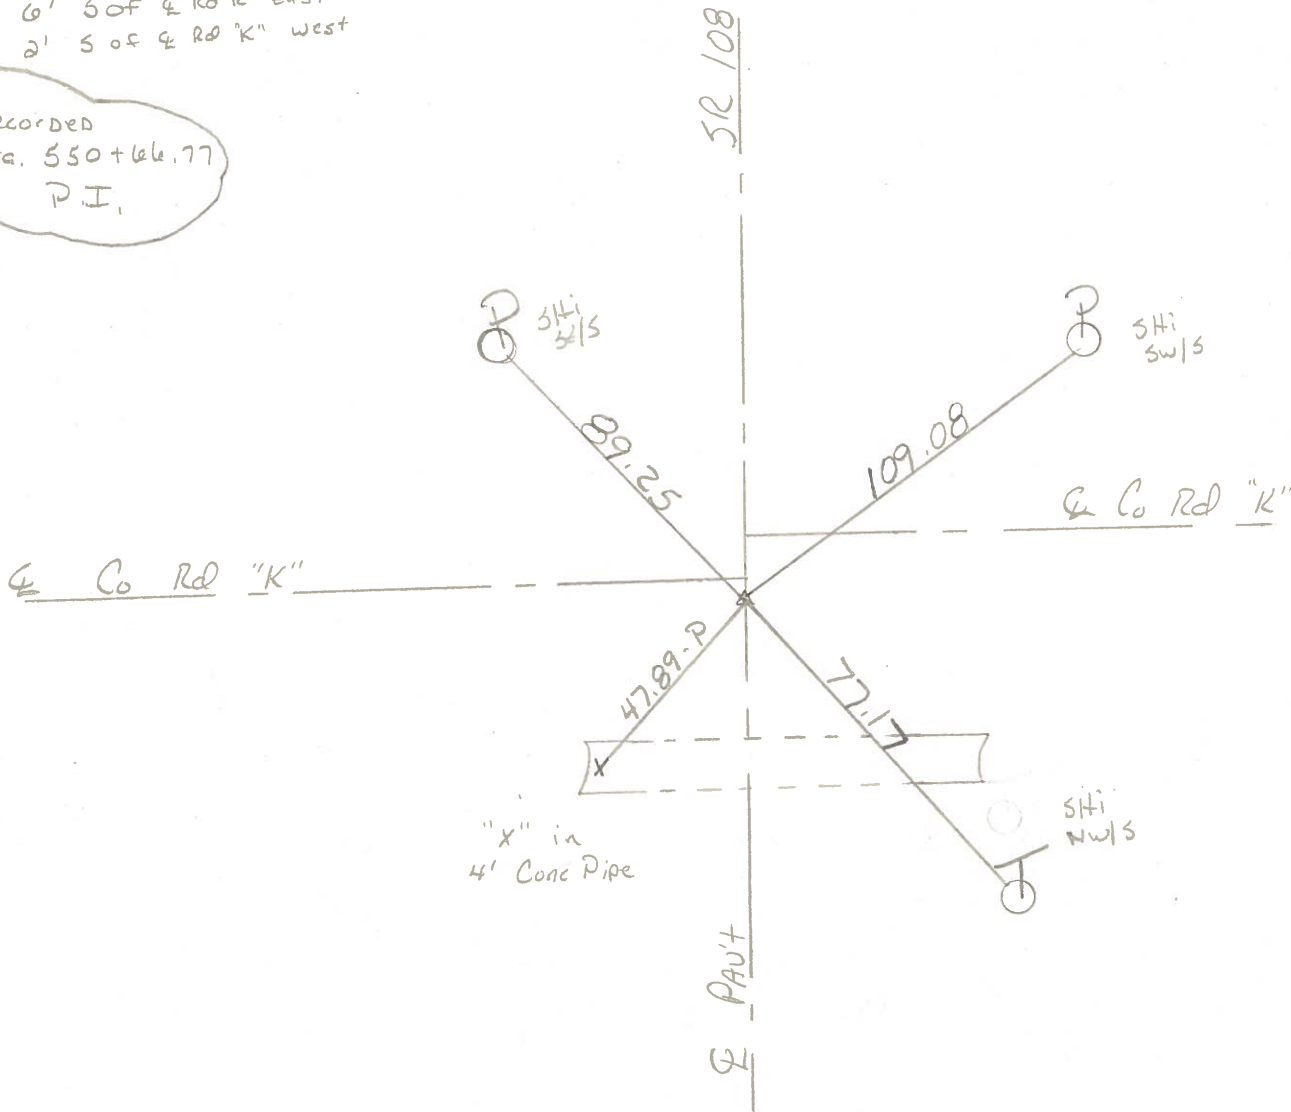


PERSONNEL	TITLE	PERSONNEL	TITLE
Tomsic			
Neuser			
Vango			
Granata			

COUNTY Henry DATE July-11-74

S. R. 108 WEATHER

SEC. Flatrock Twp. TEMP.

DESCRIPTION LEFT CENTER LINE RIGHT JOB NO.

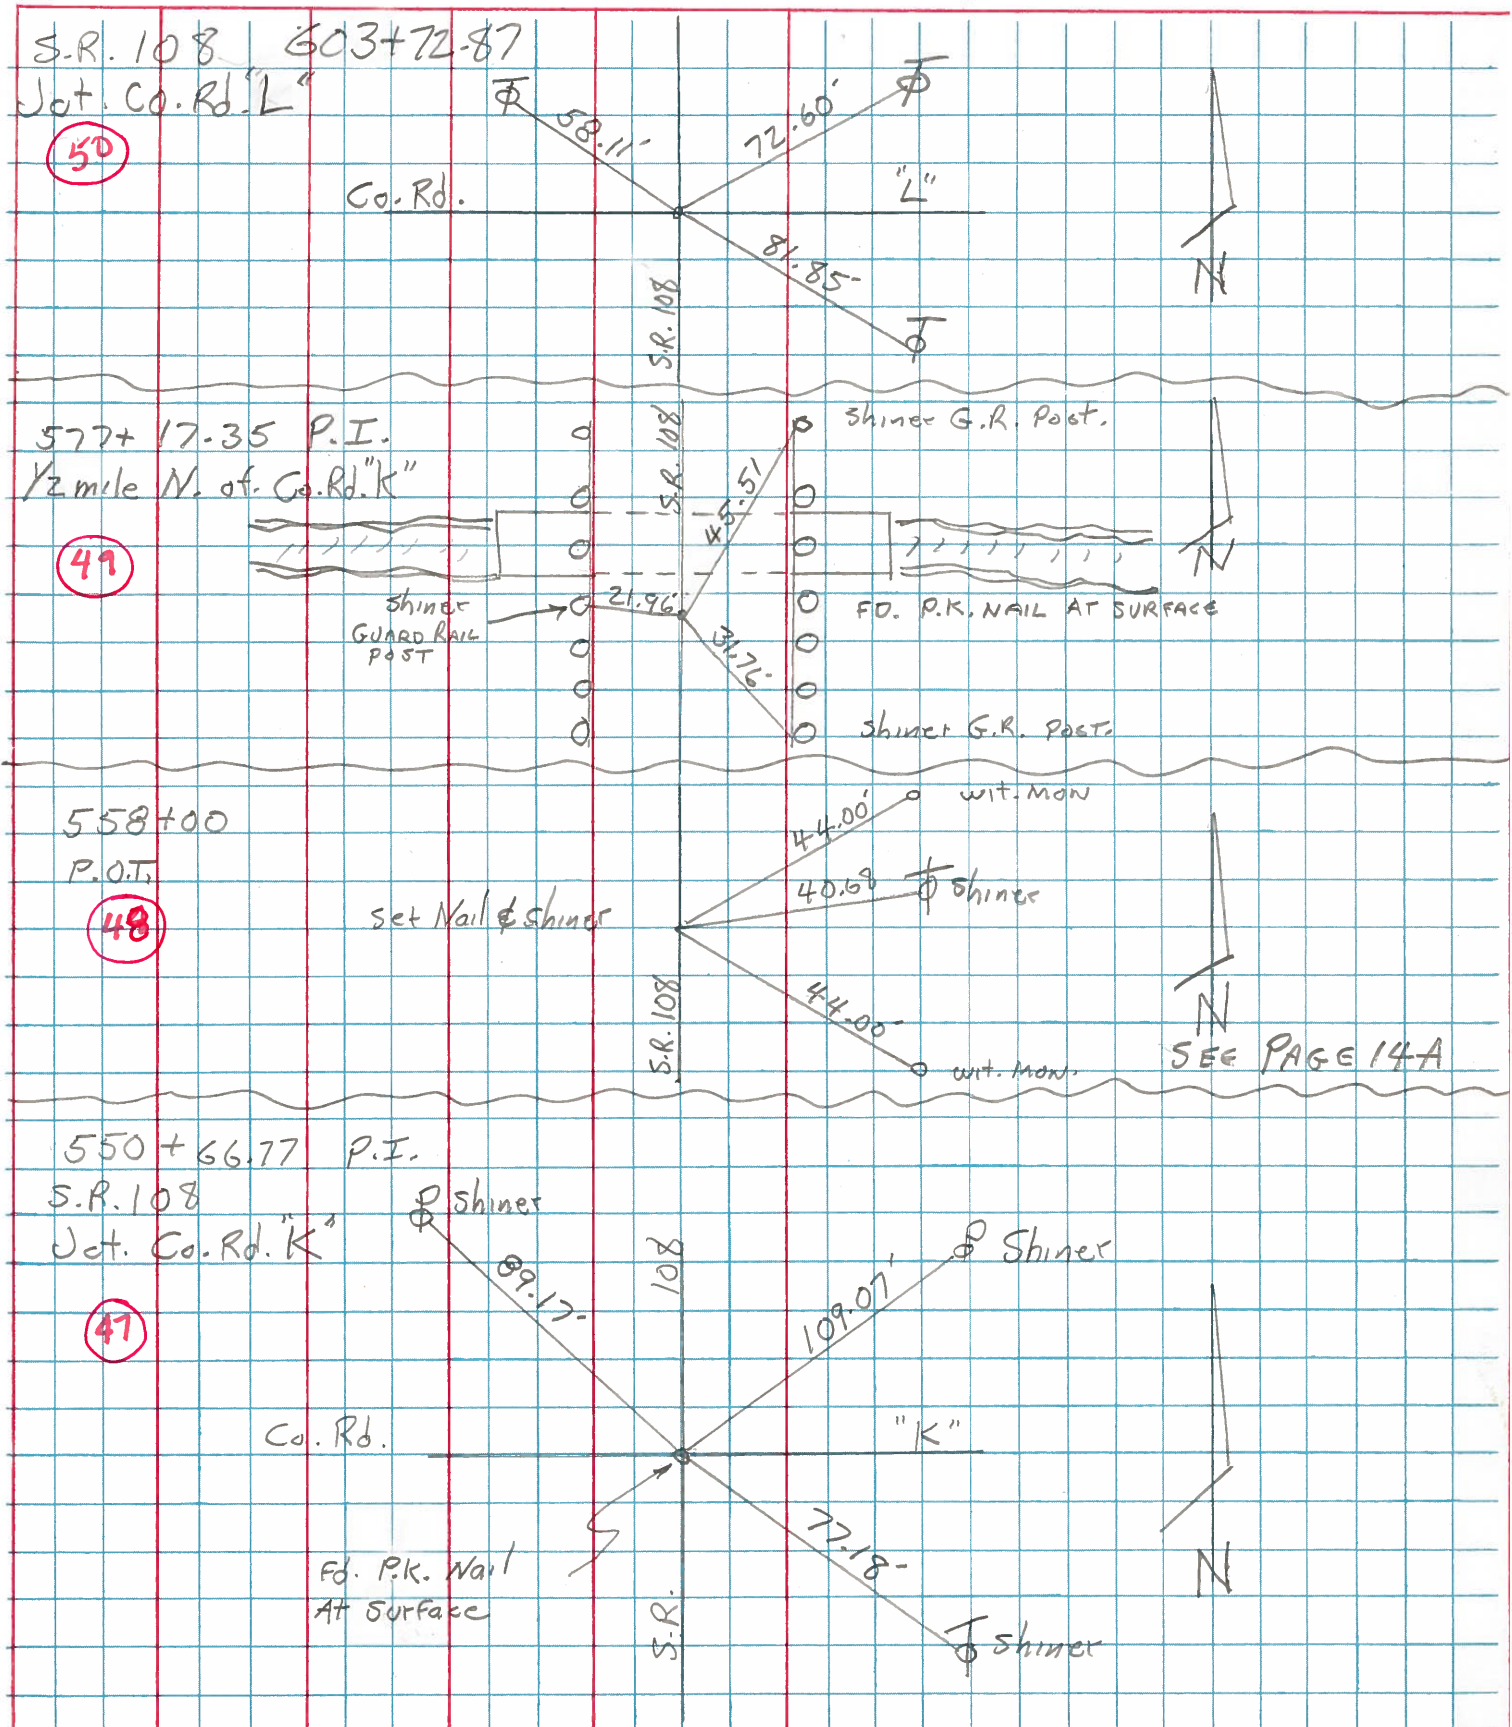

PERSONNEL TITLE PERSONNEL TITLE COUNTY Men DATE 6/8/71  
Louis Recorder S. R. #108 WEATHER Cloud Wind  
Eriksen Law SEC. Helgate to N. Gore Rd. TEMP. 70°  
Shaw DESCRIPTION Ref Const Plan Dated 1958 JOB NO. \_\_\_\_\_

