


O.D.O.T. DISTRICT 2 SURVEY OFFICE (USE ONLY)


PERSONNEL _____ REFERENCE NO. 48 SHEET 34 OF 48
NOTES VAN DUSEN DATE 8/14/92 ROUTE SR 108
H.C. McCORMICK WEATHER CLEAR COUNTY HENRY
R.C. KUSZ TEMP. 75° TOWNSHIP FLATROCK
BARNHESEL SECTION 12
DWG BY MILLER PID 94319 T 4 N R 6 E

TYPE MONUMENT P.K./WASHER
ON SURFACE - ~~BELOW~~ ON
OFFSET \varnothing PAVEMENT 0.5' LT : ~~RT~~
12.3' TO LT EDGE PAVEMENT
STATION: 557+80

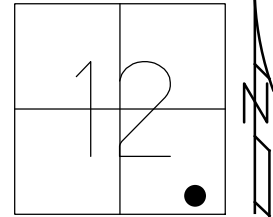

HORZ.DATUM: _____ GEOID: _____
GRID: NORTHING: _____ EASTING: _____

RECORD: P.O.T.
STA 558+00
FD P.K./WASHER
8/14/92, BVD
SET P.K./WASHER
9-17-92, MB
DNF
11-6-18, JLL
DID NOT SET
10-22-20, DSA

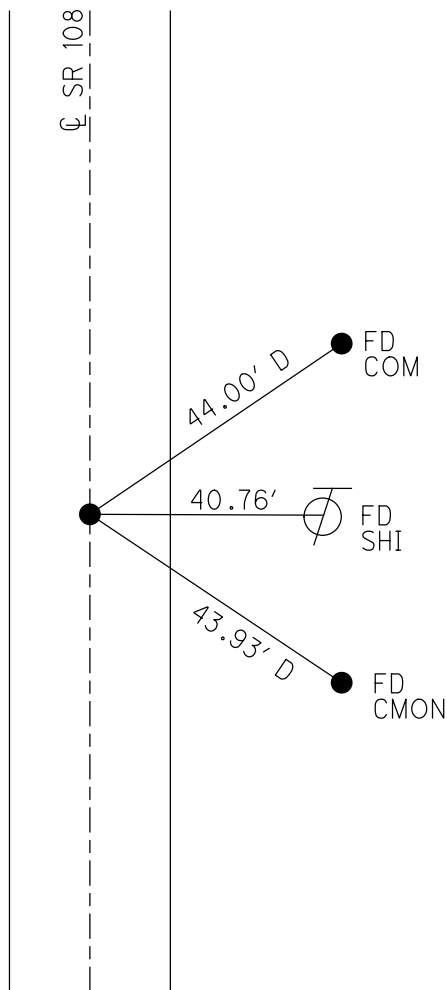

O.D.O.T. DISTRICT 2 SURVEY OFFICE

PERSONNEL

REFERENCE NO. 48

SHEET 52 OF 54

NOTES VAN DUSEN

H.C. McCORMICK

R.C. KUSZ

BARNHISEL

DATE 14 AUG 92

WEATHER CLEAR

TEMP. +75° F

ROUTE 108

COUNTY HENRY

TOWNSHIP Flatrock

SECTION 12

T 4 N R 6 E


TYPE MONUMENT PK & WASHER

ON SURFACE - BELOW YES

LEFT - & PAV'T. - RIGHT 0.5

12.3 TO LT EDGE PAVEMENT

S.L.M. 556+61

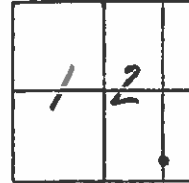


RECORDED
STA 558+00
P.O.T.

SET PK & WASHER
9-17-92
MB

SR 108

& PAV'T

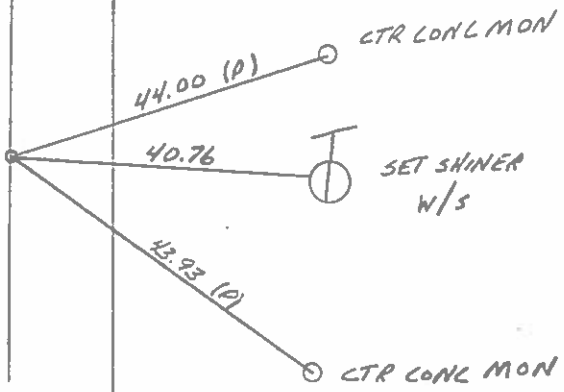

County Henry S.R. 108

Township Flatrock

Section 12

T4N, R6E

Personnel Hoffman

Loehrke HC


Householder RC

Barnhisel Notes

Date 6-28-84

Weather Sunny

Temp. +82°

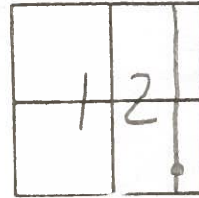


48

SLM 557+31
Fd nail @ surface
on C 05 108

8-28-84
SET PK WASHER
M.P.B


RECORDED
sta 558+00
P.O.T.

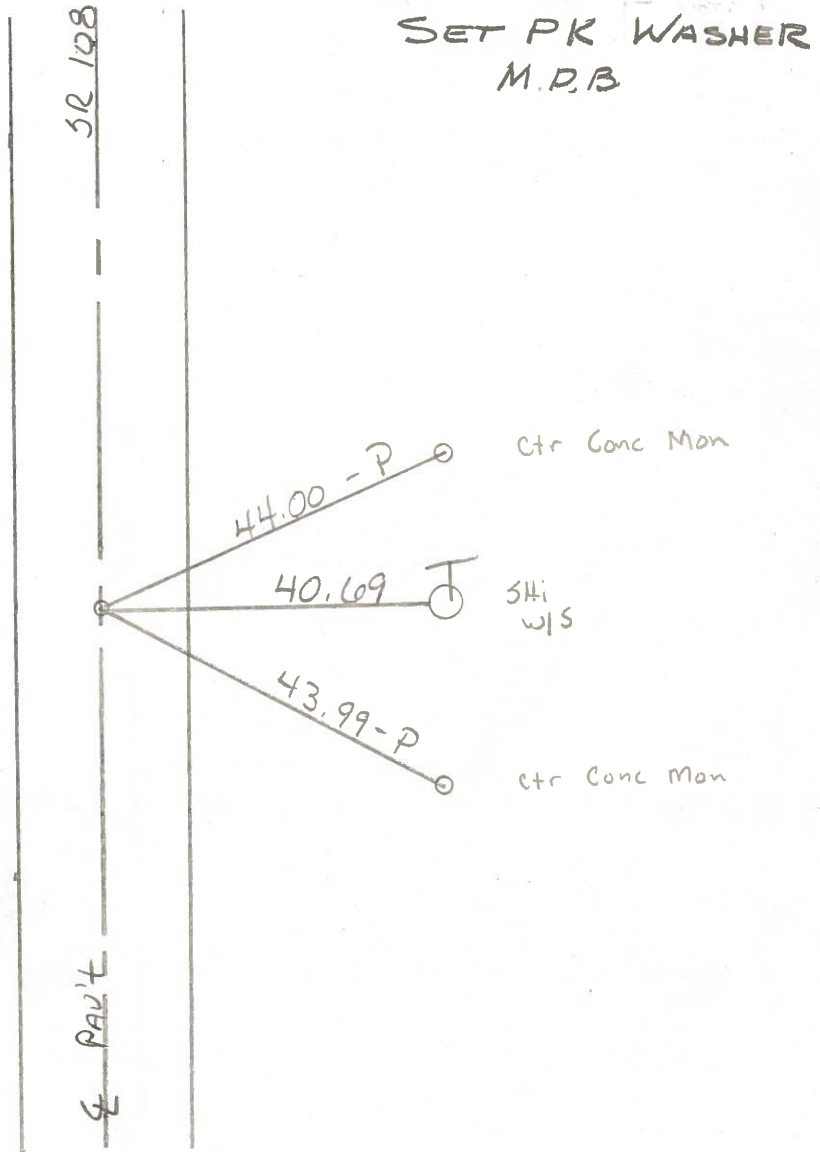

PERSONNEL	TITLE	PERSONNEL	TITLE
Tomsic			
Neuser			
Vanyo			
Granata			


COUNTY HENRY DATE July 29, 1974
 S. R. 108 WEATHER _____
 SEC. Flatrock Twp TEMP. _____

DESCRIPTION _____ LEFT _____ CENTER LINE _____ RIGHT _____ JOB NO. _____

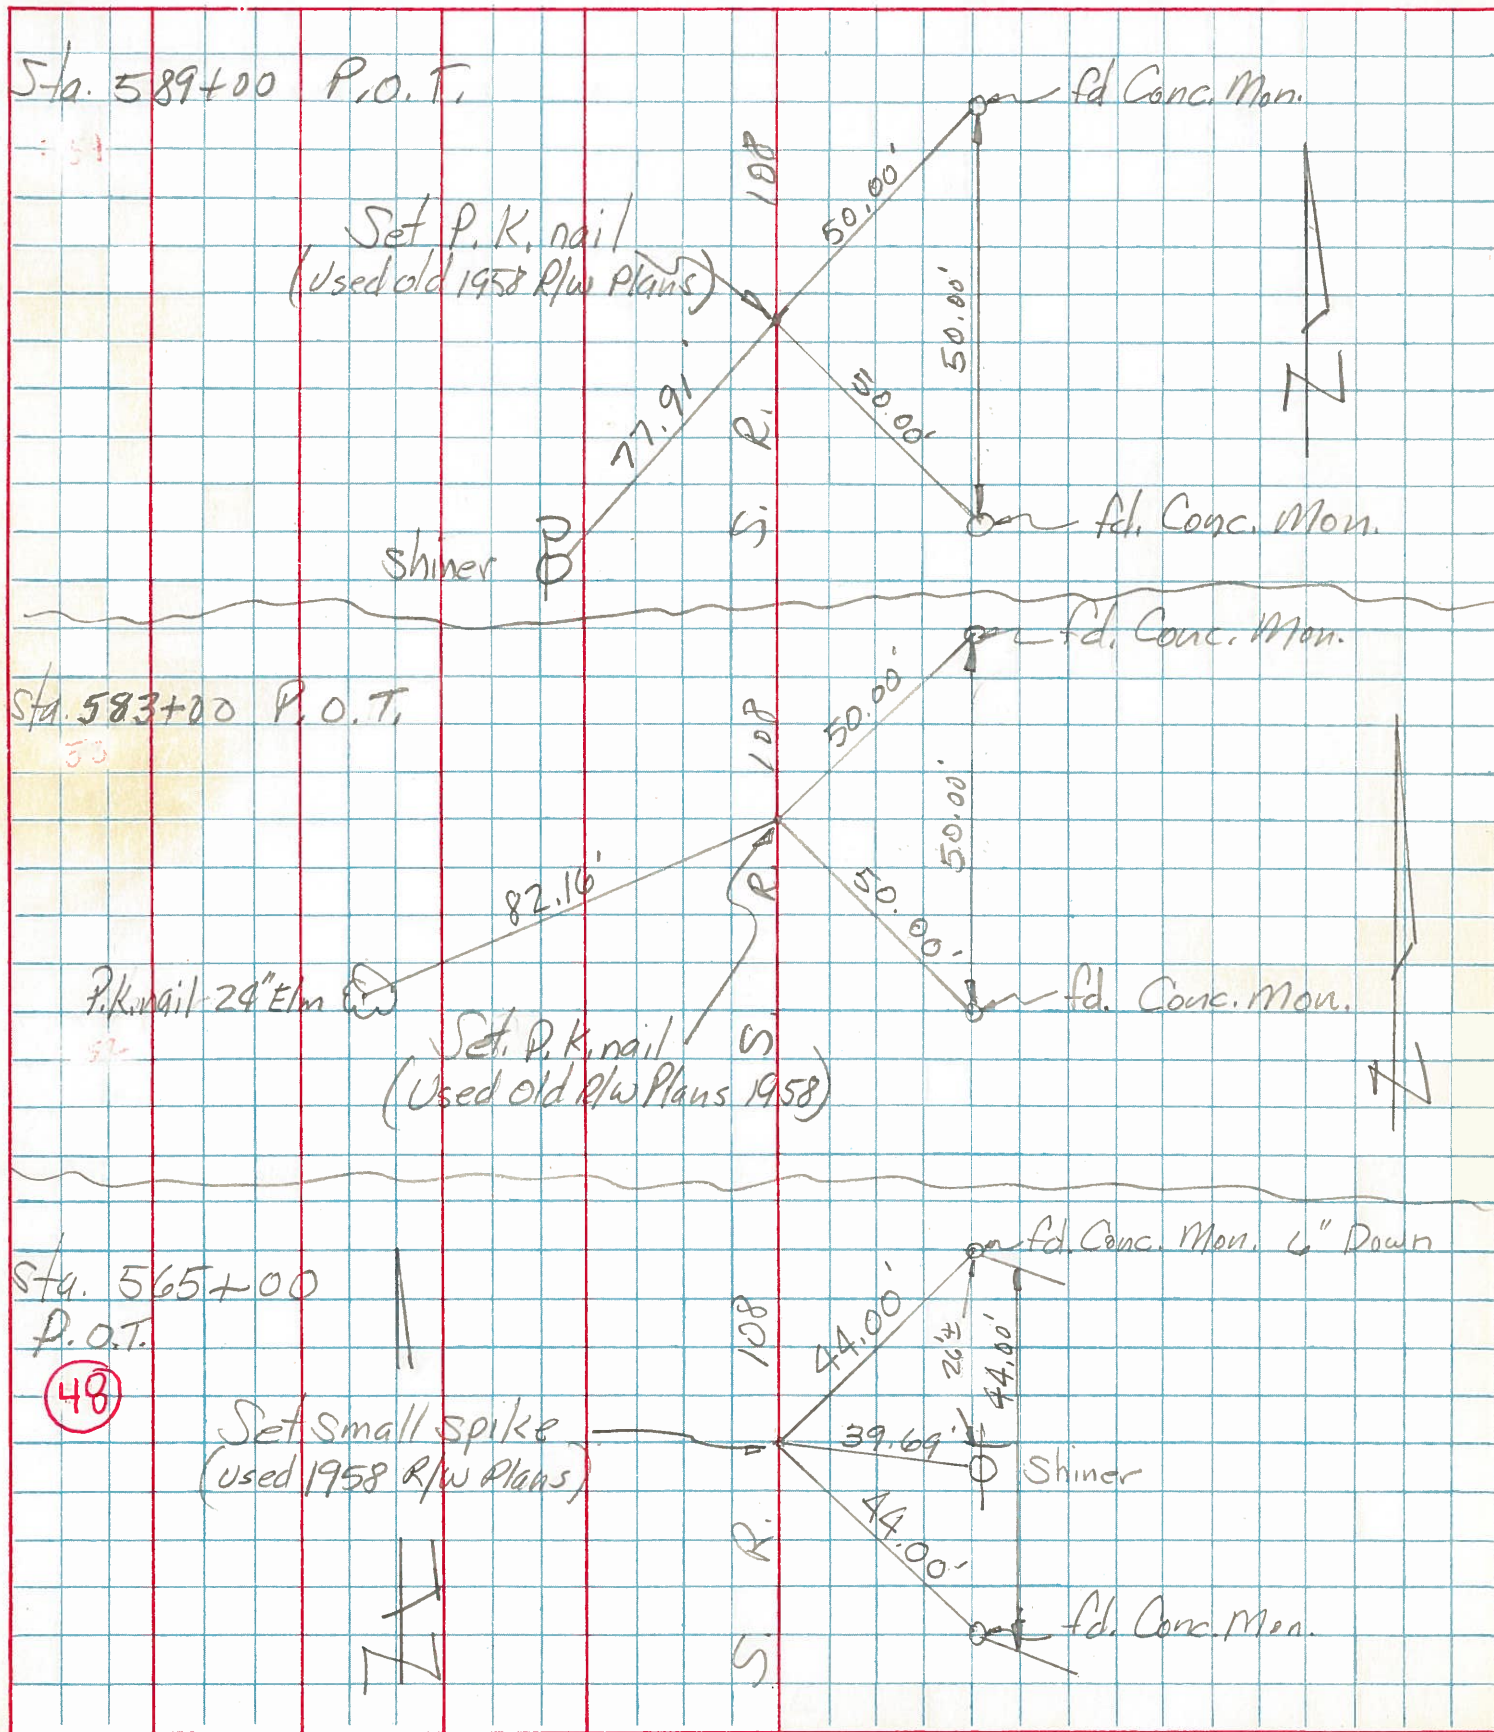

PERSONNEL TITLE PERSONNEL TITLE COUNTY Henry DATE July-11-74
 Tomsic _____
 Neuser _____
 Vango _____
 Granata _____
 S. R. 108 WEATHER _____
 SEC Flatrock Twp. TEMP _____

DESCRIPTION LEFT CENTER LINE RIGHT JOB NO.

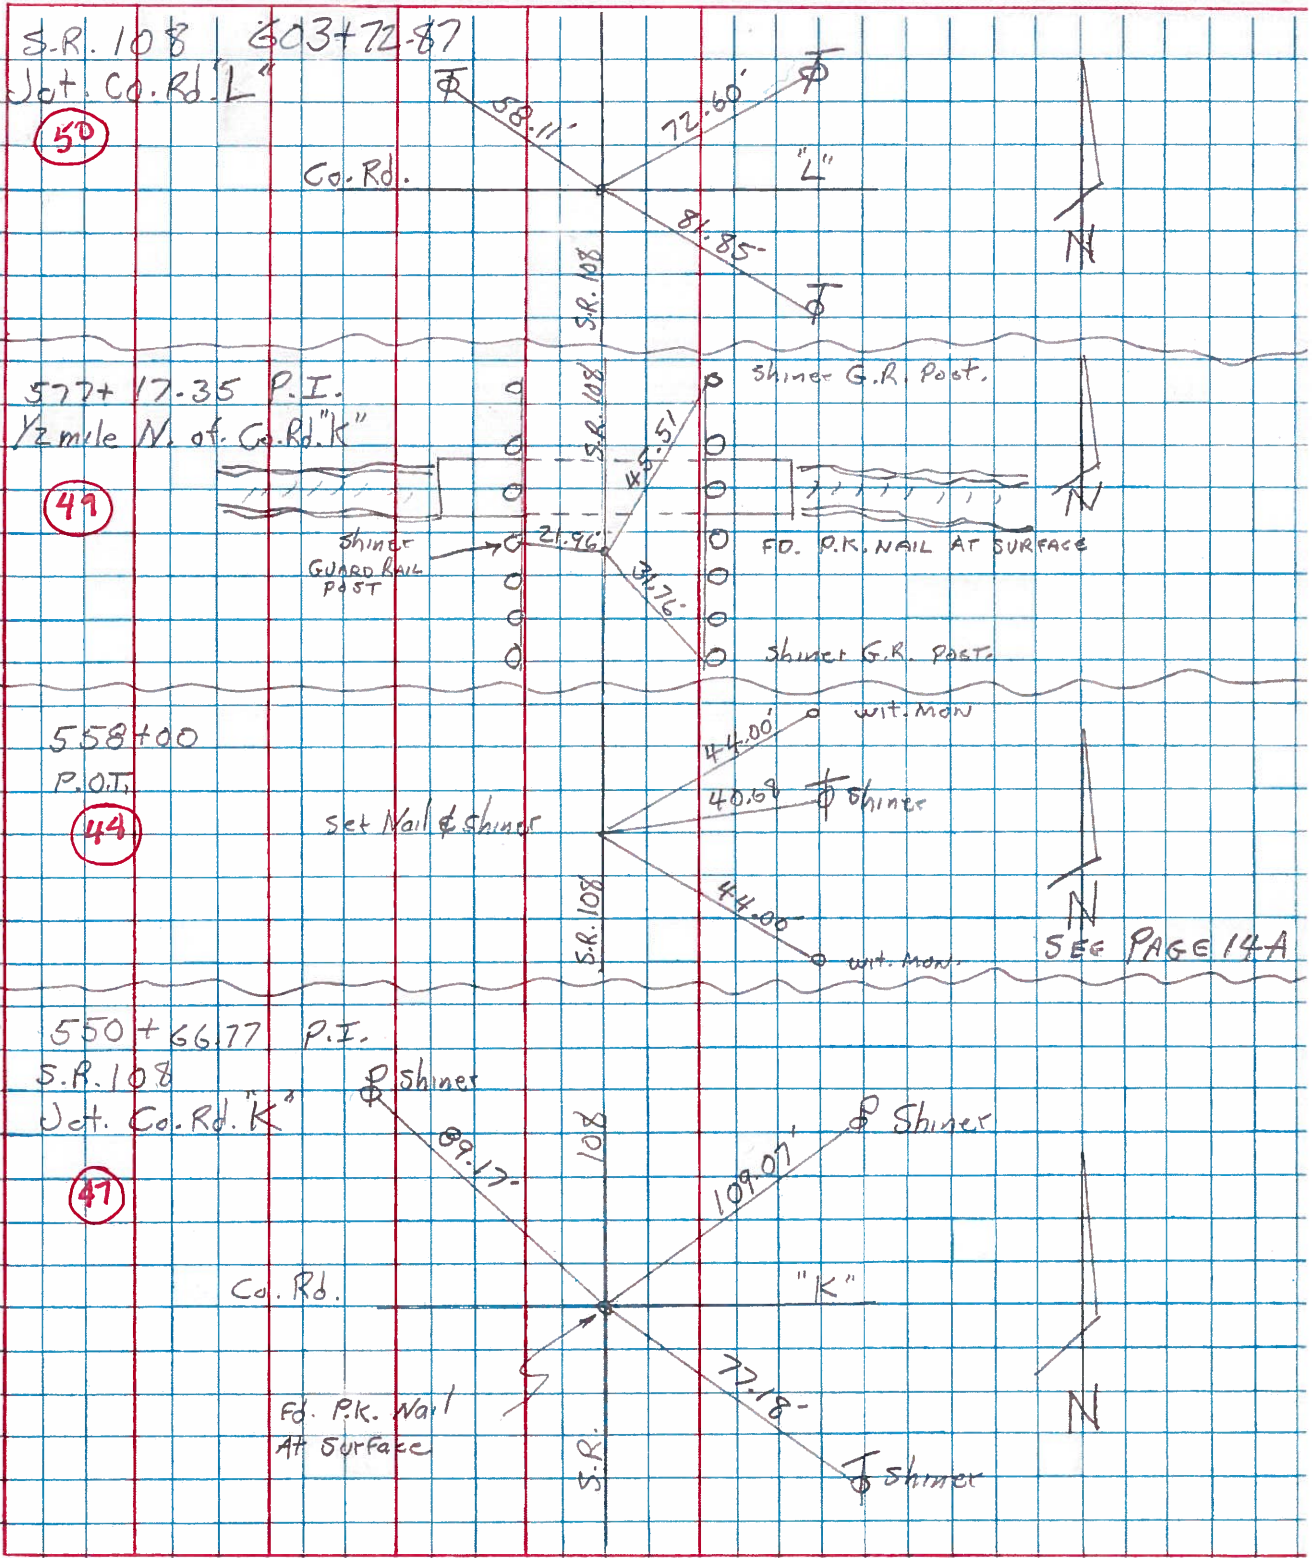

PERSONNEL TITLE PERSONNEL TITLE

Louys

COUNTY Men

DATE 6/8/71

Erksen Recorder

S. R. #108

WEATHER Cloud Wind

Kov

SEC. Helgate to N. Coroll

TEMP. 70°

Shaw

DESCRIPTION Ref Const Plan Dated 1958

JOB NO.

LEFT

CENTER LINE

RIGHT


48

POT. 558+100

Found Mon's

6/9/71

9/9/71

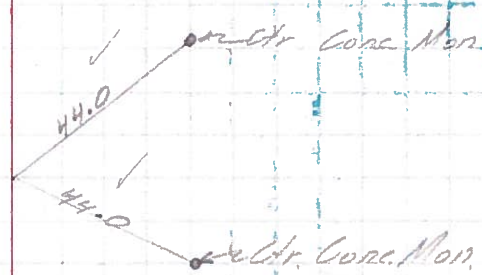

47


PI. 550+66.77 Co., Rd., K.

$\Delta = 0^\circ 13' \text{LT}$

Found Mon Box

6/8/71

9/9/71

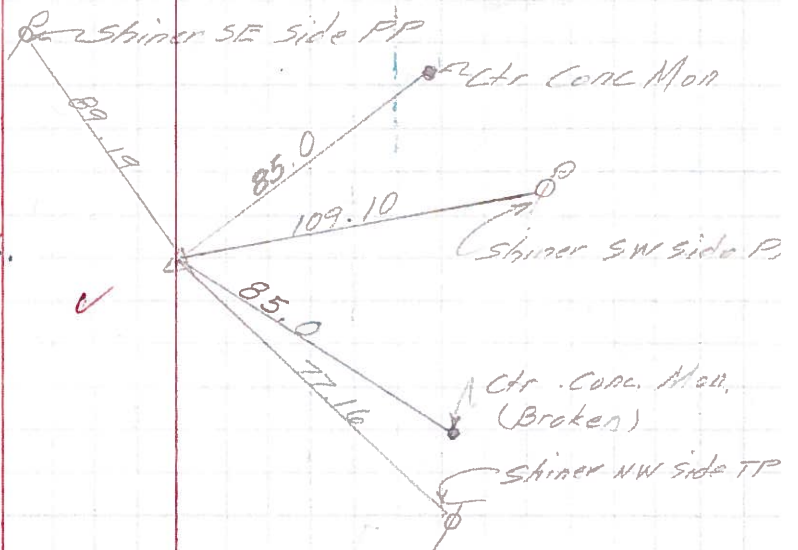

45

PI 542+39.05

$\Delta = 0^\circ 31' \text{RT}$

Found Iron Pile in Conc. Bridge App.

6/8/71

9/9/71

Shiner E side PP

