



O.D.O.T. DISTRICT 2 SURVEY OFFICE (USE ONLY)

PERSONNEL _____ REFERENCE NO. 51 SHEET 37 OF 48
 NOTES BALBAUGH DATE 3/12/20 ROUTE SR 108
 H.C. LEU WEATHER OVERCAST COUNTY HENRY
 R.C. BALBAUGH TEMP. 42° TOWNSHIP FLATROCK
 DWG BY GARRETT PID 94319 SECTION 1
 T 4 N R 6 E

TYPE MONUMENT SM.R.R.SPIKE
~~ON SURFACE~~ - BELOW 5"
 OFFSET \odot PAVEMENT ON _____ LT : RT
12.4' TO RT EDGE PAVEMENT
 STATION: 630+13.48
 HORZ.DATUM: NAD83 (2011) GEOID: 2012A
 GRID: NORTHING: 611462.963 EASTING: 1523938.035

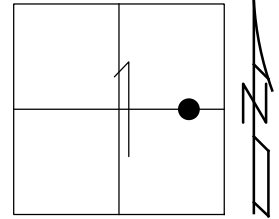

RECORD:
 STA 630+34.14
 $\Delta = 0^\circ 07' \text{ LT}$
 FD SM.R.R.SPIKE
 8/9/01, MB
 SET PK/WASHER
 11-13-01, MC
 FD LG.R.R.SPIKE
 5" DOWN
 REF51
 11-7-18, JLL
 SET MAG/WASHER
 10-22-20, DSA

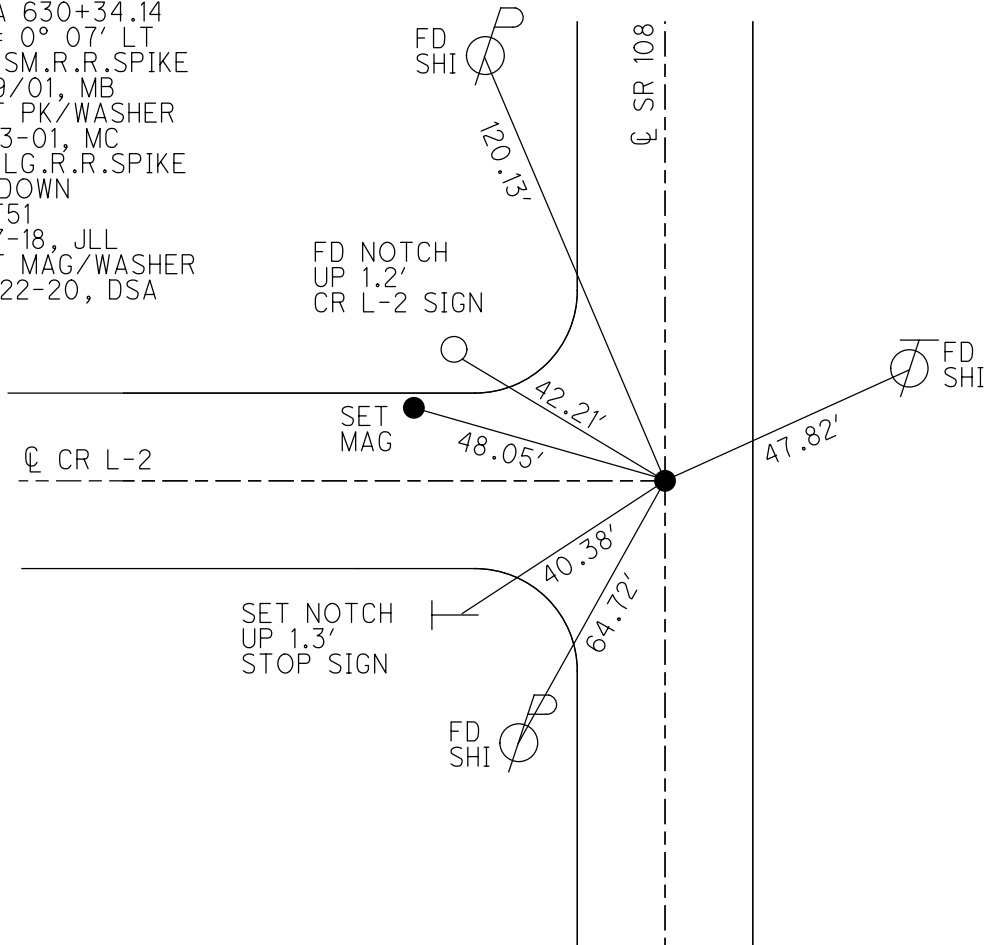

O.D.O.T. DISTRICT 2 SURVEY OFFICE

PERSONNEL

REFERENCE NO. 51

SHEET 2 OF 9

NOTES CANTERBURY

H.C. BARNHISEL

DATE 8-9-01

ROUTE 108

R.C. MOSEK

WEATHER OVERCAST

COUNTY HENRY

DRAWN BY: MOSER

TEMP. +85° F

TOWNSHIP FLATROCK

SECTION 1

T4 N R 6 E

TYPE MONUMENT Sm. RR SPIKE


ON SURFACE - ~~BELOW~~ ON

~~LEFT - C&P~~ PAV'T. - RIGHT 0.5' RT.


12.4' TO RT. EDGE PAVEMENT

S.L.M. 629+04

RESET P.K / WASHER
 11/13/01
 M.R.C.

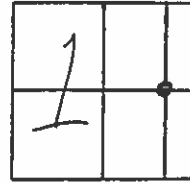

RECORD:
630+34.14

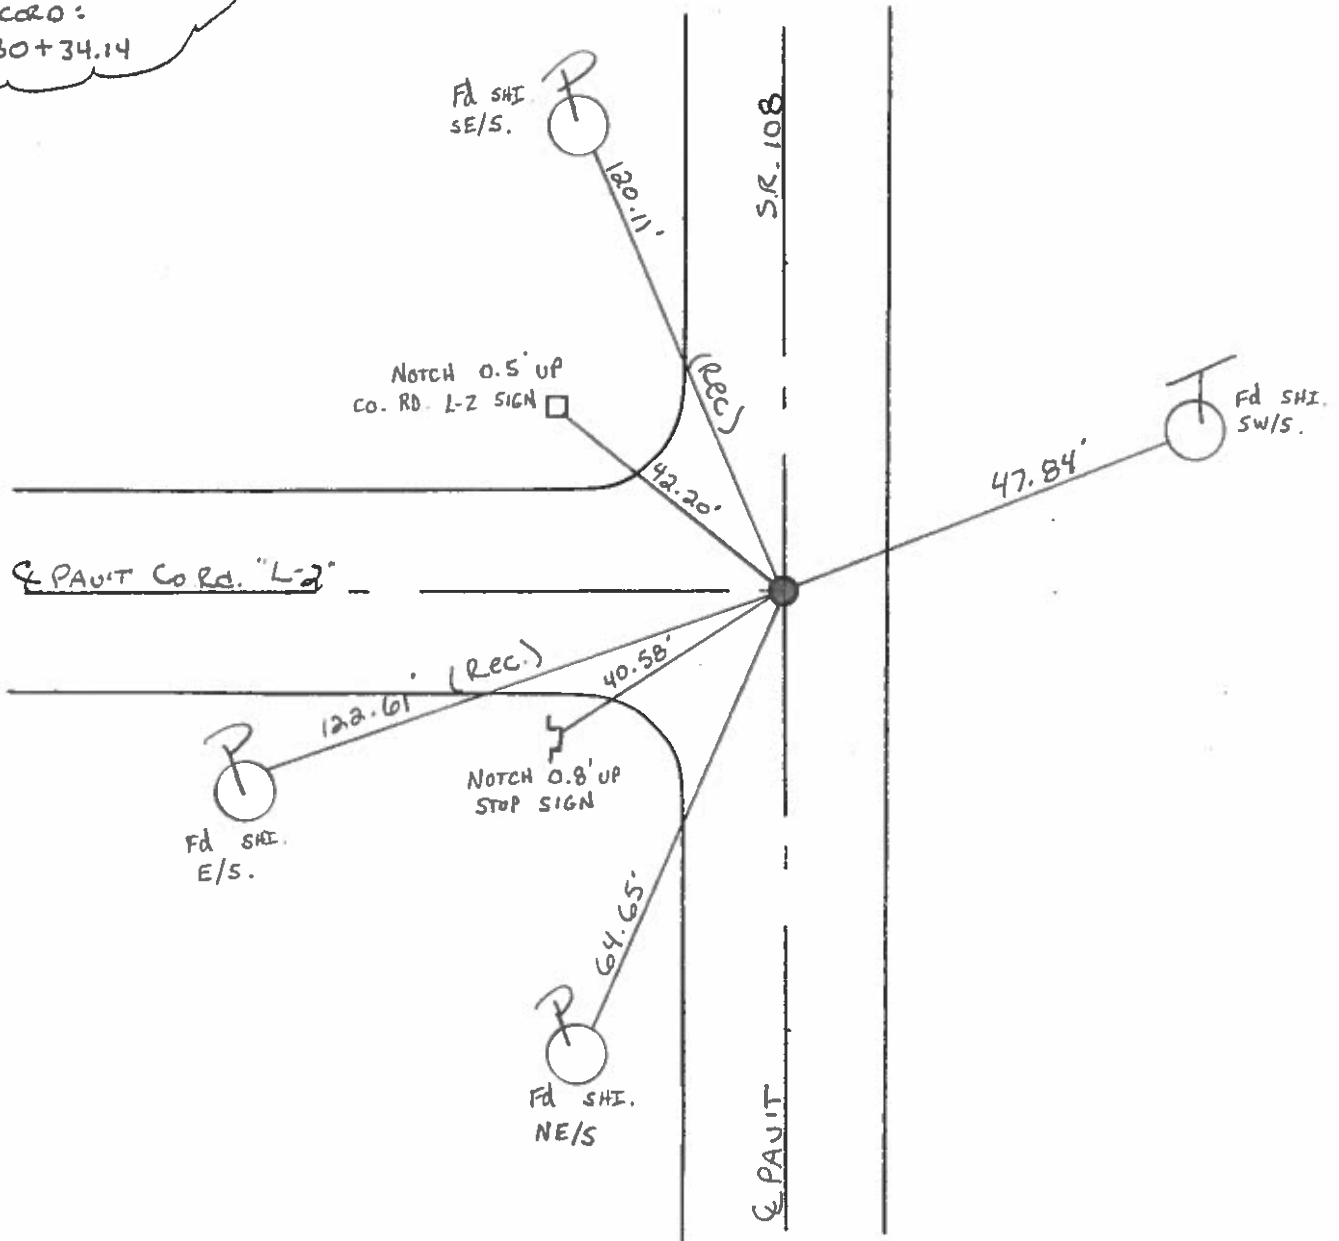

O.D.O.T. DISTRICT 2 SURVEY OFFICE

PERSONNEL

REFERENCE NO. 51

SHEET 2 OF 33

NOTES HOFFMAN

H.C. BARNHISEL

DATE 3-25-88

ROUTE SR 108

R.C. LOEHRKE

WEATHER Lt. Rain

COUNTY HENRY

REED

TEMP. 65°

TOWNSHIP FLATROCK

SECTION 1

T4 N R 6 E

TYPE MONUMENT SMALL R.R. SPIKE


~~ON SURFACE~~ - BELOW 1 1/2"

~~LEFT - & PAV'T. - RIGHT~~ YES


11.5 TO RT EDGE PAVEMENT

S.L.M. 629 + 83

Set SMALL
R.R. SPIKE
5-24-88 ewH

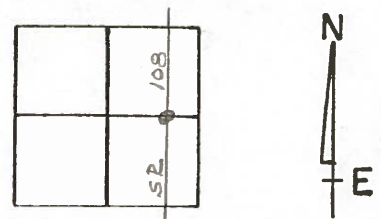

Record:
630+34.14

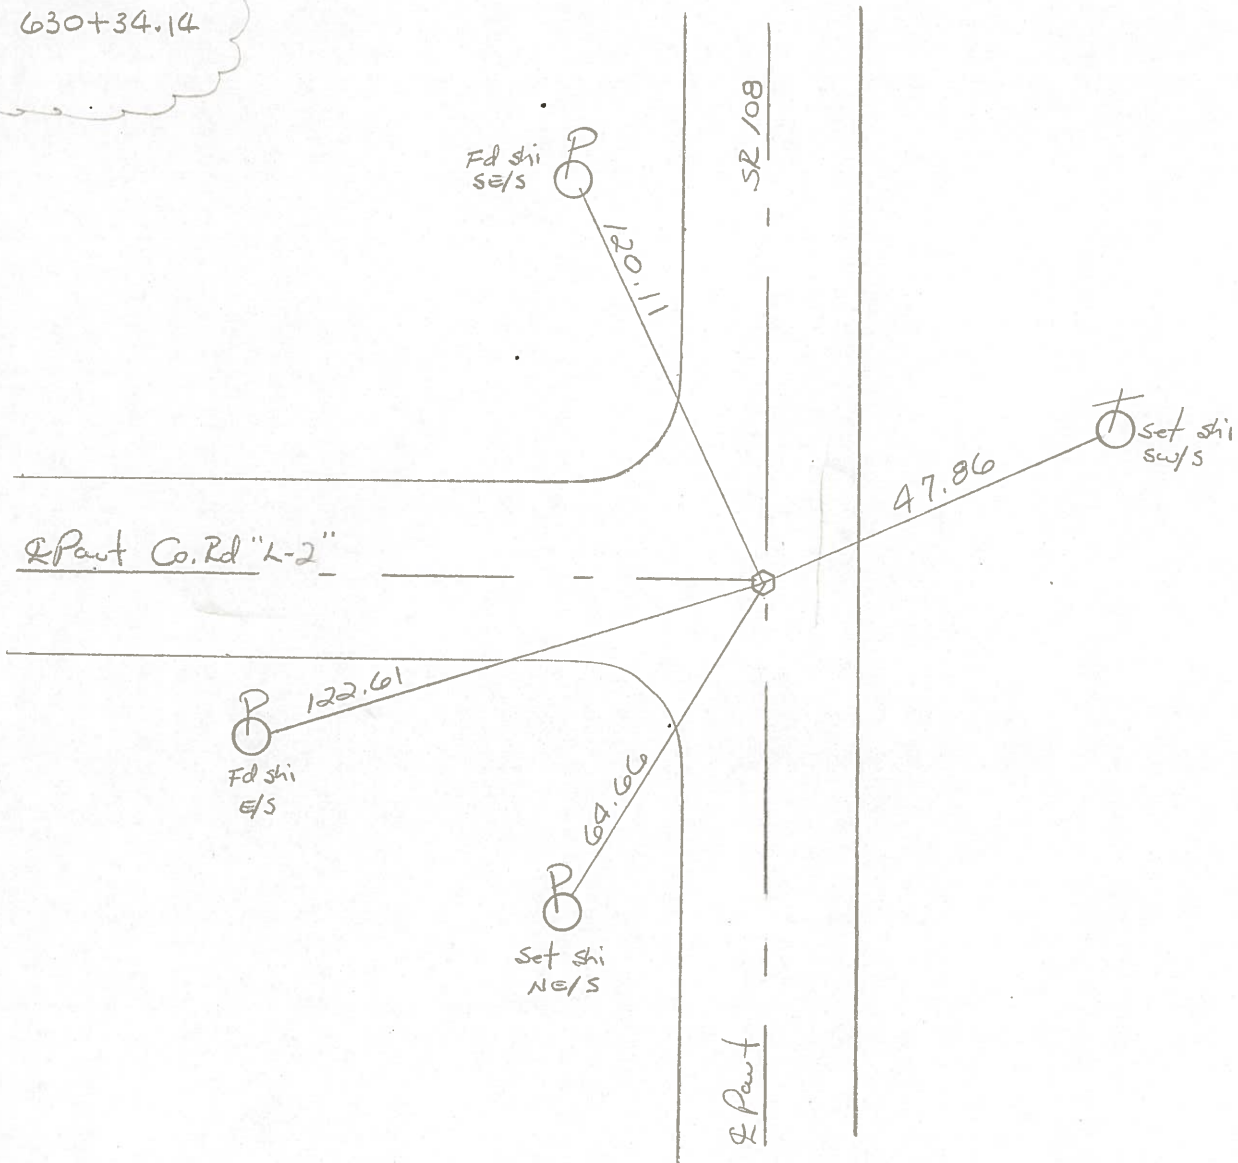

ODOT. DISTRICT 2 SURVEY OFFICE

Sht. 2 of 19
S.R. 108

County HENRY

Date 8-26-77

Township FLATROCK

Weather CLEAR

Section 1

Temp. +60°

T4N, R6E


Personnel BURNSIDE

SMITH

BOWERS

KNAPE


MEAD

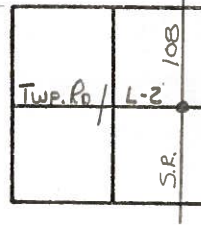

#51

FD. SMALL R.R. SPK.
@ SURFACE & IN
CTR. PAVEMENTS

STA. 630+34.14

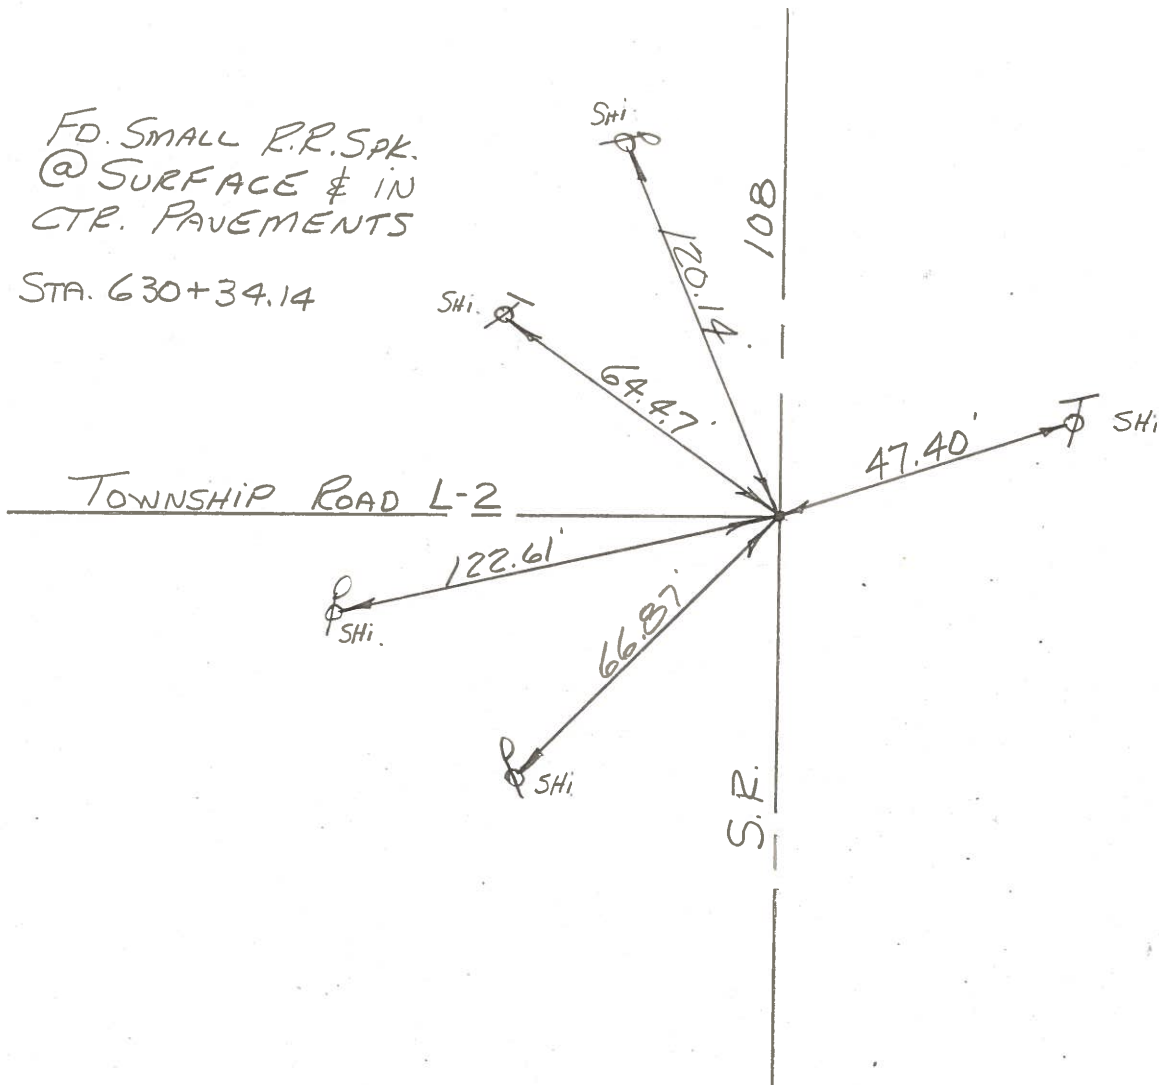


PERSONNEL	TITLE	PERSONNEL	TITLE
Tomsic			
Neuser			
Vanyo			
Granata			

COUNTY HENRY DATE July 11, 1974

S. R. 108 WEATHER _____


SEC. Flatrock TWP. TEMP. _____

DESCRIPTION _____ LEFT _____ CENTER LINE _____ RIGHT _____ JOB NO. _____

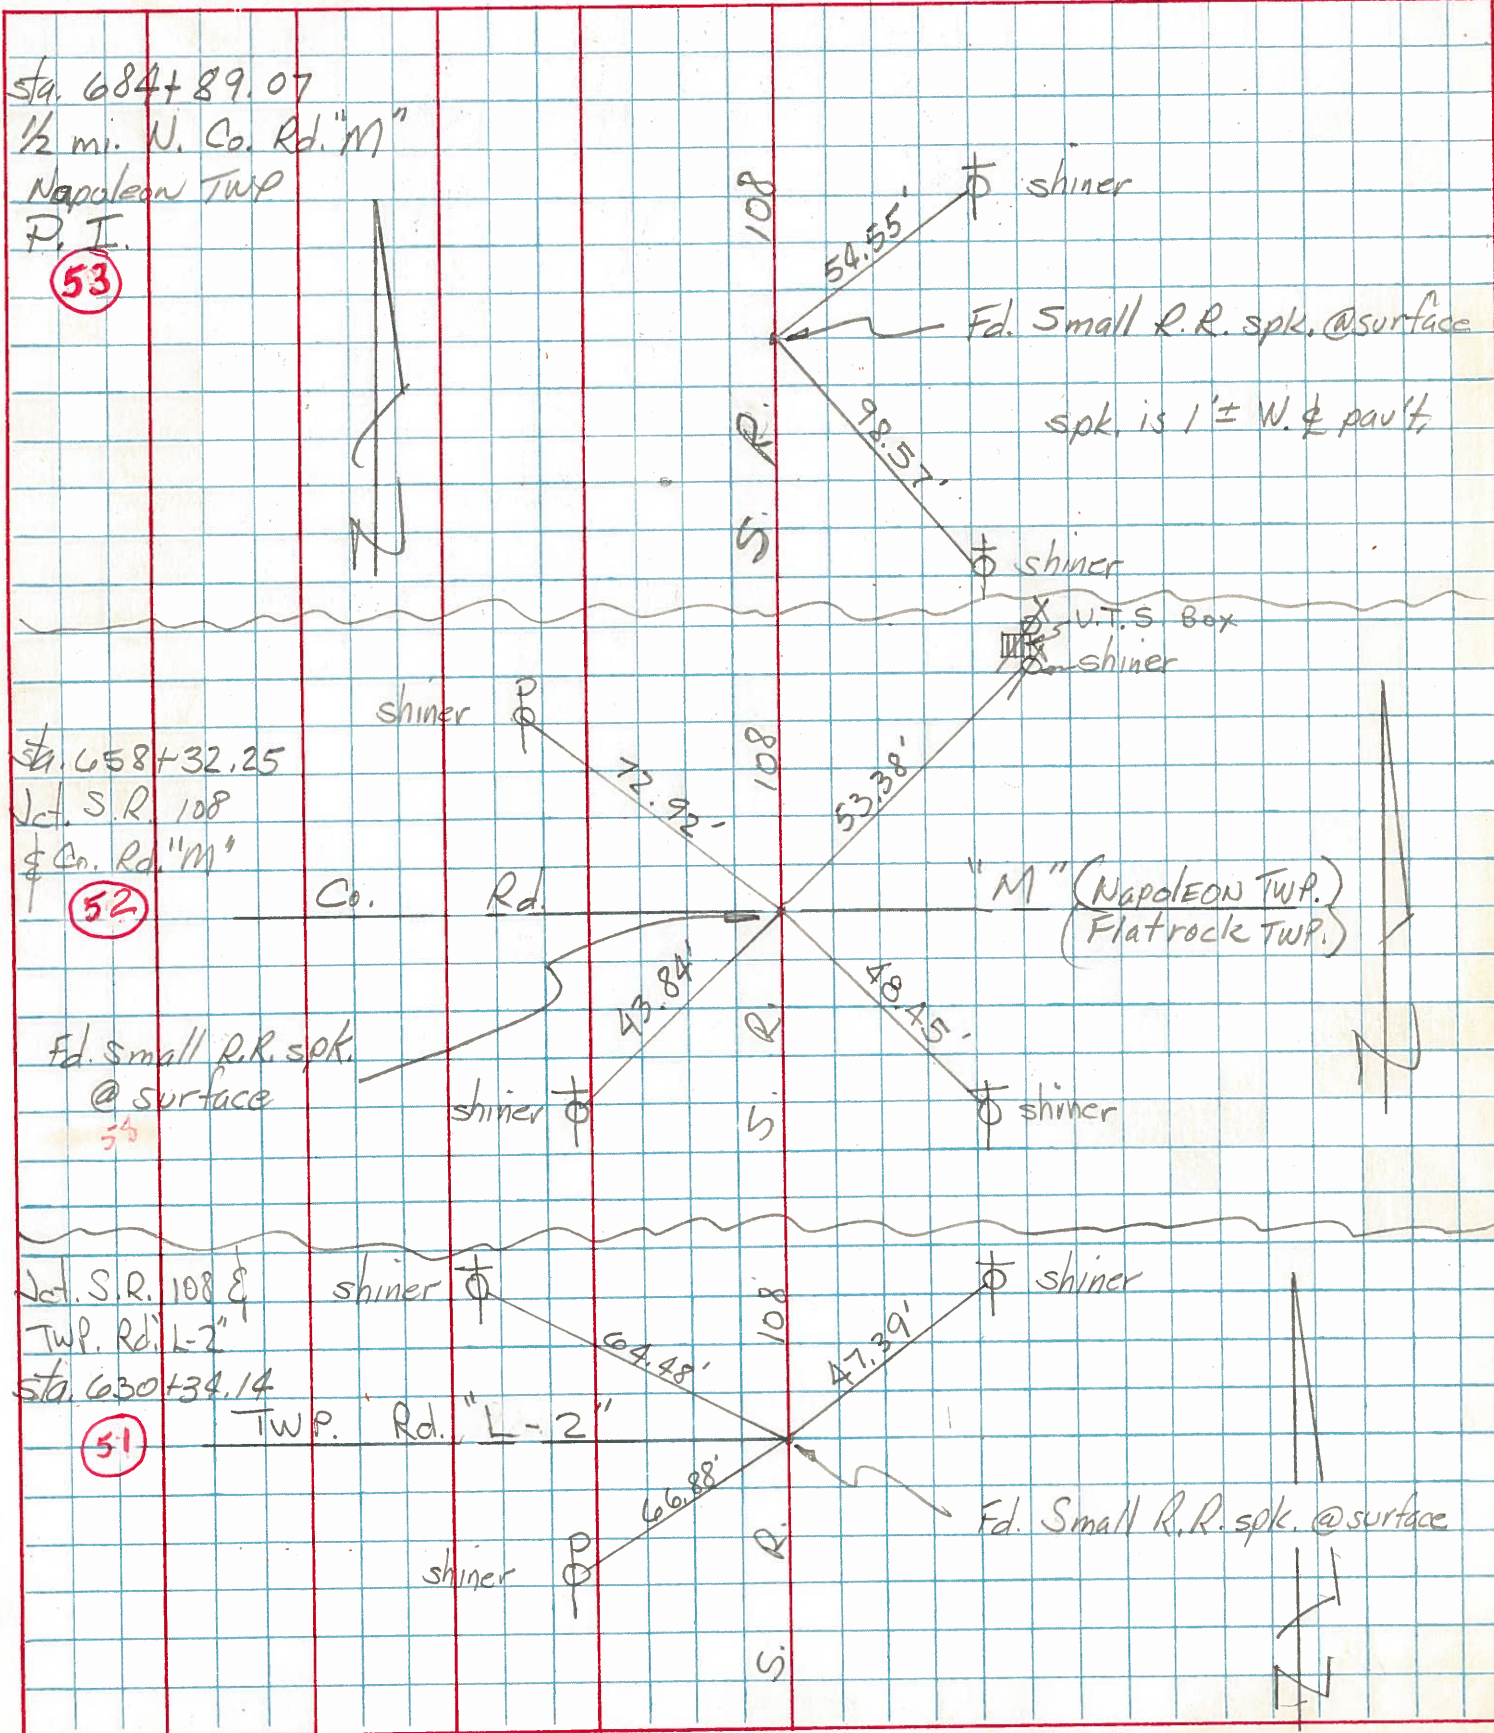

PERSONNEL TITLE PERSONNEL TITLE COUNTY HENRY DATE 11 JUNE 71
 ERIKCEU _____
 RAU _____
 CHAW RECORDER _____
 S. R. # 108 (1143) WEATHER CLOUDY
 SEC. Co Rd 1 to NAP TEMP. 75°

DESCRIPTION RE WITNESS TO CONTROL POINTS JOB NO. _____
 LEFT CENTER LINE RIGHT

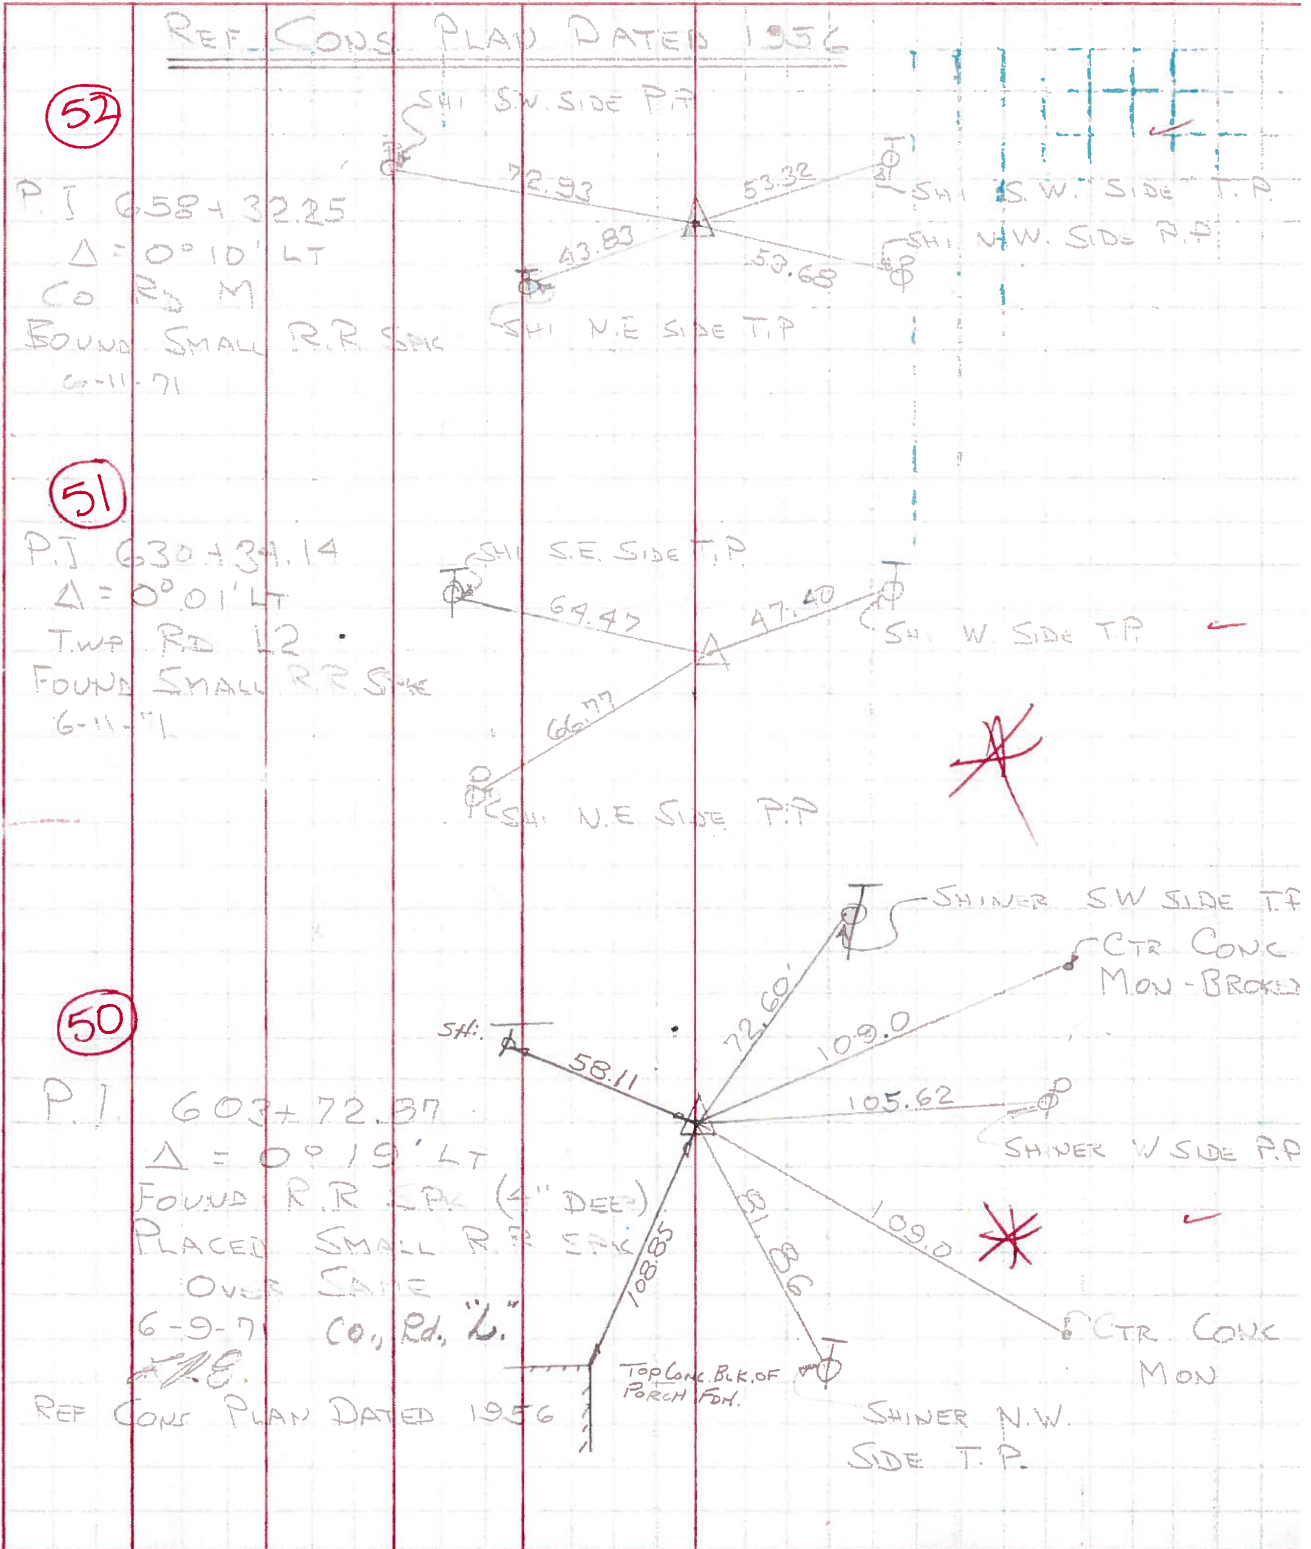

OK
 5-3-72

PERSONNEL TITLE PERSONNEL TITLE

Jamason notes German
Williams
Keil
Robinson

COUNTY Henry

DATE 7-30-57

S. R. 108

WEATHER Clear

SEC.

TEMP 90°

DESCRIPTION

Relocating Control Points

JOB NO.

LEFT

CENTER LINE

RIGHT

(50)

P.I. Sta. 603+72.87
 $\Delta = 0^\circ 19' L$

Shiner in
14° Spruce S.W.

Shiner in
15° Spruce S.S.W.

Set RR Spt.
104.41'

96.50'

71.73' Shiner N.N.E.

105.72' Shiner E

81.8'

Shiner S.S.E.

(51)

P.I. Sta. 680+34.14
 $\Delta = 0^\circ 01' L$

Shiner N.W.

Shiner S.W.

Set RR Spt.

70.80'

64.35'

47.50' Shiner N.E.

PERSONNEL	TITLE	PERSONNEL	TITLE	COUNTY	DATE
Ruffler				HENRY	11-27-56
Kwasec				S. R. 108	WEATHER Fair
Hoff				SEC.	TEMP. 30
Young					

DESCRIPTION LEFT CENTER LINE RIGHT JOB NO.

P.I. Sta 60.3 + 72.87

P.I. Sta 60.3 + 72.87

(50)

Set RR Spk

6.30 + 34.14


(51)

50
47.62

Set RR Spk


6.58 + 32.25

(52)

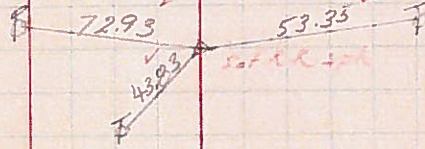


6.84 + 89.07

(53)

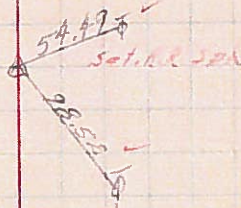

7.11 + 39.97

(54)

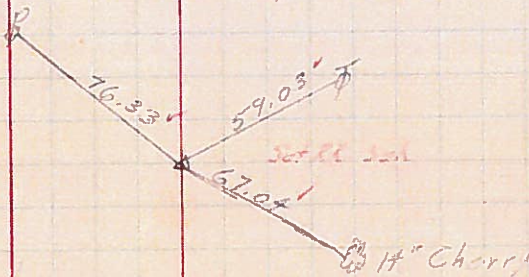


PERSONNEL TITLE PERSONNEL TITLE
 Jameson notes
 Crew

COUNTY Henry DATE 9-13-56
 S. R. 108 WEATHER Clear
 SEC. TEMP. 85°

DESCRIPTION Witness Control Points

JOB NO.

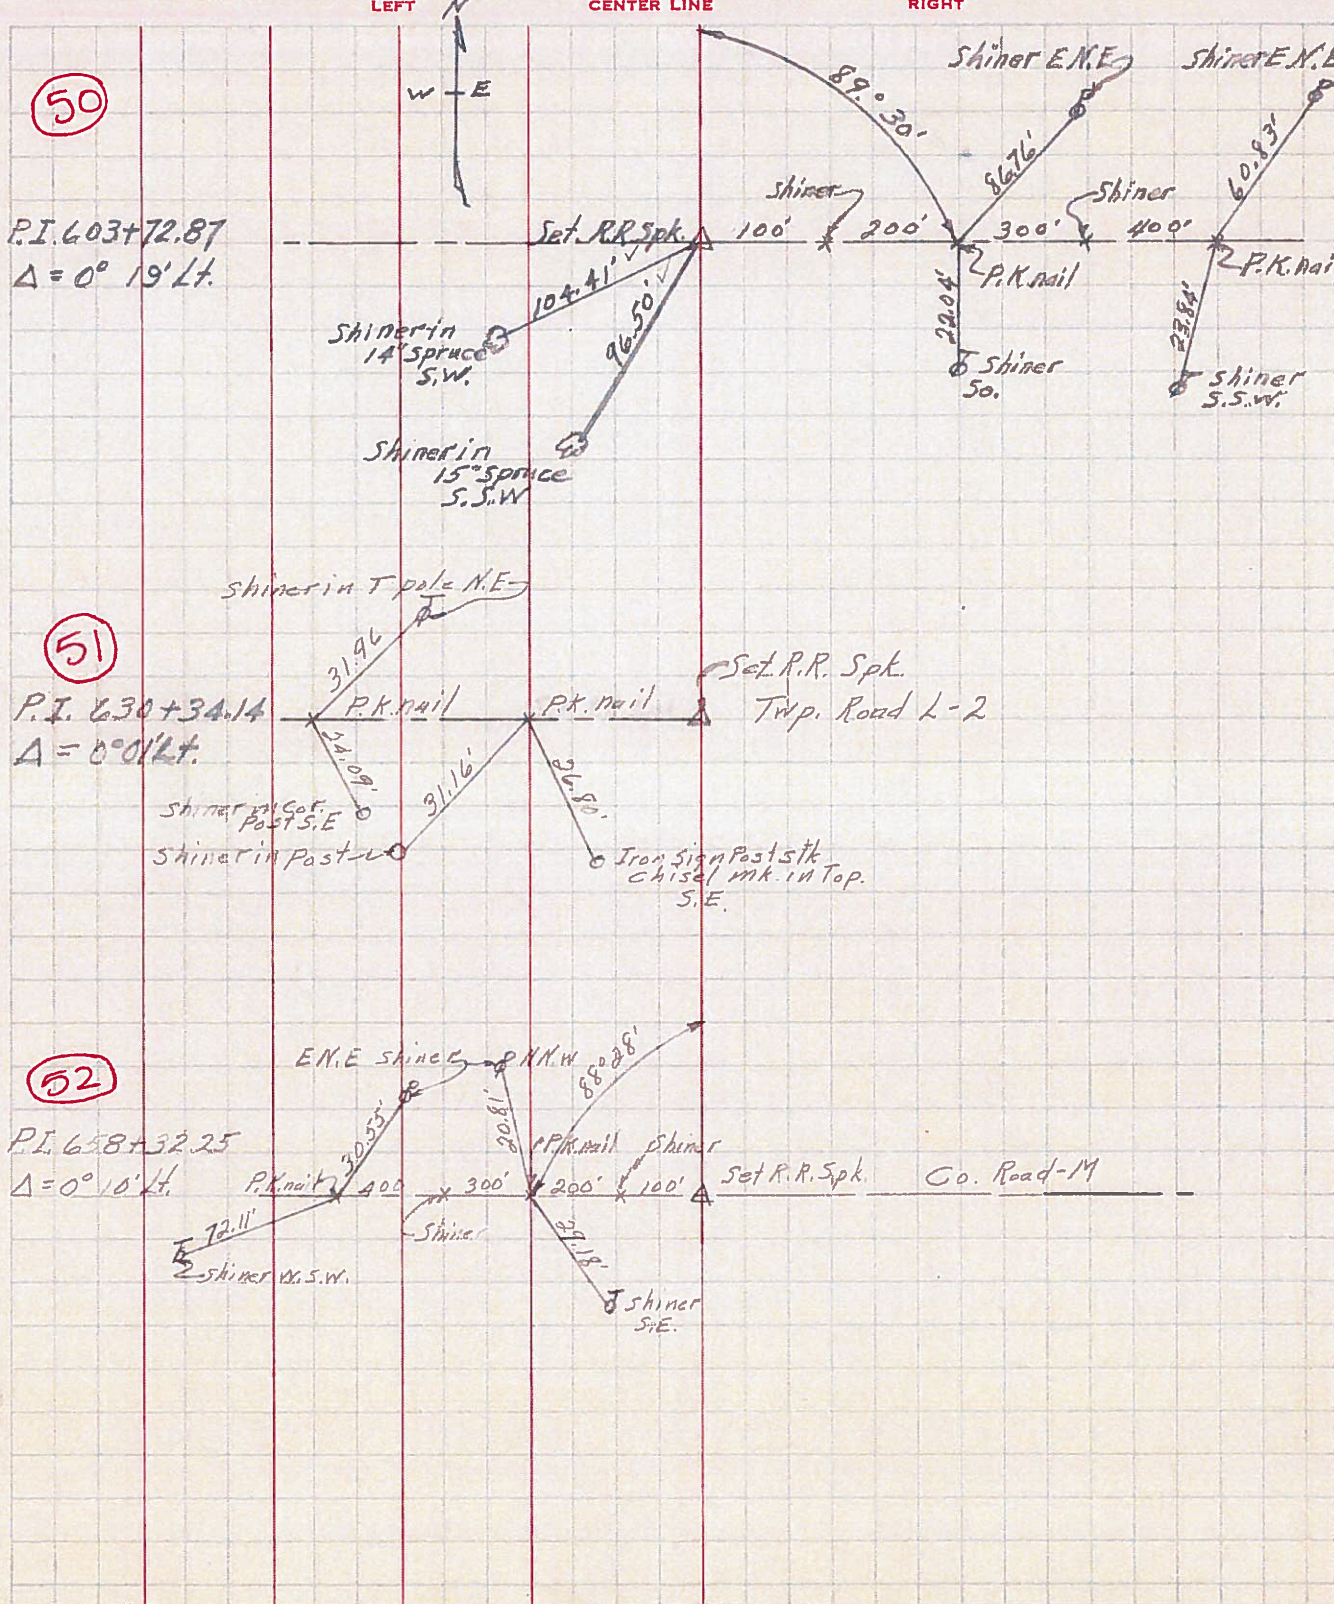

PERSONNEL TITLE PERSONNEL TITLE

Lewis
Kutter
Daum


COUNTY DATE 4-14-55

S. R. 108 WEATHER Fair

SEC. TEMP. 65°

DESCRIPTION Tie-Ins to Quarter Sec Cor. for R/W JOB NO.

LEFT CENTER LINE RIGHT

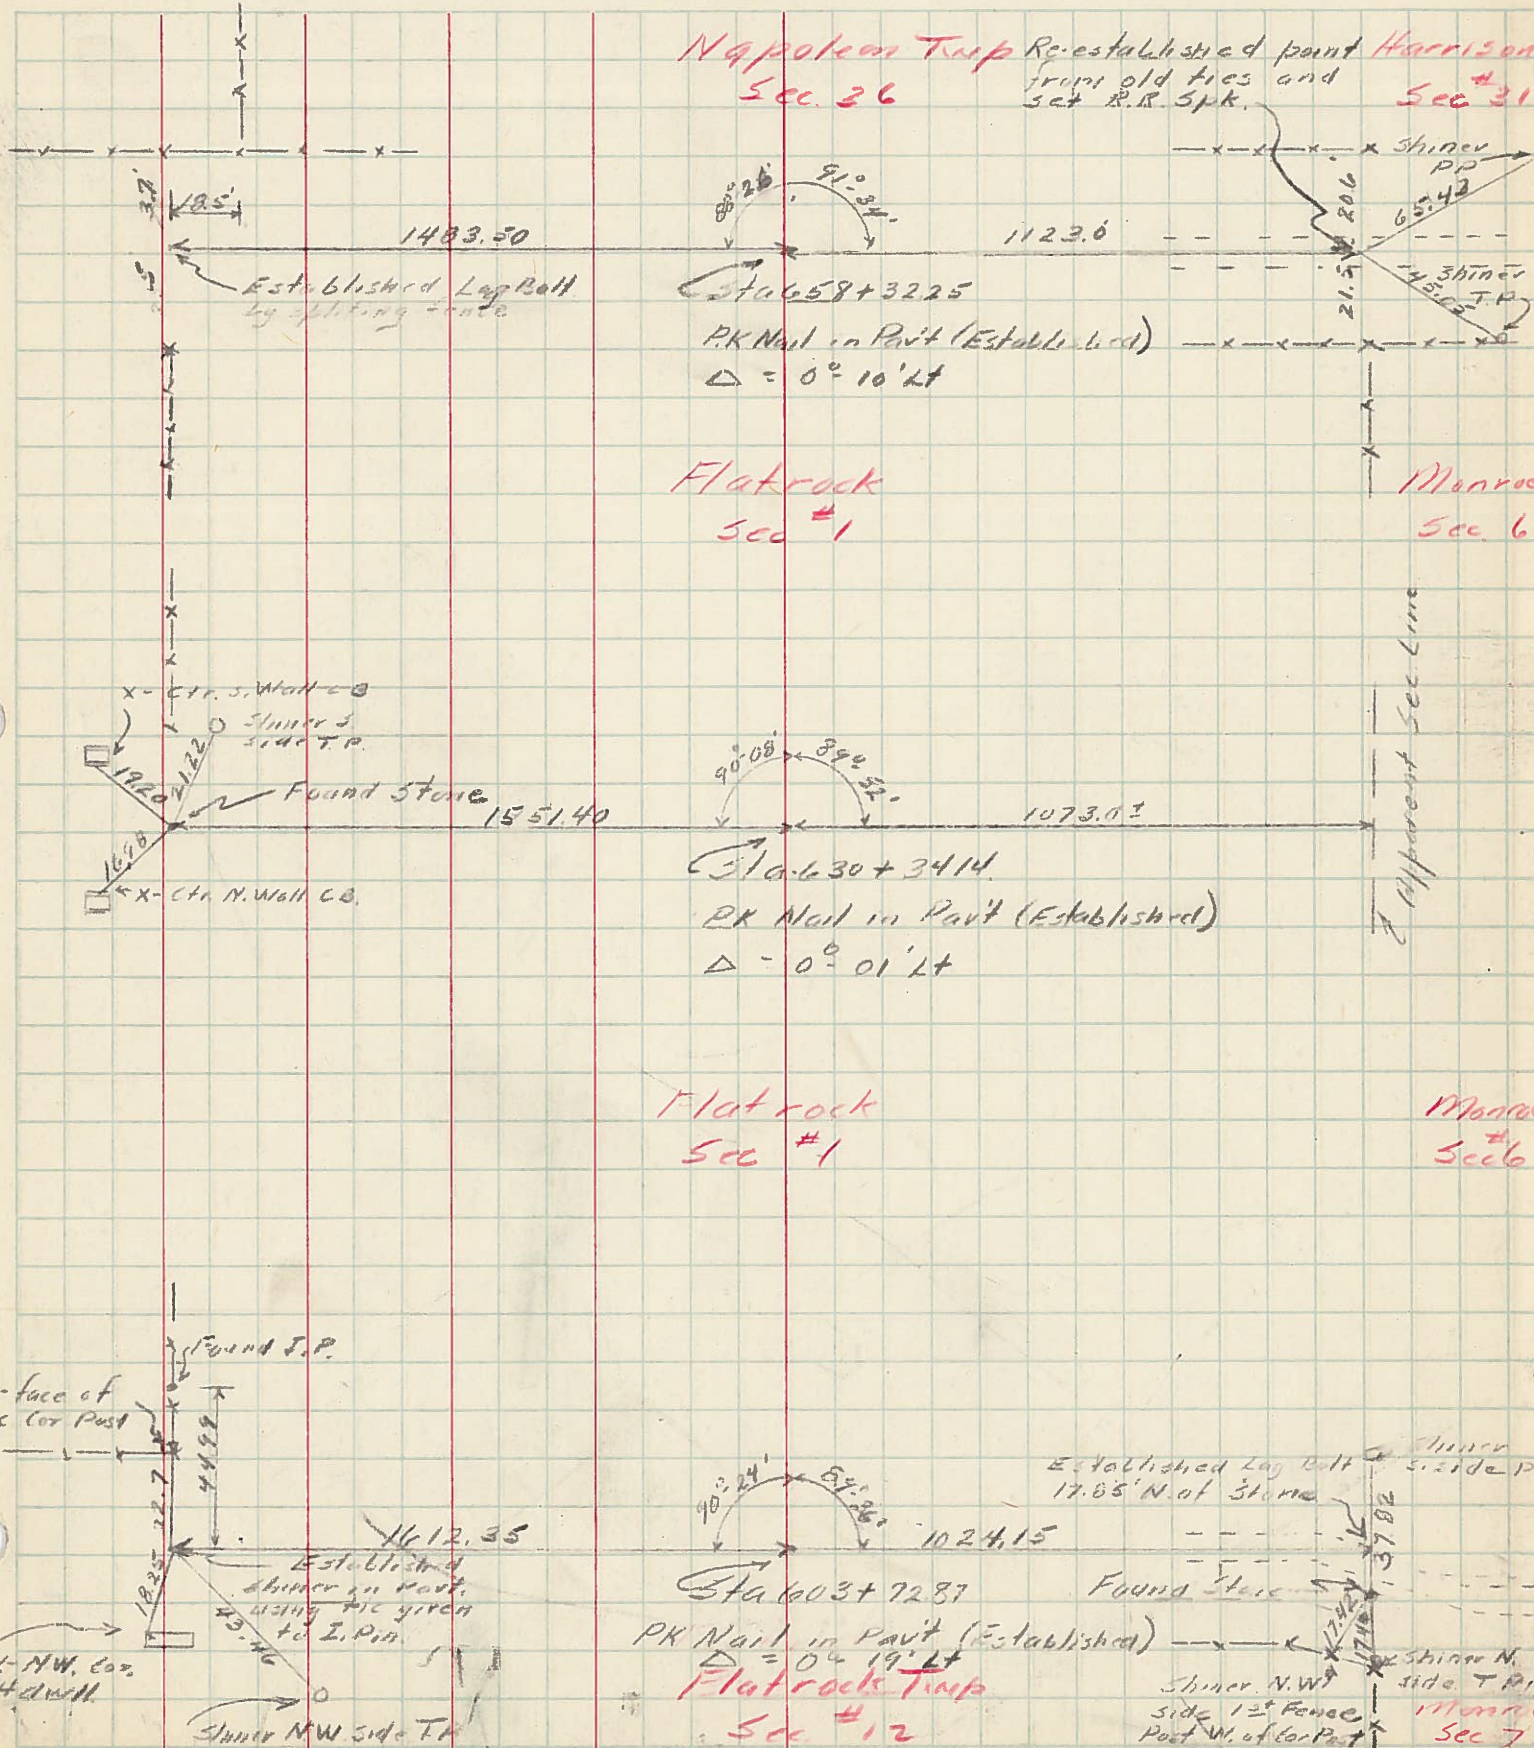

PERSONNEL	TITLE	PERSONNEL	TITLE
Huover			
Lotta			
Duda			


COUNTY He DATE 2-17-55

S. R. 108 WEATHER


SEC. TEMP.

DESCRIPTION	LEFT	CENTER LINE	RIGHT	JOB NO.
P.I.				

50

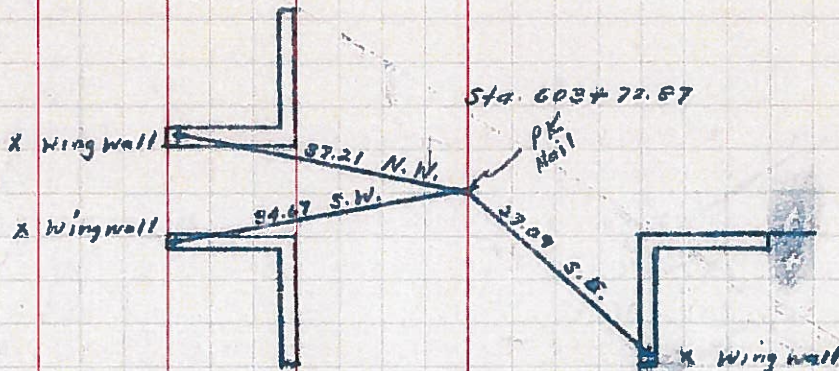

51

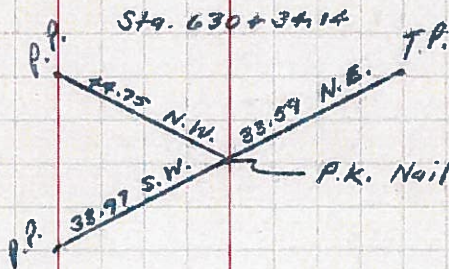

52

