

O.D.O.T. DISTRICT 2 SURVEY OFFICE (USE ONLY)

PERSONNEL _____ REFERENCE NO. 52 SHEET 38 OF 48
 NOTES BALBAUGH DATE 8/9/01 ROUTE SR 108
 H.C. LEU WEATHER OVERCAST COUNTY HENRY
 R.C. BALBAUGH TEMP. 85° TOWNSHIP FLATROCK
 DWG BY GARRETT PID 94319 SECTION 1
 T 4 N R 6 E

TYPE MONUMENT SM.R.R.SPIKE SHANK

~~ON SURFACE~~ - BELOW 3"

OFFSET \varnothing PAVEMENT ON _____ LT : RT

- TO - EDGE PAVEMENT


STATION: 658+11.0

HORZ.DATUM: NAD83 (2011)


GEOID: 2012A

GRID: NORTHING: 614260.213

EASTING: 1523899.092

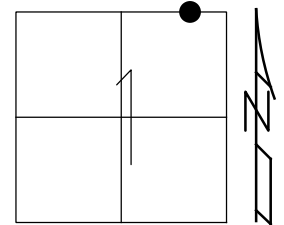

RECORD:
 STA 658+32.25
 $\Delta = 00^\circ 10' \text{ LT}$
 FD SM.R.R.SPIKE
 8/9/01, MB
 SET PK/WASHER
 10-13-01, MRC
 FD SM.R.R.SPIKE
 3" DOWN
 REF52
 11-7-18, JLL
 SET MAG/WASHER
 10-22-20, DSA

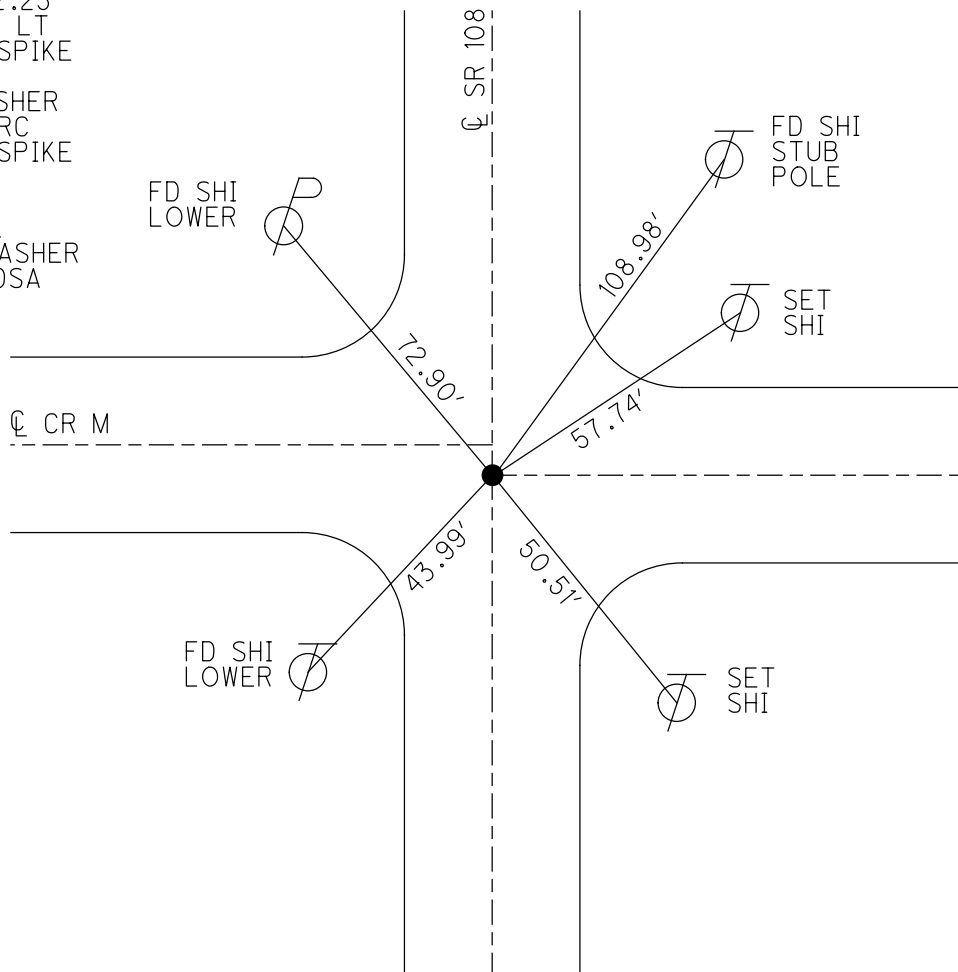

O.D.O.T. DISTRICT 2 SURVEY OFFICE

PERSONNEL

REFERENCE NO. 52

SHEET 3 OF 9

NOTES CANTERBURY

H.C. BARNHISEL

R.C. MOSEK

DRAWN BY: MOSEK

DATE 8-9-01

WEATHER OVERCAST

TEMP. +85°F

ROUTE 108

COUNTY HENRY

TOWNSHIP FLATROCK

SECTION 1

T4 N R 6 E

TYPE MONUMENT Sm R.R. SPIKE


ON SURFACE - ~~BELOW~~ ON

~~EST - C~~ PAV'T. - RIGHT C 2 C.R. "M"


- TO EDGE PAVEMENT

S.L.M. 657+14

RESET PK/WASHER
 10/13/01
 M.A.C.

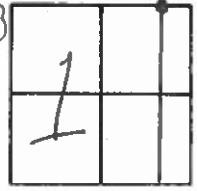

RECORD:
 658 + 32.25'

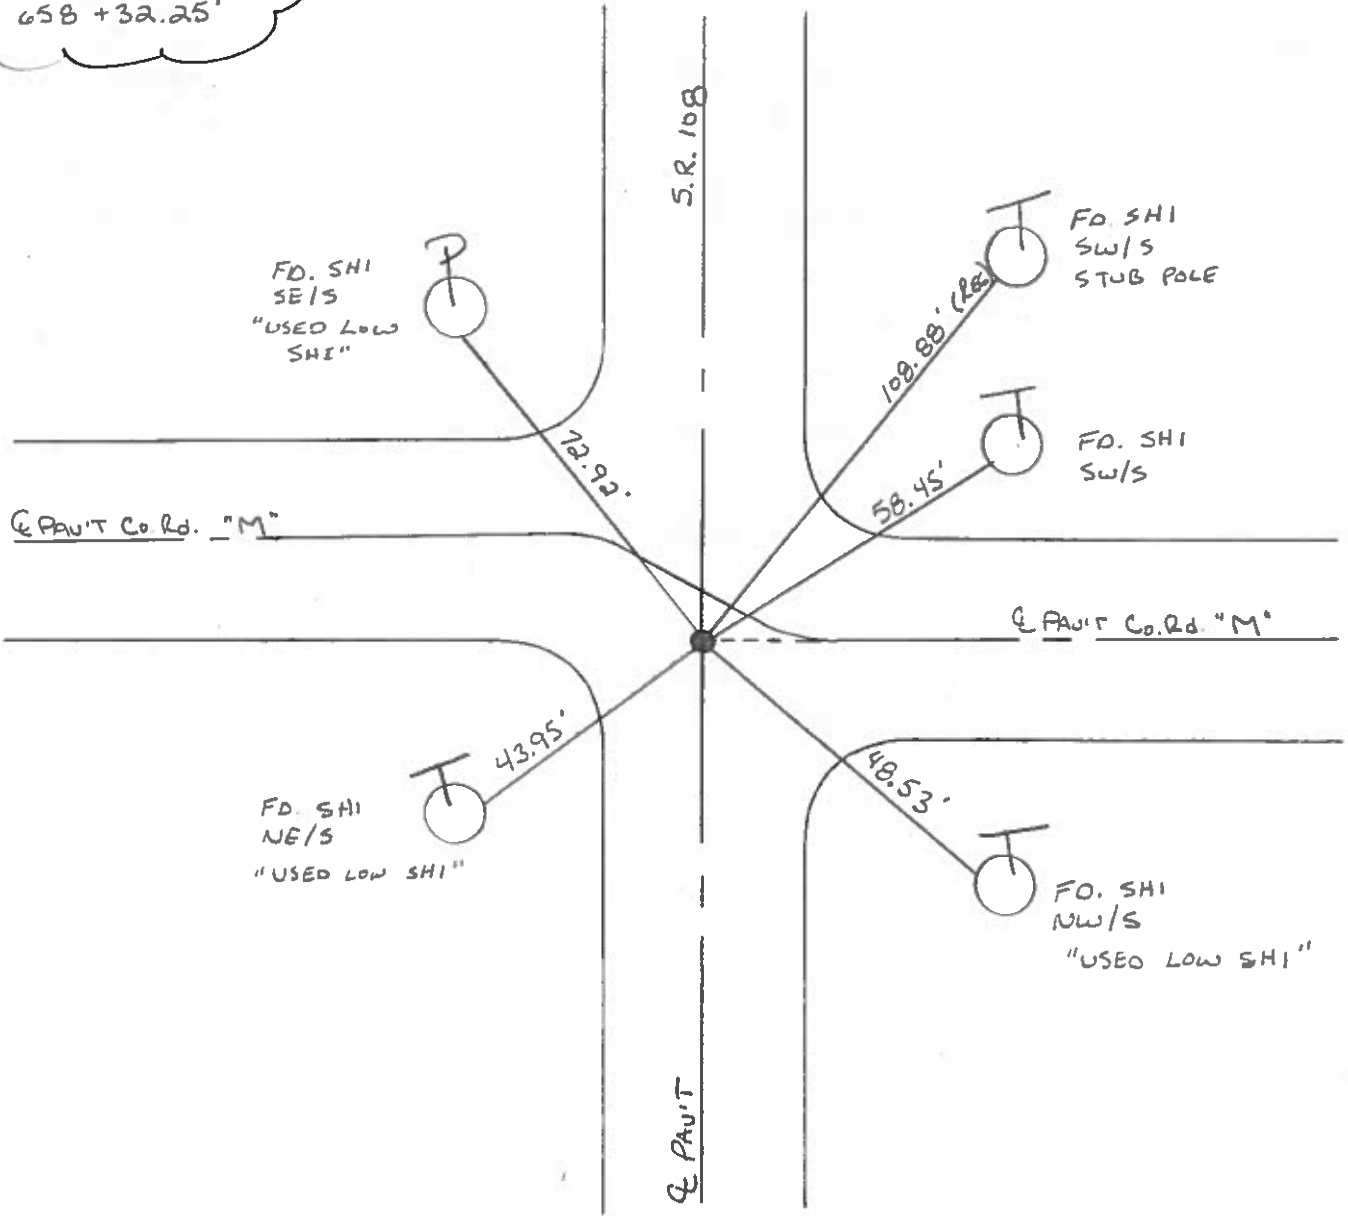

O.D.O.T. DISTRICT 2 SURVEY OFFICE

PERSONNEL

REFERENCE NO. 52

SHEET 3 OF 33

NOTES HOFFMAN

H.C. BARNHISEL

DATE 3-25-88

ROUTE SR 108

R.C. LOEHRKE

WEATHER Lt. Rain

COUNTY HENRY

REED

TEMP. 65°

TOWNSHIP FLATROCK

SECTION 1

T4 N R 6 E

TYPE MONUMENT SMALL R.R. SPIKE


~~ON SURFACE~~ - BELOW 1 1/2"

LEFT- & PAV'T. - RIGHT YES


TO EDGE PAVEMENT ON & PAVT ROAD EAST

S.L.M. 657+80

Set small R.R. SPIKE 5-24-88 swH

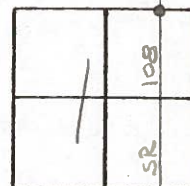

Record:
658+32.25

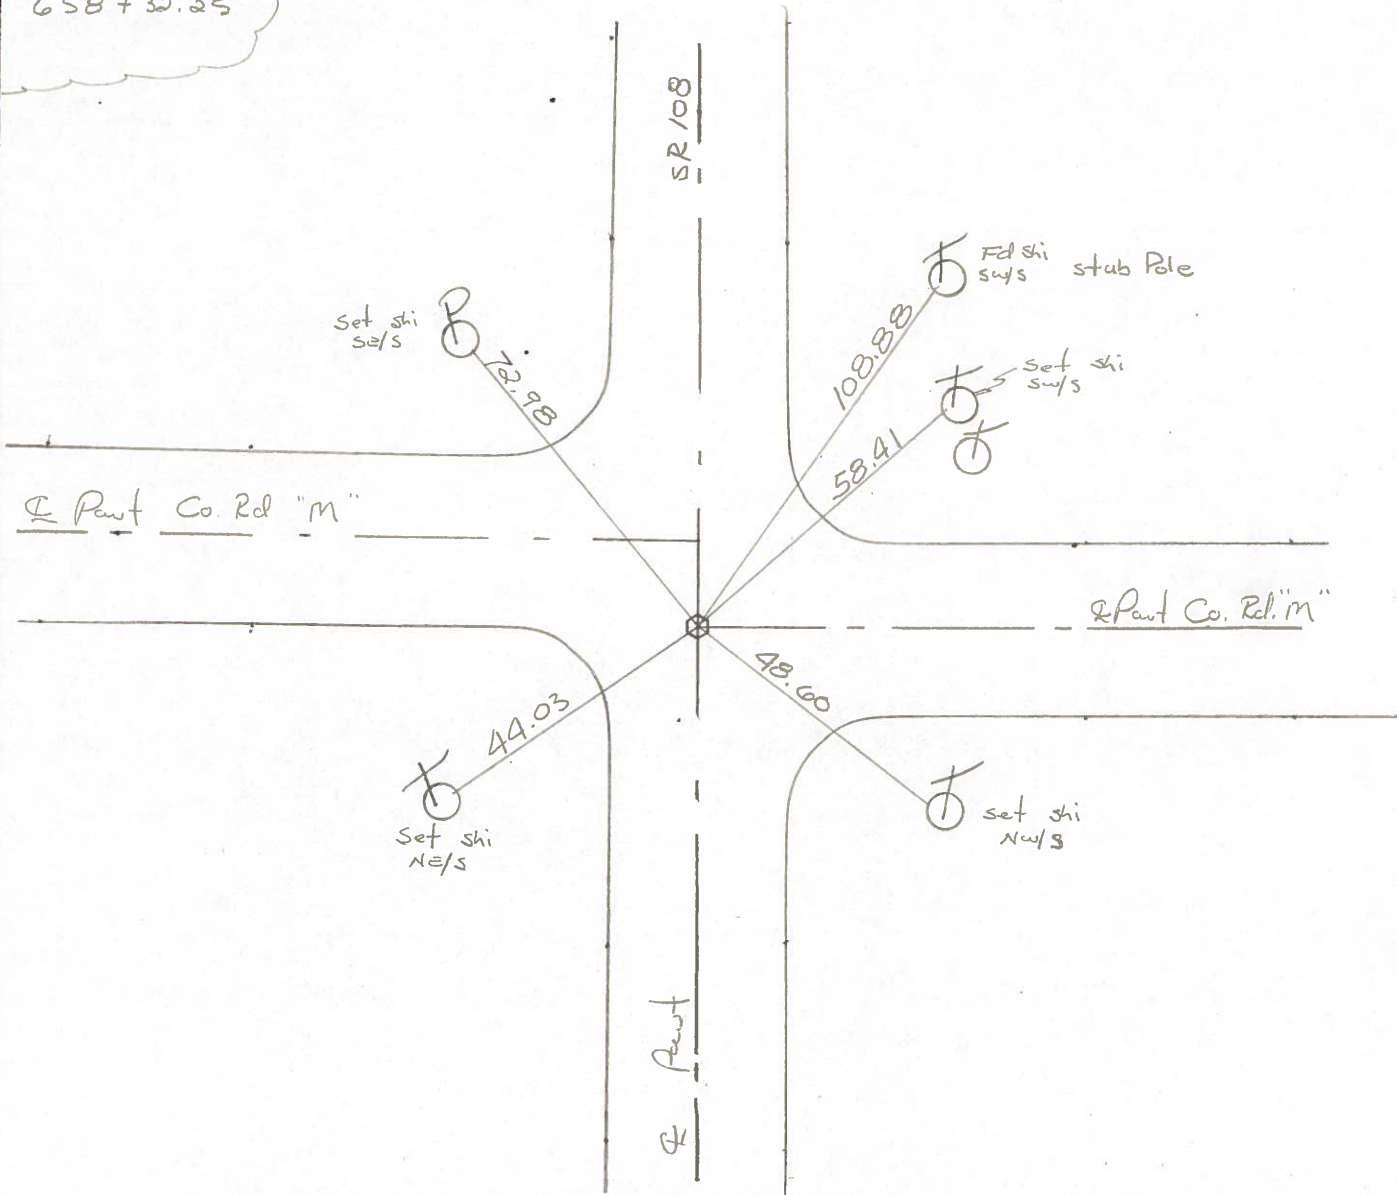

Q.D.O.T. DISTRICT 2 SURVEY OFFICE

Sht. 3 of 19
S.R. 108

County HENRY

Date 8-26-77

Township FLATROCK


Weather CLEAR

Section 1

Temp. +62°

T4N, R6E


Personnel BURNSIDE
SMITH
BOWERS
KNAPE
MEAD

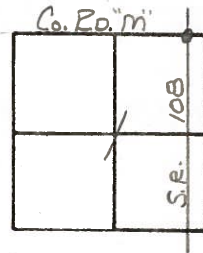

#52


FD. SMALL R.R. SPK.
 @ SURFACE & IN
 CTR. PAVEMENTS

STA. 658+32.25

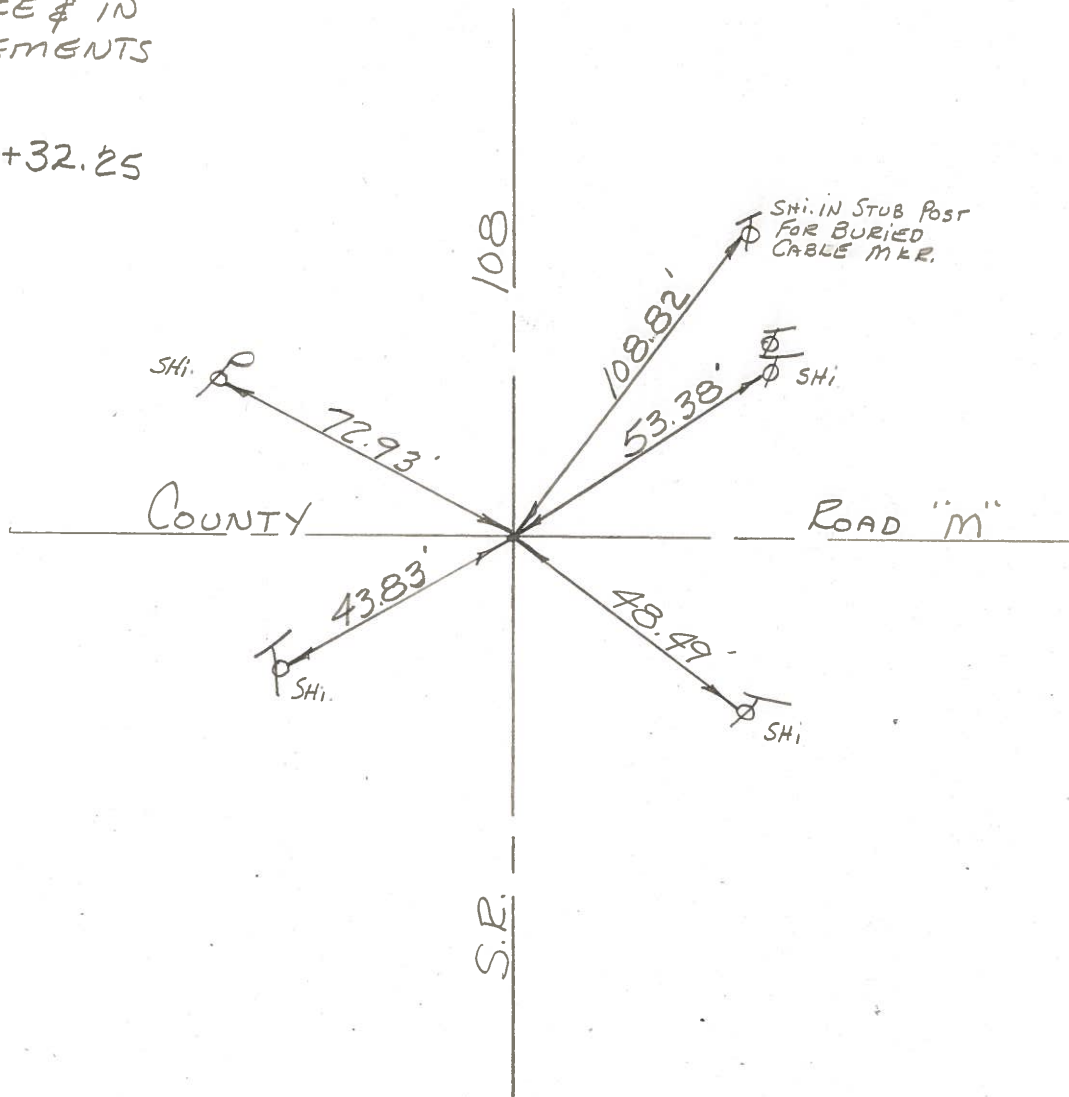


PERSONNEL	TITLE	PERSONNEL	TITLE	COUNTY	DATE	WEATHER	TEMP.
TOMSLIC				HENRY	July 11, 1974		
Neuser				S. R. 108			
Vandy				SEC. Flatrock TWP.			
Granata							

DESCRIPTION	LEFT	CENTER LINE	RIGHT	JOB NO.
-------------	------	-------------	-------	---------

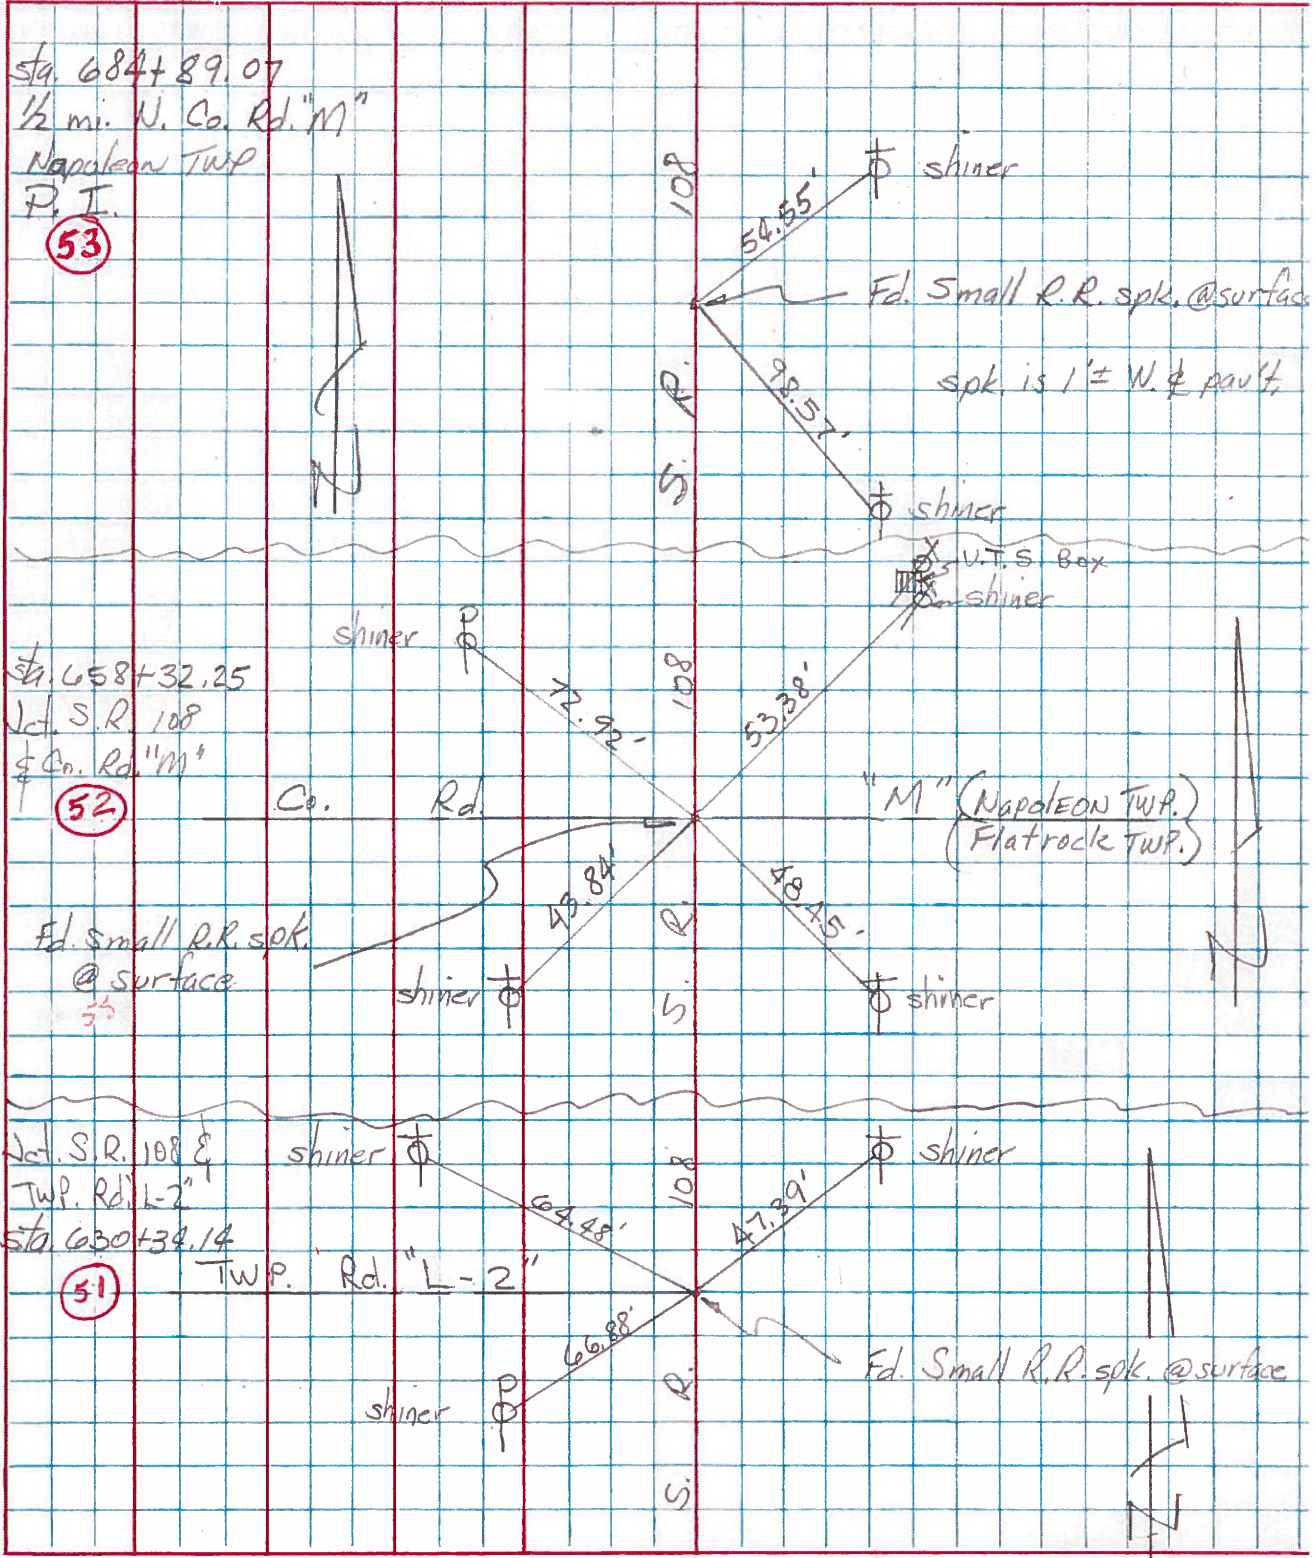


PERSONNEL ERIKCEV TITLE _____ PERSONNEL _____ TITLE _____ COUNTY HENRY DATE 11 JUNE 71
RAU _____ _____ _____ S. R. # 108 (1143) WEATHER CLOUDY
CHAW RECORDER _____ _____ _____ SEC. Co Rd L to NAP TEMP. 75°

DESCRIPTION RE WITNESS TO CONTROL POINTS JOB NO. _____

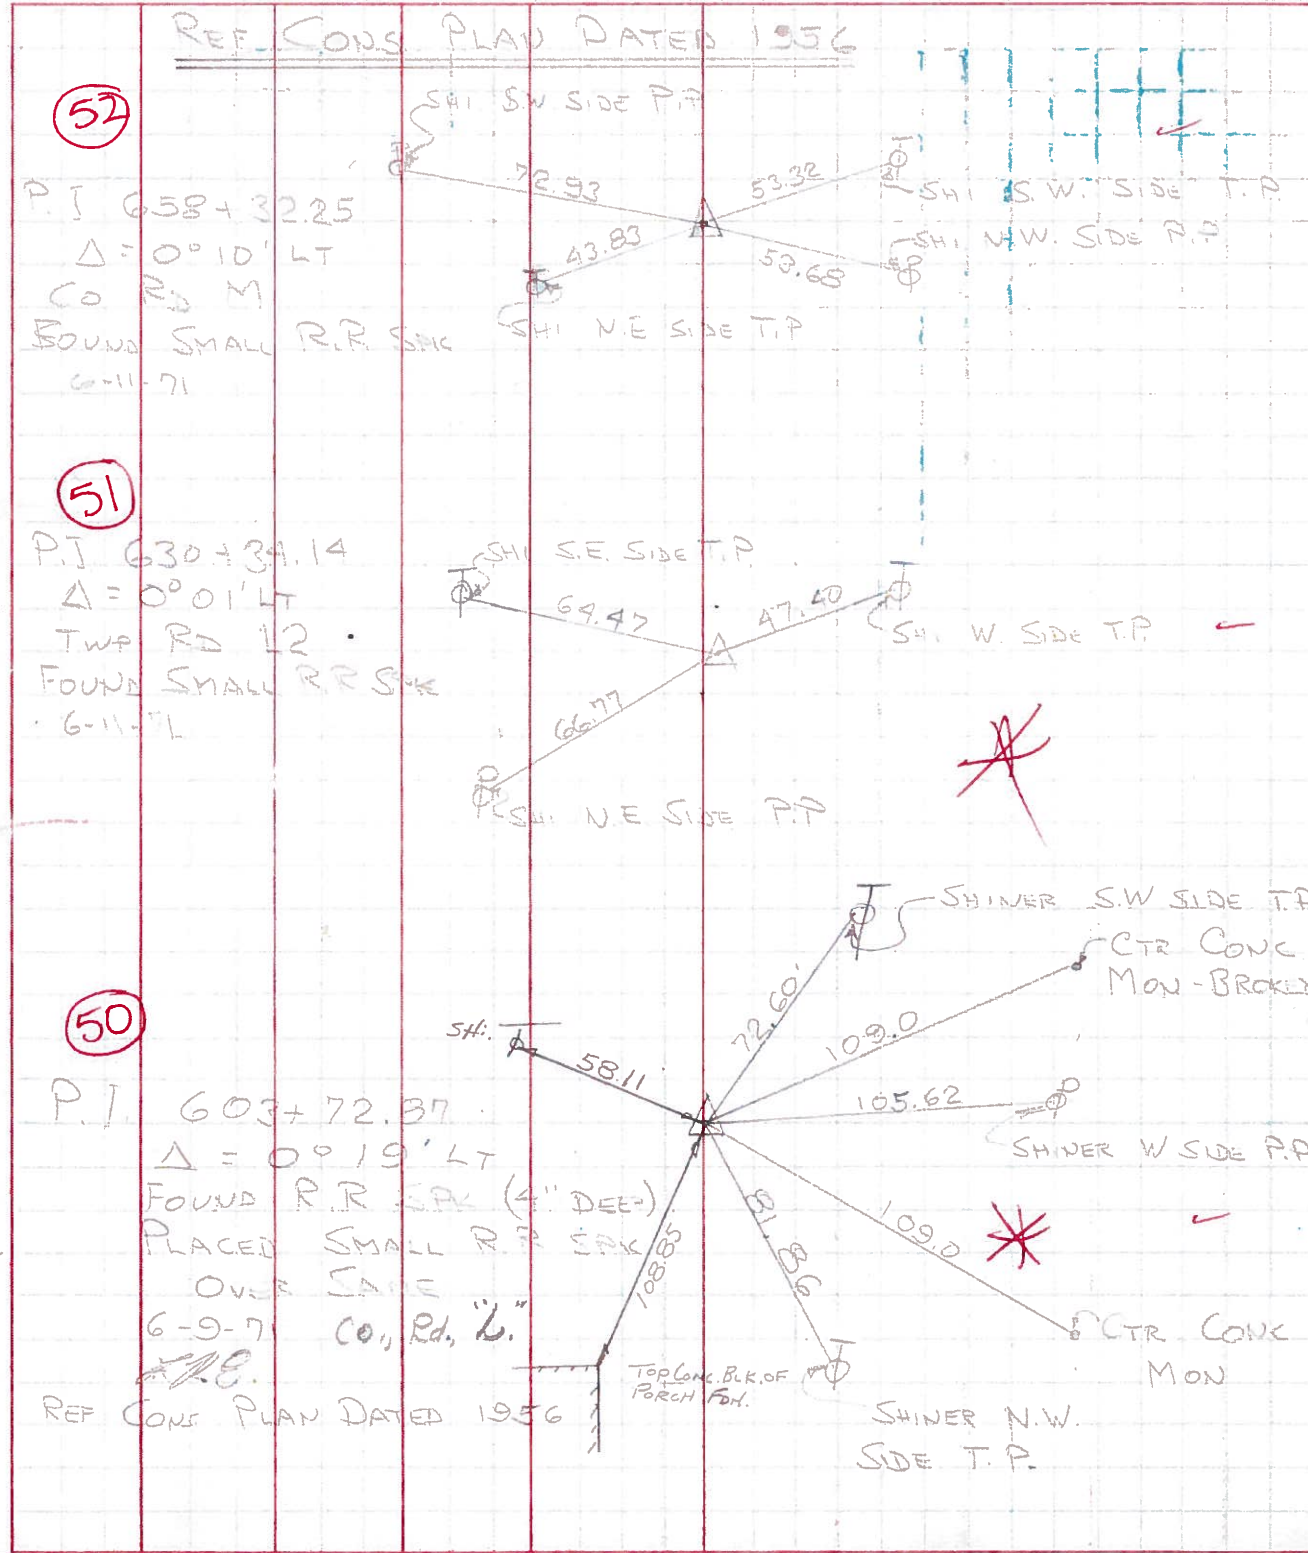

OK
5-3-72

PERSONNEL	TITLE	PERSONNEL	TITLE	COUNTY	DATE
Ruffar				HENRY	11-27-56
Kware				S. R. 108	WEATHER Fair
Hoff				SEC.	TEMP. 30
Young					

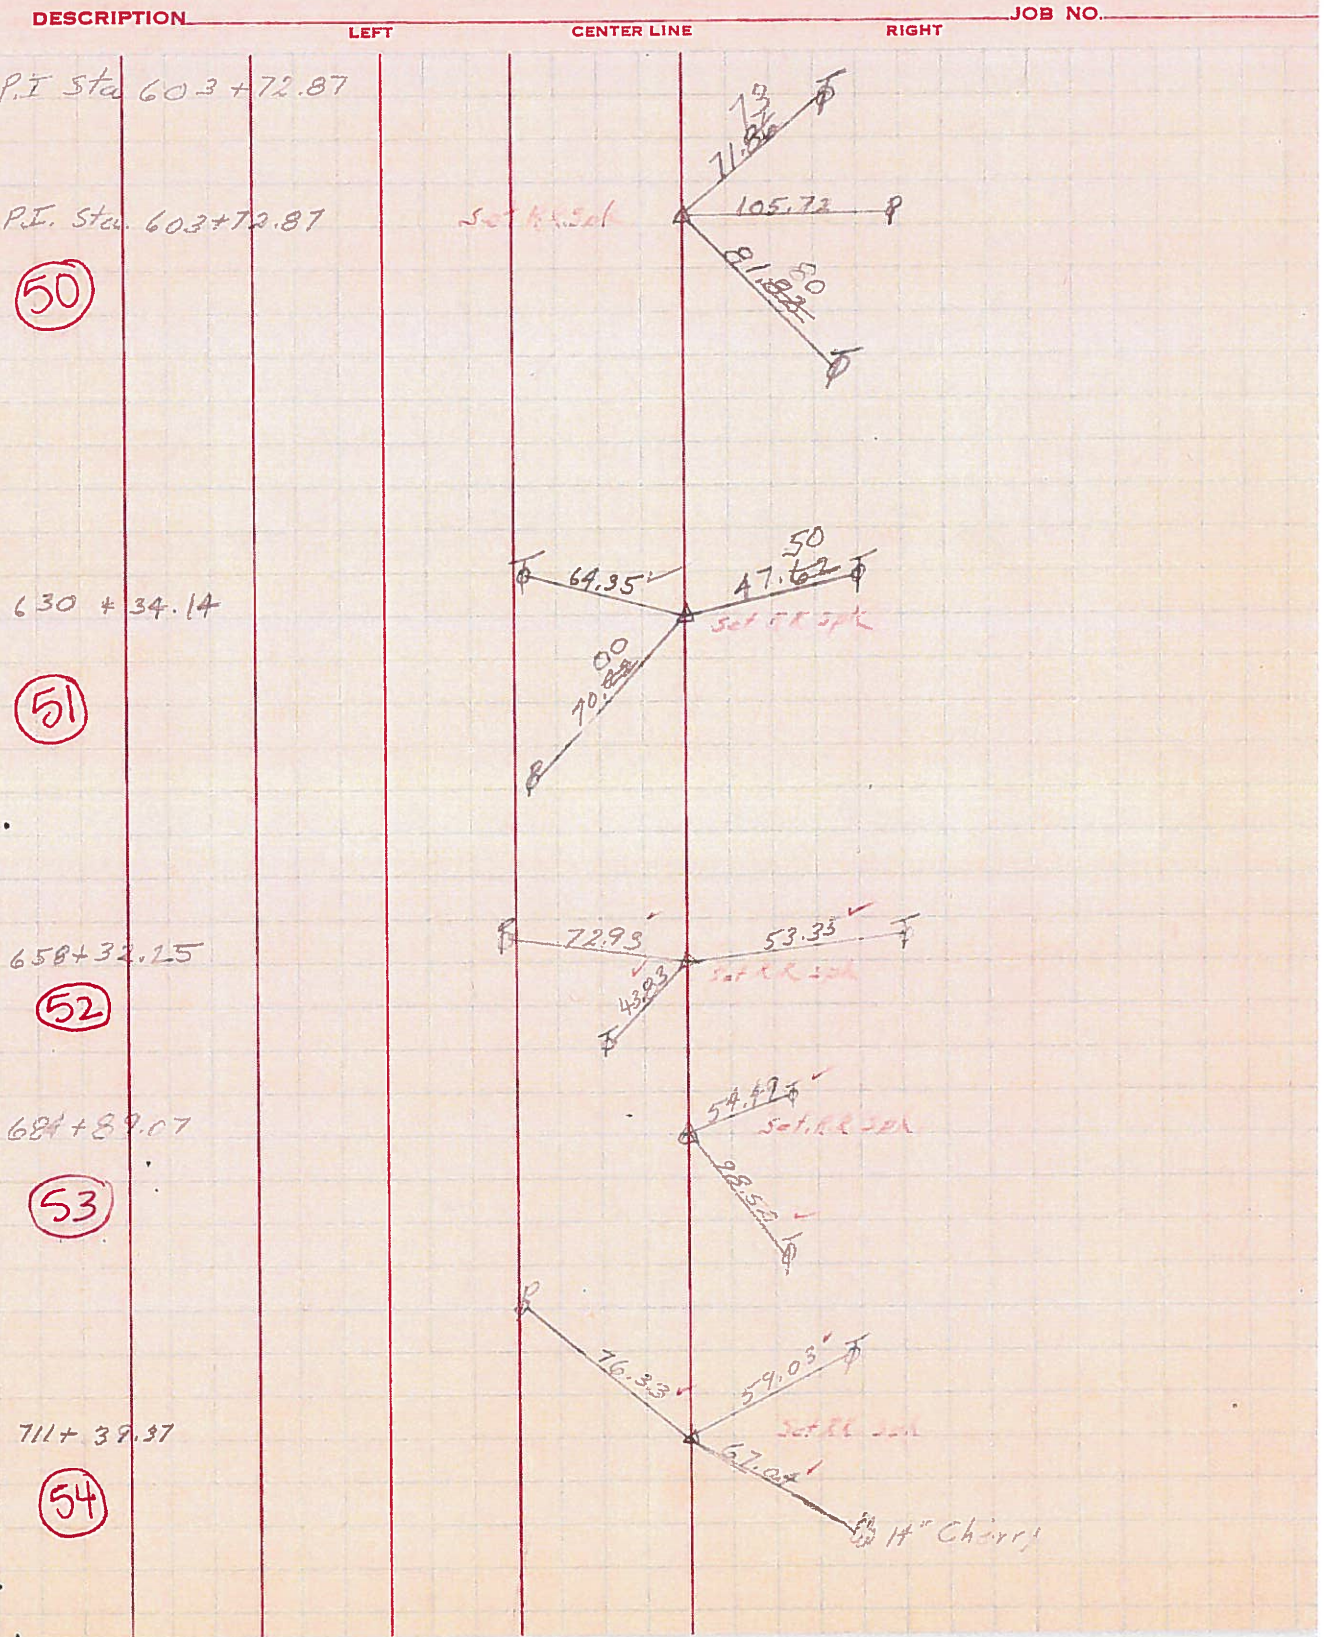

PERSONNEL TITLE PERSONNEL TITLE

Jameson notes

COUNTY Henry

DATE 9-13-56

+

S. R. 108

WEATHER Clear

crew

SEC.

TEMP. 85°

DESCRIPTION Witness Control Points

LEFT


CENTER LINE

RIGHT

JOB NO.


50

P.I. 603+72.87
Δ = 0° 19' Lt.

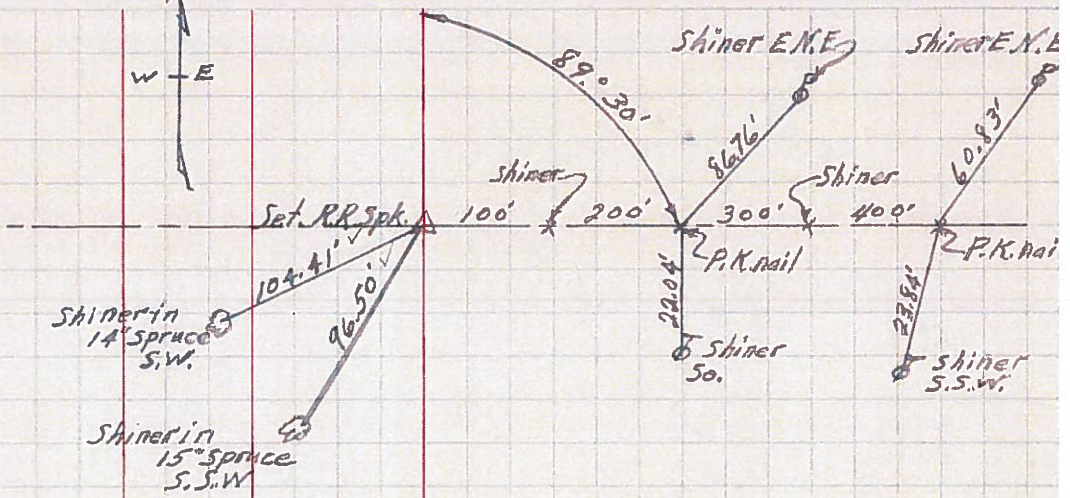


51

P.I. 630+34.14
Δ = 0° 01' Lt.

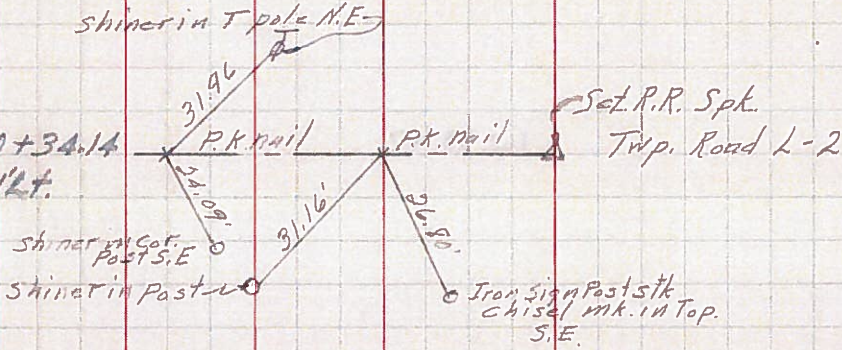

52

P.I. 658+32.25
Δ = 0° 10' Lt.

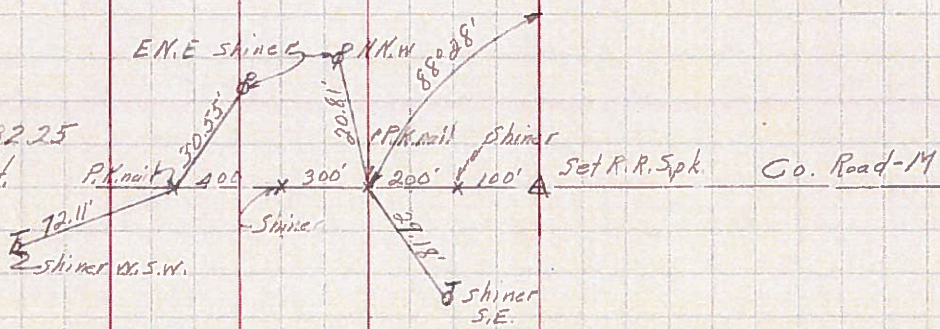

PERSONNEL TITLE PERSONNEL TITLE
 Hoover _____
 Latta _____
 Duda _____


COUNTY He DATE 2-17-55

S. R. 108 WEATHER _____


SEC. _____ TEMP. _____

DESCRIPTION P.I. LEFT CENTER LINE RIGHT JOB NO.

50

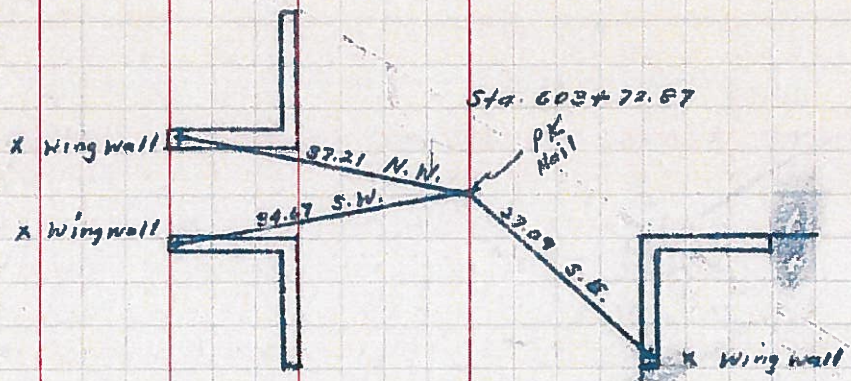

51

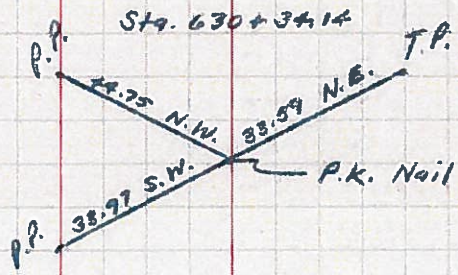

52

