


O.D.O.T. DISTRICT 2 SURVEY OFFICE (USE ONLY)


PERSONNEL _____ REFERENCE NO. 53 SHEET 39 OF 48
 NOTES BALBAUGH DATE 3/12/20 ROUTE SR 108
 H.C. LEU WEATHER OVERCAST COUNTY HENRY
 R.C. BALBAUGH TEMP. 42° TOWNSHIP NAPOLEON
 SECTION 36
 DWG BY GARRETT PID 94319 T 5 N R 6 E

TYPE MONUMENT P.K./WASHER
 ON SURFACE - ~~BELOW~~ ON
 OFFSET \bar{C} PAVEMENT 1.0' LT : ~~RT~~
11.4' TO LT EDGE PAVEMENT
 STATION: 684+67.07

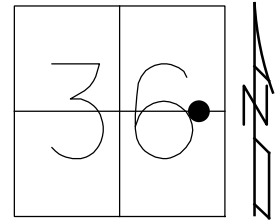

HORZ.DATUM: NAD83 (2011) GEOID: 2012A
 GRID: NORTHING: 616915.897 EASTING: 1523854.116

RECORD: P.I.
 STA 684+89.07
 $\Delta = 00^\circ 26' RT$
 FD SM.R.R.SPIKE
 8/9/01, MB
 SET P.K./WASHER
 11-15-01, MRC
 FD P.K./WASHER
 REF53
 11-7-18, JLL
 SET MAG/WASHER
 10-22-20, DSA

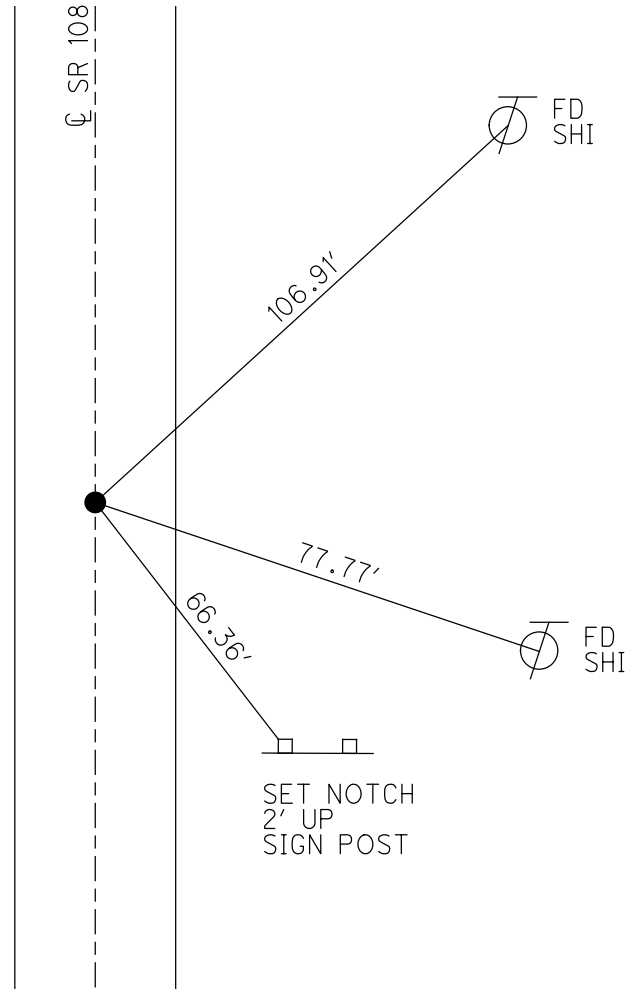

O.D.O.T. DISTRICT 2 SURVEY OFFICE

PERSONNEL

REFERENCE NO. 53

SHEET 4 OF 9

NOTES CANTERBURY

H.C. BARNAISEL

DATE 8-9-01

ROUTE 108

R.C. MOSEK

WEATHER OVERCAST

COUNTY HENRY

DRAWN BY: MOSEK

TEMP. +85°F

TOWNSHIP NAPOLEON

SECTION 36

TS N R 6 E

TYPE MONUMENT Sm. RR SPIKE


ON SURFACE - ~~BELOW~~ ON

LEFT - ~~PAV'T.~~ RIGHT 1.0 LT

11.4' TO LT. EDGE PAVEMENT


S.L.M. 683+84

RESET PK./WASHER
11/15/01
M.R.C.

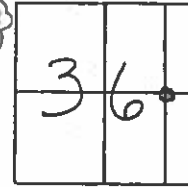

RECORD:

P.I. 684+89.07

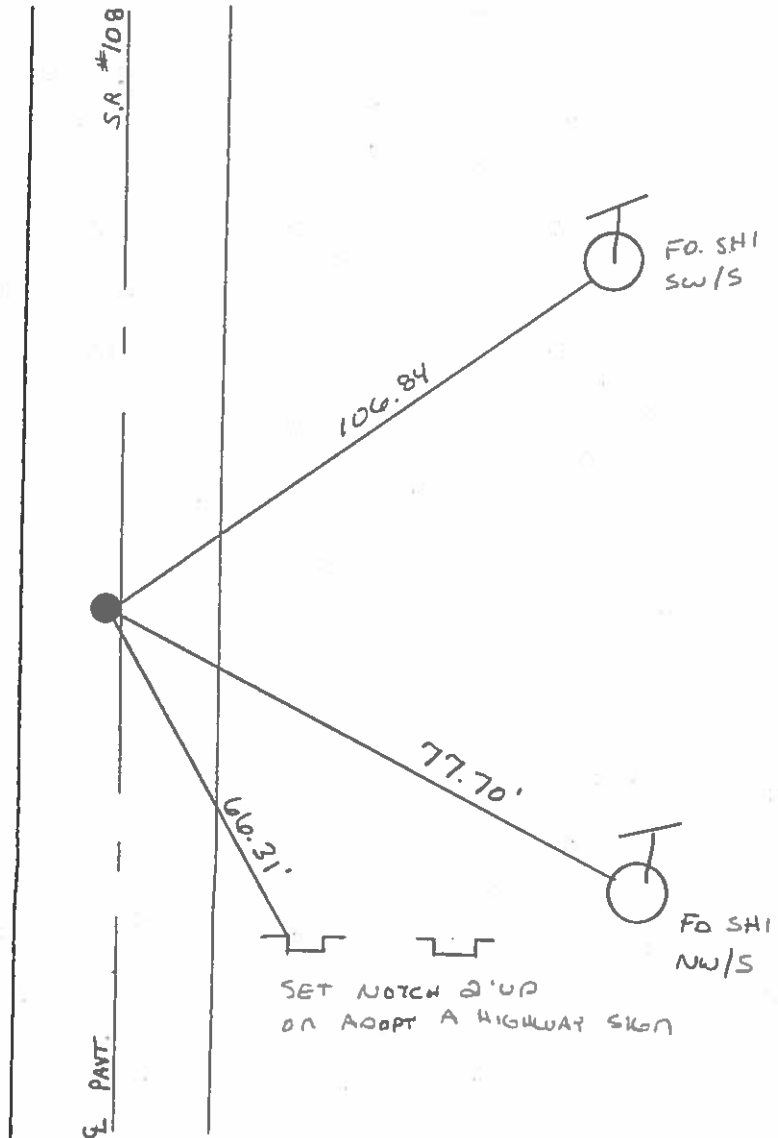

O.D.O.T. DISTRICT 2 SURVEY OFFICE

PERSONNEL

REFERENCE NO. 53

SHEET 4 OF 33

NOTES HOFFMAN

H.C. BARNHISEL

DATE 3-25-88

ROUTE SR 108

R.G. LOSHRELE

WEATHER lt Rain

COUNTY HENRY

REED

TEMP. 60°

TOWNSHIP NAPOLÉON

SECTION 36

T 5 N R 6 E

TYPE MONUMENT SMALL RR SPIKE


ON-SURFACE - BELOW 1 1/2"

LEFT- & PAV'T. - RIGHT 0.9'


10.7 TO LT EDGE PAVEMENT

S.L.M. 684+39

Set small
R.R. SPIKE
5-24-88 SWH

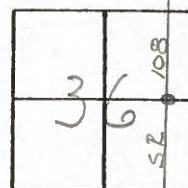

Record:
P.I. 684+89.07

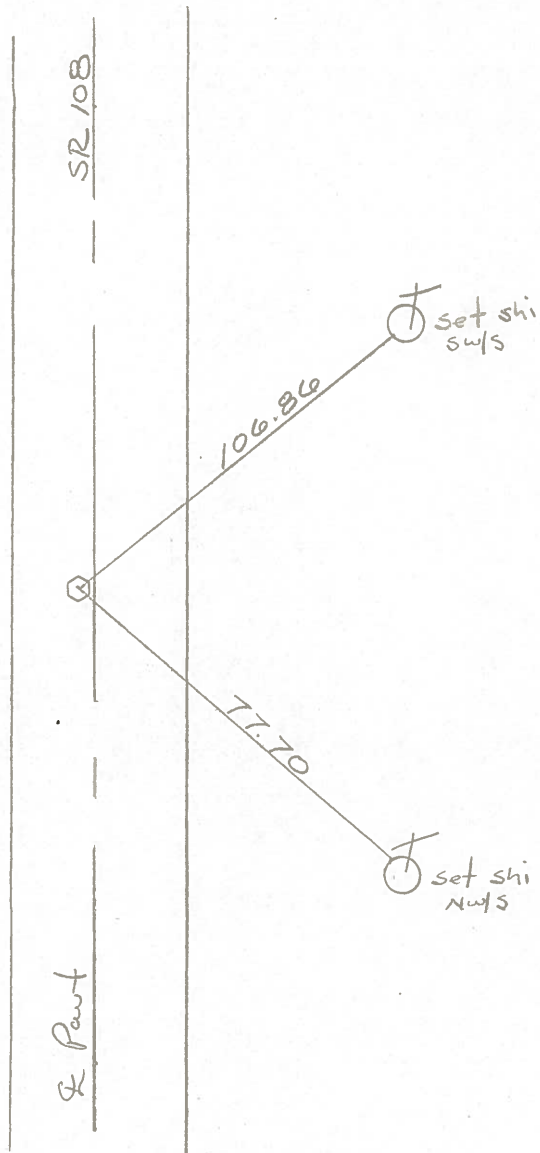

O.D.O.T. DISTRICT 2 SURVEY OFFICE

Sht. 4 of 19
S.R. 108

County HENRY

Date 8-26-77

Township NAPOLEON


Weather CLEAR

Section 36

Temp. +63°

T5N, R6E

Personnel BURNSIDE

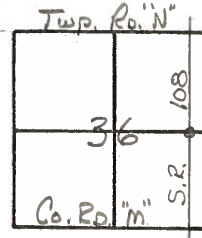


SMITH
BOWERS
KNAPE
MEAD

#53

FD. SMALL R.R. SPK
@ SURFACE ± 1' ±
W. OF CTR. PAVE.

STA. 684+89.07
P.I.

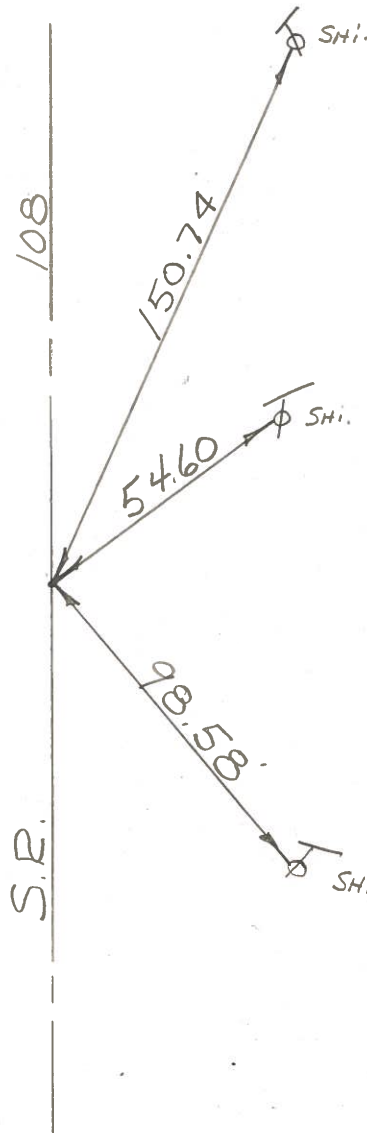


PERSONNEL	TITLE	PERSONNEL	TITLE
TOMSLIC			
Neuser			
Vanyo			
Granata			

COUNTY HENRY DATE July 11, 1974

S. R. 108 WEATHER _____


SEC. Flatrock TWP. TEMP. _____

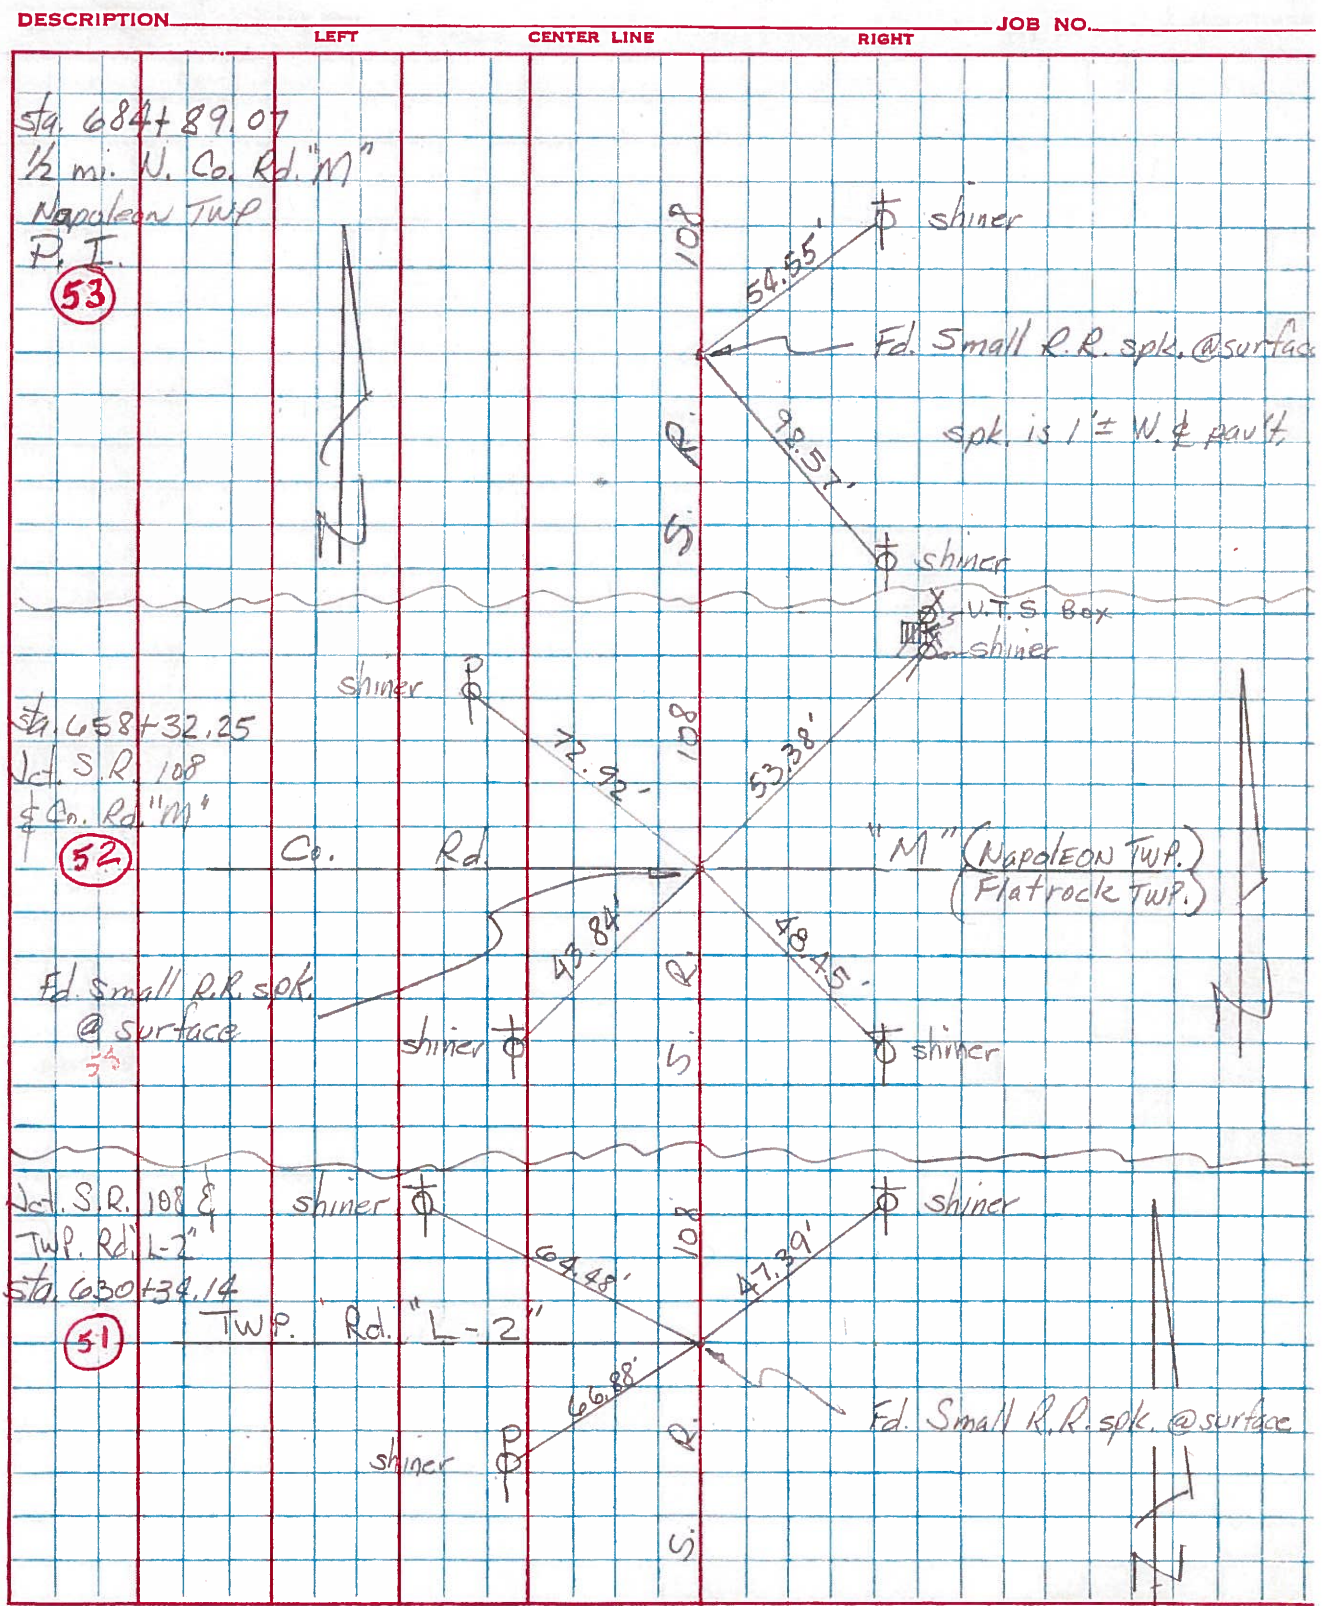


PERSONNEL TITLE PERSONNEL TITLE
 ERIKSEN _____
 RAU _____
 SHAW _____

COUNTY HENRY DATE 11 JUN 71
 S. R. # 108 (1193) WEATHER CLOUDY, RAIN
 SEC. Co Rd L70 N44 TEMP. 75°

DESCRIPTION RE WITNESS TO CONTROL POINTS JOB NO. _____

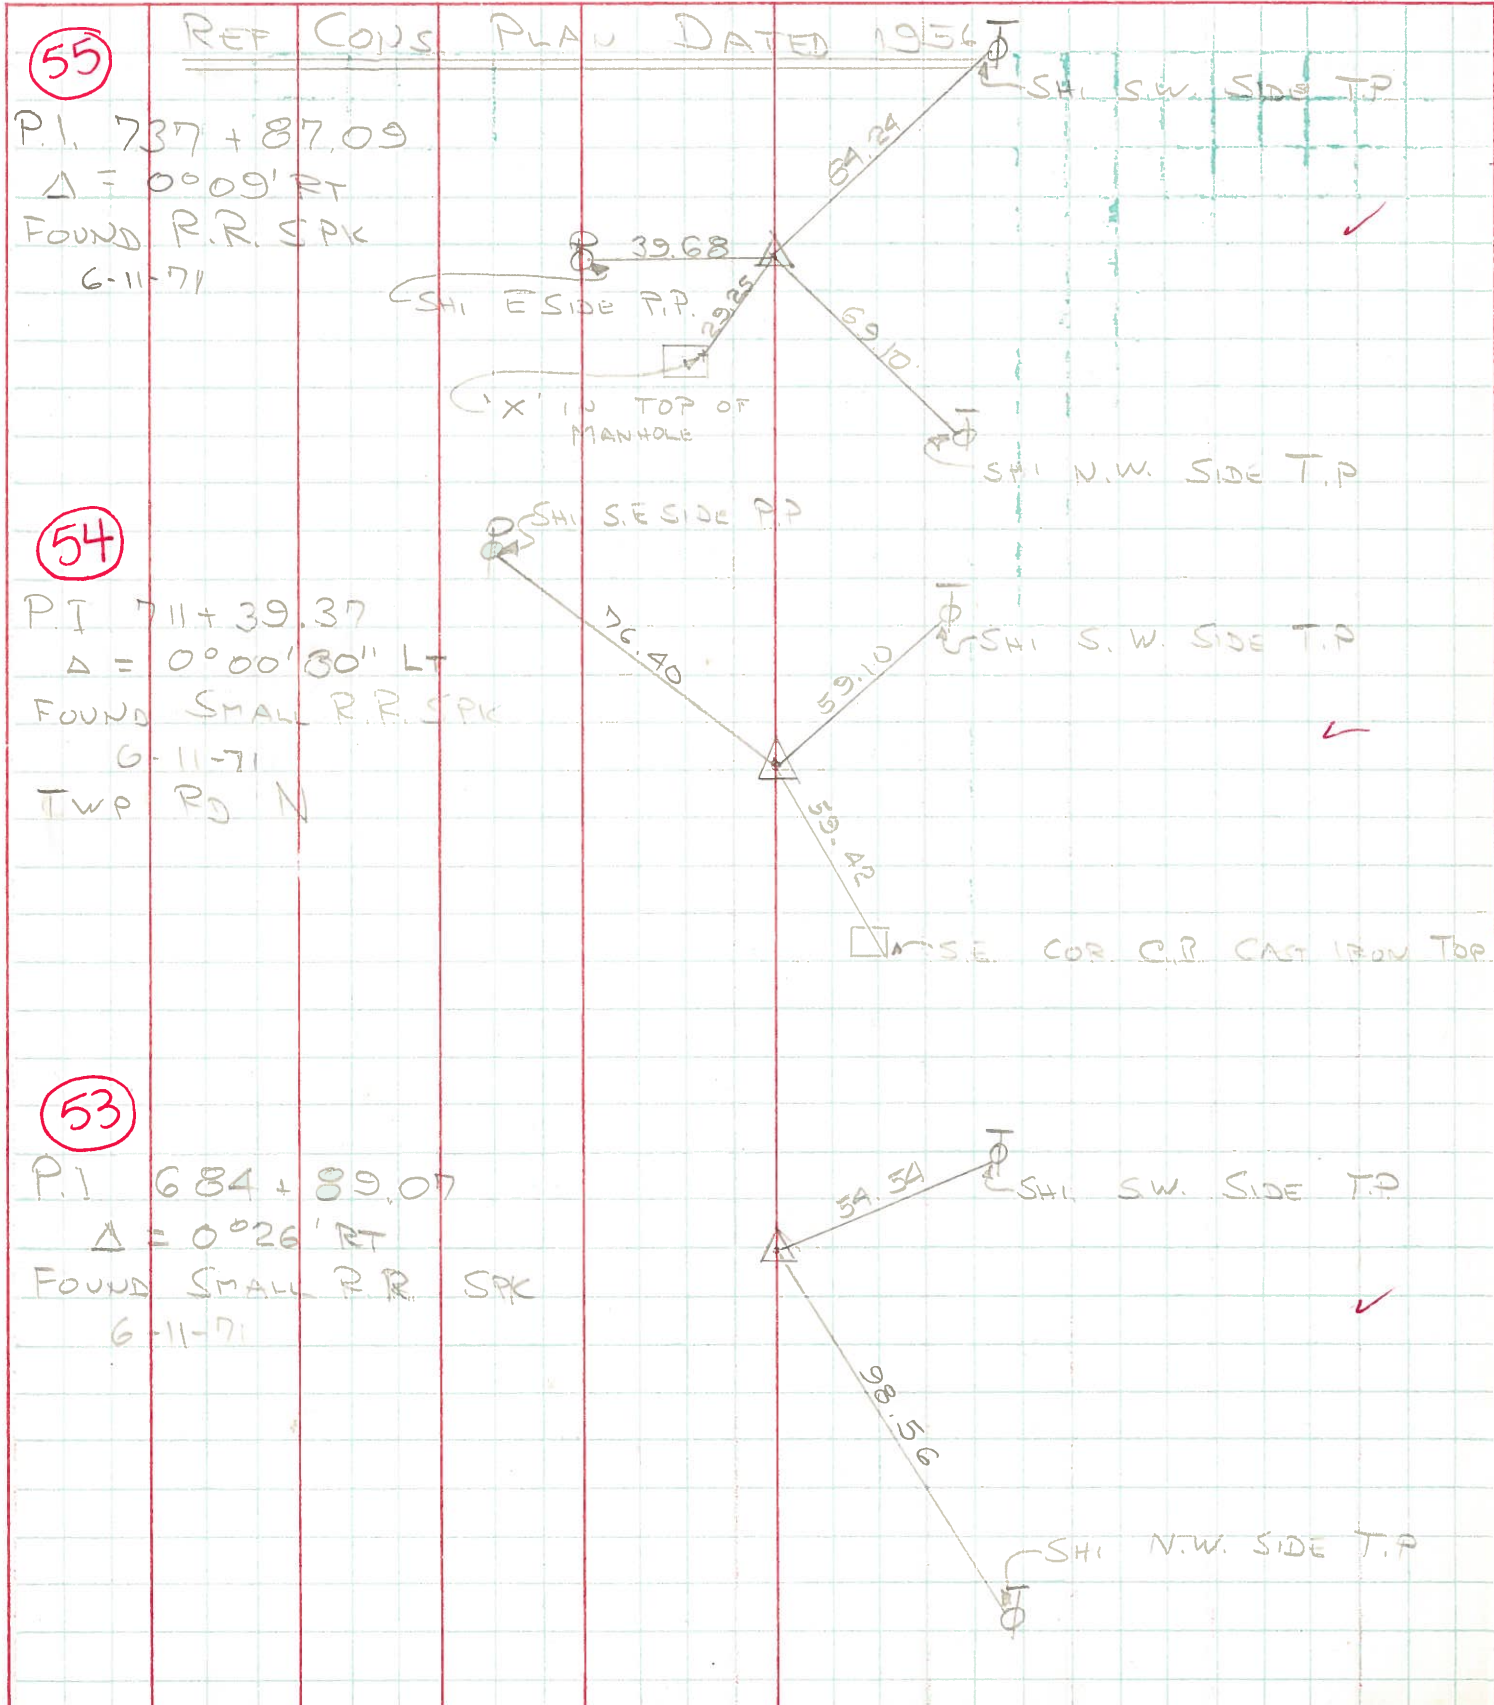


PERSONNEL	TITLE	PERSONNEL	TITLE	COUNTY	DATE
Riuffar				HENRY	11-27-56
Kwarc				S. R. 108	WEATHER Fair
Hoff				SEC.	TEMP. 30
Young					

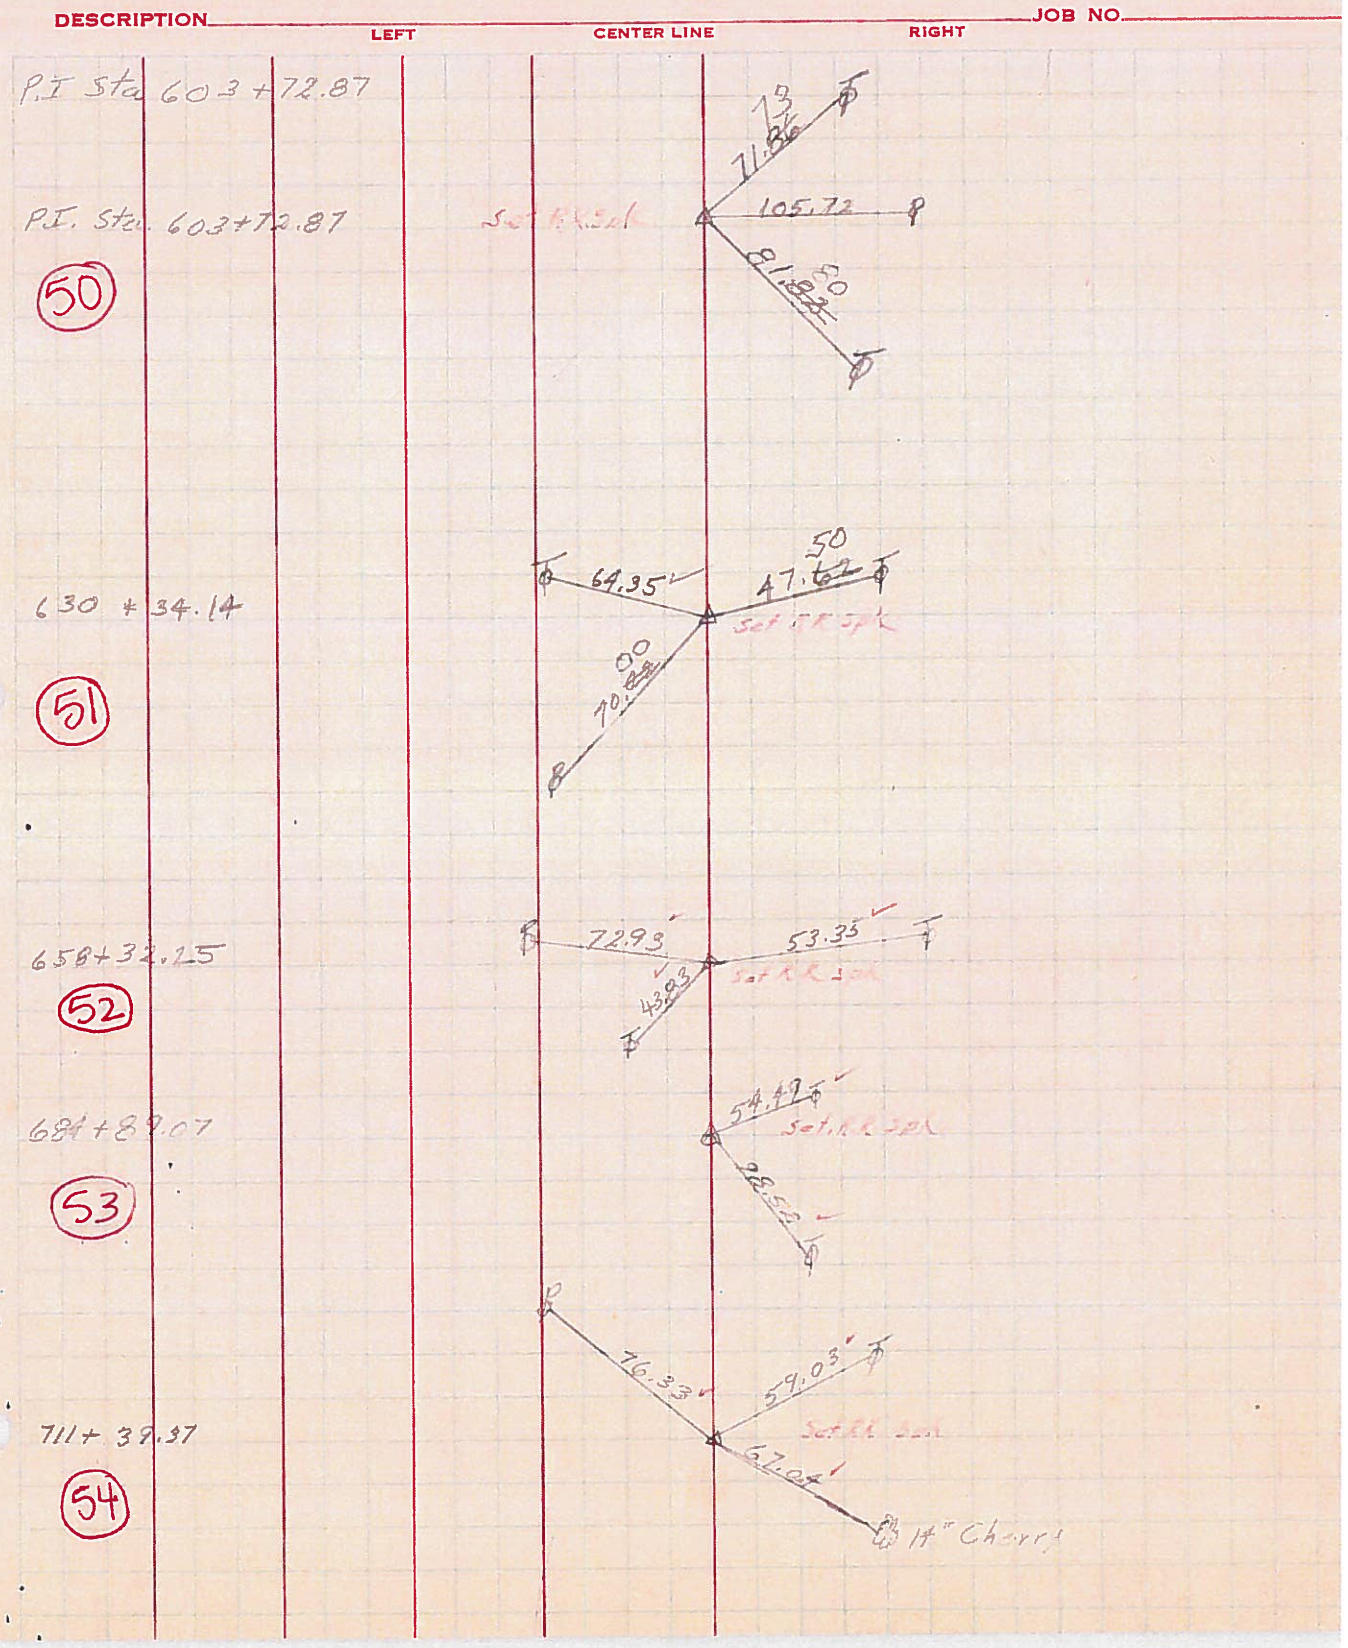

PERSONNEL	TITLE	PERSONNEL	TITLE	COUNTY	DATE
Jamison		Wilkinson		Henry	9-7-56
Burnside		Phillips		S. R. 108	WEATHER Clear
Bacrett				SEC.	TEMP. 70°
Spith					

DESCRIPTION Witness Control Pts. LEFT CENTER LINE RIGHT JOB NO.

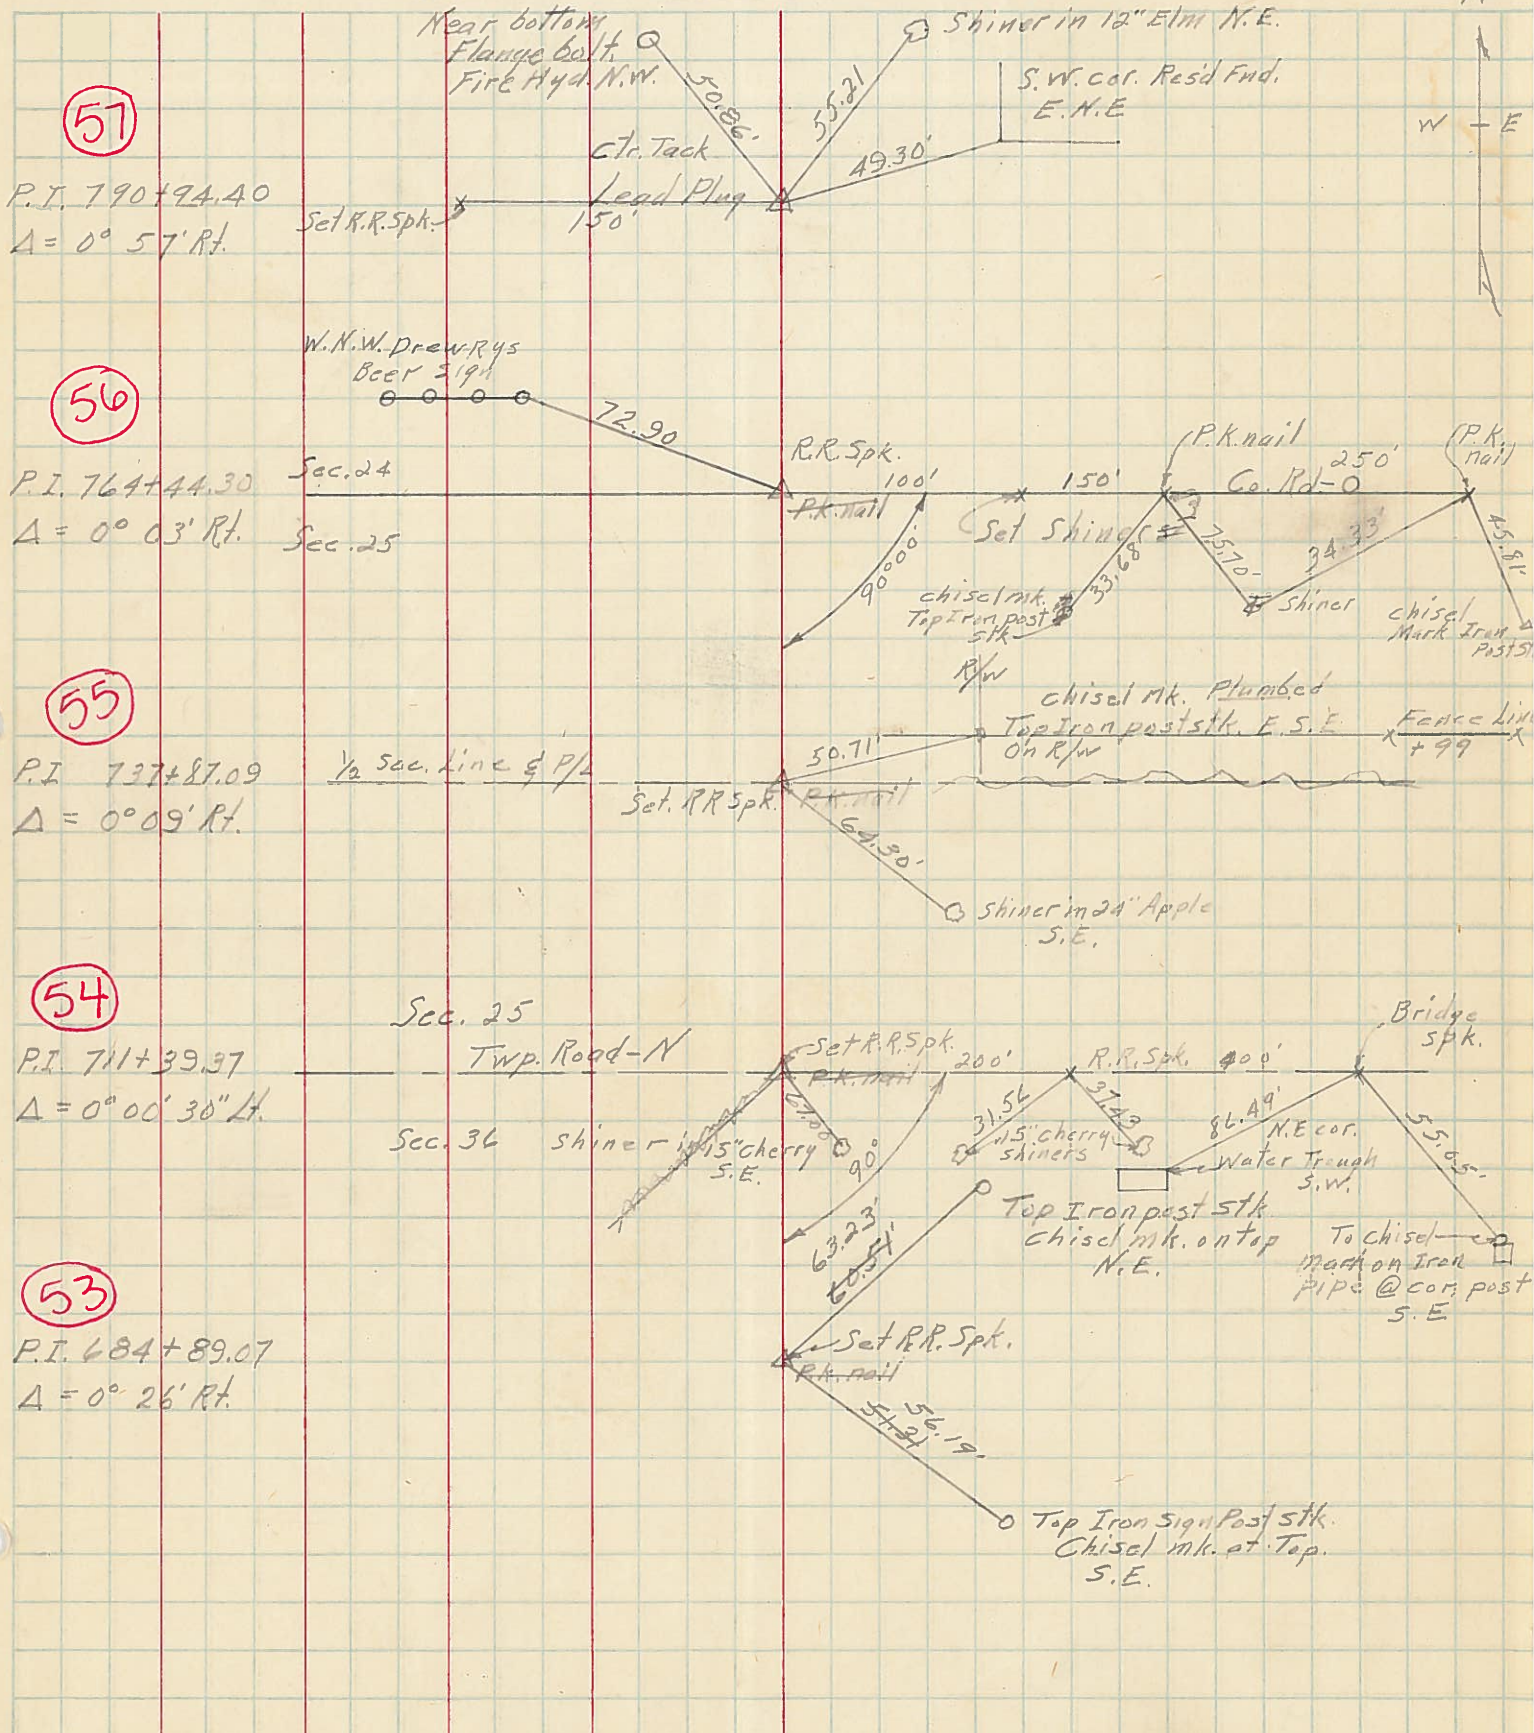

PERSONNEL TITLE PERSONNEL TITLE

Hoover
Latta
Duda

COUNTY He

DATE 2-17-55

S. R. 108

WEATHER _____

SEC. _____

TEMP. _____

DESCRIPTION

P.I.

LEFT

CENTER LINE

RIGHT

JOB NO. _____

53

Sta. 684 + 89.07

41.29 OR Shiner T.P.

91.67

Shiner T.P.

54

Sta. 711 + 39.37

X Face abut.

21.76 N.W.

31.44 N.E. T.P. Shiner

P.K. Nail

17.65 S.W.

X Face abut.

55

Sta. 737 + 37.09

Shiner P.P.

39.96 N.W.

34.41 N.E. Shiner T.P.

P.K. nail

56.64 S.E.

Shiner T.P.