

O.D.O.T. DISTRICT 2 SURVEY OFFICE (USE ONLY)

PERSONNEL _____ REFERENCE NO. 55 SHEET 41 OF 48
 NOTES BALBAUGH DATE 3/12/20 ROUTE SR 108
 H.C. LEU WEATHER OVERCAST COUNTY HENRY
 R.C. BALBAUGH TEMP. 42° TOWNSHIP NAPOLEON
 DWG BY GARRETT PID 94319 SECTION 25
 T 5 N R 6 E

TYPE MONUMENT SM.R.R.SPIKE

~~ON SURFACE~~ - BELOW 3.5"

OFFSET \odot PAVEMENT 0.5' LT : ~~RT~~

12.4' TO LT EDGE PAVEMENT


STATION: 737+63.61

HORZ.DATUM: NAD83 (2011)


GEOID: 2012A

GRID: NORTHING: 622212.193

EASTING: 1523804.330

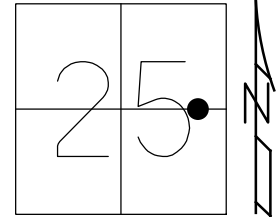

RECORD:
 STA 737+87.09
 $\Delta = 00^\circ 09' RT$
 FD SM.R.R.SPIKE
 8/9/01, MB
 SET P.K./WASHER
 11-13-01, MRC
 FD P.K.NAIL
 11-7-18, JLL
 SET MAG/WASHER
 10-23-20, DSA

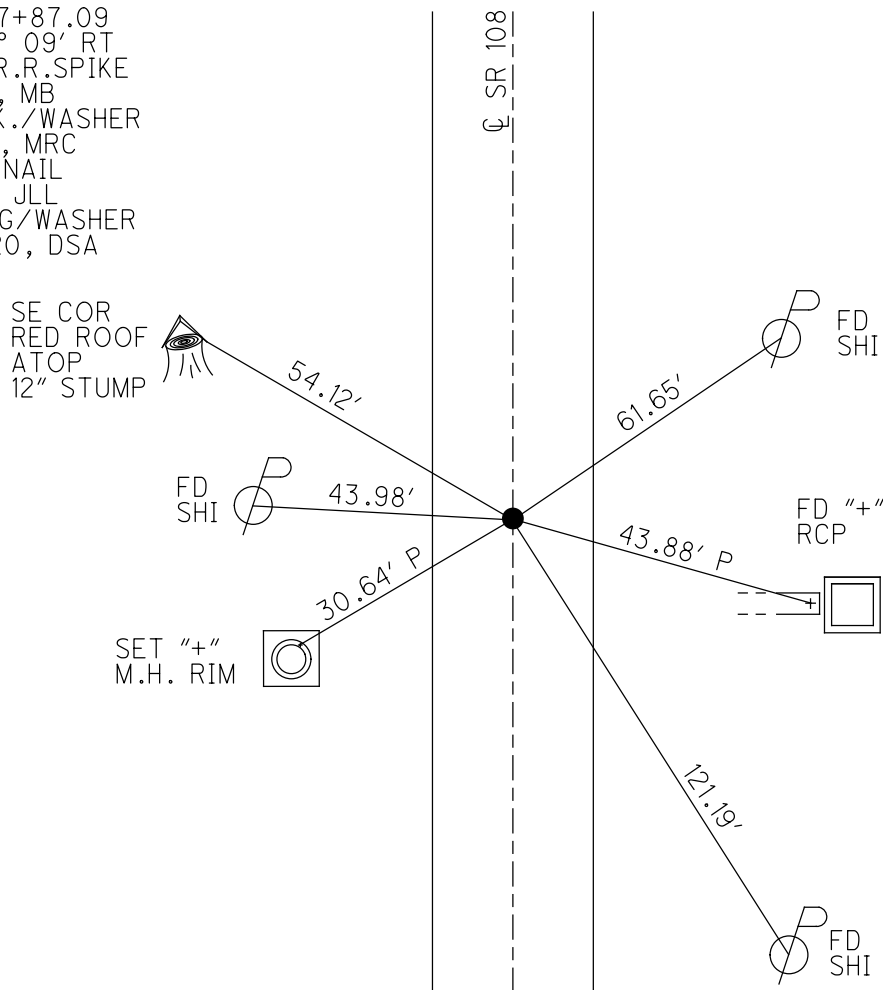

O.D.O.T. DISTRICT 2 SURVEY OFFICE

PERSONNEL

REFERENCE NO. 55

SHEET 6 OF 9

NOTES CAWTERBURY

H.C. BARNHISEL

R.C. MOSEER

DRAGON BY MOSEER

DATE 8-9-01

WEATHER OVERCAST

TEMP. +92°F

ROUTE 108

COUNTY HENRY

TOWNSHIP NAPOLEON

SECTION 25

T 5 N R 6 E


TYPE MONUMENT SMALL R.R. SPIKE

ON SURFACE - ~~BELOW~~ ON


~~12.4~~ - 12.4 TO LT. EDGE PAVEMENT

S.L.M. 737+05

RESET P.W/WASHER
 11/13/01
 M.R.C.

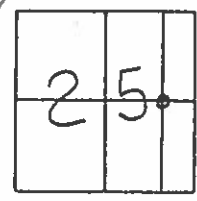

RECORD:
737+87.09

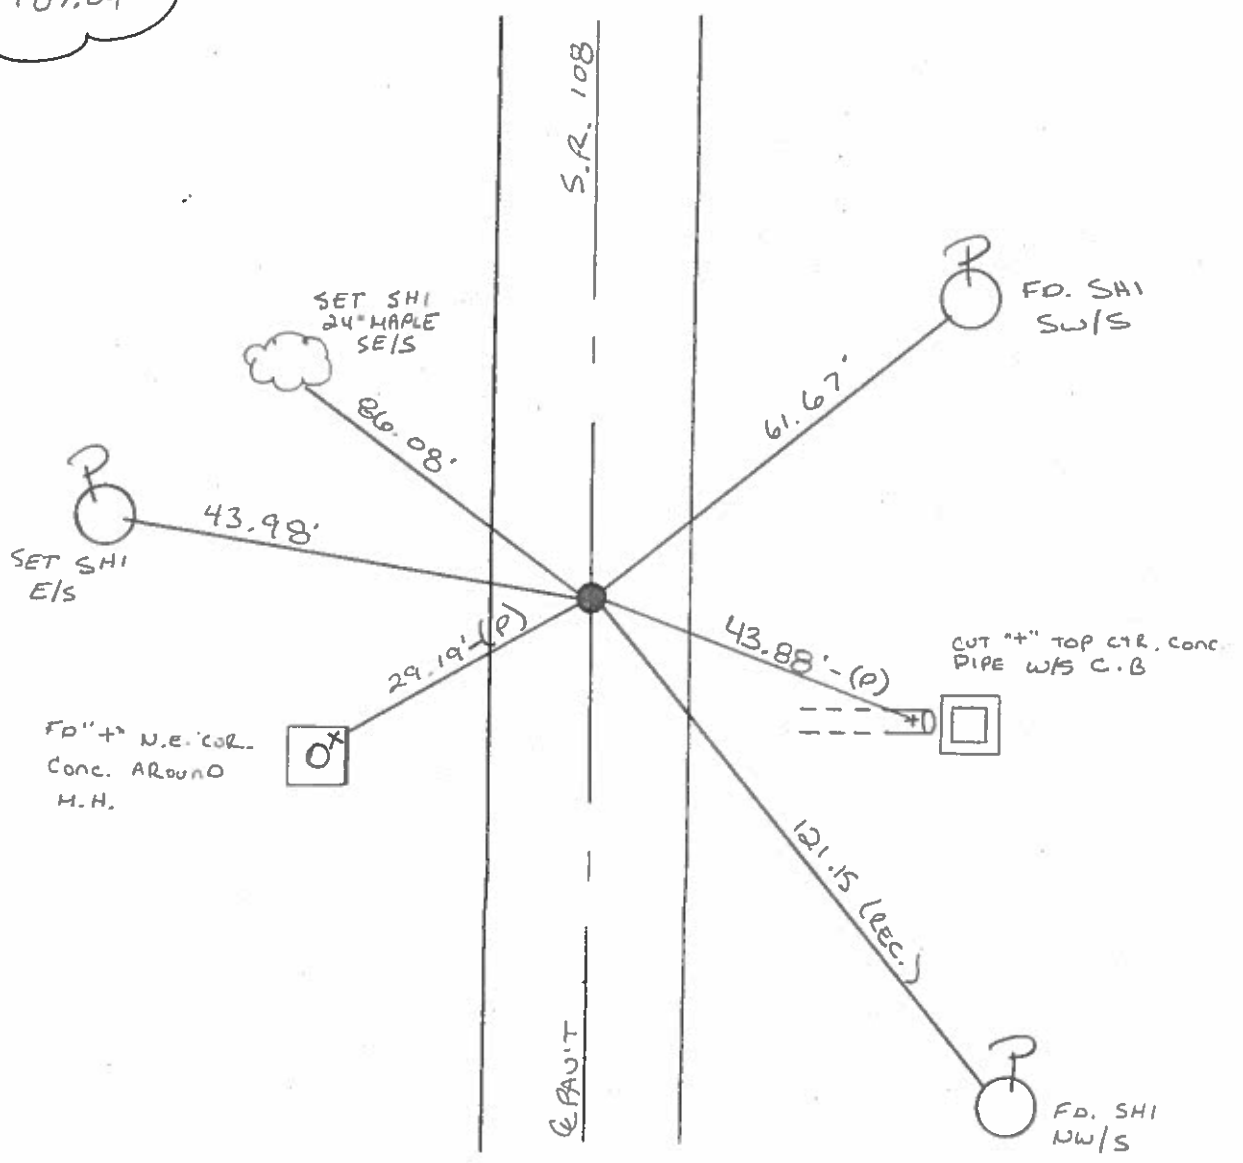

O.D.O.T. DISTRICT 2 SURVEY OFFICE

PERSONNEL

REFERENCE NO. 55

SHEET 6 OF 33

NOTES HOFFMAN

H.C. BAENHISEL

R.C. LOSHRKE

REED

DATE 3-25-88

WEATHER OVERCAST

TEMP. 60°

ROUTE SR 108

COUNTY HENRY

TOWNSHIP NAPOLÉON

SECTION 25

T.S. N.R. 6 E

TYPE MONUMENT R.R. SPIKE


~~ON SURFACE~~ - BELOW 2"

LEFT-☉ PAV'T. - RIGHT 0.5


11.8 TO L+ EDGE PAVEMENT

S.L.M. 737+35

Set SMALL
RR SPIKE
5-29-88. SWK

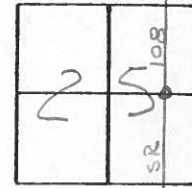

Record!
737+87.09

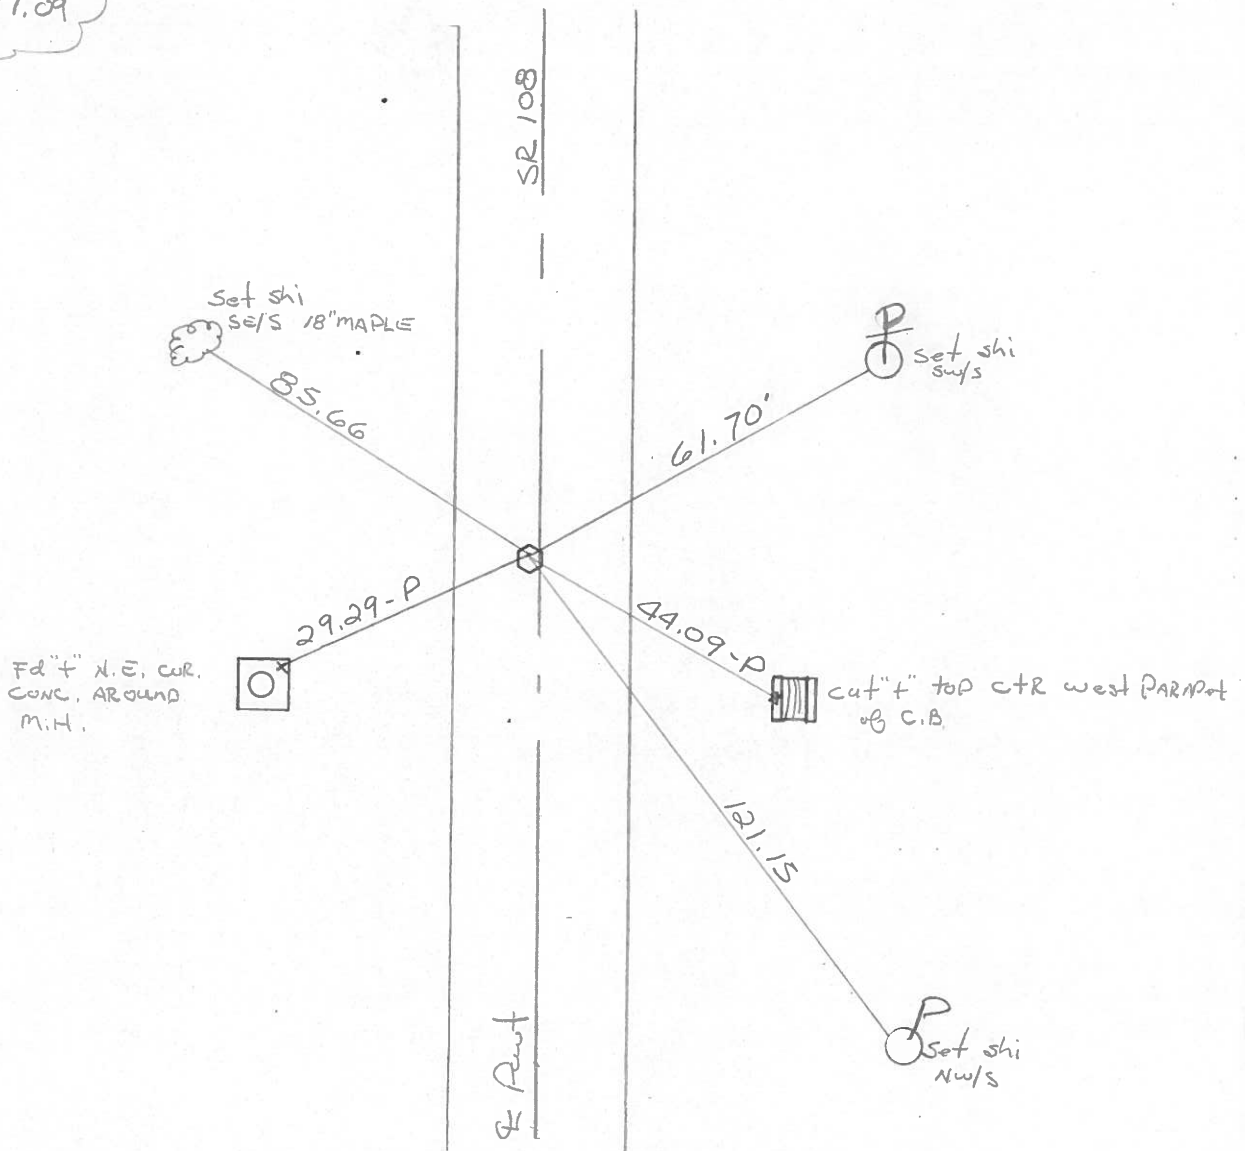

ODOT. DISTRICT 2 SURVEY OFFICE

Sht. 6 of 19
S.R.108

County HENRY

Date 8-26-77

Township NAPOLEON


Weather CLEAR

Section 25

Temp. +65°

T5N, R6E

Personnel BURNSIDE

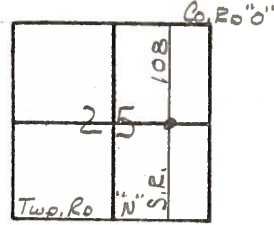

SMITH

BOWERS


KNAPE

MEAD

#55

FD. R.R. SPK. @ SURFACE
& IN CTR. PAVE.


STA. 737+87.09

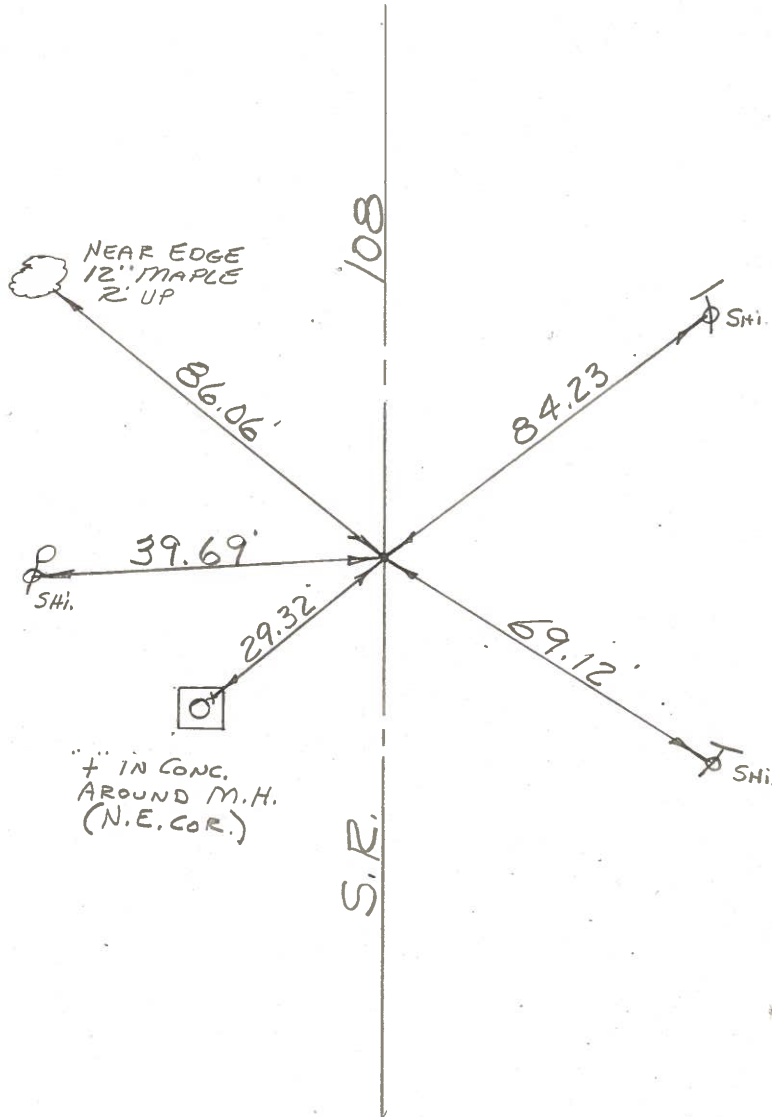

+ IN CONC.
AROUND M.H.
(N.E. COR.)


PERSONNEL	TITLE	PERSONNEL	TITLE	COUNTY	DATE
Tomsic				HENRY	July 12, 1974
Neuser				S. R. 108	WEATHER
Van yo				SEC. Napoleon TWP.	TEMP.
Granato					

DESCRIPTION	LEFT	CENTER LINE	RIGHT	JOB NO.
-------------	------	-------------	-------	---------

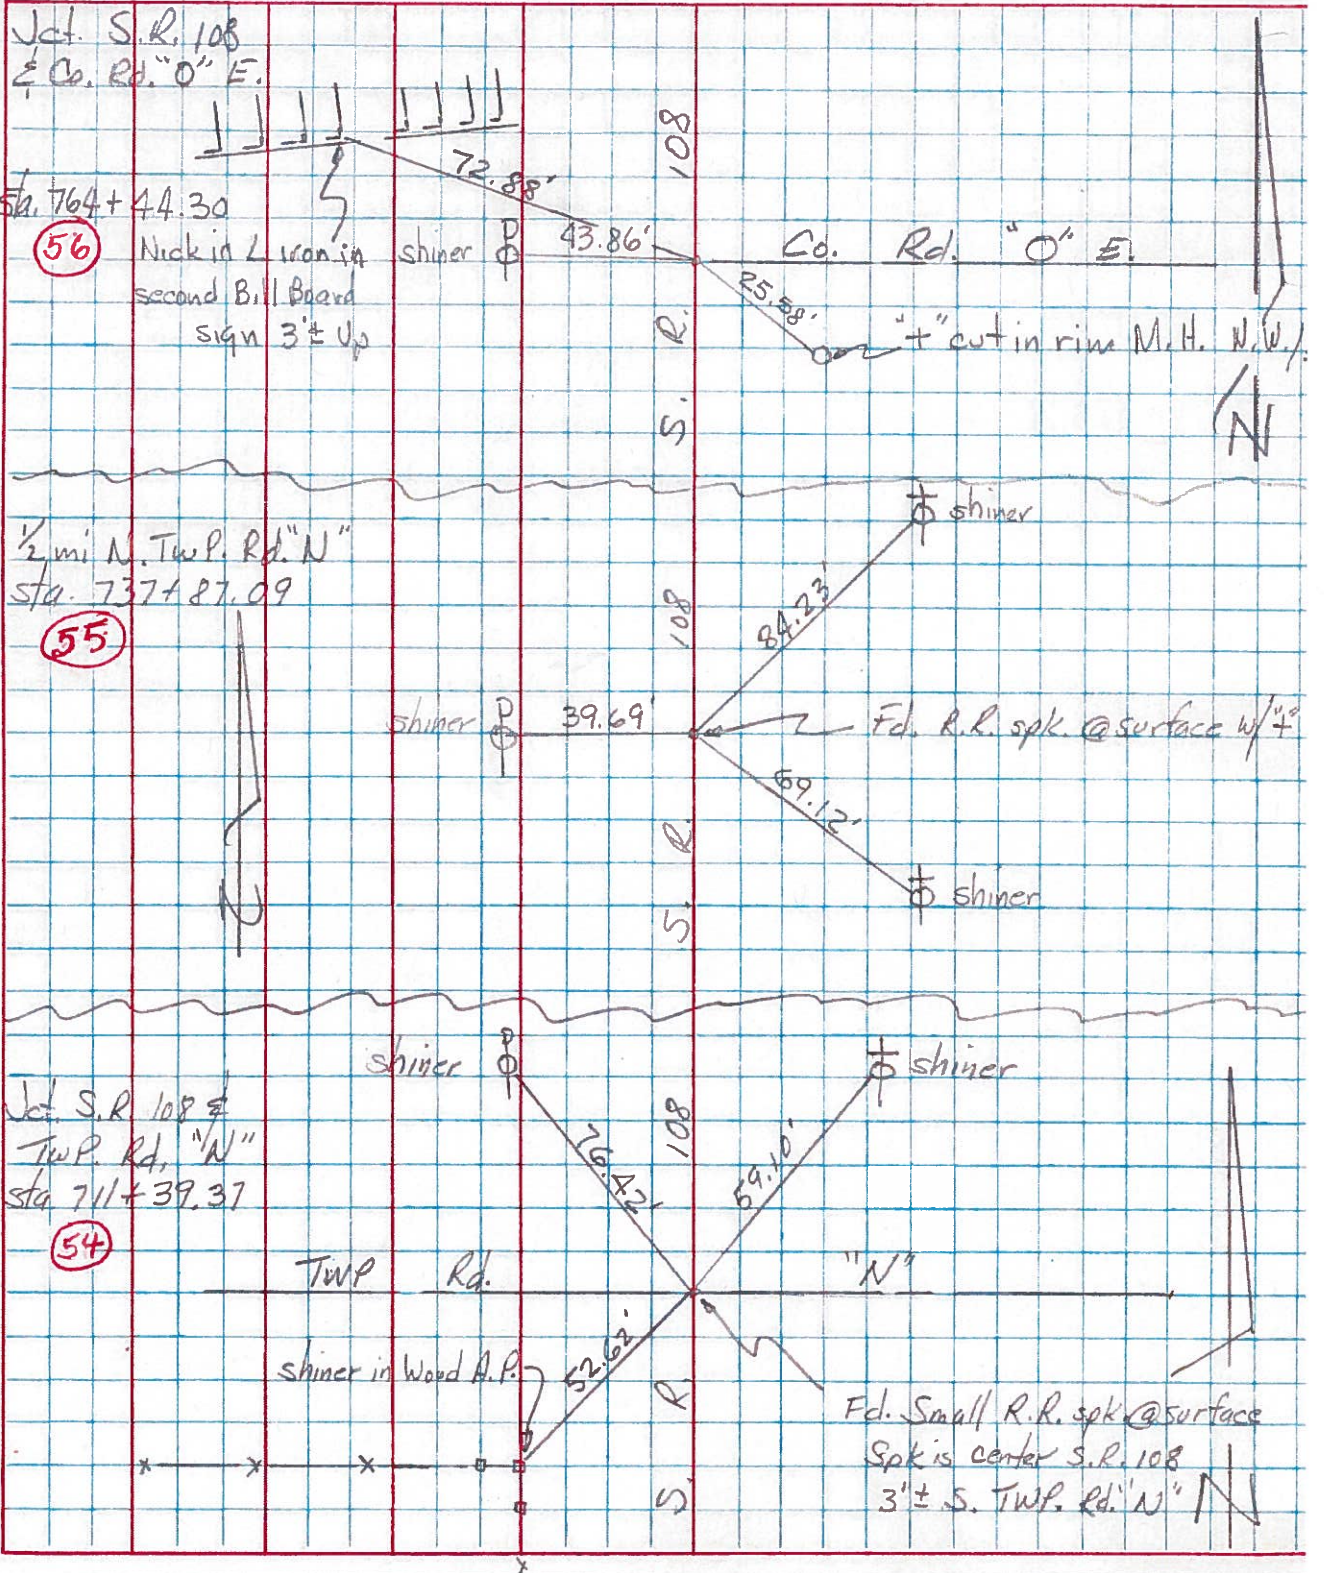

PERSONNEL ERIKSEN TITLE _____ PERSONNEL _____ TITLE _____ COUNTY HENRY DATE 11 JUN 71
RAU _____ _____ _____ S. R. # 108 (11.93) WEATHER CLOUDY, R
SHAW _____ _____ _____ SEC. Co Rd Ltn NAF TEMP. 75°

DESCRIPTION RE WITNESS TO CONTROL POINTS JOB NO. _____

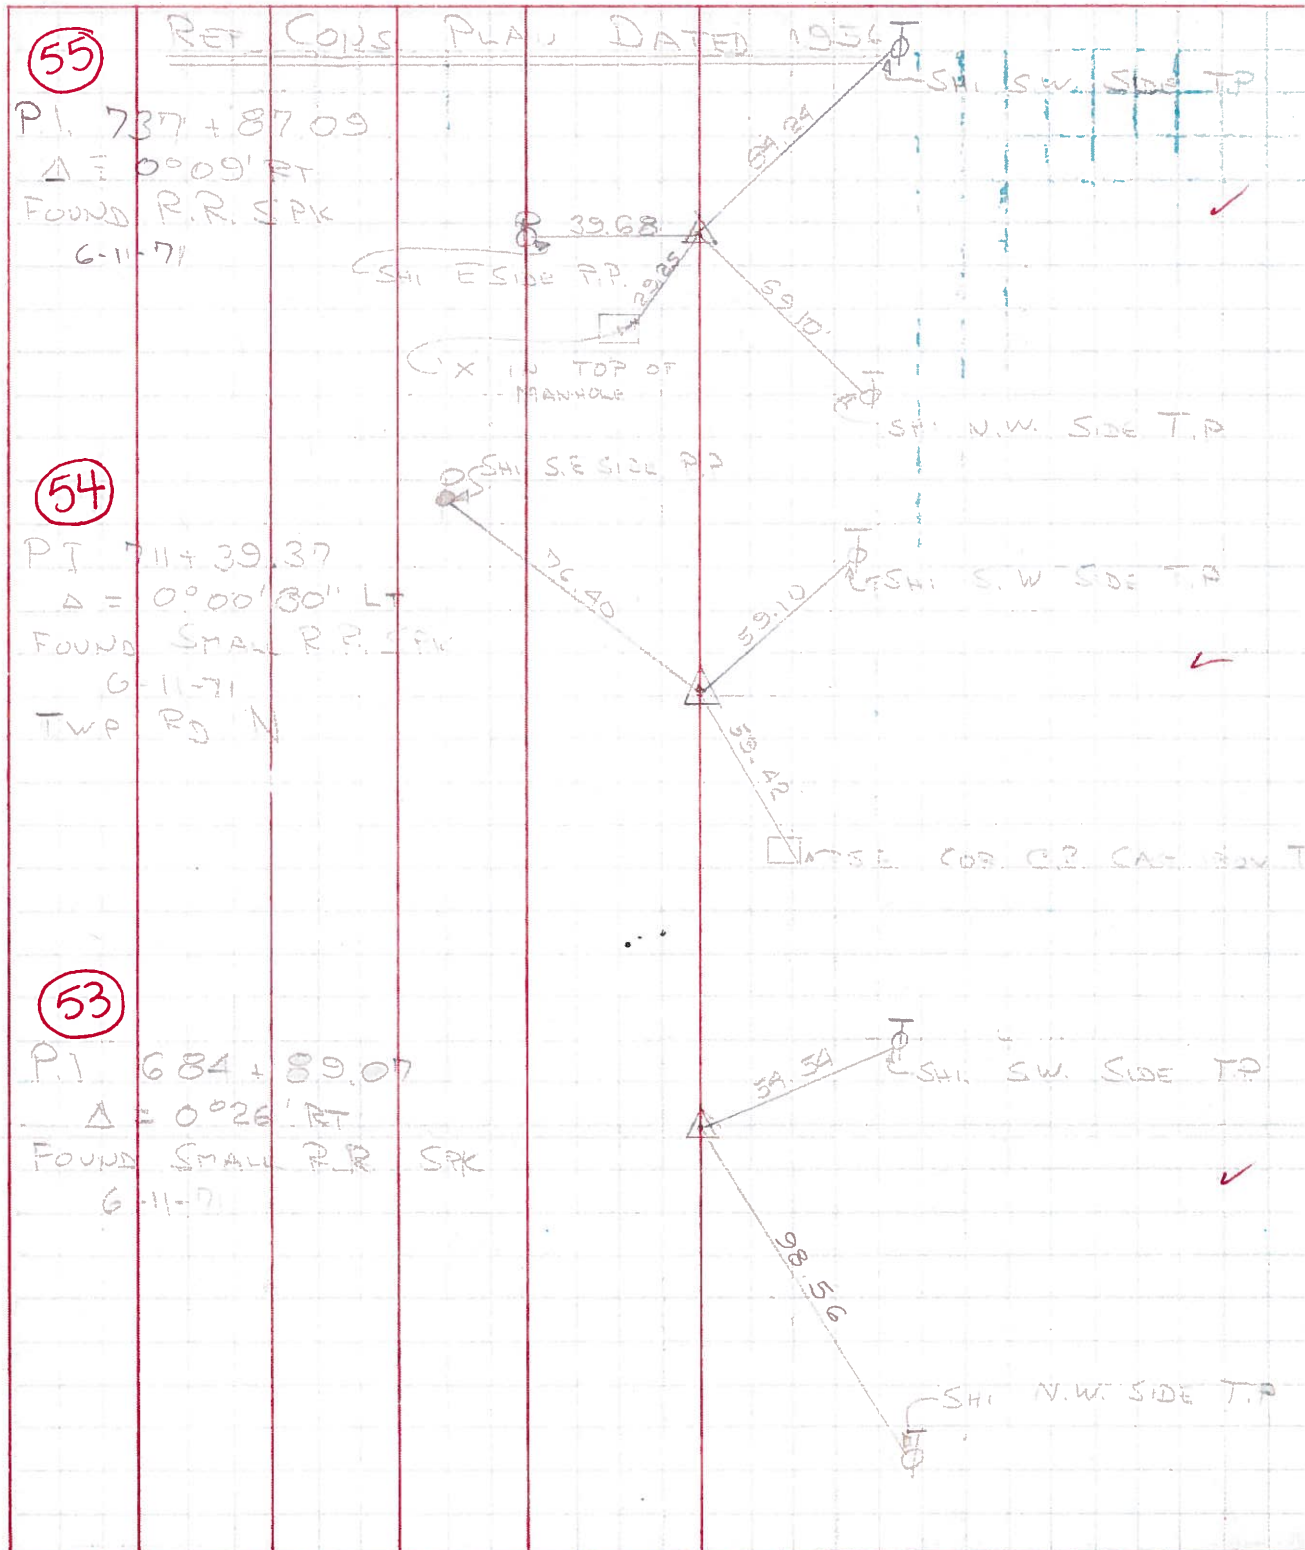

PERSONNEL	TITLE	PERSONNEL	TITLE	COUNTY	DATE	WEATHER	TEMP.
Ruffer				Henry	11-26-56	Fair	35
Knape				108			
Hoff							
Young							

DESCRIPTION _____ LEFT _____ CENTER LINE _____ RIGHT _____ JOB NO. _____

55


737 + 87.09

56

764 + 47.30


57

790 + 94.40

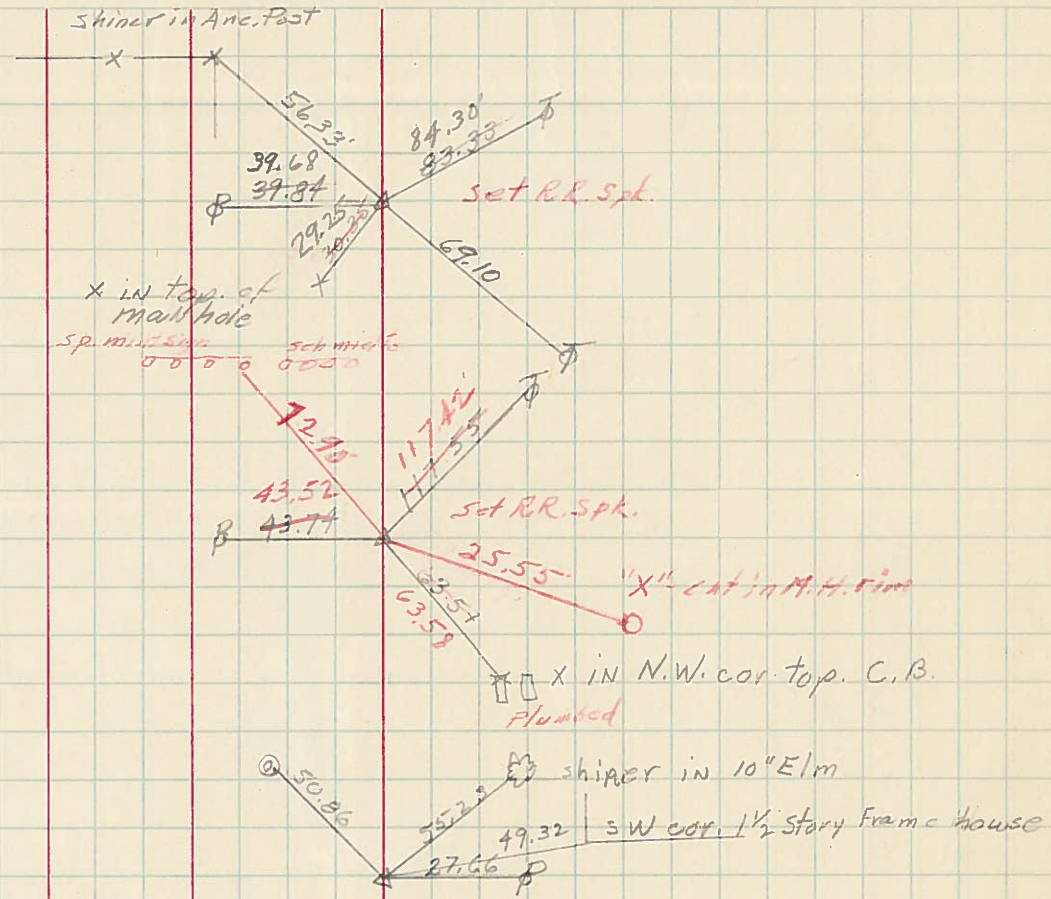

PERSONNEL	TITLE	PERSONNEL	TITLE	COUNTY	DATE
Jamison		Wilkinson		Henry	9-7-56
Burnside		Phillips		S. R. 108	WEATHER clear
Bozett				SEC.	TEMP. 70°
Smith					

DESCRIPTION Witness Central Pts JOB NO. _____

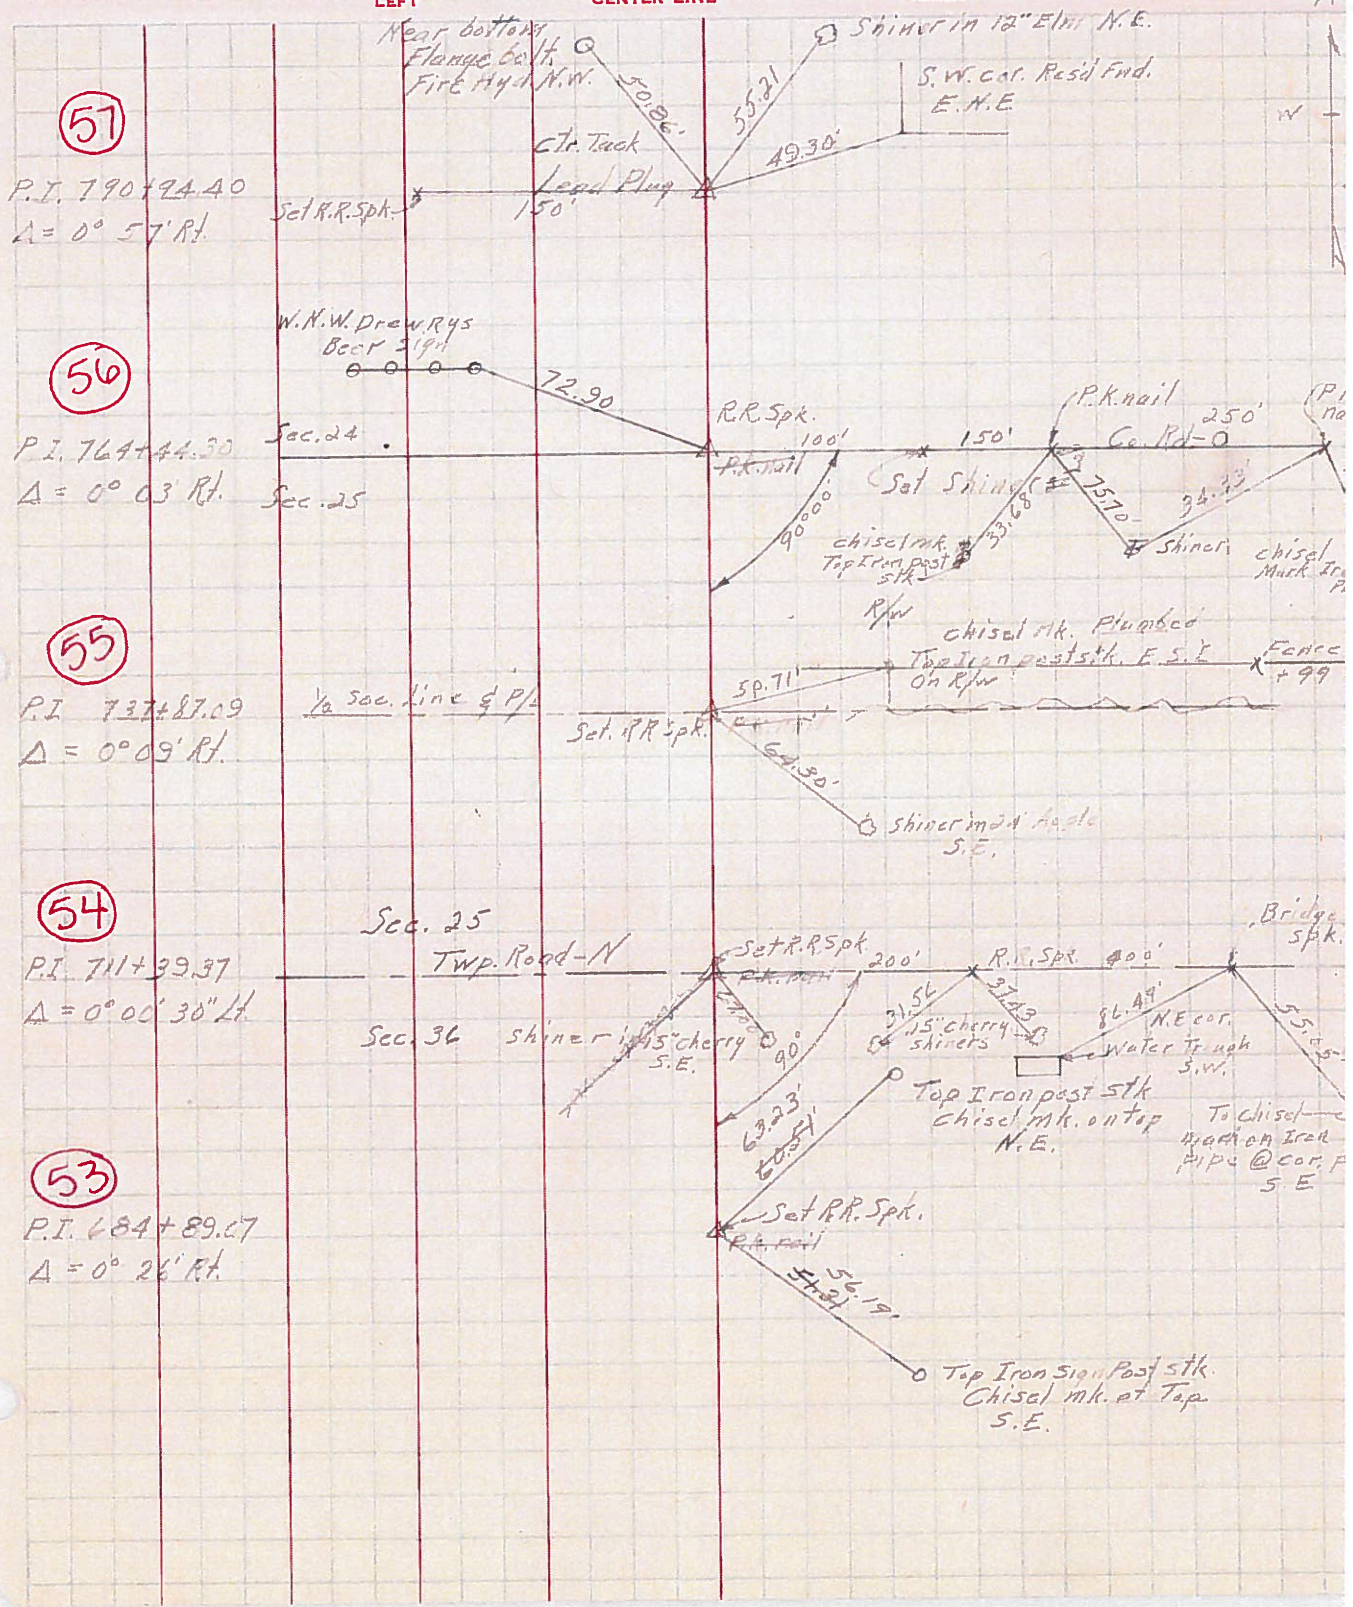

PERSONNEL TITLE PERSONNEL TITLE


Lougs
Dunn
Muhler
Rafter

COUNTY He DATE 3-31-55

S. R. 108 WEATHER

SEC. _____ TEMP. _____

DESCRIPTION LEFT CENTER LINE RIGHT JOB NO.

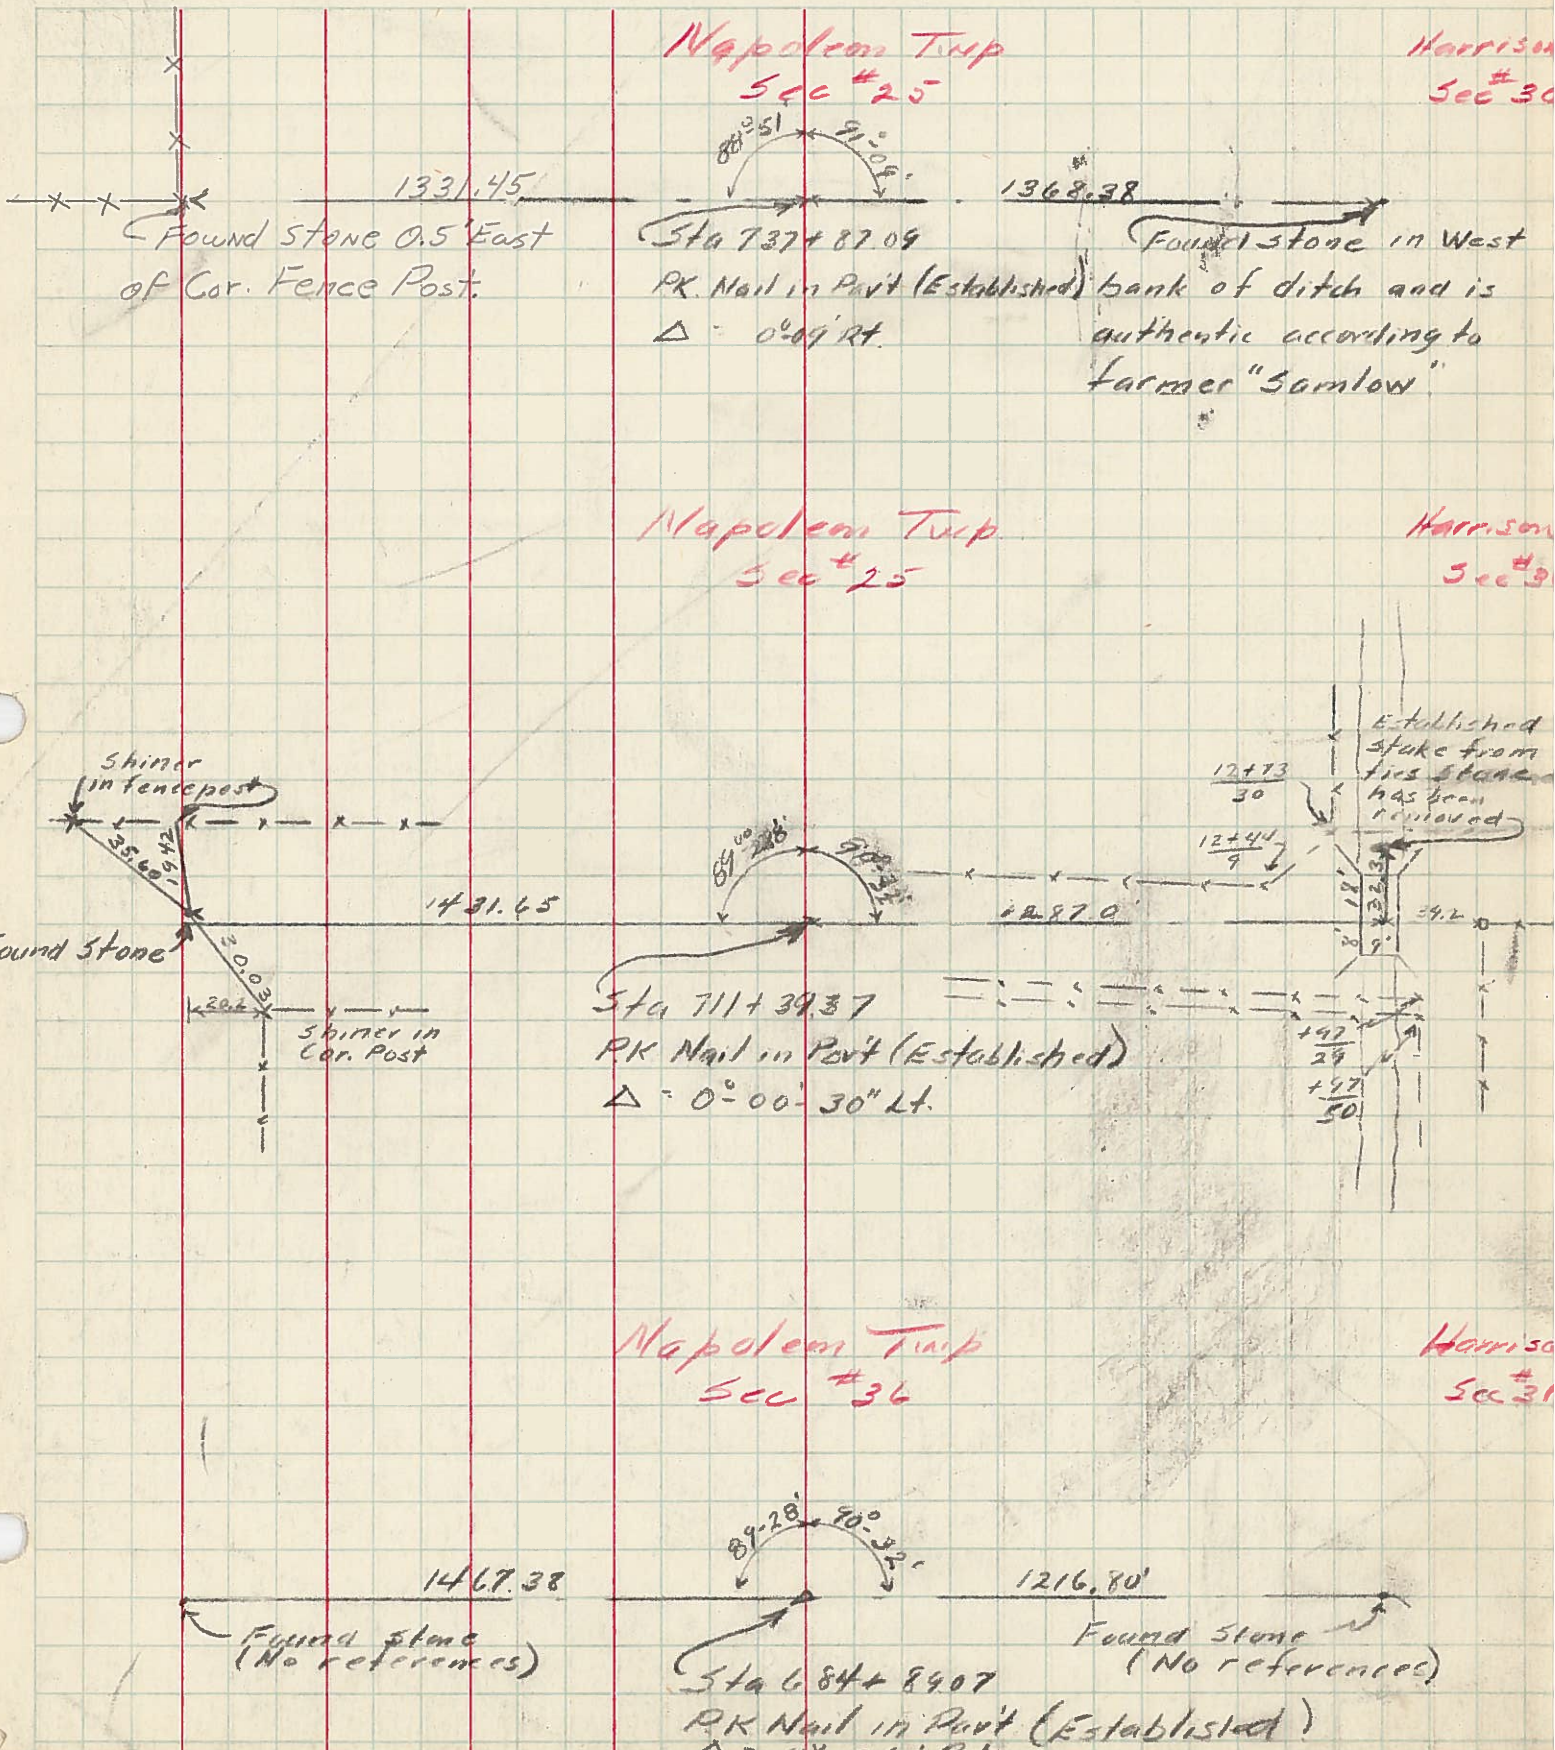

PERSONNEL TITLE PERSONNEL TITLE
 Hoover _____
 Latta _____
 Duda _____


COUNTY He DATE 2-17-55

S. R. 108 WEATHER _____


SEC. _____ TEMP. _____

DESCRIPTION P.I. LEFT CENTER LINE RIGHT JOB NO.

53

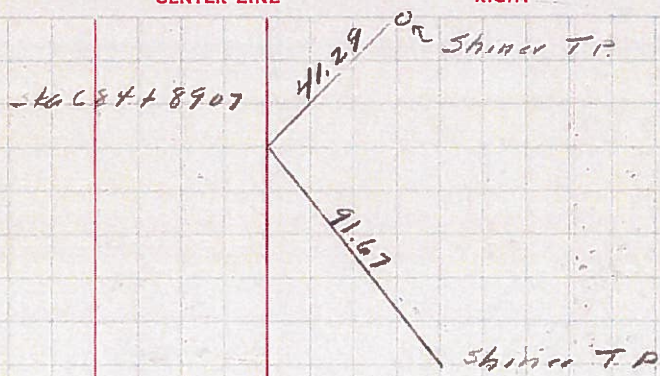

54

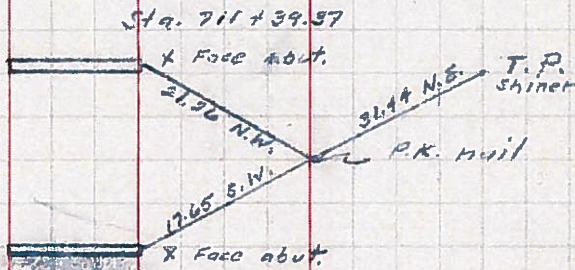

55

