

O.D.O.T. DISTRICT 2 SURVEY OFFICE (USE ONLY)

PERSONNEL _____ REFERENCE NO. 56 SHEET 42 OF 48
 NOTES BALBAUGH DATE 3/19/20 ROUTE SR 108
 H.C. LEU WEATHER OVERCAST COUNTY HENRY
 R.C. BALBAUGH TEMP. 46° TOWNSHIP NAPOLEON
 DWG BY GARRETT PID 94319 SECTION 25
 T 5 N R 6 E

TYPE MONUMENT SM.R.R.SPIKE


~~ON SURFACE~~ - BELOW 3"

OFFSET \varnothing PAVEMENT ON LT : RT
12.5' TO LT EDGE PAVEMENT

STATION: 764+20.87


HORZ.DATUM: NAD83 (2011) GEOID: 2012A

GRID: NORTHING: 624869.407 EASTING: 1523785.920

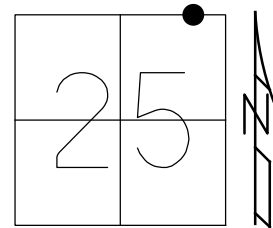

RECORD:
 STA 764+44.30'
 $\Delta=00^{\circ}-03'$ RT
 RESET PK/WASHER
 11-13-01, MRC
 FD LG R.R. SPIKE
 3" BELOW
 REF56
 $\Delta=00^{\circ}03'35''$ RT
 11-7-18, JLL
 SET MAG/WASHER
 10-23-20, DSA

FD NOTCH
 IRON LEG
 SECOND SIGN

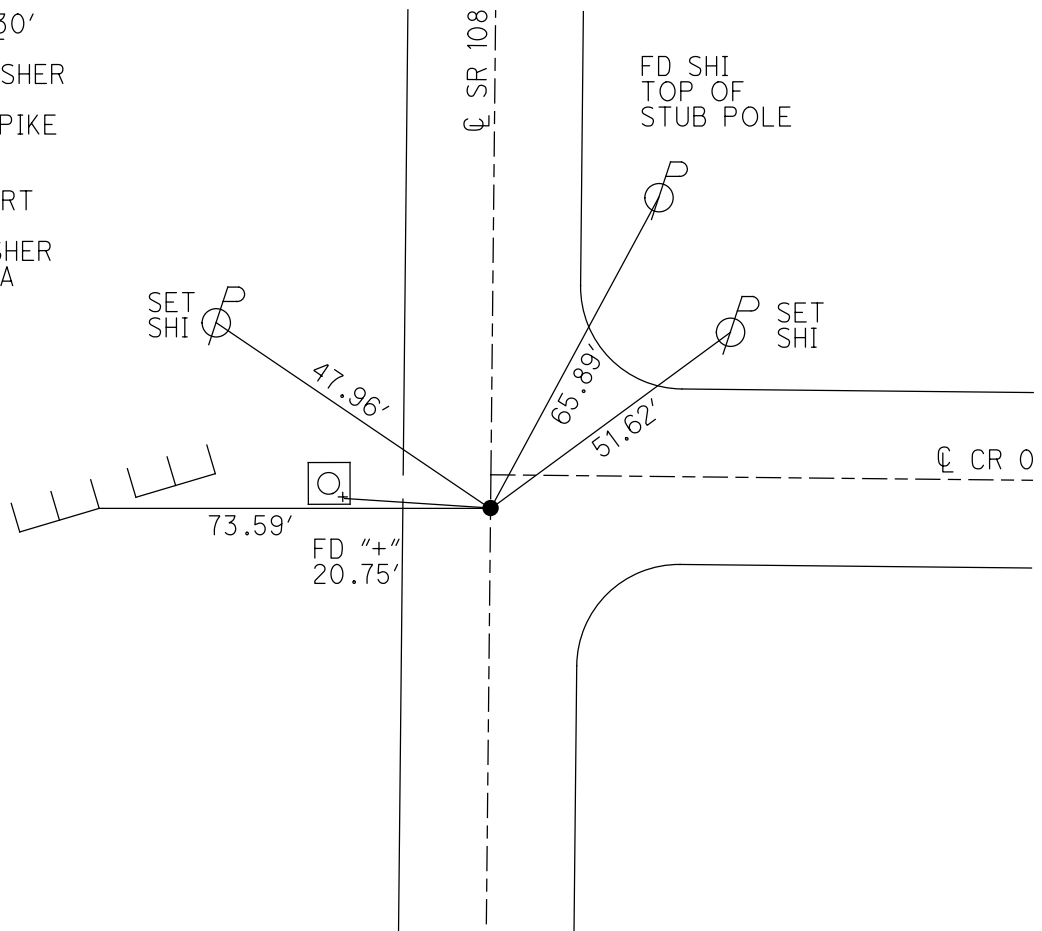

O.D.O.T. DISTRICT 2 SURVEY OFFICE

PERSONNEL

REFERENCE NO. 56

SHEET 7 OF 9

NOTES CANTERBURY

H.C. BARNHISEL

DATE 8-9-01

ROUTE 108

R.C. MOSE

WEATHER OVERCAST

COUNTY HENRY

DRAWN BY: MOSE

TEMP. +92°F

TOWNSHIP NAPOLEON

SECTION 25

T S N R 6 E

TYPE MONUMENT SMALL R.R. SPIKE


ON SURFACE - ~~BELOW~~ ON

RESET P.R./WASHER
11/13/01
M.R.C.


~~12.5~~ - CL PAVT. - ~~RIGHT~~ CL S.R. 108 / 25' S. OF CL OF CRE

12.5 TO LT. EDGE PAVEMENT

S.L.M. 763 + 70

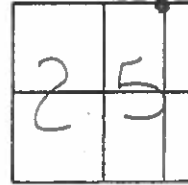

RECORD:
764 + 44.30

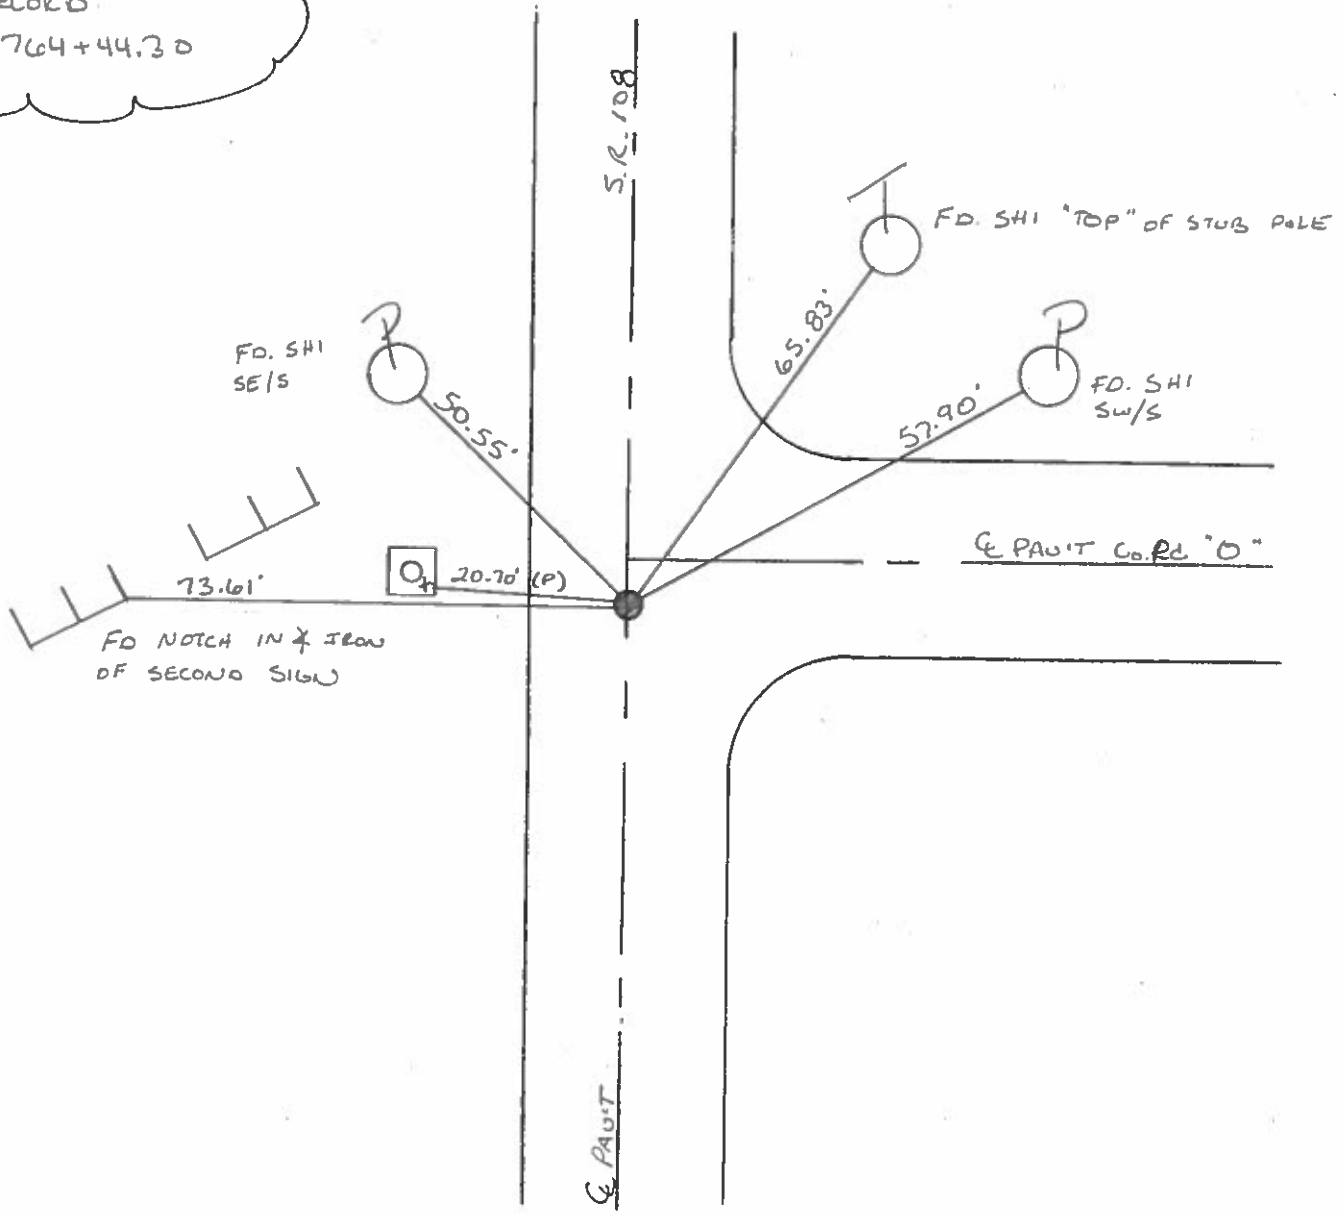

O.D.O.T. DISTRICT 2 SURVEY OFFICE

PERSONNEL

REFERENCE NO. 56

SHEET 7 OF 33

NOTES HOFFMAN

H.C. BARNHISEL

R.C. LOEHRKE

REED

DATE 3-25-88

WEATHER OVERCAST

TEMP. 60°

ROUTE SR 108

COUNTY HENRY

TOWNSHIP NAPOLEON

SECTION 25

T 5 N R 6 E

TYPE MONUMENT R.R. SPIKE


ON SURFACE - BELOW 2"

LEFT- & PAW'T. - RIGHT YES


11.9 TO LT EDGE PAVEMENT 2.2' S. of & Part East

S.L.M. 763 + 93

Set SMALL
R.R. SPIKE
5-24-88 SWH

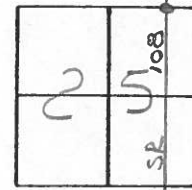

Record!
764 + 44.30

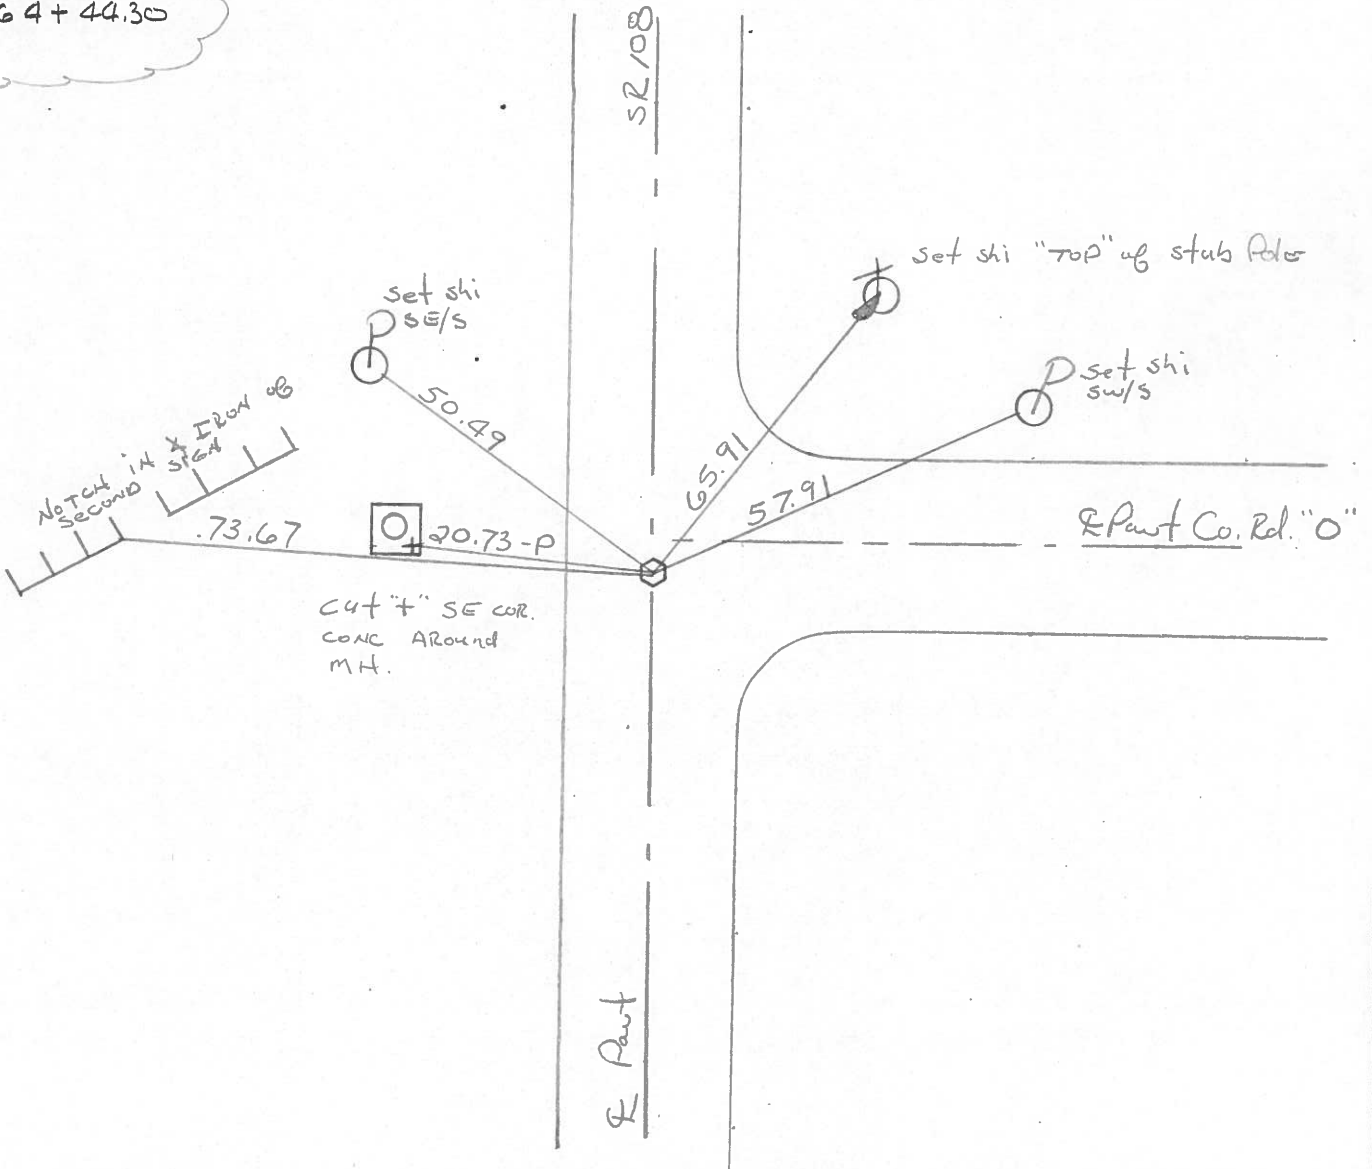

OD.O.T. DISTRICT 2 SURVEY OFFICE

Sht. 7 of 19
S.R. 108

County HENRY

Date 8-26-77

Township NAPOLEON


Weather CLEAR

Section 25

Temp. +68°

T5N, R6E

Personnel BURNSIDE

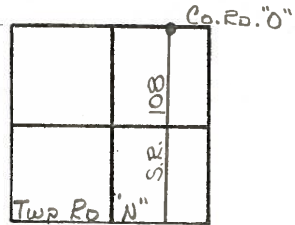


SMITH
BOWERS
KNAPE
MEAD

#56


FD. R.R. SPK. @ SURFACE
#6" ± W. OF CTR. PAVE.

STA. 764+44.30

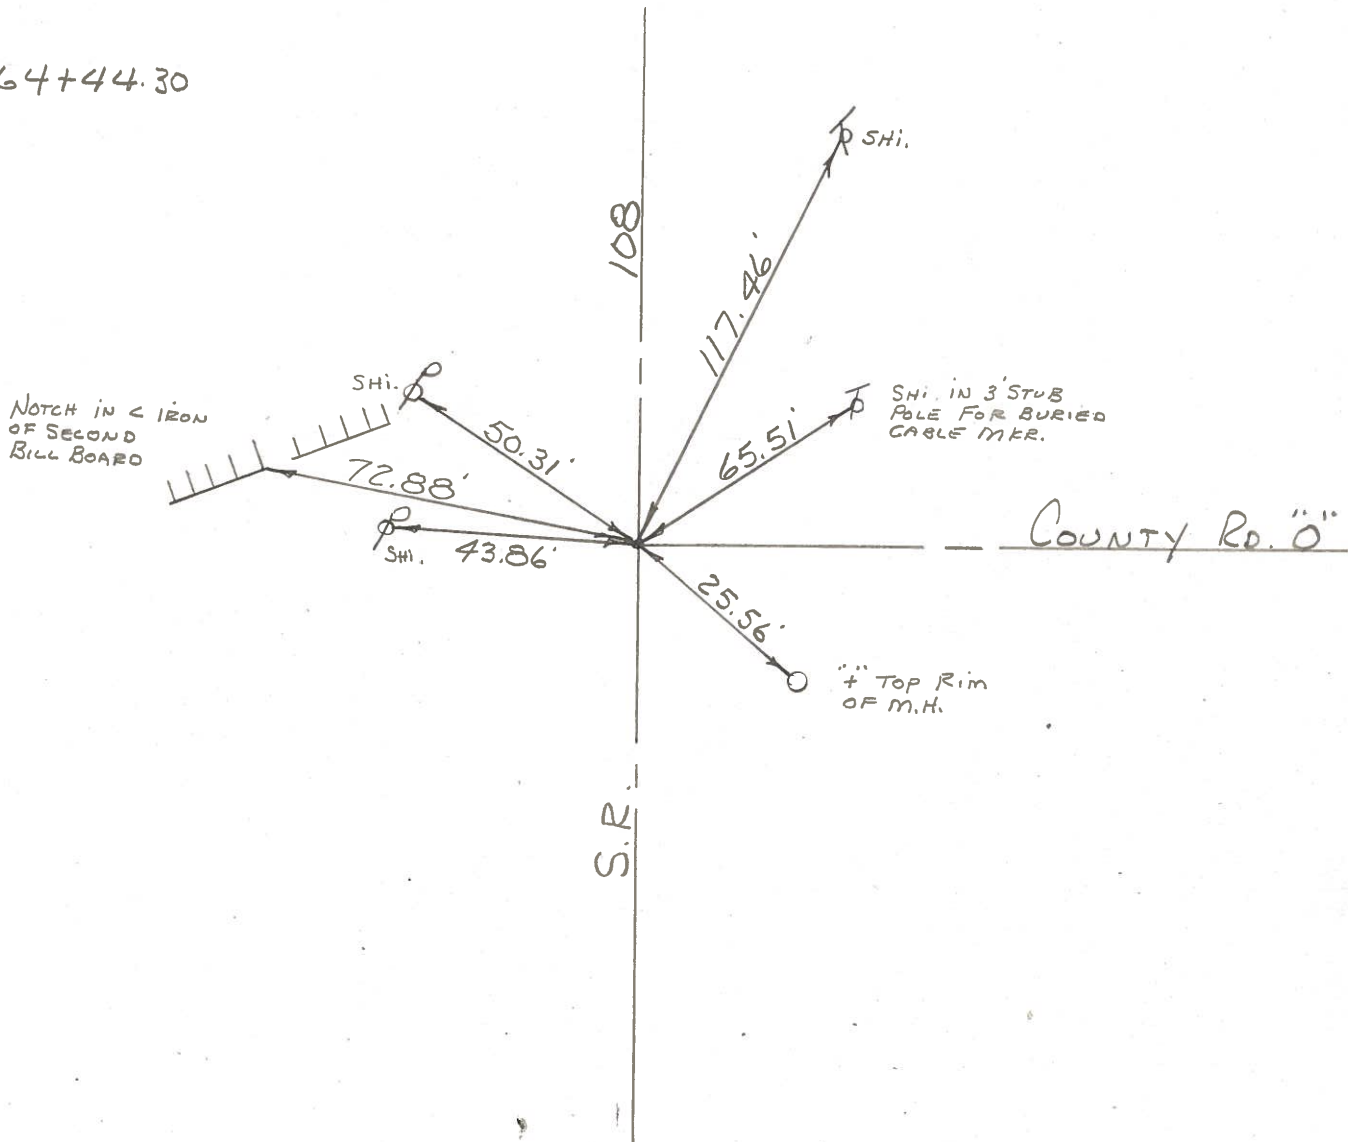

PERSONNEL	TITLE	PERSONNEL	TITLE	COUNTY	HEARY	DATE	July 12, 1974
Tomsic				S. R.	108	WEATHER	
Neuser				SEC.	Napoleon TWP.	TEMP.	
Van Yo							
Granata							

DESCRIPTION _____ LEFT _____ CENTER LINE _____ RIGHT _____ JOB NO. _____

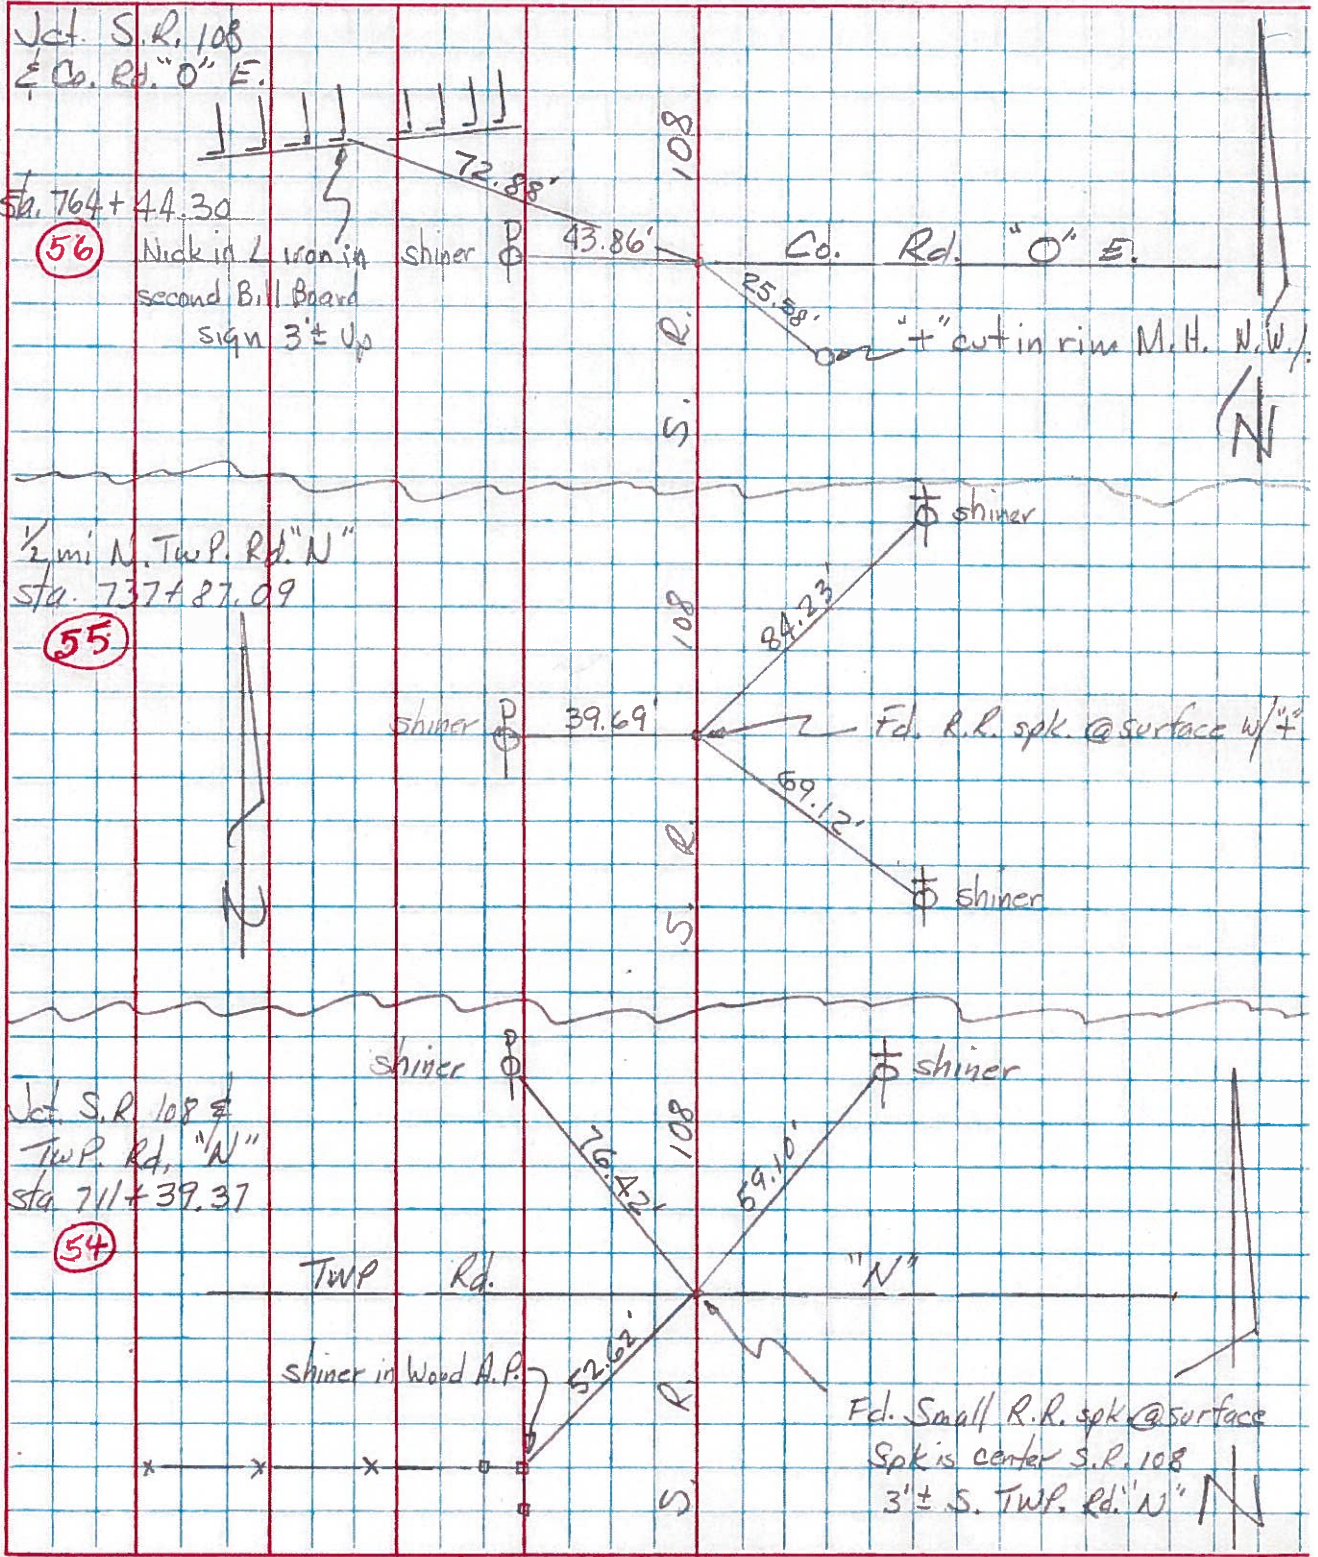

PERSONNEL TITLE PERSONNEL TITLE COUNTY HENRY DATE 11 JUNE 71
FRICKSEN _____
RAV _____
SHAW _____
 S. R. # 108 (119?) WEATHER CLOUDY R
 SEC. CRD 1 TO NAP TEMP. 75°

DESCRIPTION RE WITNESS TO CONTROL POINTS JOB NO. _____
 LEFT CENTER LINE RIGHT

REF	CONS	PLAN DATED 1956
<p>(51)</p> <p>P.I. 790 + 94.40 $\Delta = 0^{\circ} 57' RT$ HUDDLE RD FOUND SMALL R.R. SPK 11 JUN 71</p>		
<p>(56)</p> <p>P.I. 764 + 44.30 $\Delta = 0^{\circ} 03' RT$ FOUND R.R. SPK 11 JUNE 71 Co. RD O</p>		

PERSONNEL	TITLE	PERSONNEL	TITLE	COUNTY	Henry	DATE	11-26-56
Ruffar				S. R.	108	WEATHER	Fair
Kwape				SEC.		TEMP.	35
Holt							
Young							

DESCRIPTION LEFT CENTER LINE RIGHT JOB NO.

55


737 + 87.09

56

764 + 47.36


57

790 + 94.40

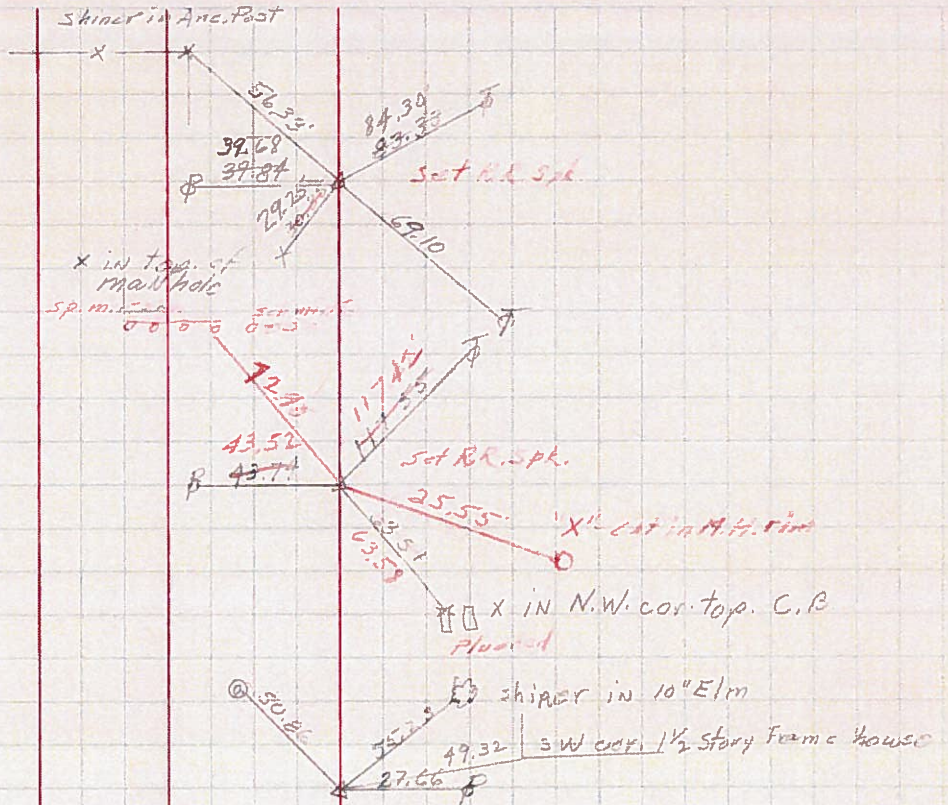

PERSONNEL	TITLE	PERSONNEL	TITLE	COUNTY	DATE
Jamson		Wilkinson		Henry	9-7-56
Burris		Phillips		S. R. 108	WEATHER clear
Borrett				SEC.	TEMP. 70°
Smith					

DESCRIPTION Witness Central Pts JOB NO. _____

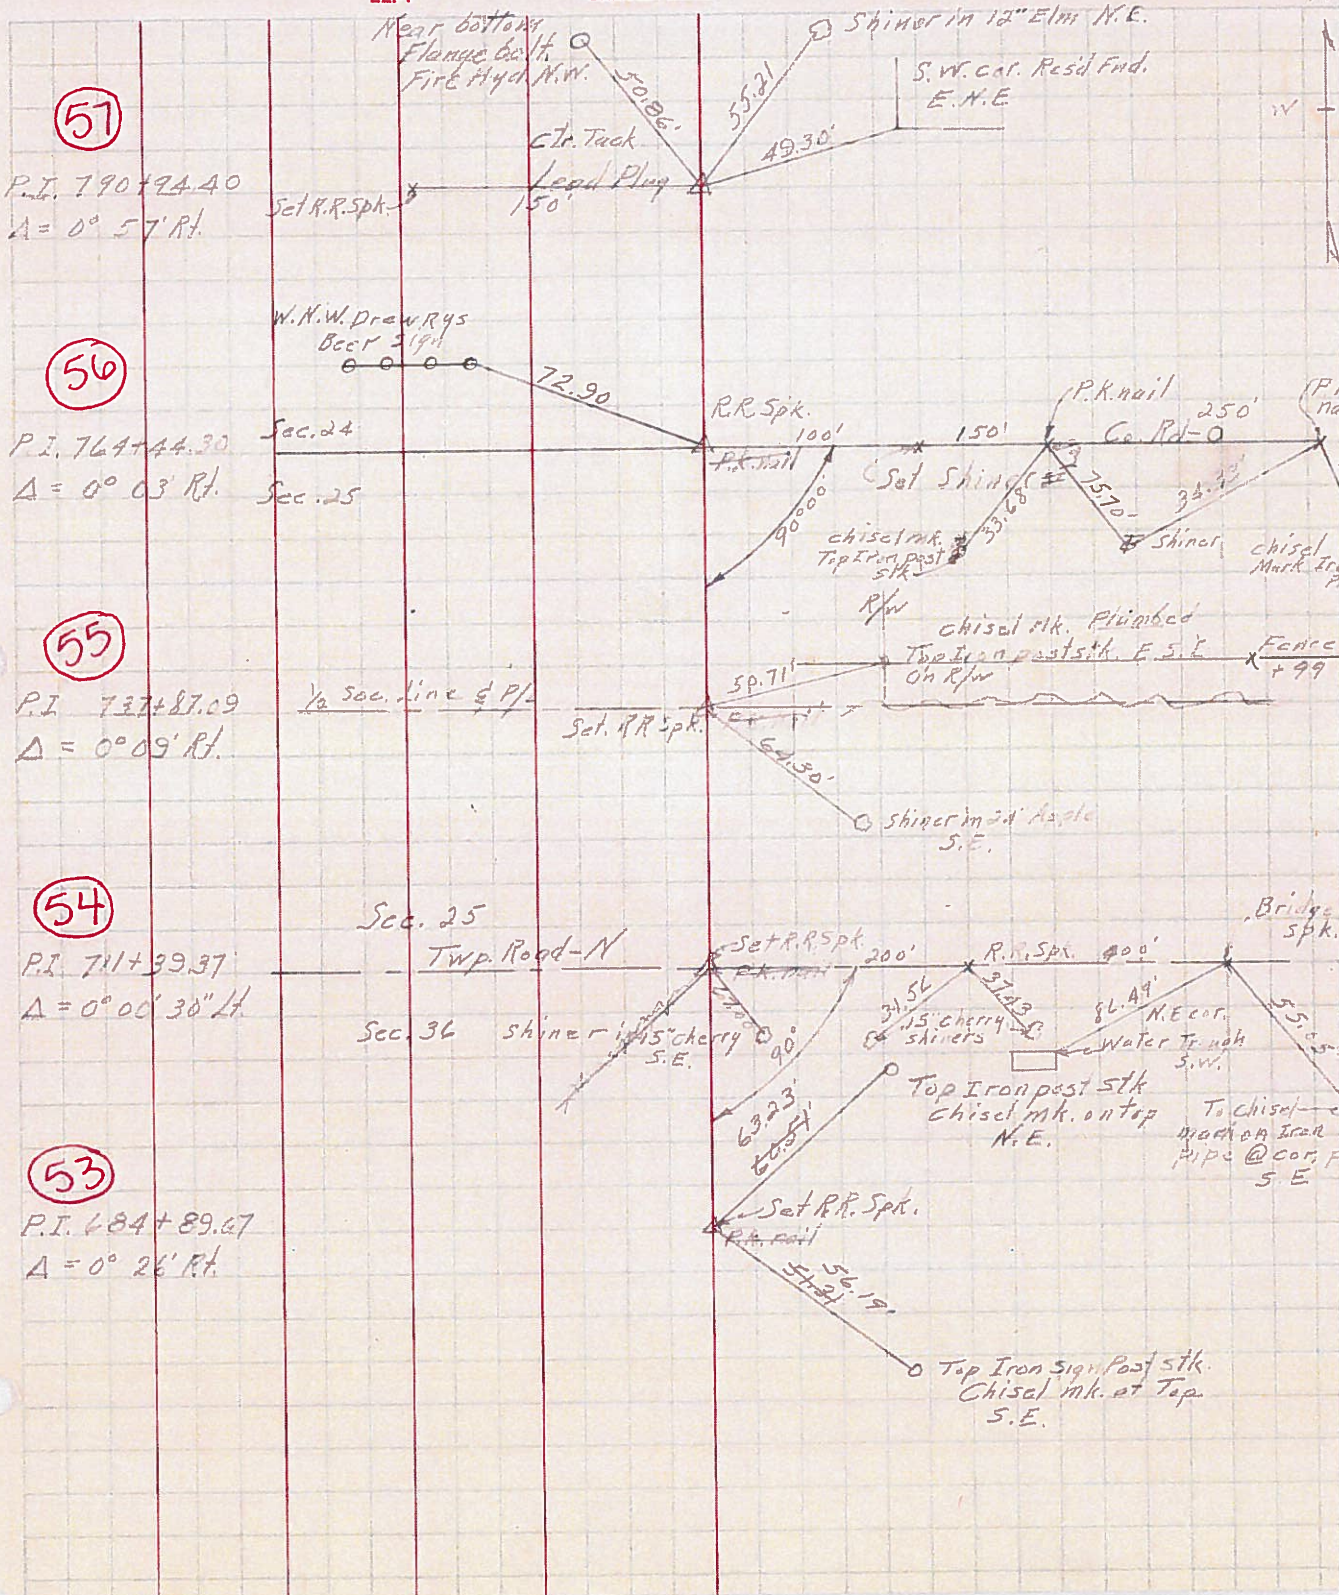

PERSONNEL TITLE PERSONNEL TITLE




Lougs
Dunn
Muhler
Rafter

COUNTY He DATE 3-31-55

S. R. 108 WEATHER

SEC. TEMP.

DESCRIPTION LEFT CENTER LINE RIGHT JOB NO.

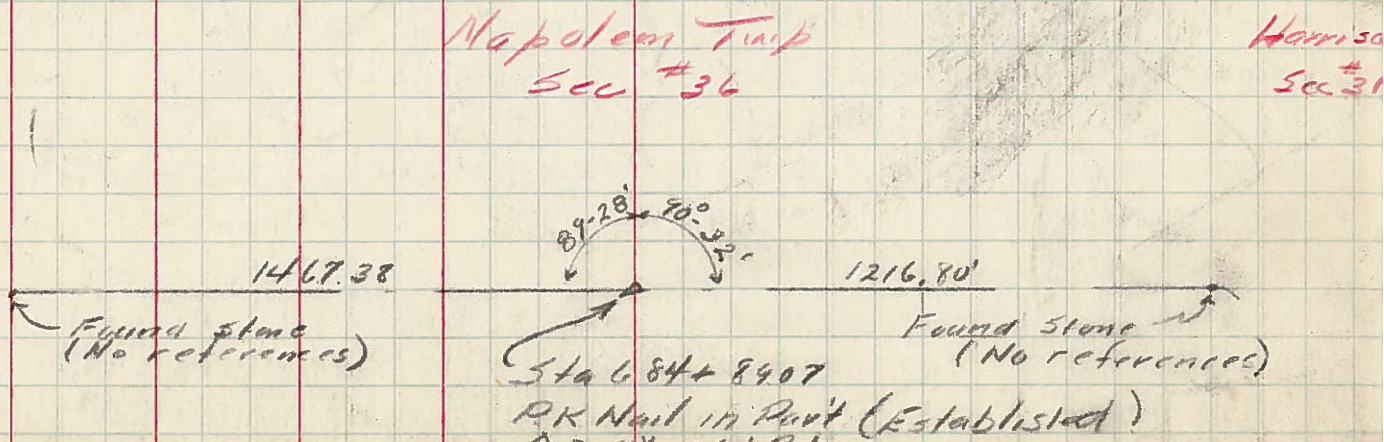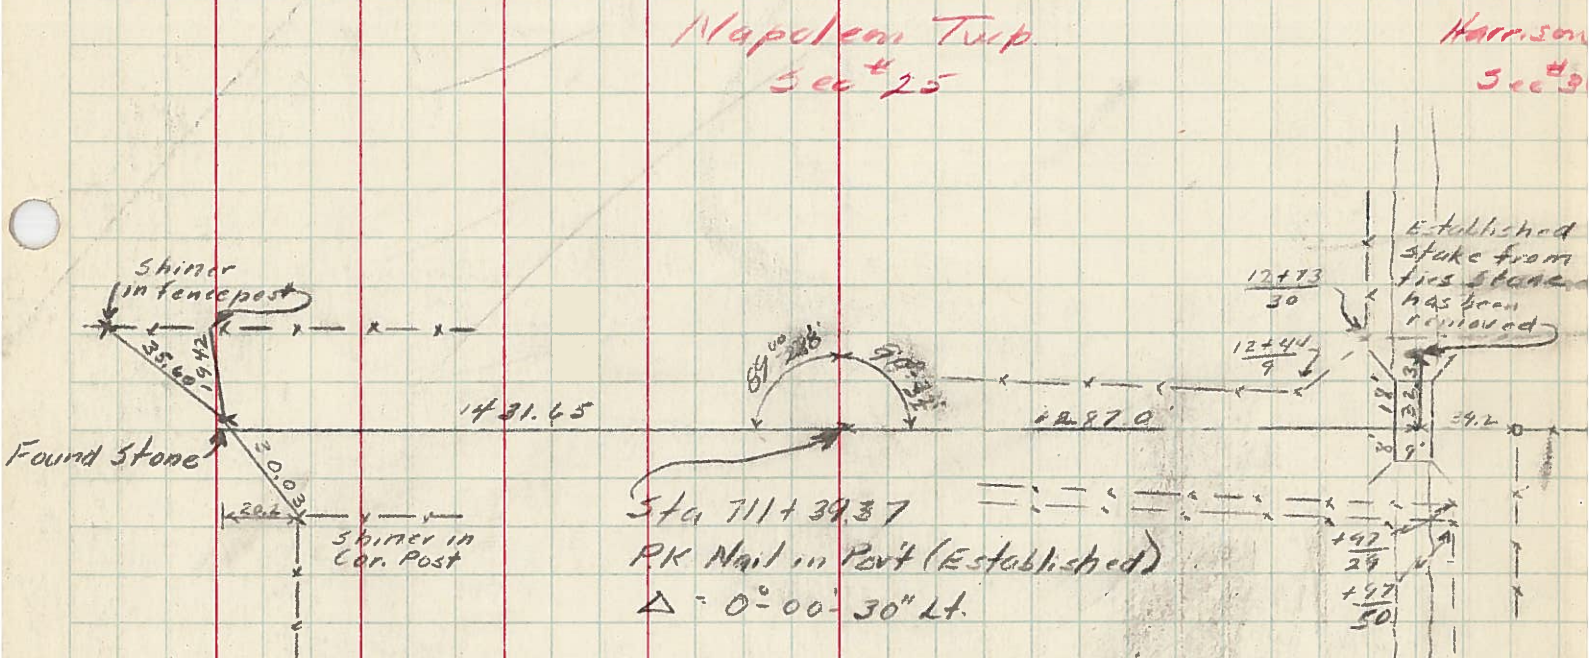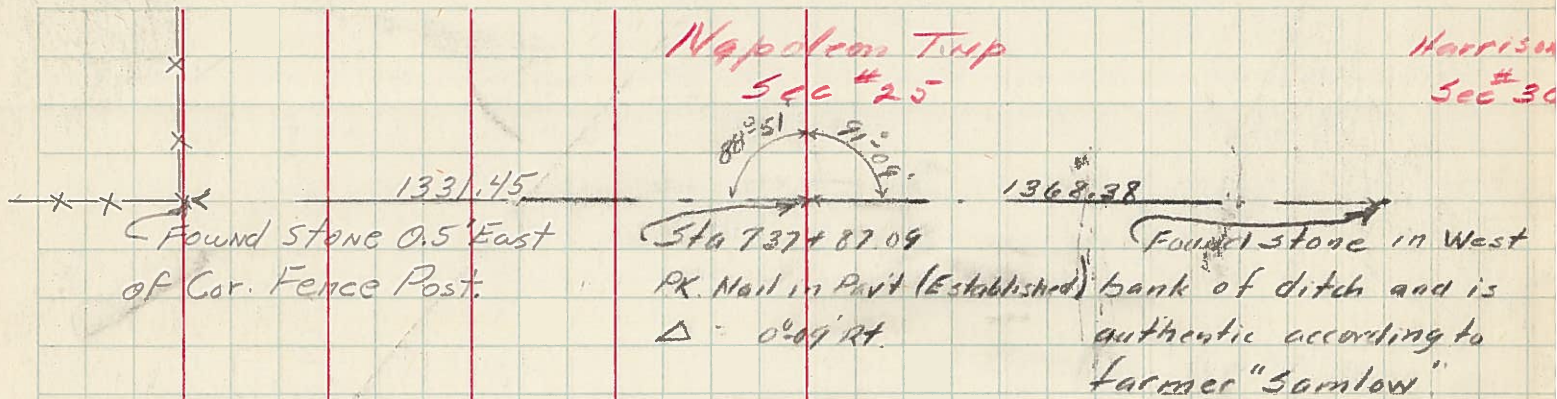

PERSONNEL TITLE PERSONNEL TITLE

Hoover
Latta
Duda


COUNTY He DATE 2-17-55

S. R. 108 WEATHER

SEC. TEMP.

DESCRIPTION P.I. LEFT CENTER LINE RIGHT JOB NO.

56

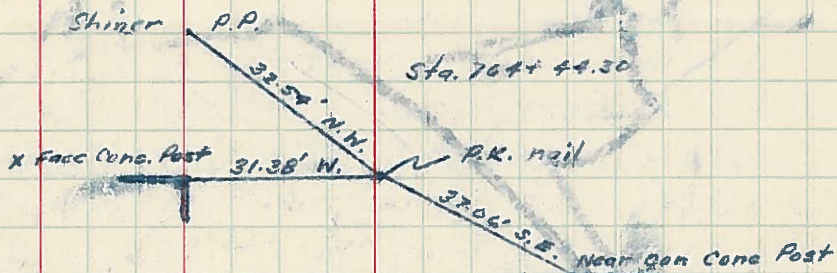

57

