

O.D.O.T. DISTRICT 2 SURVEY OFFICE (USE ONLY)

PERSONNEL

REFERENCE NO. 58

SHEET 44 OF 48

NOTES BALBAUGH

DATE 4/6/20

ROUTE SR 108

H.C. LEU

WEATHER SUNNY

COUNTY HENRY

R.C. O'DONNELL

TEMP. 57°

TOWNSHIP NAPOLEON

DWG BY MILLER

PID 94319

SECTION 24
T 5 N R 6 E

TYPE MONUMENT SM.R.R.SPIKE

ON SURFACE - ~~BELOW~~ ON _____

OFFSET \odot PAVEMENT 5.0' ~~LT~~ : RT

- TO - EDGE PAVEMENT


STATION: 817+15.72

HORZ. DATUM: NAD83 (2011)


GEOID: 2012A

GRID: NORTHING: 630164.054

EASTING: 1523798.955

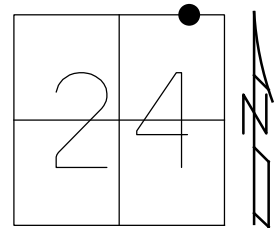

RECORD:
FD STAPLE
IN CONC. PVMT
1958, BEACH
SET SM.R.R.SPIKE
1960
1974, TOMSICK
1977, BURNSIDE
FD P.K.NAIL
SET SM.R.R.SPIKE
1988, HOFFMAN
FD SM.R.R.SPIKE
2001, MB
REF58
4/6/20, JLL
SET MAG/WASHER
10-23-20, DSA

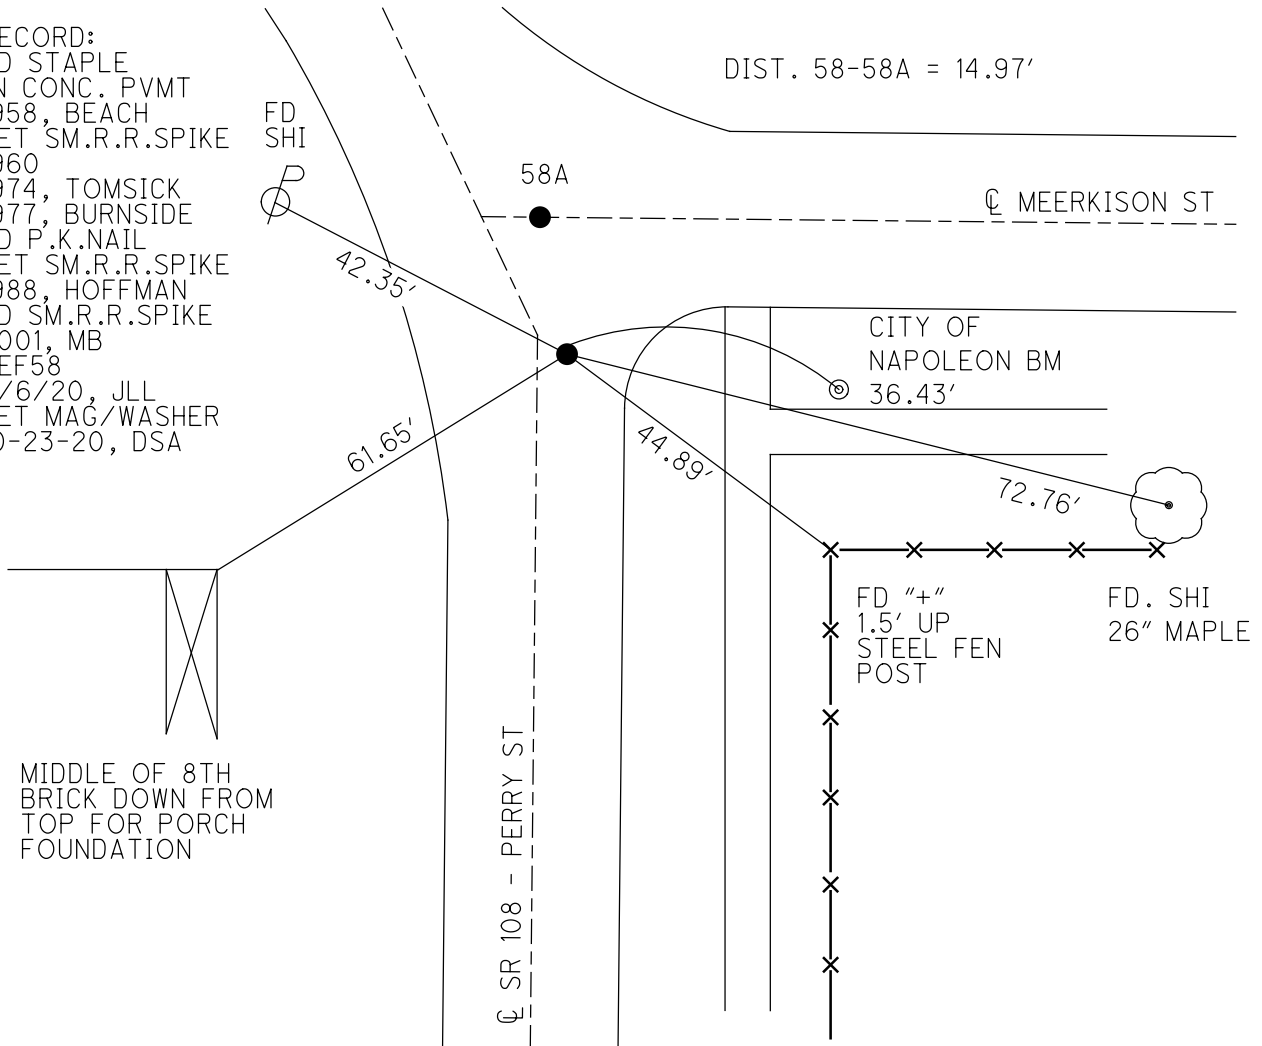

MIDDLE OF 8TH
BRICK DOWN FROM
TOP FOR PORCH
FOUNDATION

O.D.O.T. DISTRICT 2 SURVEY OFFICE

PERSONNEL

REFERENCE NO. 58

SHEET 9 OF 9

NOTES CANTERBURY

H.C. BARNHISEL

DATE 8-9-01

ROUTE 108

R.C. MOSEK

WEATHER OVERCAST

COUNTY HENRY

DRAWN: MOSEK

TEMP. +92°F

TOWNSHIP NAPOLEON

SECTION 24

T5 N R 6 E



TYPE MONUMENT SMALL R.R. SPIKE

ON SURFACE - ~~BELOW~~ ON

~~LEFT - SPAV'T.~~ - RIGHT S.O' RT

- TO - EDGE PAVEMENT ± 14' S. OF ♀ PART OF MEERISON ST.

S.L.M. B16 + 81

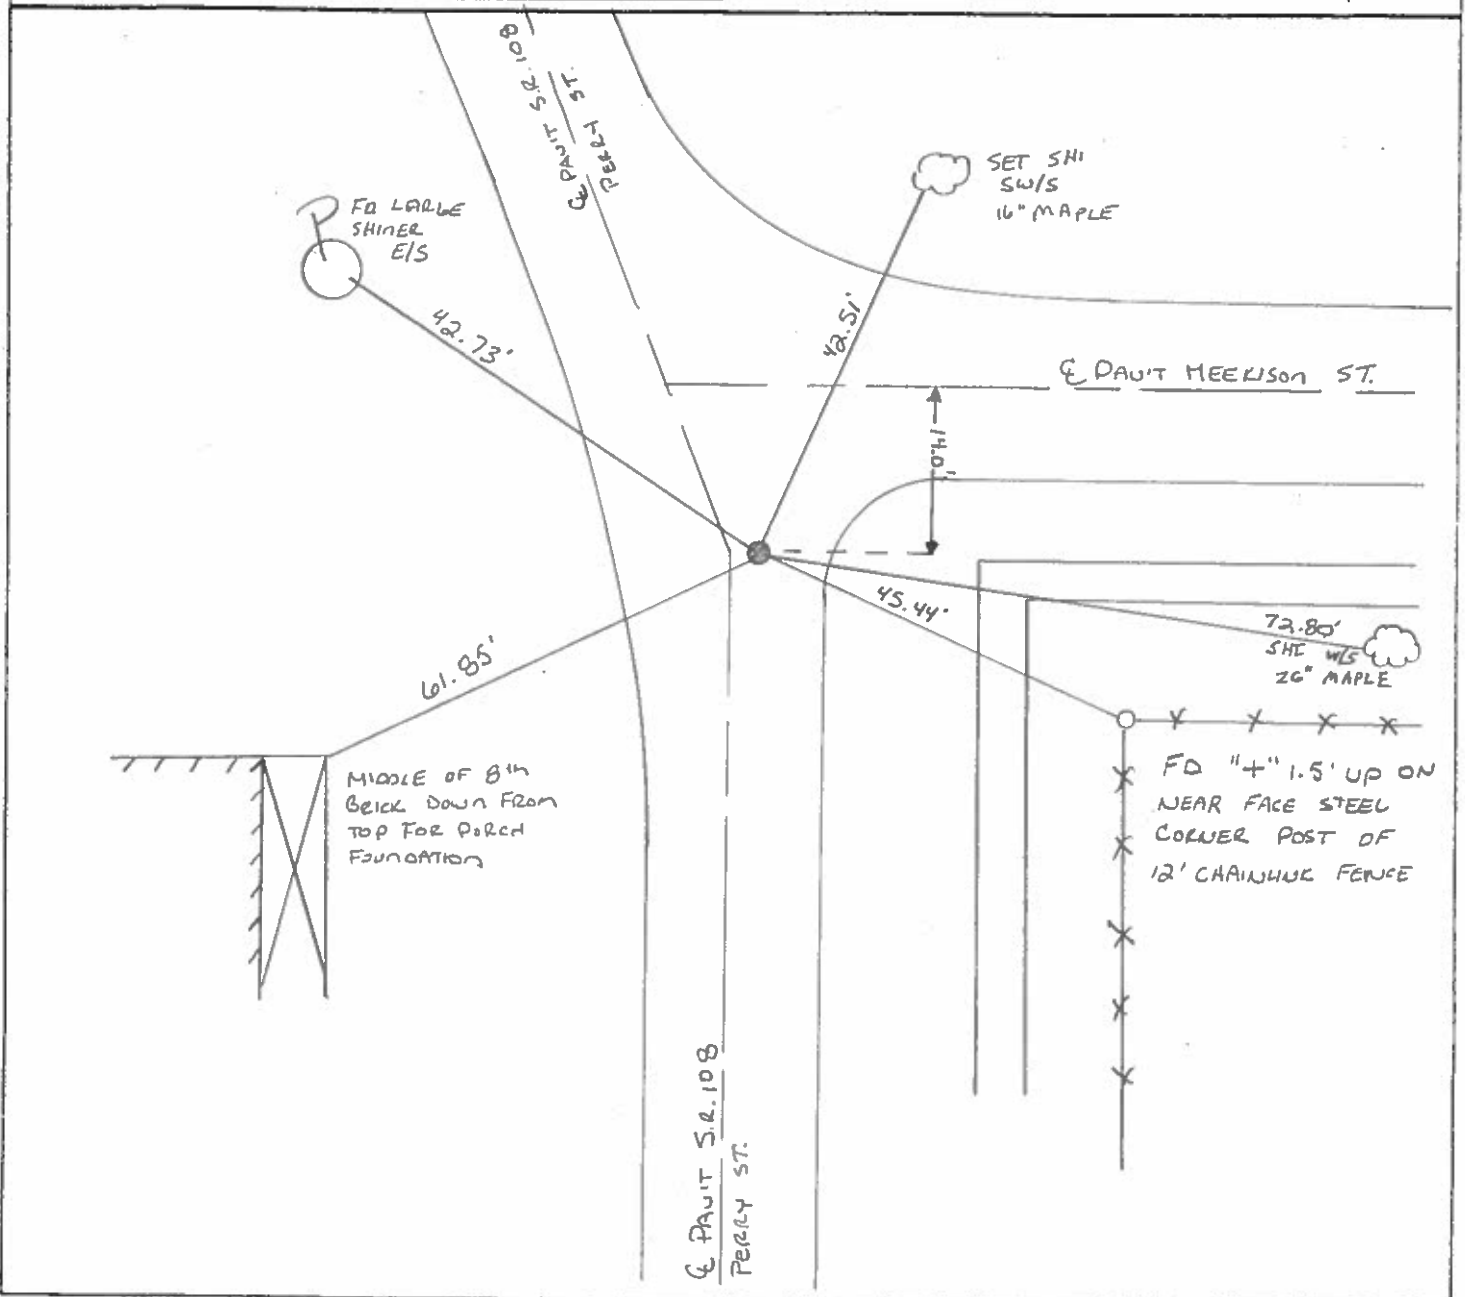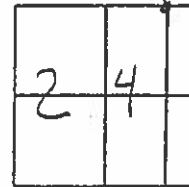

O.D.O.T. DISTRICT 2 SURVEY OFFICE

PERSONNEL

REFERENCE NO. 58

SHEET 9 OF 33

NOTES HOFFMAN

H.C. BARNHISEL

R.C. LOSHRKE

REED

DATE 3-25-88

WEATHER P. CLEAR

TEMP. 60°

ROUTE SR 108

COUNTY HENRY

TOWNSHIP NAPOLEON

SECTION 24

T5 N R 6 E

TYPE MONUMENT PK. Nail

ON SURFACE - BELOW YES



~~LEFT~~ - CL PAV'T. - RIGHT 2.4'

21.2 TO L + EDGE PAVEMENT

S.L.M. 816 + 81

Set SMALL RR SPIKE
5-24-88 SWH

14.0' S. of CL
Part of MEEKISON ST.

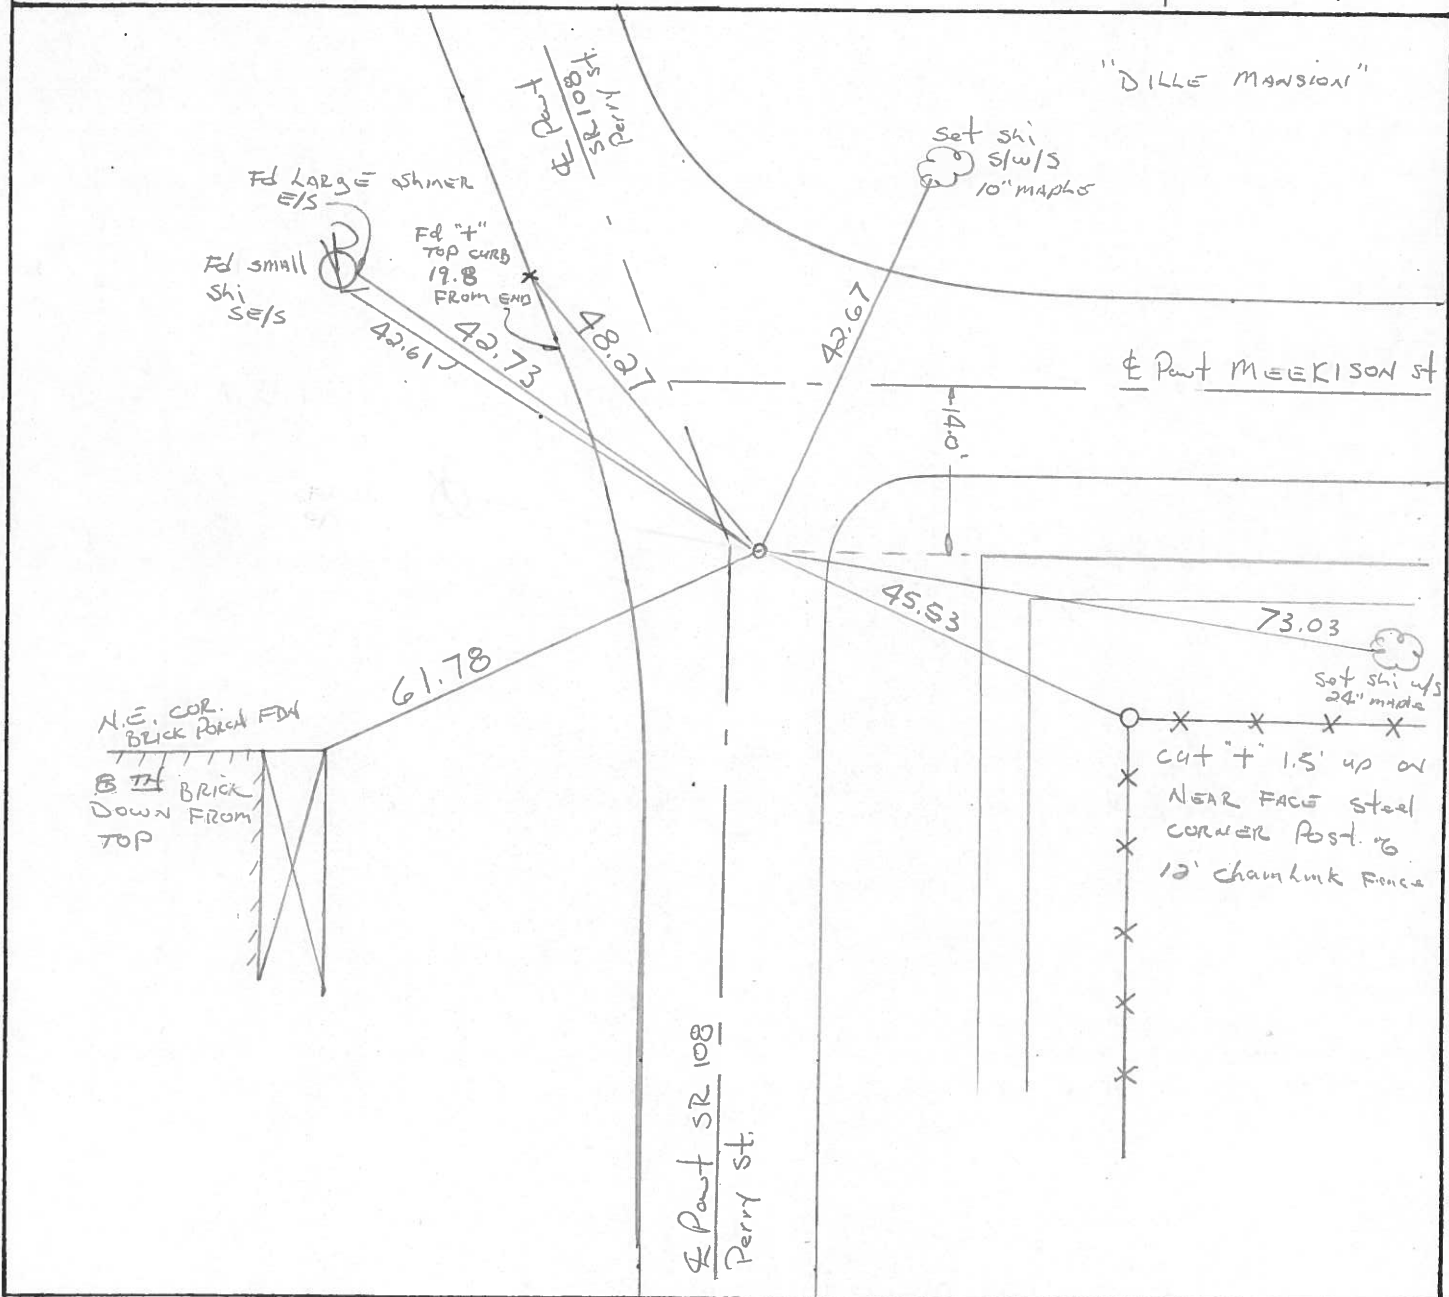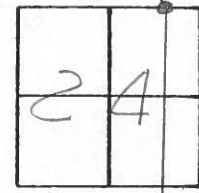

O.D.O.T. DISTRICT 2 SURVEY OFFICE

Sht. 9 of 19
S.R.108

County HENRY

Date 8-26-77

Township NAPOLEON

Weather CLEAR

Section 24

Temp. +75°

T5N, R6E

Personnel BURNSIDE

SMITH

BOWERS


KNAPE

MEAD




#58

FD. SMALL R.R. SPK
@ SURFACE.

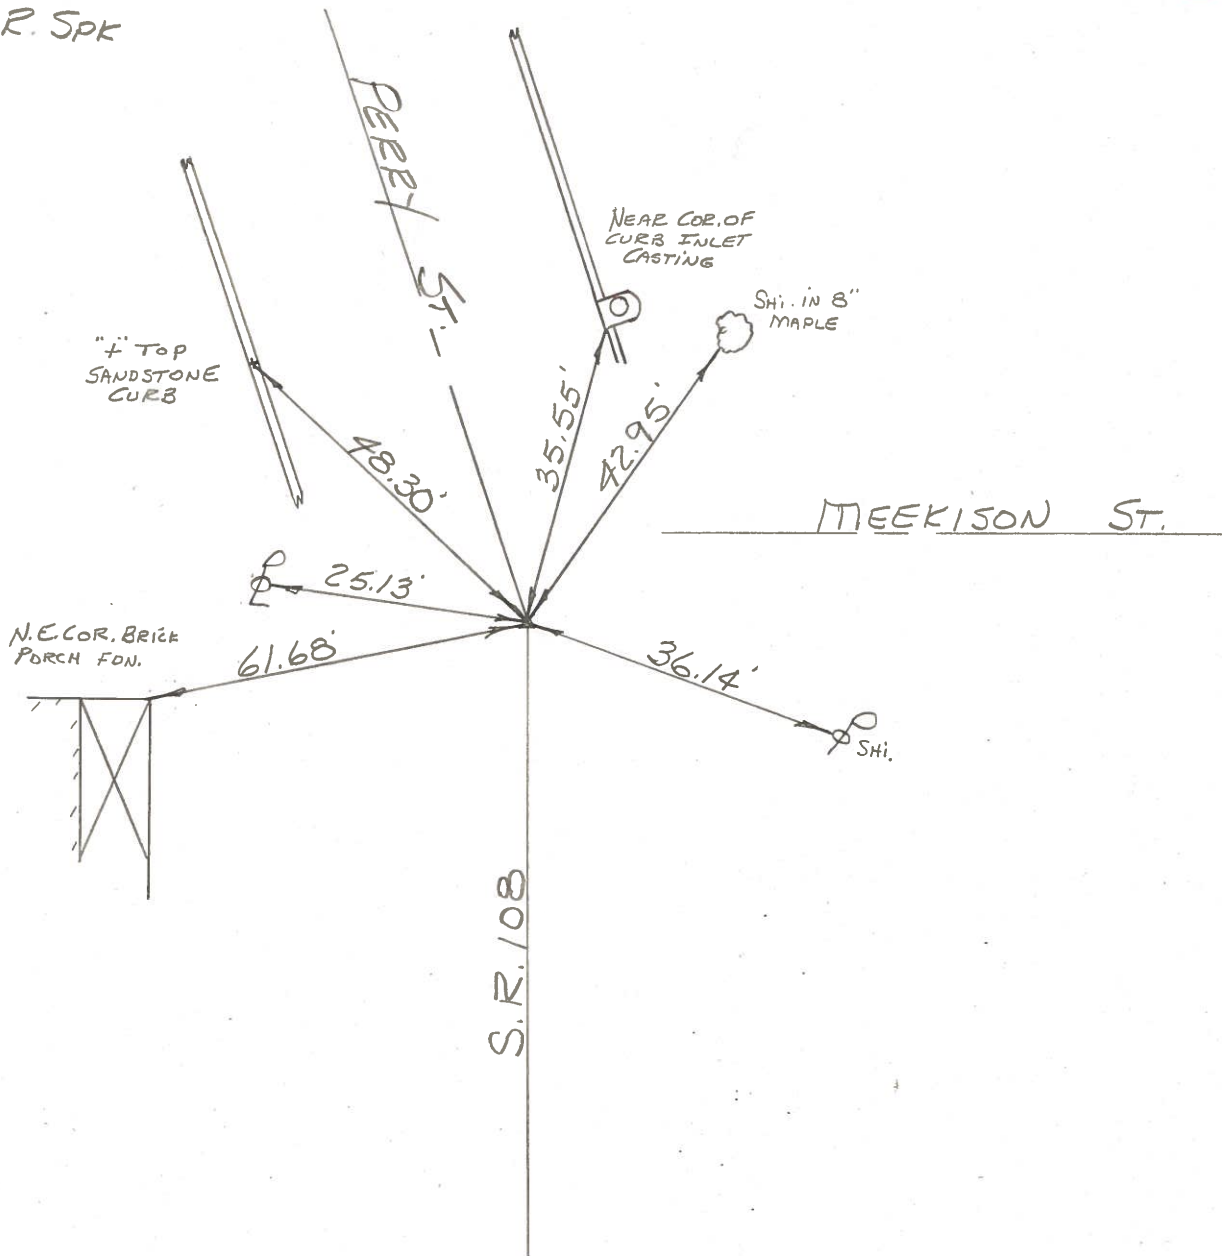

PERSONNEL	TITLE	PERSONNEL	TITLE	COUNTY	HENRY	DATE	July 12, 1974
Tomsic				S. R.	108	WEATHER	
Neuser				SEC.	Napoleon Twp.	TEMP.	
Vanya							
Granata							

DESCRIPTION _____ LEFT _____ CENTER LINE _____ RIGHT _____ JOB NO. _____

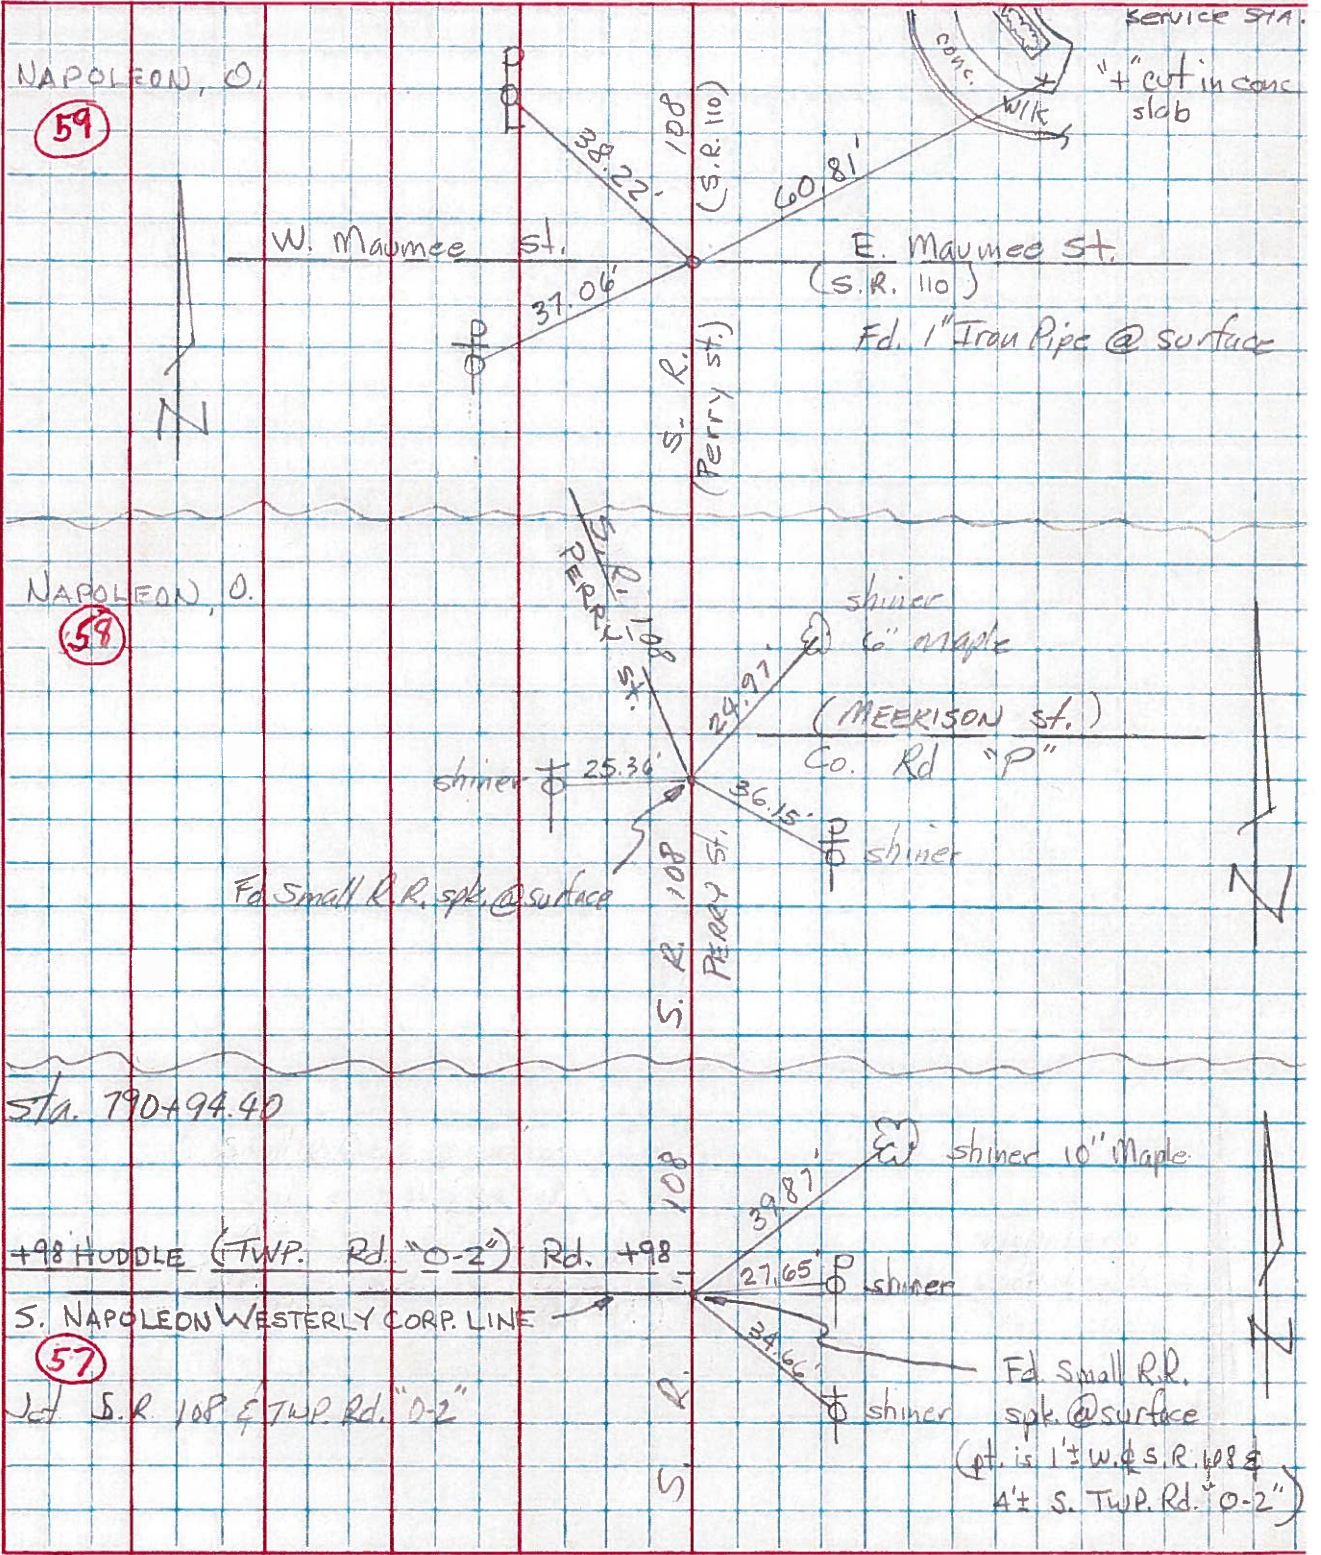

PERSONNEL TITLE PERSONNEL TITLE
 Beach Armbruster
 Knappe

COUNTY Henry DATE 18 Aug '58
 10-24-60
 S. R. 108 WEATHER
 SEC Napoleon TEMP.

DESCRIPTION CONTROL POINTS JOB NO.
 LEFT CENTER LINE RIGHT

