

O.D.O.T. DISTRICT 2 SURVEY OFFICE (USE ONLY)

PERSONNEL

REFERENCE NO. 59 A

SHEET 47 OF 48

NOTES LEU

DATE 11/7/18

ROUTE SR 108

H.C. _____

WEATHER _____

COUNTY HENRY

R.C. _____

TEMP. _____

TOWNSHIP NAPOLEON

SECTION 13

DWG BY MILLER

PID 94319

T 5 N R 6 E

TYPE MONUMENT MONBOX W/1" IPIN

ON SURFACE - ~~BELOW~~ ON _____

OFFSET \odot PAVEMENT ON _____ LT : RT

- TO - EDGE PAVEMENT


STATION: 833+17

HORIZ.DATUM: NAD83 (2011)


GEOID: 2012A

GRID: NORTHING: 631624.184


EASTING: 1523090.659

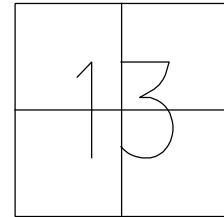

RECORD:
ORIGIN UNKNOWN
FD NAIL
2" DOWN
3-25-88
LG NAIL
3" DOWN
4-18-94, CL
FD MONBOX
W/ 1" IPIN
REFA59
11-7-18, JLL

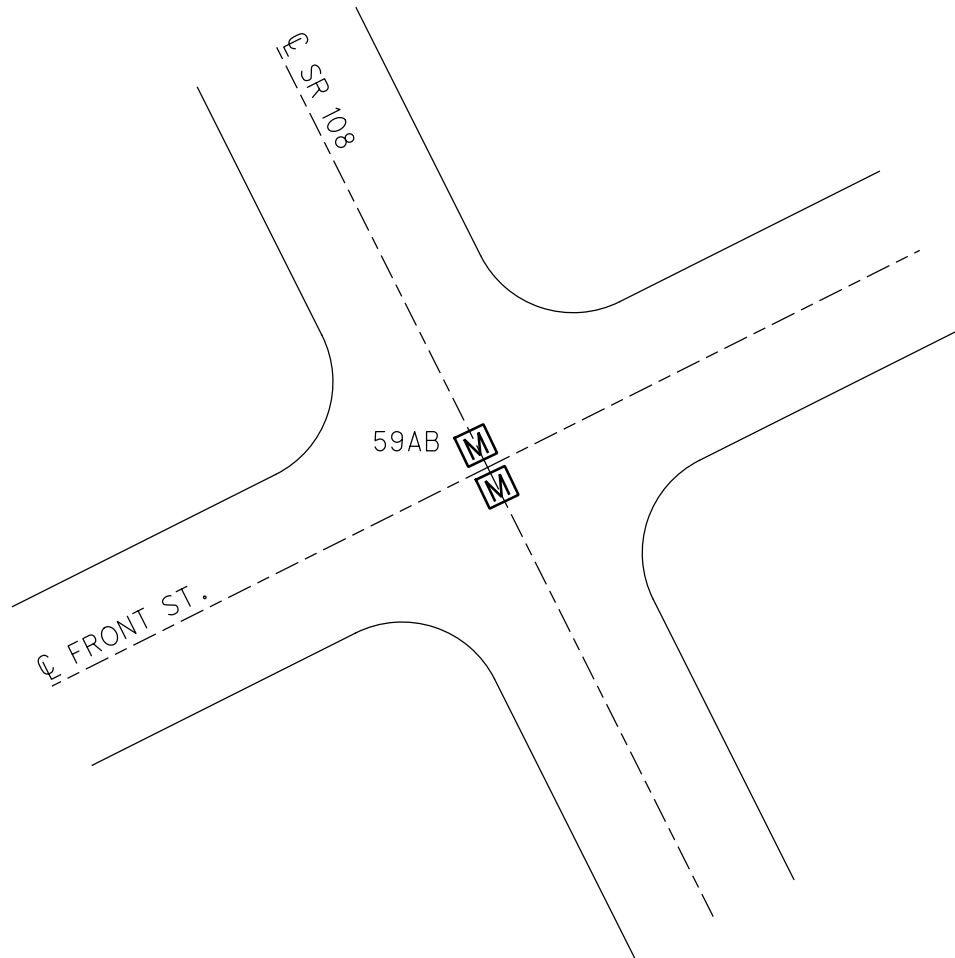

PERSONNEL	TITLE	PERSONNEL	TITLE	COUNTY	DATE
HOMAN	D			HEN	1-14-02
CORDES	T W			S.R.	108
				SEC.	15.61
DESCRIPTION ESTABLISH & R/W AND SUR. OF SR 108				WEATHER	sun
				TEMP	30°
				JOB NO.	423290

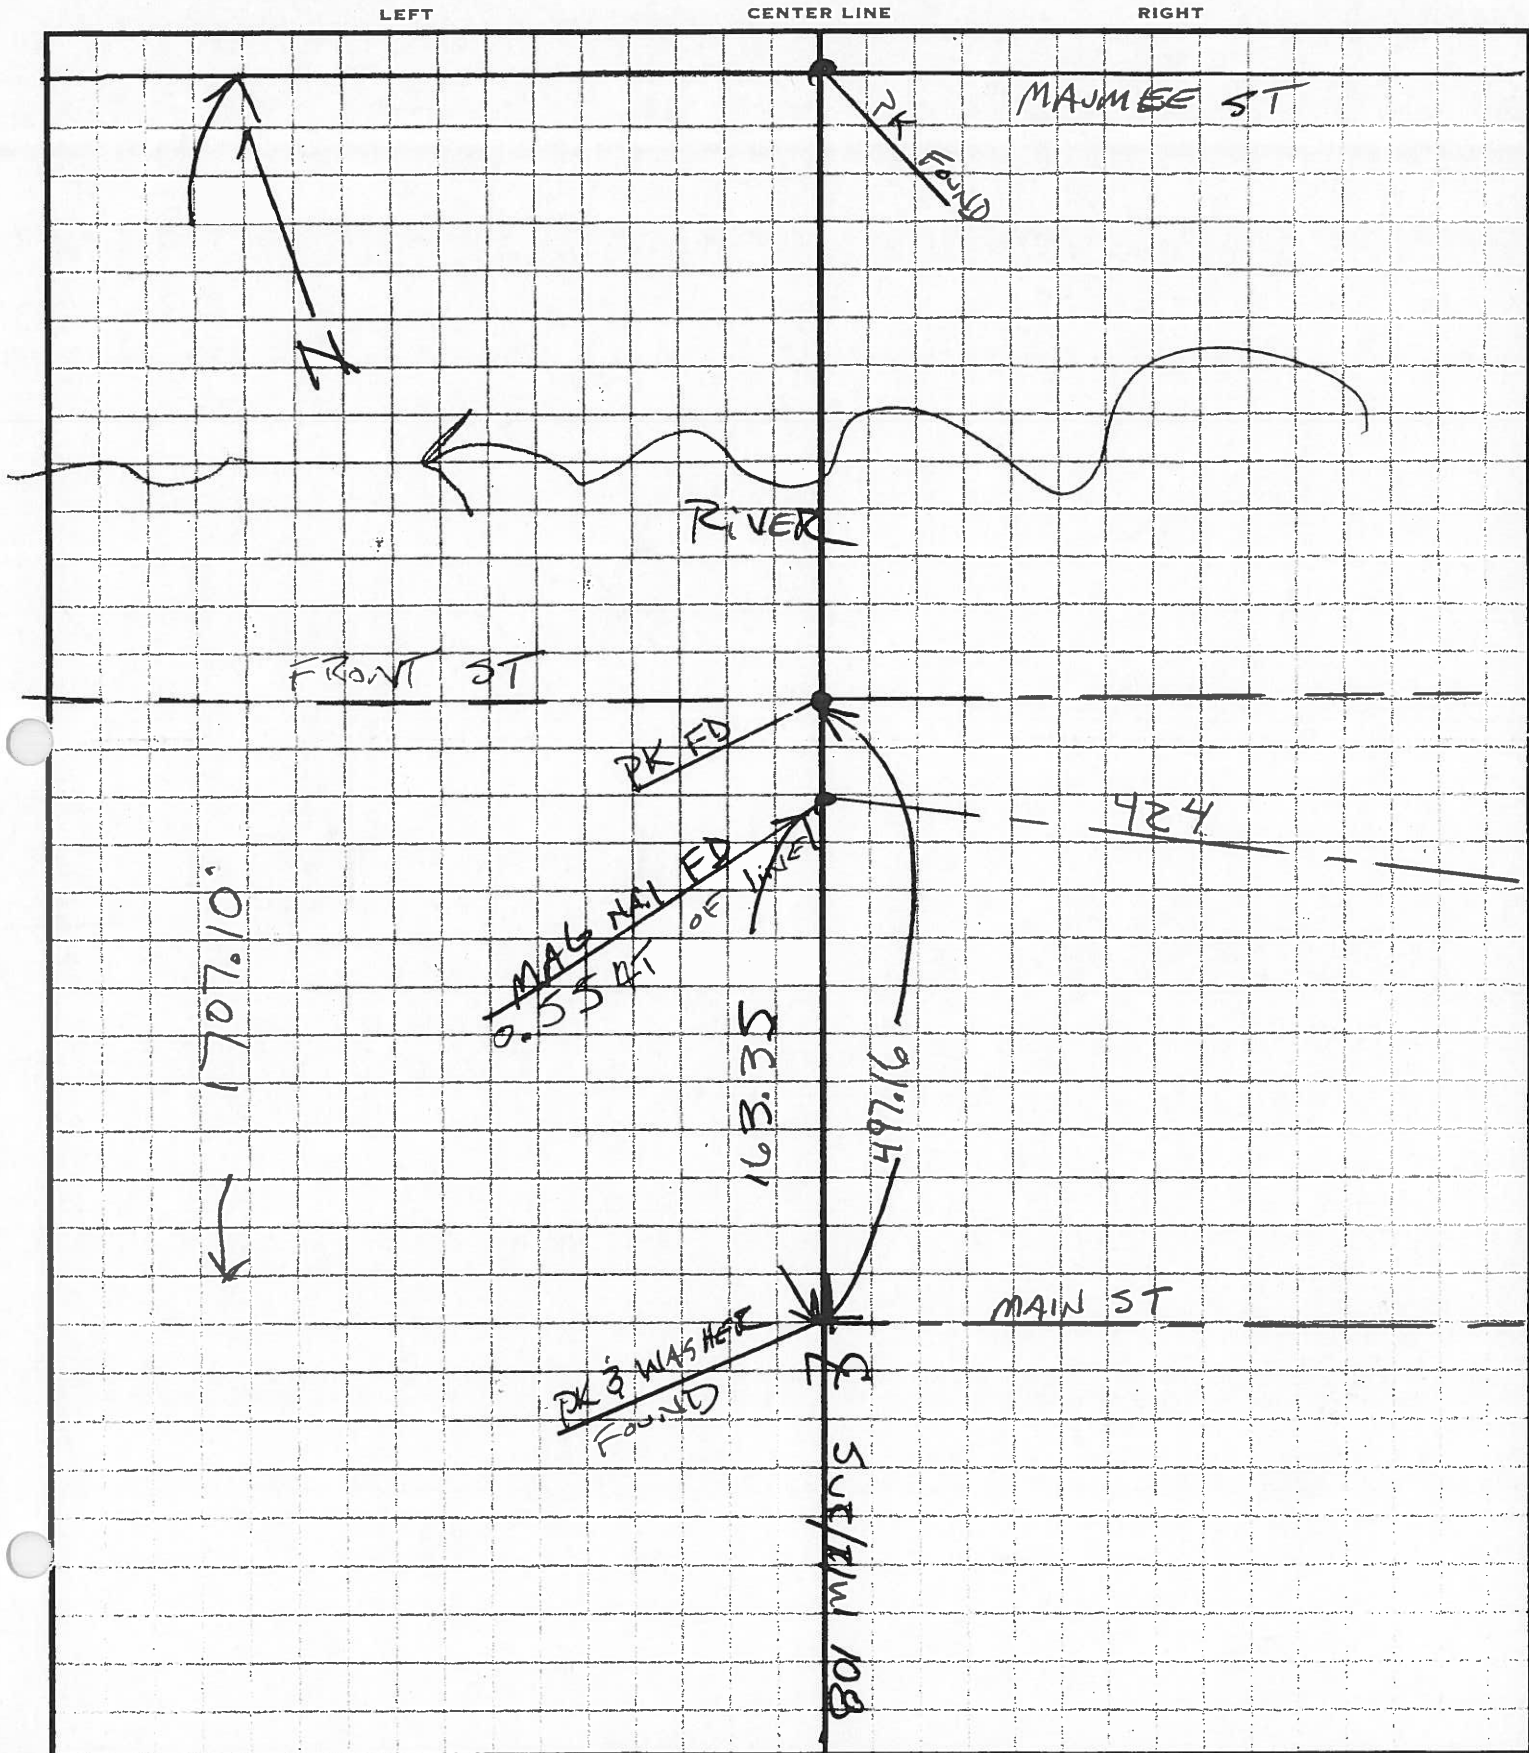

O.D.O.T. DISTRICT 2 SURVEY OFFICE

PERSONNEL _____

REFERENCE NO. 59-A

SHEET 2 OF 6

NOTES LOEHRKE

H.C. _____

DATE 4-18-94

ROUTE S. R. 108

R.C. _____

WEATHER _____

COUNTY HENRY

TEMP. _____

TOWNSHIP NAPOLEON

SECTION 13

T 5 N R 6 E


TYPE MONUMENT LG. NAIL DID NOT FIND

ON SURFACE - BELOW 3" BELOW


LEFT- & PAV'T. - RIGHT & BOTH PAV'T.

TO EDGE PAVEMENT

S.L.M. 833+17

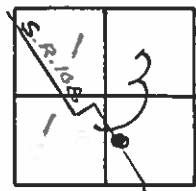

DID NOT FIND

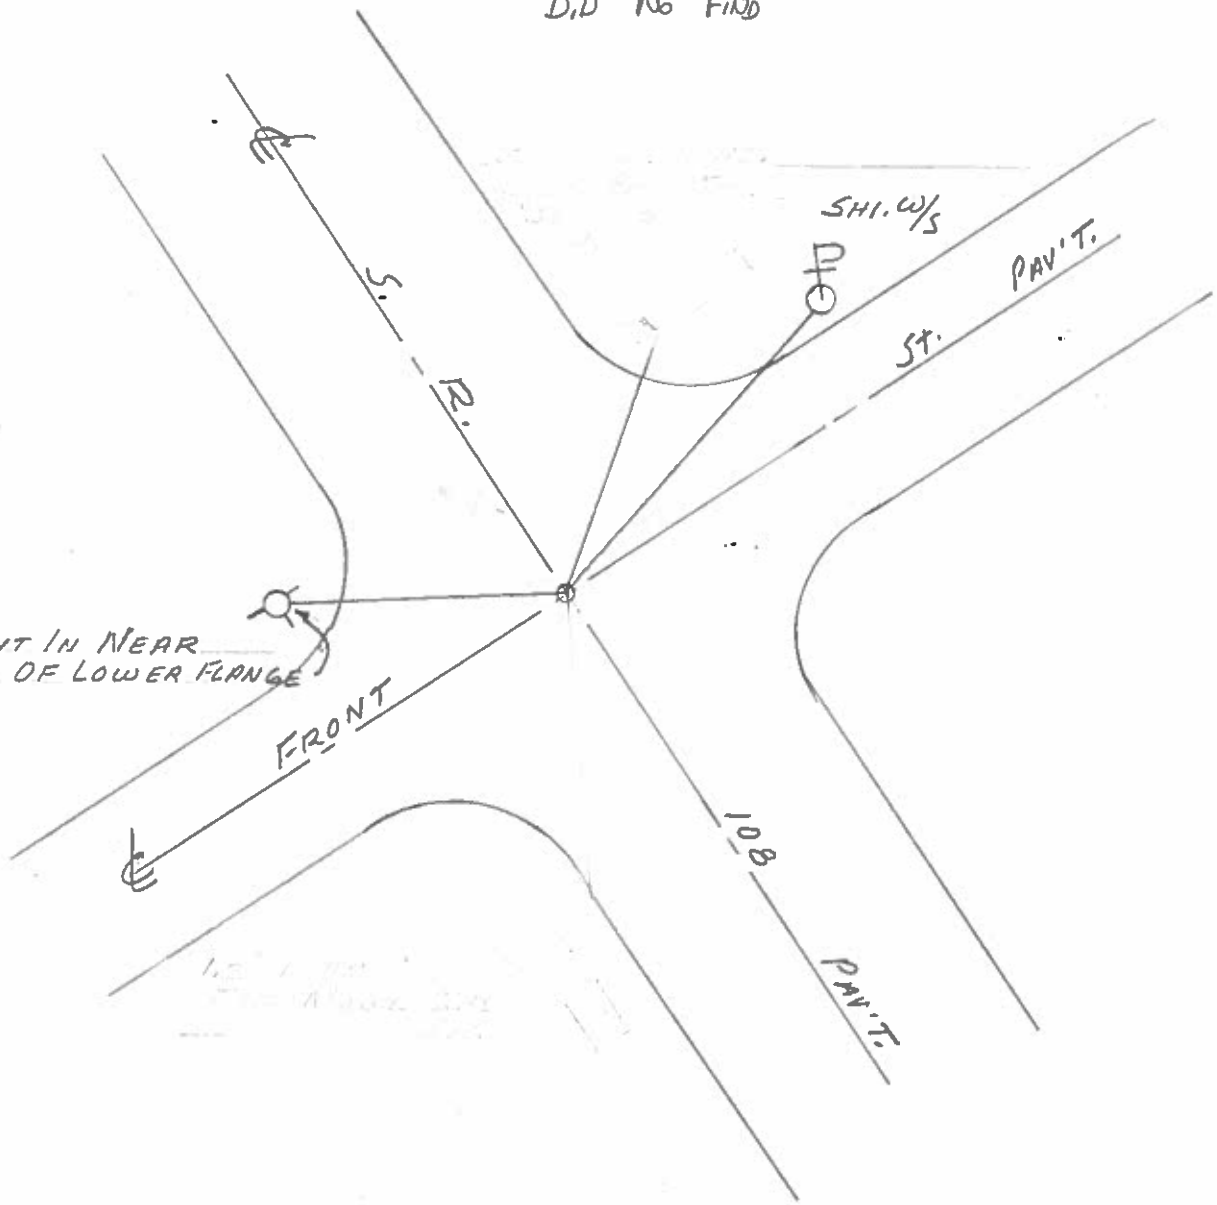

O.D.O.T. DISTRICT 2 SURVEY OFFICE

PERSONNEL

REFERENCE NO. 59-A

SHEET 11 OF 33

NOTES HOFFMAN

H.C. BARNATSKY

DATE 3-25-88

ROUTE SR 108

R.C. LOEHLKE

WEATHER P. CLEAR

COUNTY HENRY

REED

TEMP. 60°

TOWNSHIP Napoleon

SECTION 13

TS. N R 6 E



TYPE MONUMENT Nail - ORIGINAL UNKNOWN

ON-SURFACE - BELOW 2"

LEFT- & PAV'T. - RIGHT Both Pav'ts

29.1 TO RT EDGE PAVEMENT

S.L.M. 833+17

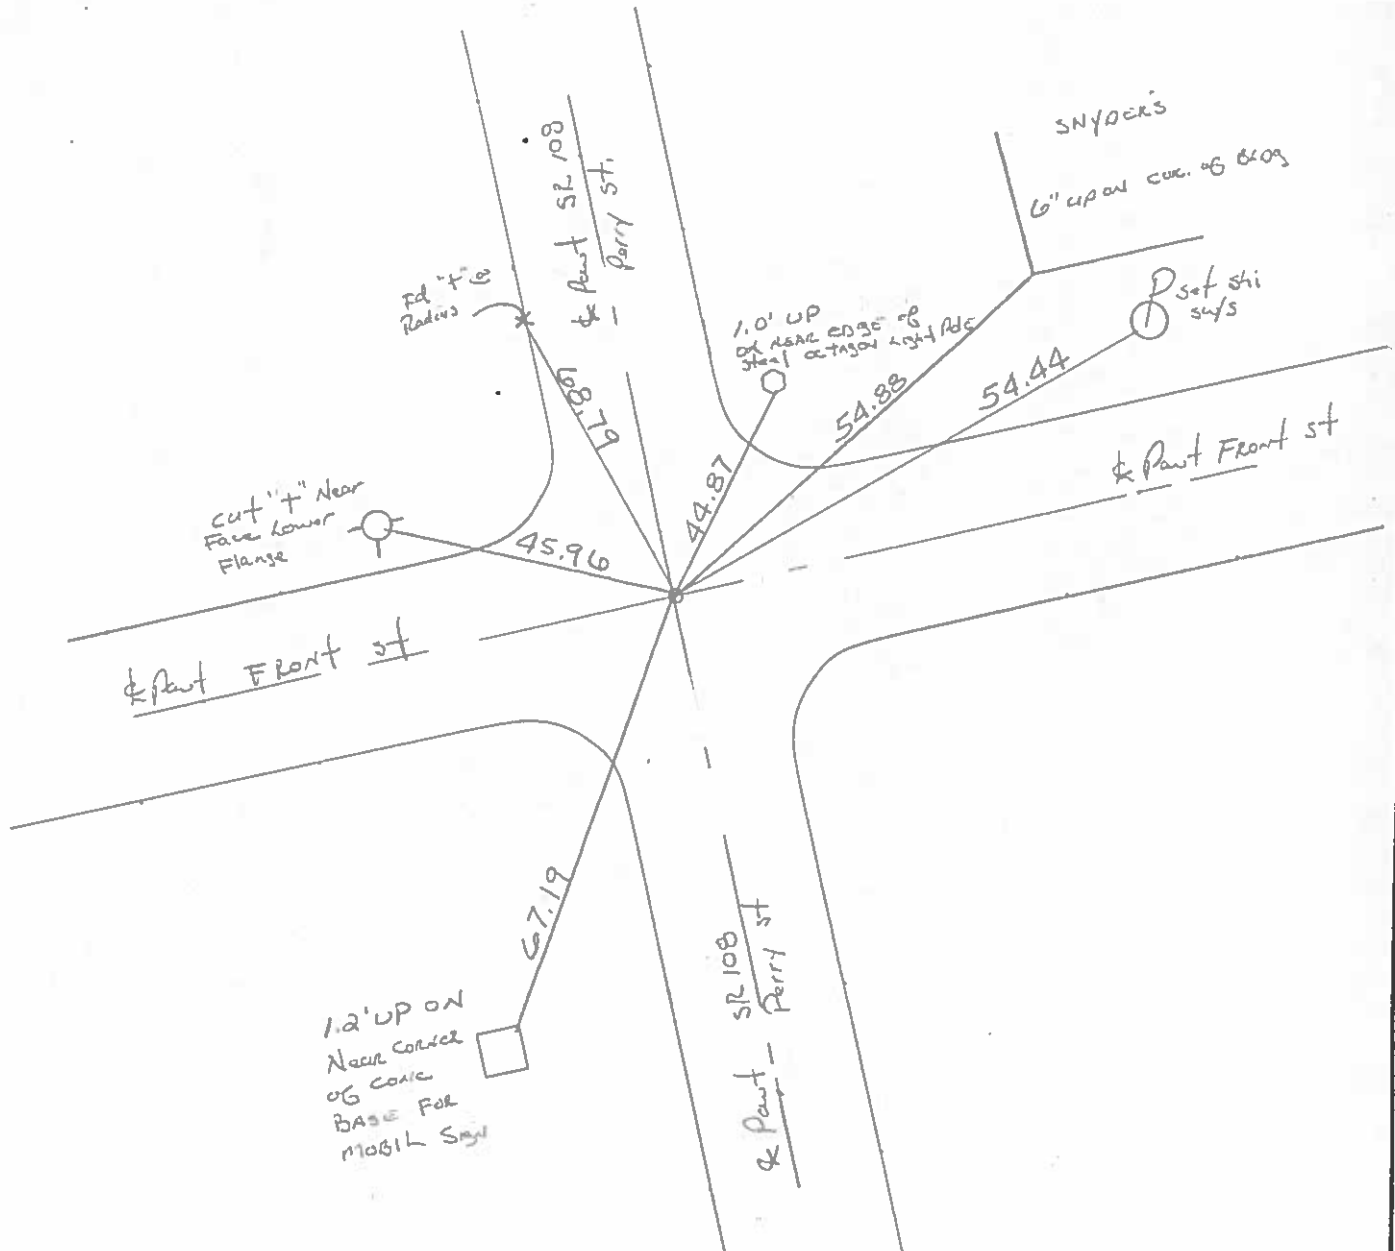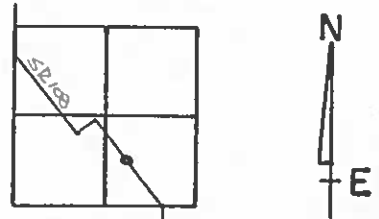

O.D.O.T. DISTRICT 2 SURVEY OFFICE

Sht. 11 of 19
S.R.108

County HENRY

Date 5-17-78

Township NAPOLEON

Weather CLEAR

Section _____

Temp. +67°


T5N, R6E

Personnel BURNSIDE

SMITH

KNAPP

MEAD

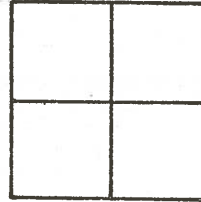

#59-A

FD. NAIL @ SURFACE
ORIGIN UNKNOWN

