

O.D.O.T. DISTRICT 2 SURVEY OFFICE (USE ONLY)

PERSONNEL

REFERENCE NO. 59 B

SHEET 1 OF 14

NOTES CURTIS DATE 4/18/94
 H.C. LOEHRKE WEATHER CLOUDY
 R.C. _____ TEMP. 60°

ROUTE SR 108
 COUNTY HENRY
 TOWNSHIP NAPOLEON
 SECTION 13

DWG BY NIESE PID _____

T 5 N R 6 E

TYPE MONUMENT LG R.R. SPIKE

~~ON SURFACE~~ - BELOW 7 1/2"


OFFSET Q PAVEMENT _____ ON _____ LT : RT

_____ TO _____ EDGE PAVEMENT


STATION: 836+50

HORZ.DATUM: _____ GEOID: _____

GRID: NORTHING: _____ EASTING: _____

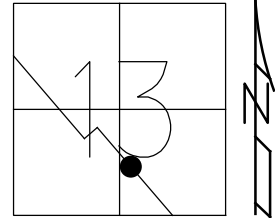

RECORD:
 FD LG R.R. SPIKE
 7 1/2" DOWN
 4/18/94, CL
 D.N.F.
 8/2/94, CL

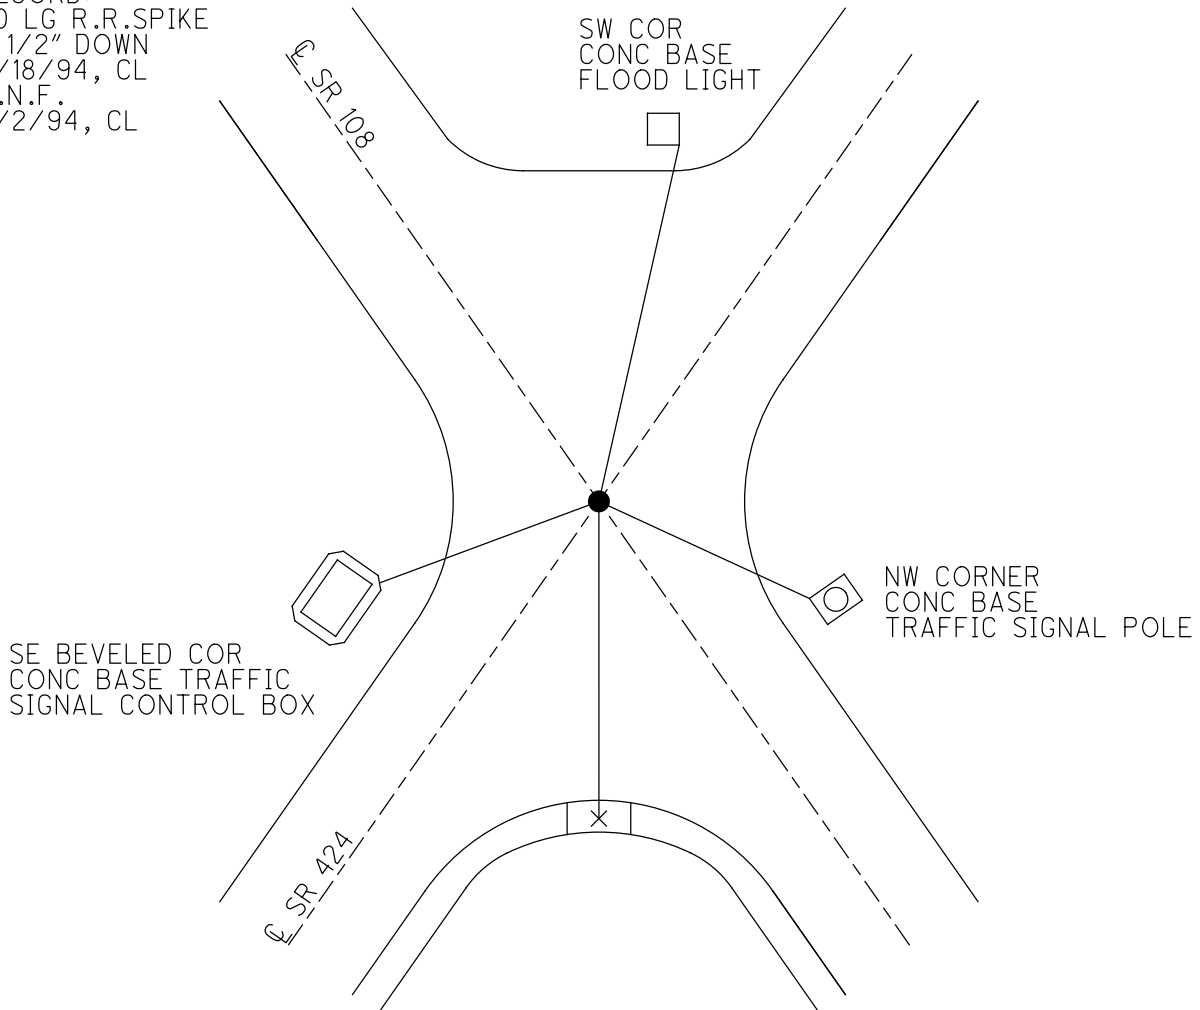

O.D.O.T. DISTRICT 2 SURVEY OFFICE

PERSONNEL

REFERENCE NO. 59-B

8
106. 29
SHEET 7 OF 6

NOTES D. CURTIS MB

9/03/04

H.C. LOEHRKE MC

DATE 4-18-94

R.C. S. HOOKER

WEATHER _____

TEMP. _____

424
ROUTE S.R. 108

COUNTY HENRY



TOWNSHIP NAPOLEON

SECTION 13

T 5 N R 6 E

TYPE MONUMENT Mag Nail
TO R.R. SPK. - DID NOT FIND
ON SURFACE - BELOW 7 1/2" BELOW SURFACE
LEFT & PAV'T. - RIGHT & BOTH PAV'T.'S ✓
✓ TO ✓ EDGE PAVEMENT

S.L.M. 836+50 516+19

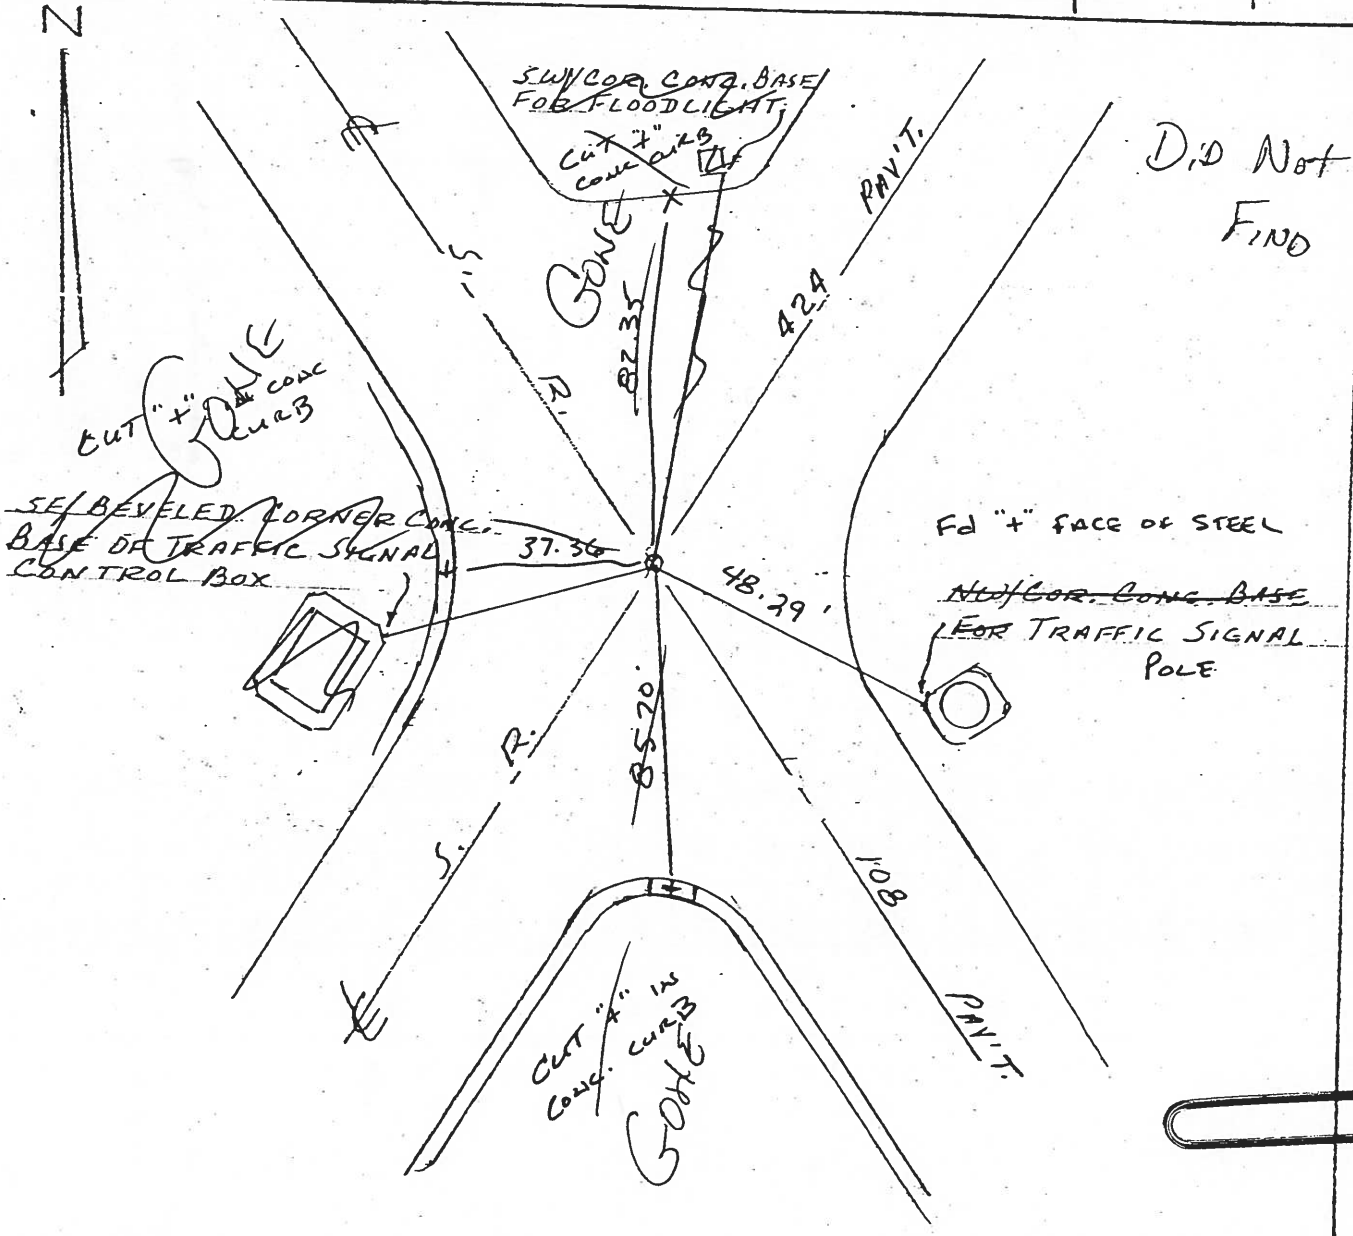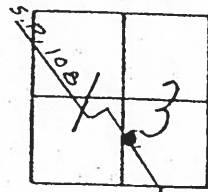

O.D.O.T. DISTRICT 2 SURVEY OFFICE

PERSONNEL _____

REFERENCE NO. 59-B

SHEET 3 OF 6

NOTES D. CURTIS

H.C. LOEHRKE

DATE 4-18-94

ROUTE S.R. 108

R.C. _____

WEATHER _____

COUNTY HENRY

TEMP. _____

TOWNSHIP NAPOLEON

SECTION 13

T 5 N R 6 E

TYPE MONUMENT LG. R.R. SPK. - DID NOT FIND
 ON SURFACE - BELOW 7 1/2" BELOW
 LEFT- & PAV'T. - RIGHT & BOTH PAV'T.'S
 / TO / EDGE PAVEMENT
 S.L.M. 836 + 50

