

O.D.O.T. DISTRICT 2 SURVEY OFFICE (USE ONLY)

PERSONNEL _____

REFERENCE NO. 59 C

SHEET 2 OF 14

NOTES CURTIS DATE 4/18/94

ROUTE SR 108

H.C. CANTERBURY WEATHER CLOUDY

COUNTY HENRY

R.C. CORDES TEMP. 60°
HERMILLER, VOGEL

TOWNSHIP NAPOLEON

DWG BY NIESE PID _____

SECTION 13

T 5 N R 6 E

TYPE MONUMENT LG R.R SPIKE

ON SURFACE - ~~BELOW~~ ON


OFFSET ☉ PAVEMENT ON LT : RT

- TO - EDGE PAVEMENT


STATION: 838+08

HORIZ.DATUM: _____ GEOID: _____

GRID: NORTHING: _____ EASTING: _____

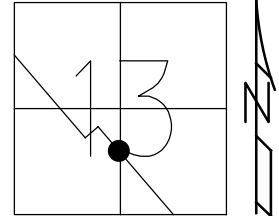

RECORD:
 FD LG R.R. SPIKE
 4/18/94, MC
 SET P.K./WAHER
 8/2/94, CL

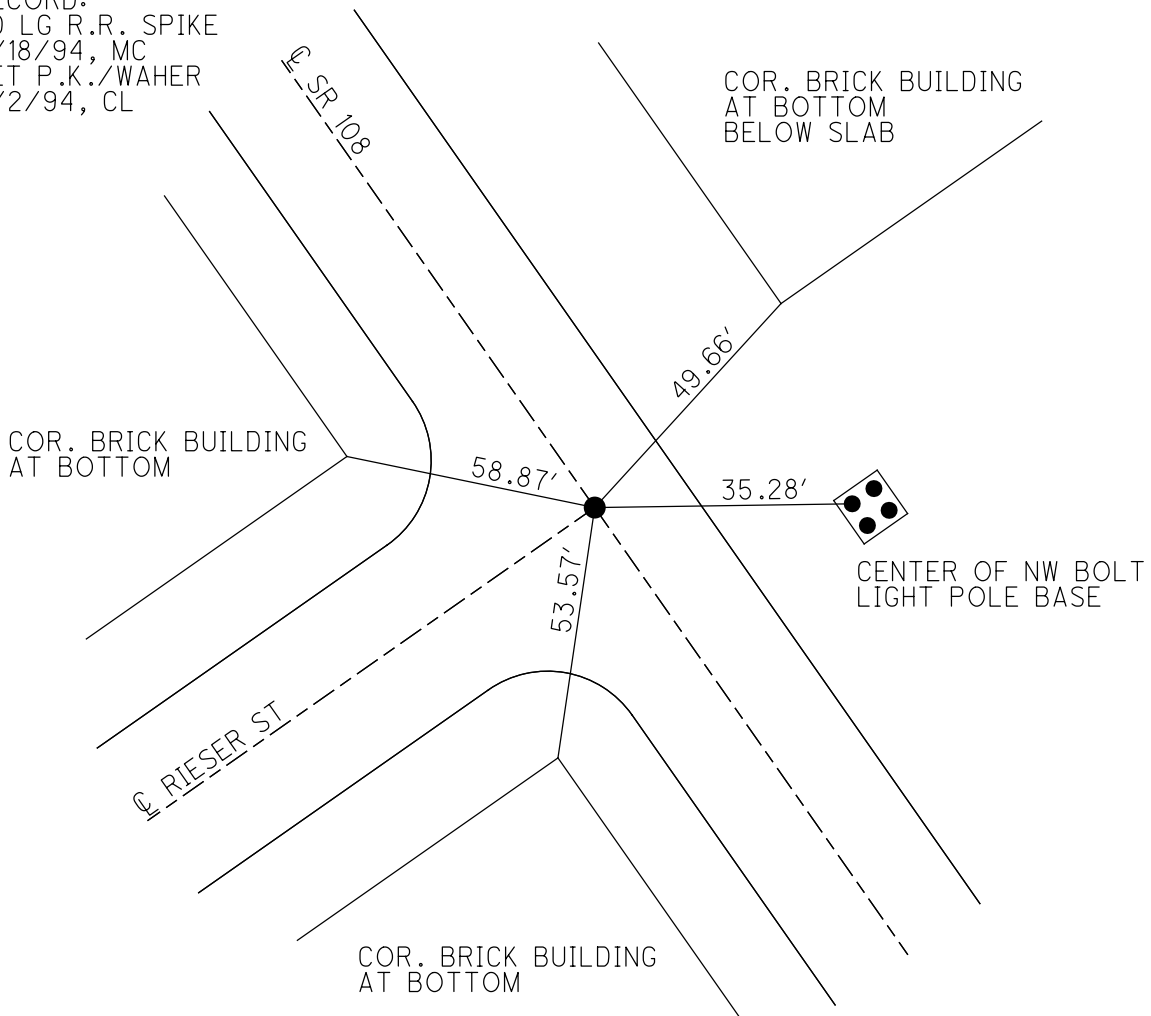

O.D.O.T. DISTRICT 2 SURVEY OFFICE

PERSONNEL

REFERENCE NO. 59-C

SHEET 4 OF 6

NOTES D. CURTIS

H.C. CANTERBURY

DATE 4-18-94

ROUTE S.R. 108

R.C. CORDS

WEATHER Cloudy

COUNTY HENRY

HERMILLER

TEMP. + 60

TOWNSHIP NAPOLEON

VOGEL


SECTION 13

Sat PK. / WASHER

T 5 N R 6 E

TYPE MONUMENT LG. R.R. SPK.
 ON SURFACE BELOW ON SURFACE
 LEFT- & PAV'T. - RIGHT & BOTH PAV'T.
TO EDGE PAVEMENT

8-2-94
C.L.

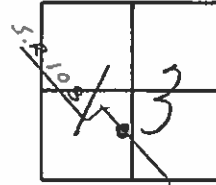

S.L.M. 838+08

