

O.D.O.T. DISTRICT 2 SURVEY OFFICE (USE ONLY)

PERSONNEL

REFERENCE NO. 59 D

SHEET 3 OF 14

NOTES CURTIS  
 H.C. CANTERBURY  
 R.C. HERMILLER  
CORDES, VOGEL

DATE 4/18/94  
 WEATHER CLOUDY  
 TEMP. 60°

ROUTE SR 108  
 COUNTY HENRY  
 TOWNSHIP NAPOLEON  
 SECTION 13

DWG BY NIESE PID \_\_\_\_\_

T 5 N R 6 E

TYPE MONUMENT P.K. NAIL

ON SURFACE - ~~BELOW~~ ON


OFFSET ☉ PAVEMENT ON LT : RT

- TO - EDGE PAVEMENT


STATION: 846+04

HORZ.DATUM: \_\_\_\_\_ GEOID: \_\_\_\_\_

GRID: NORTHING: \_\_\_\_\_ EASTING: \_\_\_\_\_

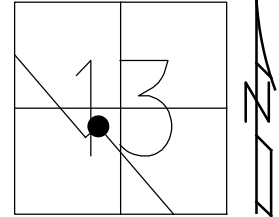

RECORD:  
 FD P.K. NAIL  
 4/18/94, MC  
 SET P.K./WASHER  
 8/2/94, CL

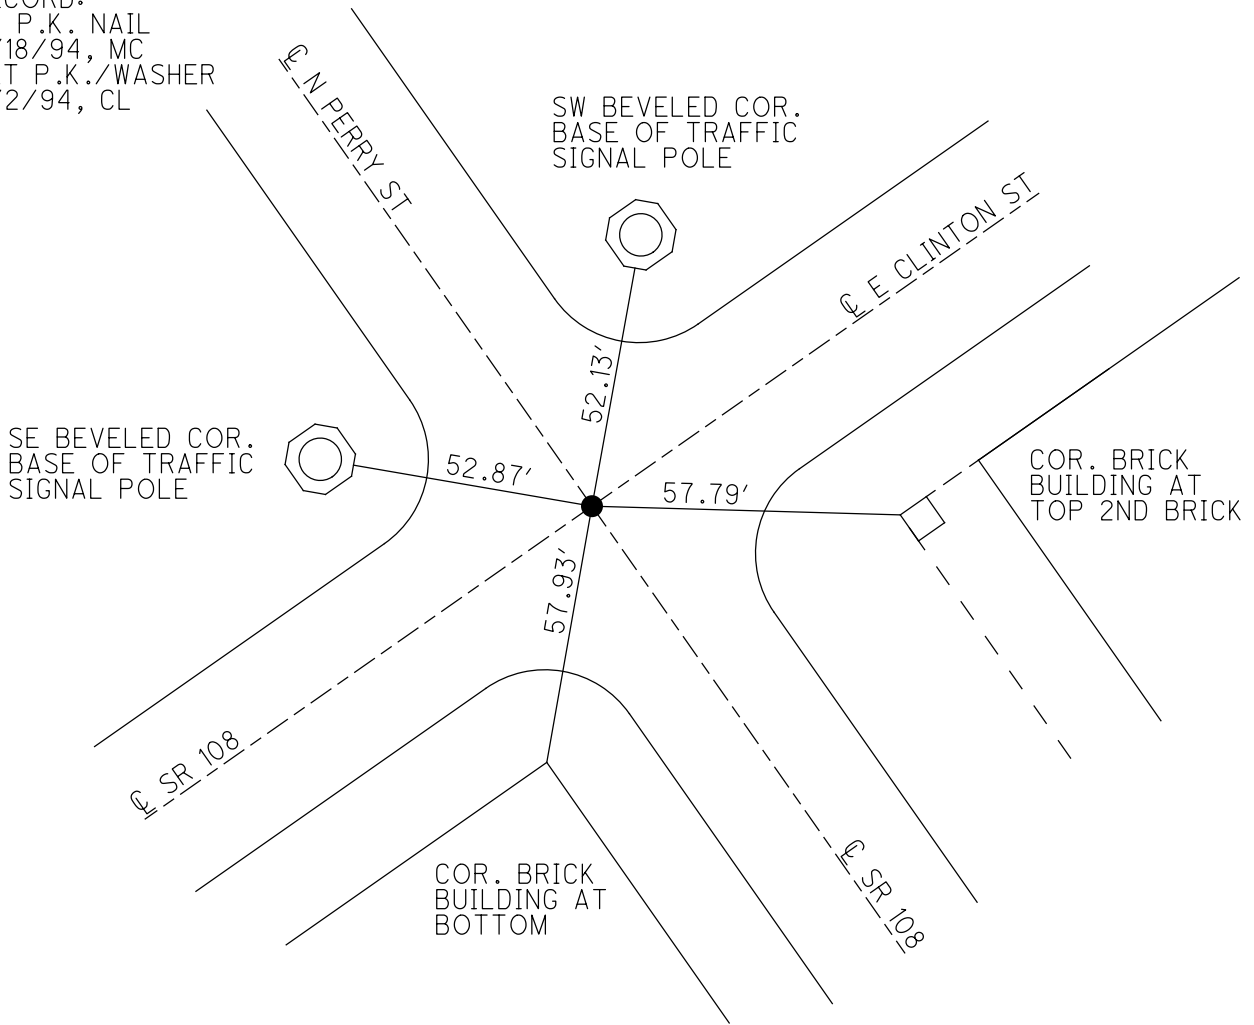

# O.D.O.T. DISTRICT 2 SURVEY OFFICE

PERSONNEL

REFERENCE NO. 59-7

SHEET 5 OF 6

NOTES D. CURTIS

H.C. CANTERBURY

DATE 4-18-94

ROUTE S.R. 108

R.C. HEMILLER

WEATHER Cloudy

COUNTY HENRY

CORDS

TEMP. +60

TOWNSHIP NAPOLEON

VOGEL

SECTION 13

T 5 N R 6 E

TYPE MONUMENT P.K. NAIL Set P.K. / WASHER B-2-94

ON SURFACE - BELOW ON SURFACE C.L.

LEFT- & PAV'T. - RIGHT & BOTH PAV'T'S

TO EDGE PAVEMENT

S.L.M. 846+04

