

O.D.O.T. DISTRICT 2 SURVEY OFFICE (USE ONLY)

PERSONNEL \_\_\_\_\_

REFERENCE NO. 60

SHEET 4 OF 14

NOTES CURTIS

DATE 4/18/94

ROUTE SR 108

H.C. CANTERBURY

WEATHER RAIN

COUNTY HENRY

R.C. HERMILLER  
CORDES, VOGEL

TEMP. 60°

TOWNSHIP NAPOLEON

DWG BY NIESE PID \_\_\_\_\_

SECTION 13

T 5 N R 6 E

TYPE MONUMENT BOAT SPIKE

~~ON SURFACE~~ - BELOW 2"


OFFSET Q PAVEMENT 2.7' LT : ~~RT~~

18.0' TO LT EDGE PAVEMENT

STATION: 850+62

HORIZ.DATUM: \_\_\_\_\_ GEOID: \_\_\_\_\_


GRID: NORTHING: \_\_\_\_\_ EASTING: \_\_\_\_\_

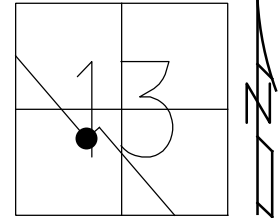

RECORD:  
FD BOAT SPIKE  
4/18/94, MC  
SET P.K./WASHER  
8/2/94, CL

DIST.60-60A= 51.90'

"+" CUT SW  
COR. CONC BASE  
TRAFFIC SIGNAL

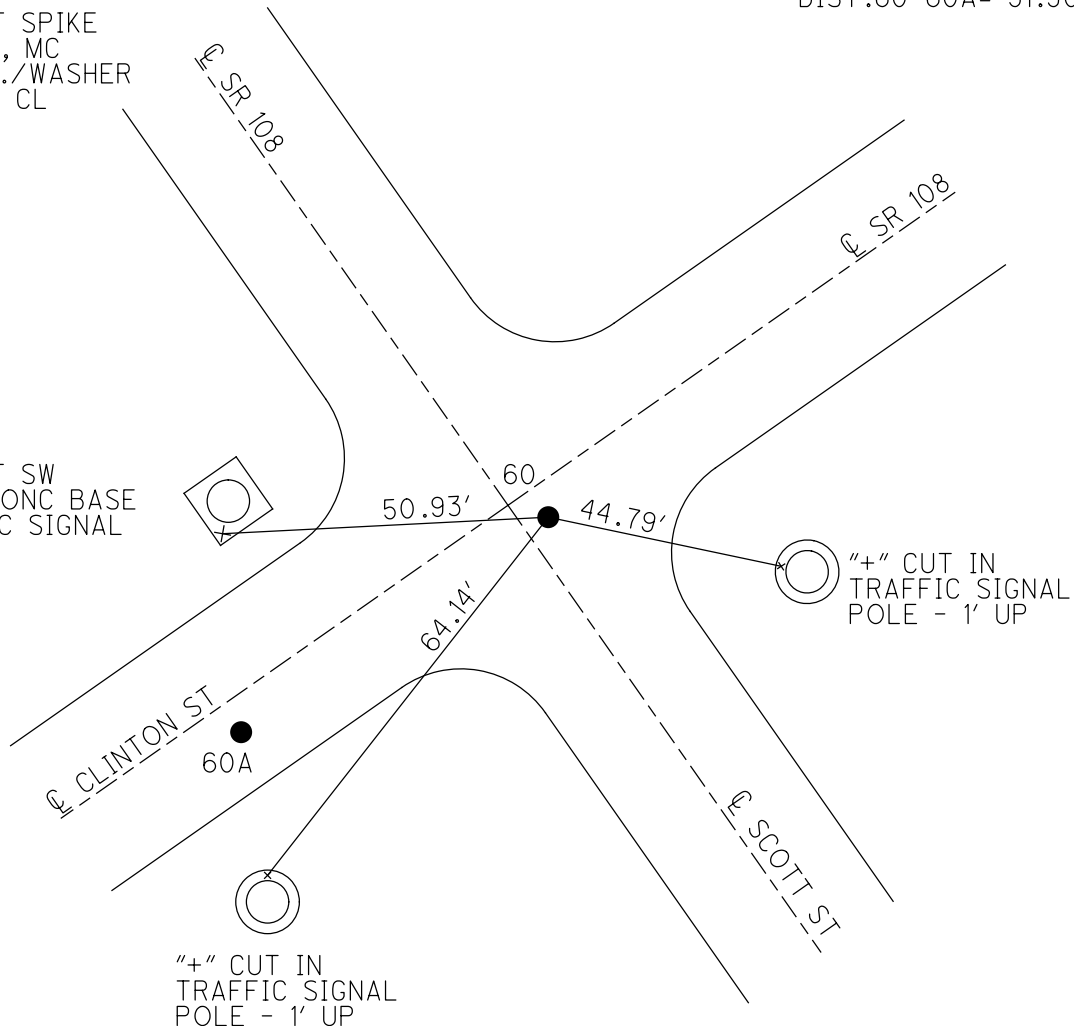

# O.D.O.T. DISTRICT 2 SURVEY OFFICE

PERSONNEL

REFERENCE NO. 60

SHEET 6 OF 6

NOTES D. CURTIS

H.C. CANTERBURY

DATE 4-18-94

ROUTE S.R. 108

R.C. HERMILLER

WEATHER RAIN

COUNTY HENRY

CORDS

TEMP. +60

TOWNSHIP NAPOLEON


VOGEL

SECTION 13


Set P.K. / WASHER 8-2-94

T 5 N R 6 E

TYPE MONUMENT BOAT SPIKES - BOTH PT.'S C.L.  
 ON SURFACE - BELOW 2" BELOW - BOTH PT.'S  
 LEFT - PAV'T. - RIGHT 2.7' Lt. - BOTH PT.'S  
18' TO Lt. EDGE PAVEMENT

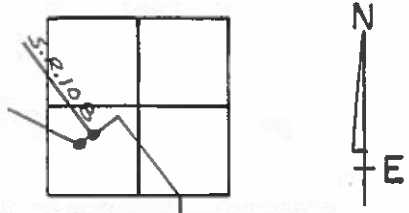

S.L.M. (A) 850+62 (B) 851+13 (S.R. 108 EXT.)

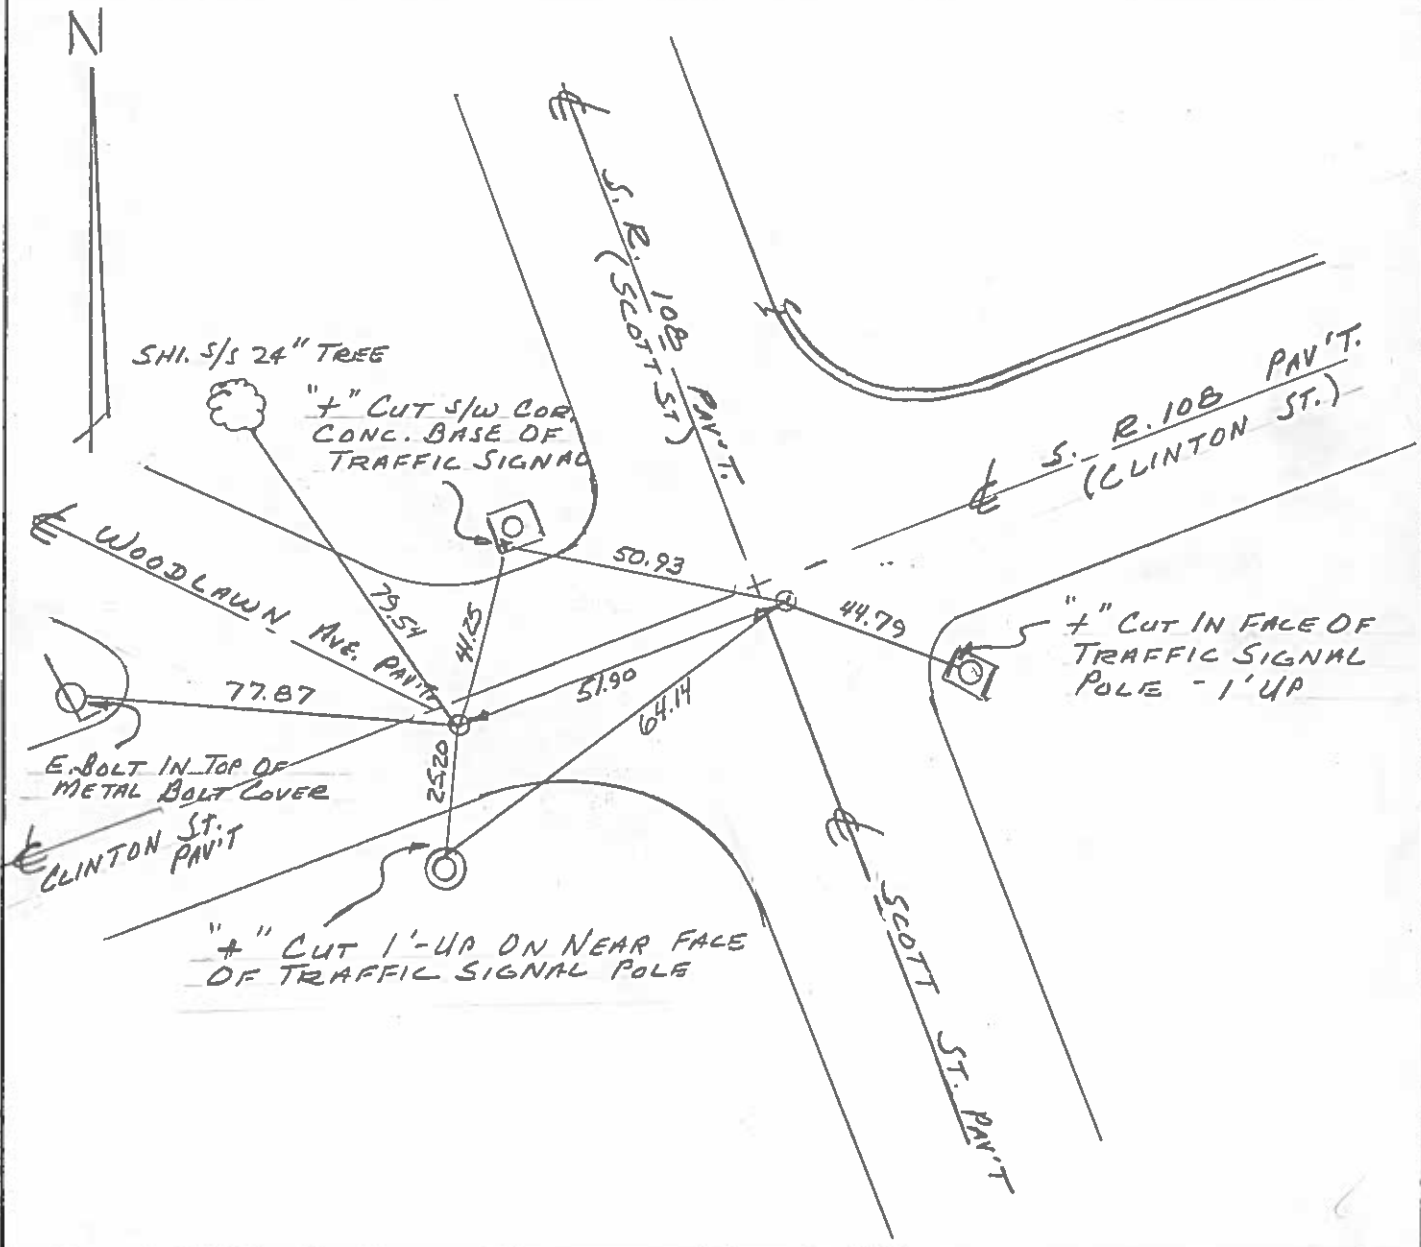

# O.D.O.T. DISTRICT 2 SURVEY OFFICE

PERSONNEL

REFERENCE NO. 60

SHEET 12 OF 33

NOTES HOFFMAN

H.C. BARHISEK

DATE 3-25-88

ROUTE SR 108

R.C. LOSHKLE

WEATHER P. CLEAR

COUNTY HENRY

REED

TEMP. 60°

TOWNSHIP NAPOLEON

SECTION 13

T.S. N R 6 E


TYPE MONUMENT BOAT SPIKE - BOTH Points

~~ON SURFACE~~ - BELOW 1 1/2"


LEFT - CL PAV'T. - RIGHT 2.7'

18.1 TO LT EDGE PAVEMENT

S.L.M. 850+08

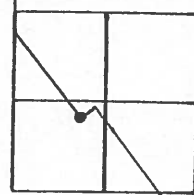

850+72.97 P.T. "A"  
1966 PLAN

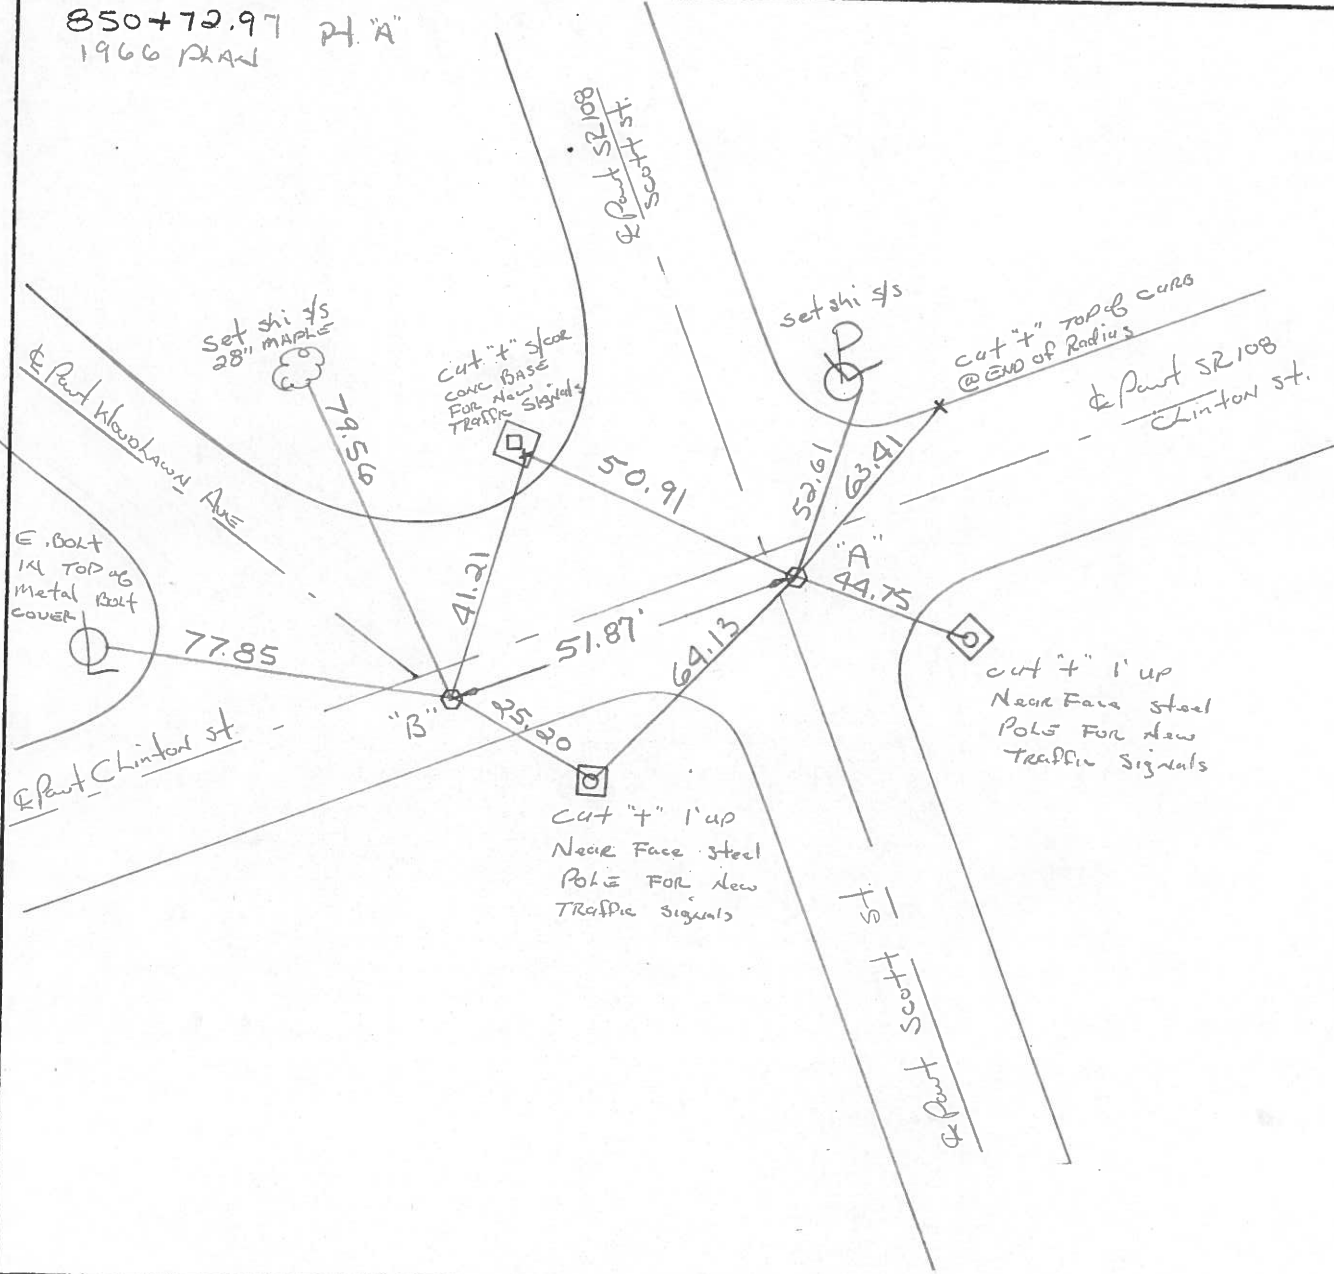

O.D.O.T. DISTRICT 2 SURVEY OFFICE

Sht. 12 of 19  
S.R.108

County HENRY

Date 5-17-78

Township NAPOLEON


Weather CLEAR

Section \_\_\_\_\_

Temp. +72°


T5N, R6E

Personnel BURNSIDE

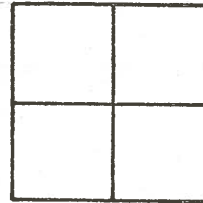

SMITH  
KNAPE  
MEAD

#60

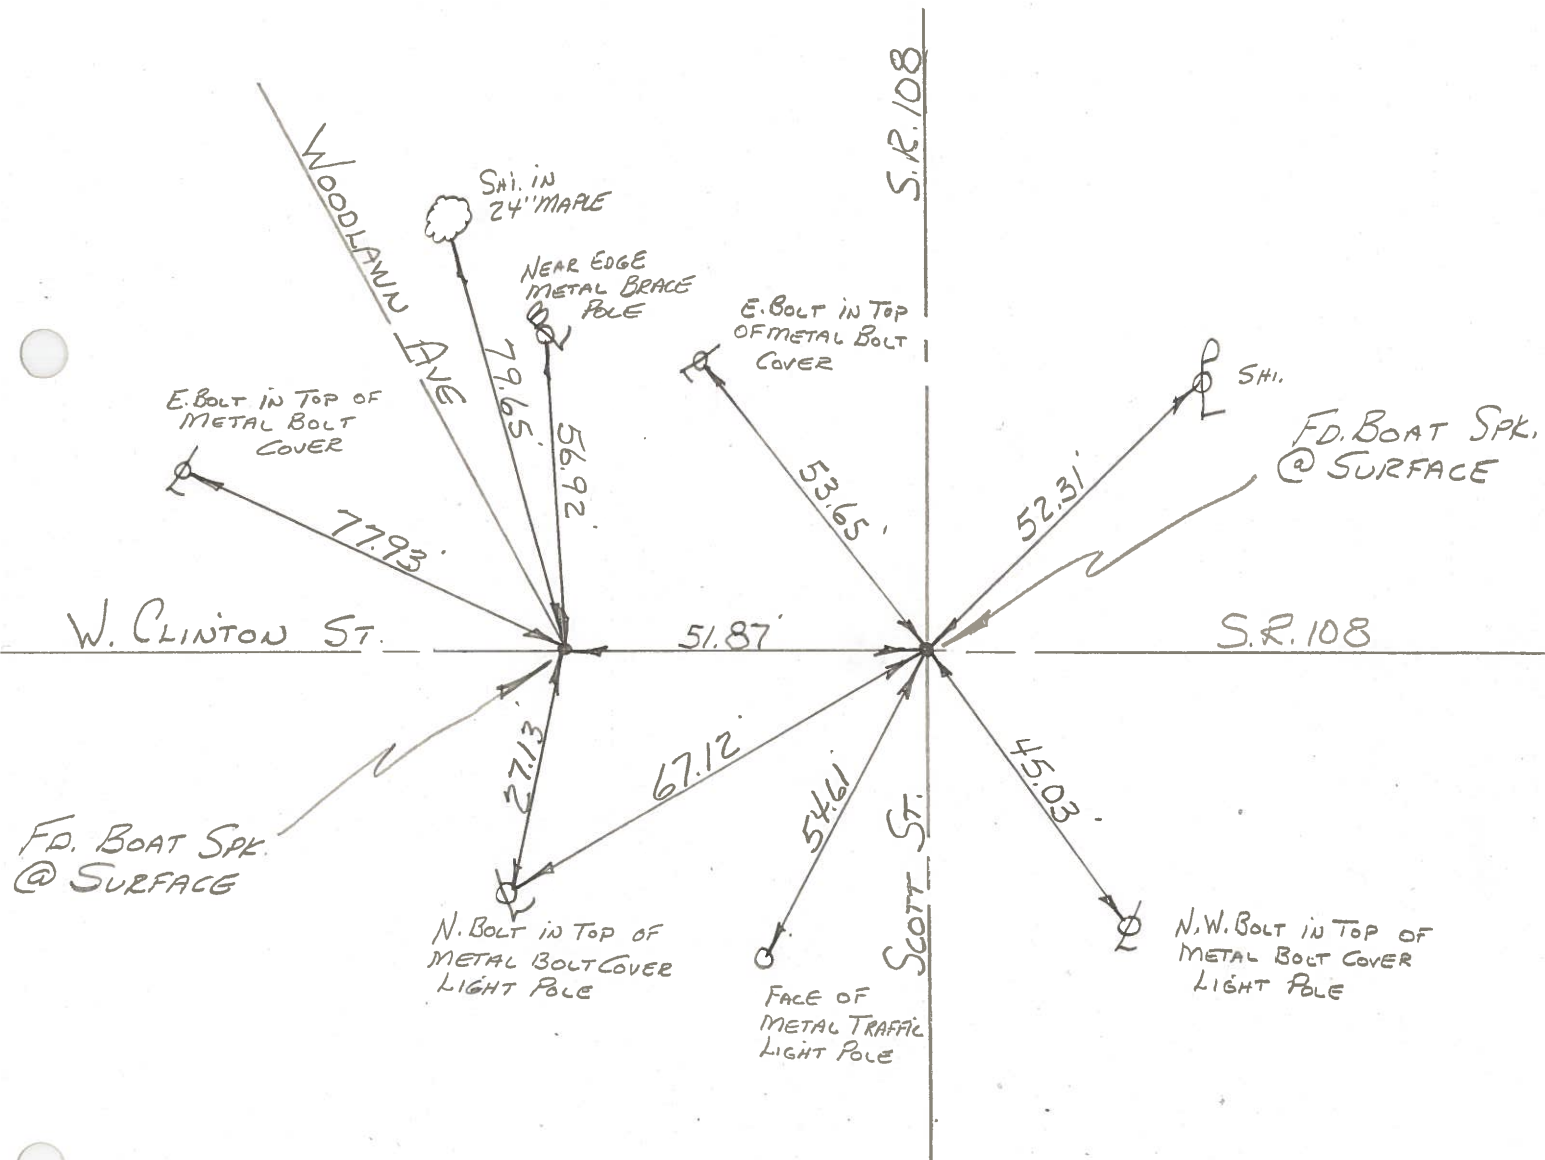

PERSONNEL	TITLE	PERSONNEL	TITLE	COUNTY	DATE	WEATHER	TEMP.
Tomsic				HENRY	Sept. 17, 1951		
Neuser				S. R. 108			
Vandy				SEC. NAPOLEON TWP			
Granata							

DESCRIPTION Napoleon, O. LEFT CENTER LINE RIGHT JOB NO. \_\_\_\_\_

