

O.D.O.T. DISTRICT 2 SURVEY OFFICE (USE ONLY)

PERSONNEL

REFERENCE NO. 60 A

SHEET 5 OF 14

NOTES CURTIS  
 H.C. CANTERBURY  
 R.C. HERMILLER  
CORDES, VOGEL

DATE 4/18/94  
 WEATHER RAIN  
 TEMP. 60°

ROUTE SR 108  
 COUNTY HENRY  
 TOWNSHIP NAPOLEON  
 SECTION 13

DWG BY NIESE PID \_\_\_\_\_

T 5 N R 6 E

TYPE MONUMENT BOAT SPIKE

~~ON SURFACE~~ - BELOW 2"

OFFSET  $\varnothing$  PAVEMENT 2.7' LT : ~~RT~~

18.0' TO LT EDGE PAVEMENT


STATION: 851+13

HORZ. DATUM: \_\_\_\_\_

GEOID: \_\_\_\_\_


GRID: NORTHING: \_\_\_\_\_

EASTING: \_\_\_\_\_

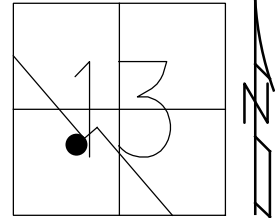

RECORD:  
 FD BOAT SPIKE  
 4/18/94, MC  
 SET P.K./WASHER  
 8/2/94, CL

DIST. 60-60A = 51.90'

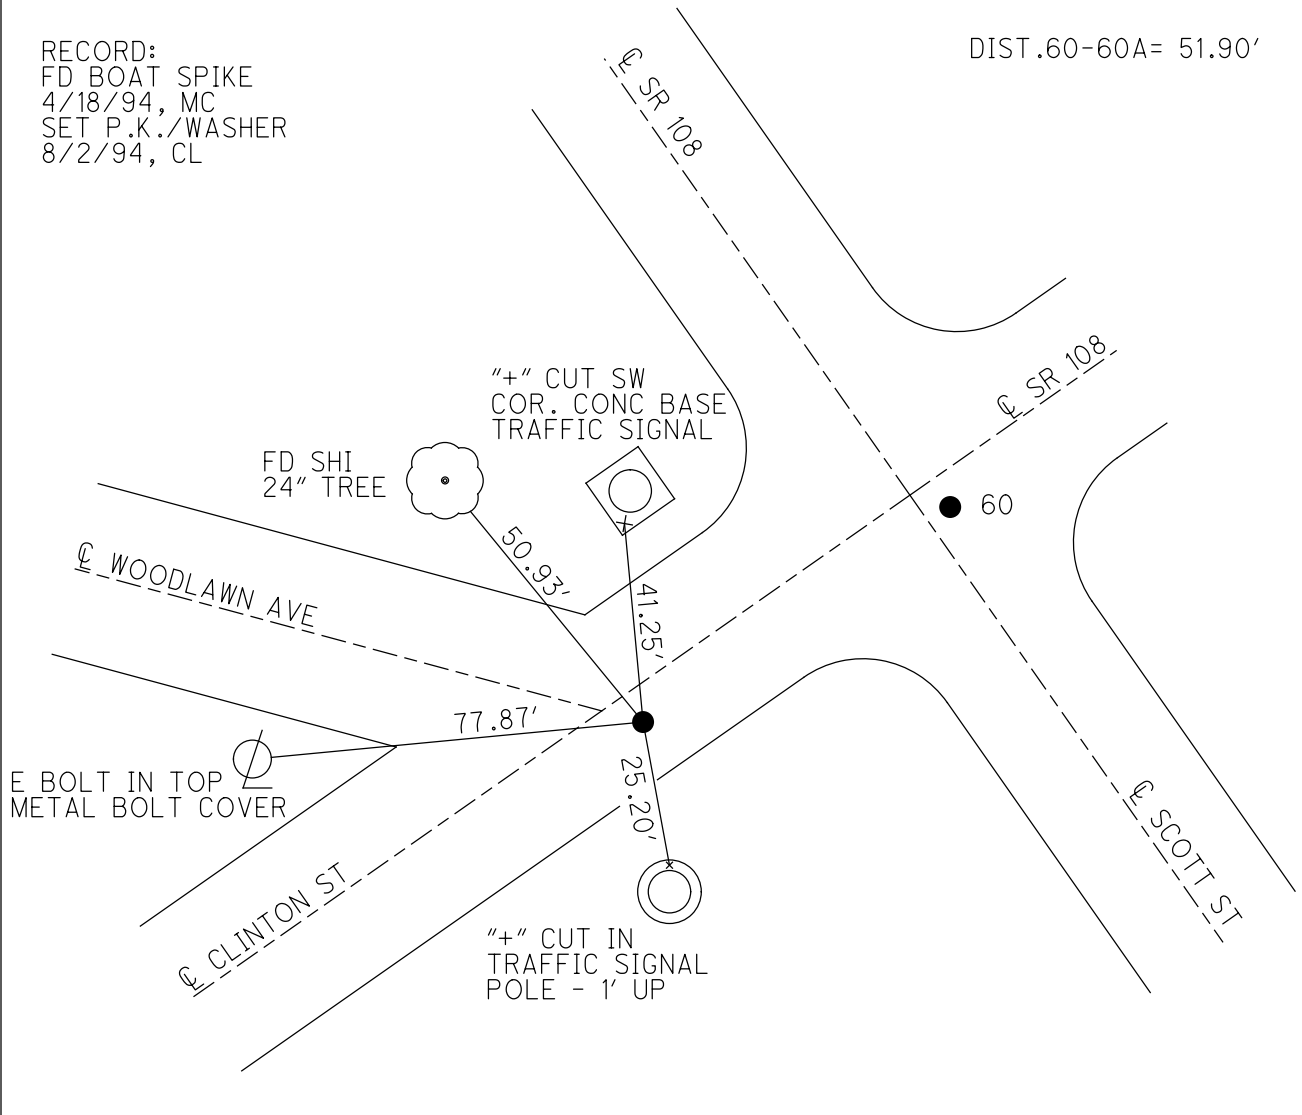

# O.D.O.T. DISTRICT 2 SURVEY OFFICE

PERSONNEL

REFERENCE NO. 60

SHEET 6 OF 6

NOTES D. CURTIS

H.C. CANTERBURY

DATE 4-18-94

ROUTE S.R. 108

R.C. HERMILLER

WEATHER RAIN

COUNTY HENRY

CORDS

TEMP. +60

TOWNSHIP NAPOLEON


VOGEL

SECTION 13


Set P.K. / WASHER 8-2-94

T 5 N R 6 E

TYPE MONUMENT BOAT SPIKES - BOTH PT.'S C.L.  
 ON SURFACE - BELOW 2" BELOW - BOTH PT.'S  
 LEFT - PAV'T. - RIGHT 2.7' Lt. - BOTH PT.'S  
18' TO Lt. EDGE PAVEMENT

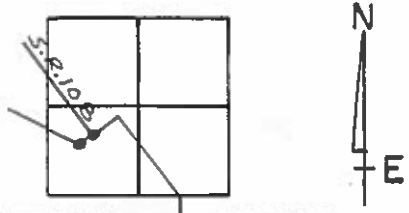

S.L.M. (A) 850+62 (B) 851+13 (S.R. 108 EXT.)

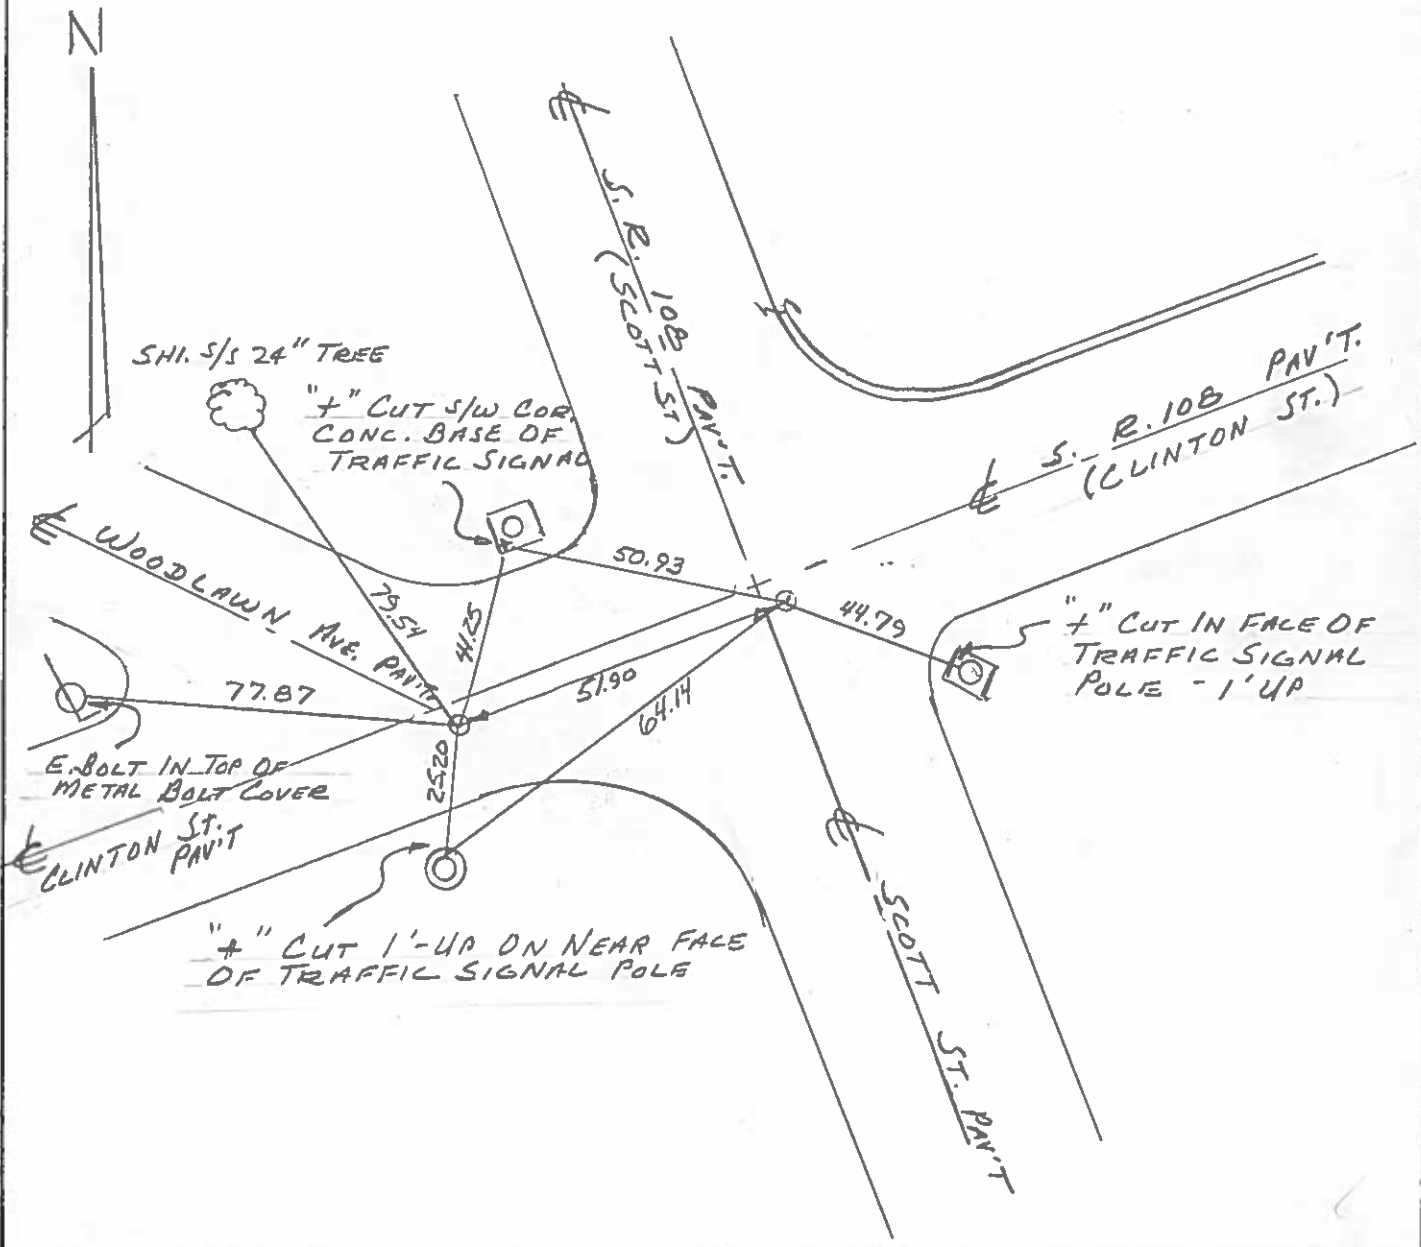

O.D.O.T. DISTRICT 2 SURVEY OFFICE

PERSONNEL

REFERENCE NO. 60

SHEET 12 OF 33

NOTES Hoffman

H.C. Bardhisak

DATE 3-25-88

ROUTE SR 108

R.C. Loehrls

WEATHER P.CLEAR

COUNTY Henry

REED

TEMP. 60°

TOWNSHIP NAPOLION

SECTION 13

T S N R 6 E


TYPE MONUMENT Boat SPIKE - BOTH Points

~~ON SURFACE~~ - BELOW 1 1/2"


LEFT - ¢ PAV'T. - RIGHT 2.7'

18.1 TO Lt EDGE PAVEMENT

S.L.M. 850+08

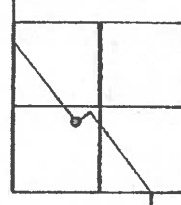

850+72.97 P.A.  
1966 DRAW

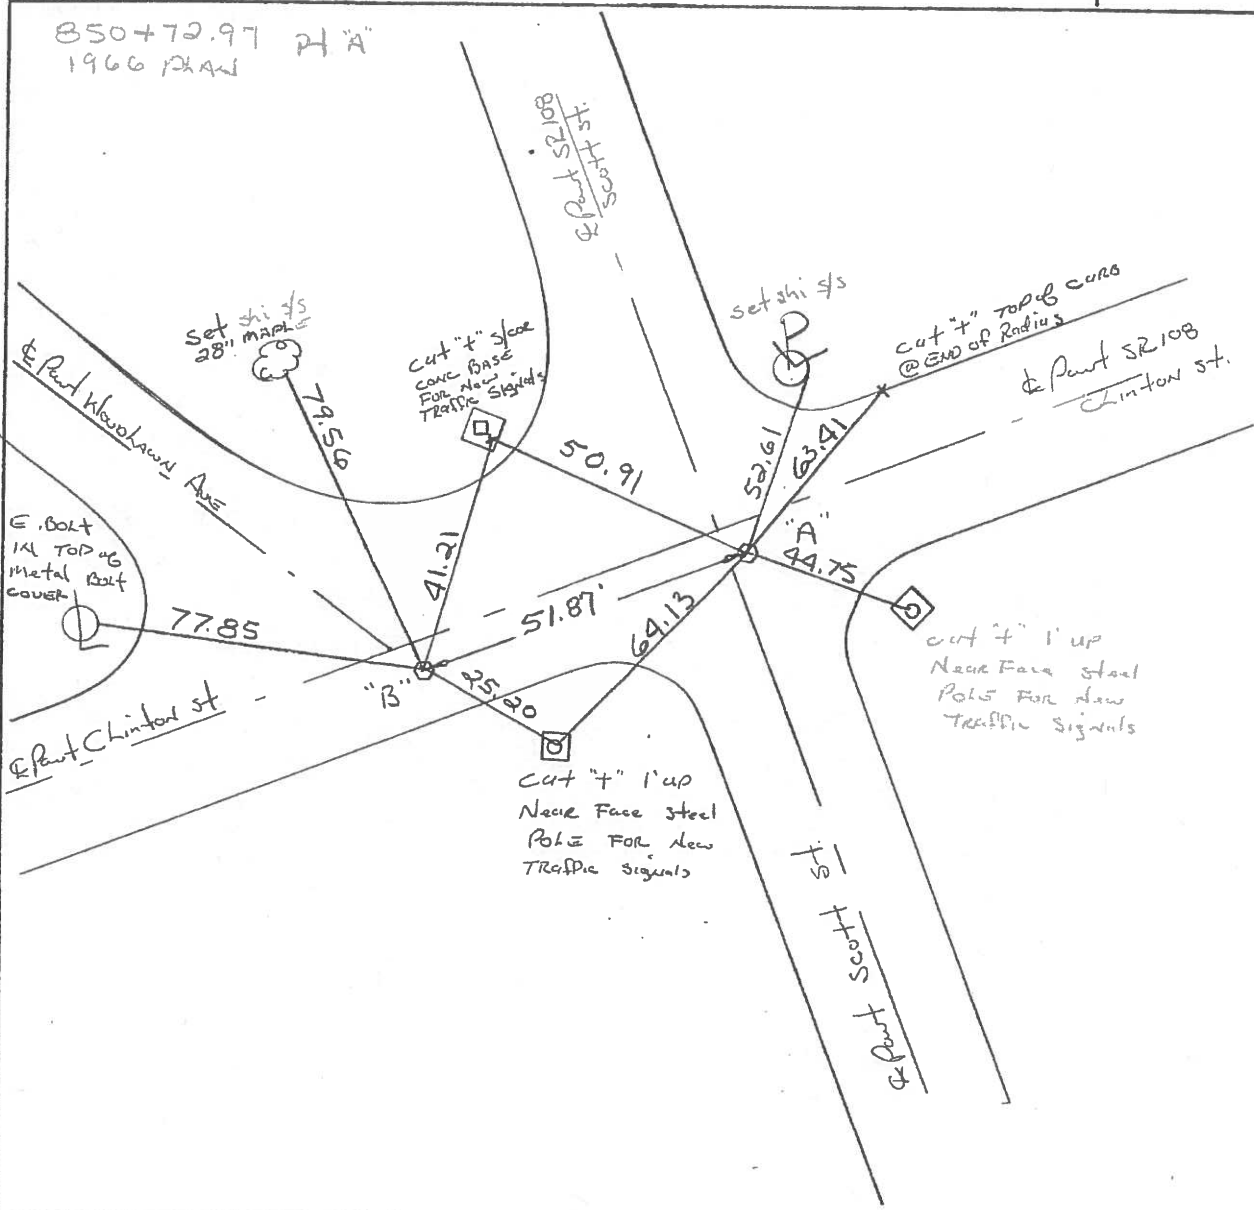

ODOT. DISTRICT 2 SURVEY OFFICE

Sht. 12 of 19  
S.R. 108

County HENRY

Date 5-17-78

Township NAPOLÉON

Weather CLEAR

Section \_\_\_\_\_

Temp. +72°


T5N, R6E

Personnel BURNSIDE

SMITH


KNAPE

MEAD

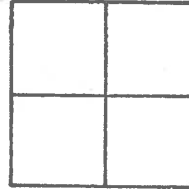

4B

#60

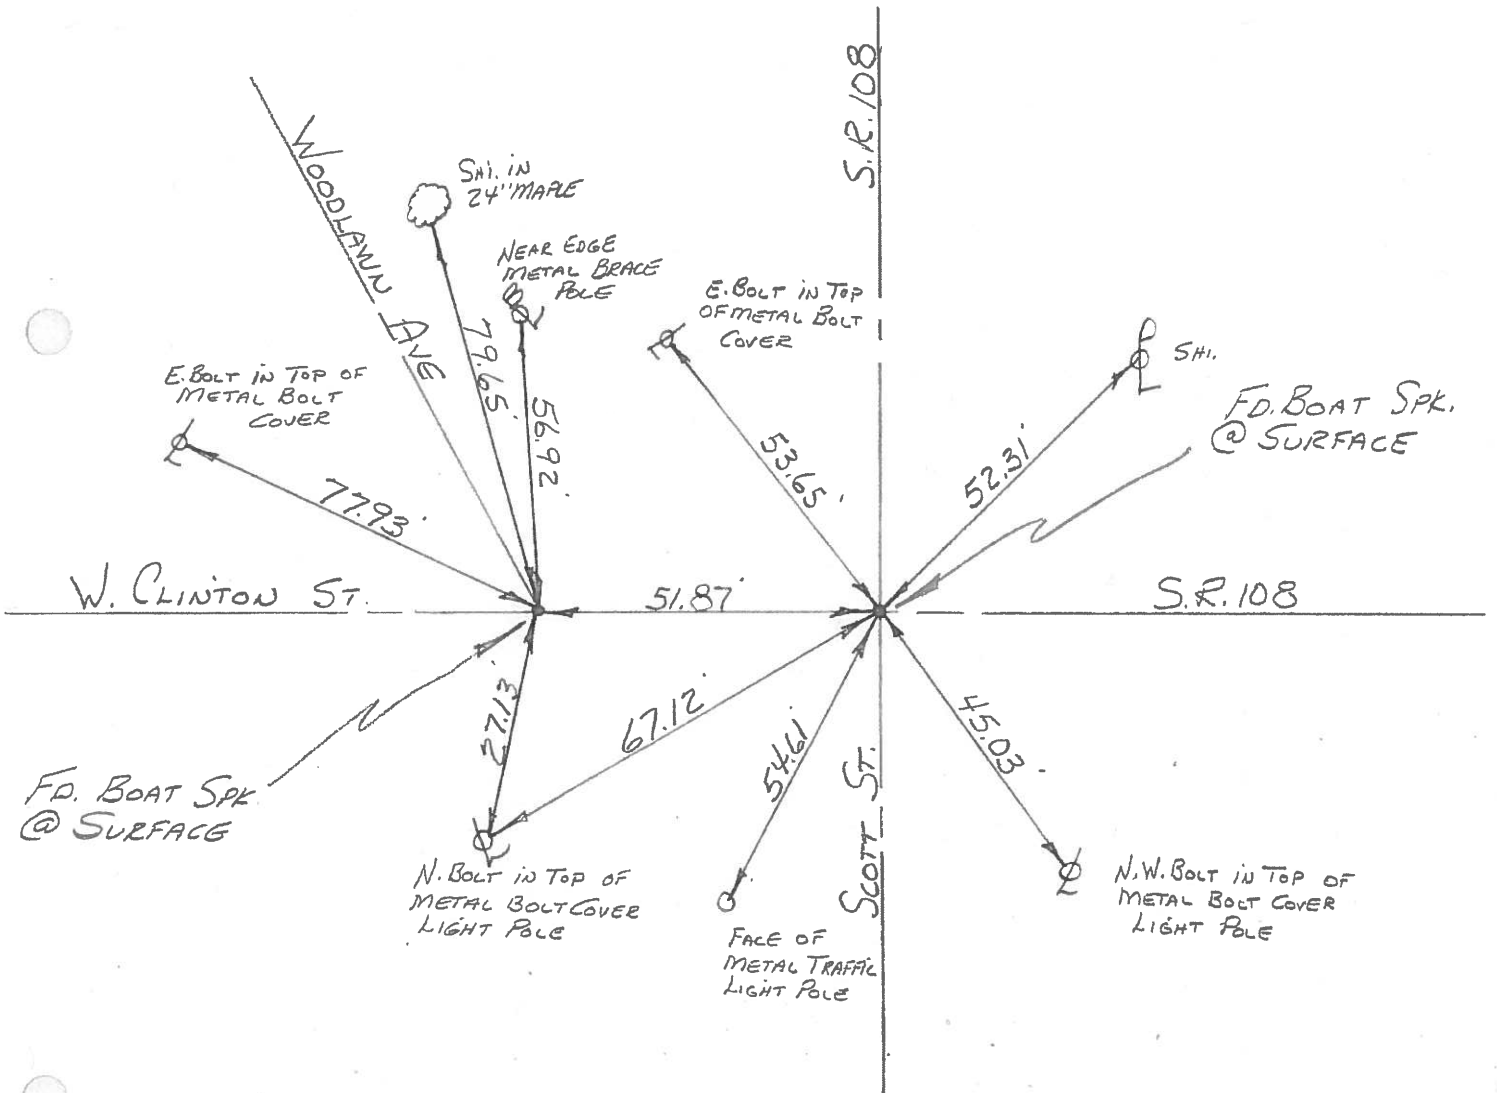

PERSONNEL TITLE PERSONNEL TITLE  
 Tomisk \_\_\_\_\_  
 Neuser \_\_\_\_\_  
 Vanyo \_\_\_\_\_  
 Granata \_\_\_\_\_

COUNTY HENRY DATE Sept. 17, 1977

S. R. 108 WEATHER \_\_\_\_\_

SEC. NAPOLEON TWP TEMP. \_\_\_\_\_

DESCRIPTION Napoleon, O. JOB NO. \_\_\_\_\_  
 LEFT CENTER LINE RIGHT

