

O.D.O.T. DISTRICT 2 SURVEY OFFICE (USE ONLY)

PERSONNEL _____

REFERENCE NO. 62

SHEET 7 OF 14

NOTES MOSER

DATE 8/2/01

ROUTE SR 108

H.C. CANTERBURY

WEATHER CLEAR

COUNTY HENRY

R.C. MOSER

TEMP. 75°

TOWNSHIP NAPOLEON

SECTION 13

DWG BY NIESE PID _____

T 5 N R 6 E

TYPE MONUMENT SM. SPIKE

ON SURFACE - ~~BELOW~~ ON


OFFSET 0 PAVEMENT ON LT : RT

14.5' TO LT EDGE PAVEMENT


STATION: 859+93

HORIZ.DATUM: _____ GEOID: _____

GRID: NORTHING: _____ EASTING: _____

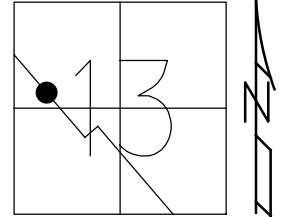

RECORD: P.I.
 STA 860+56.78
 FD SM SPIKE
 8/2/01, MRC
 SET P.K./WASHER
 11/15/01, MRC

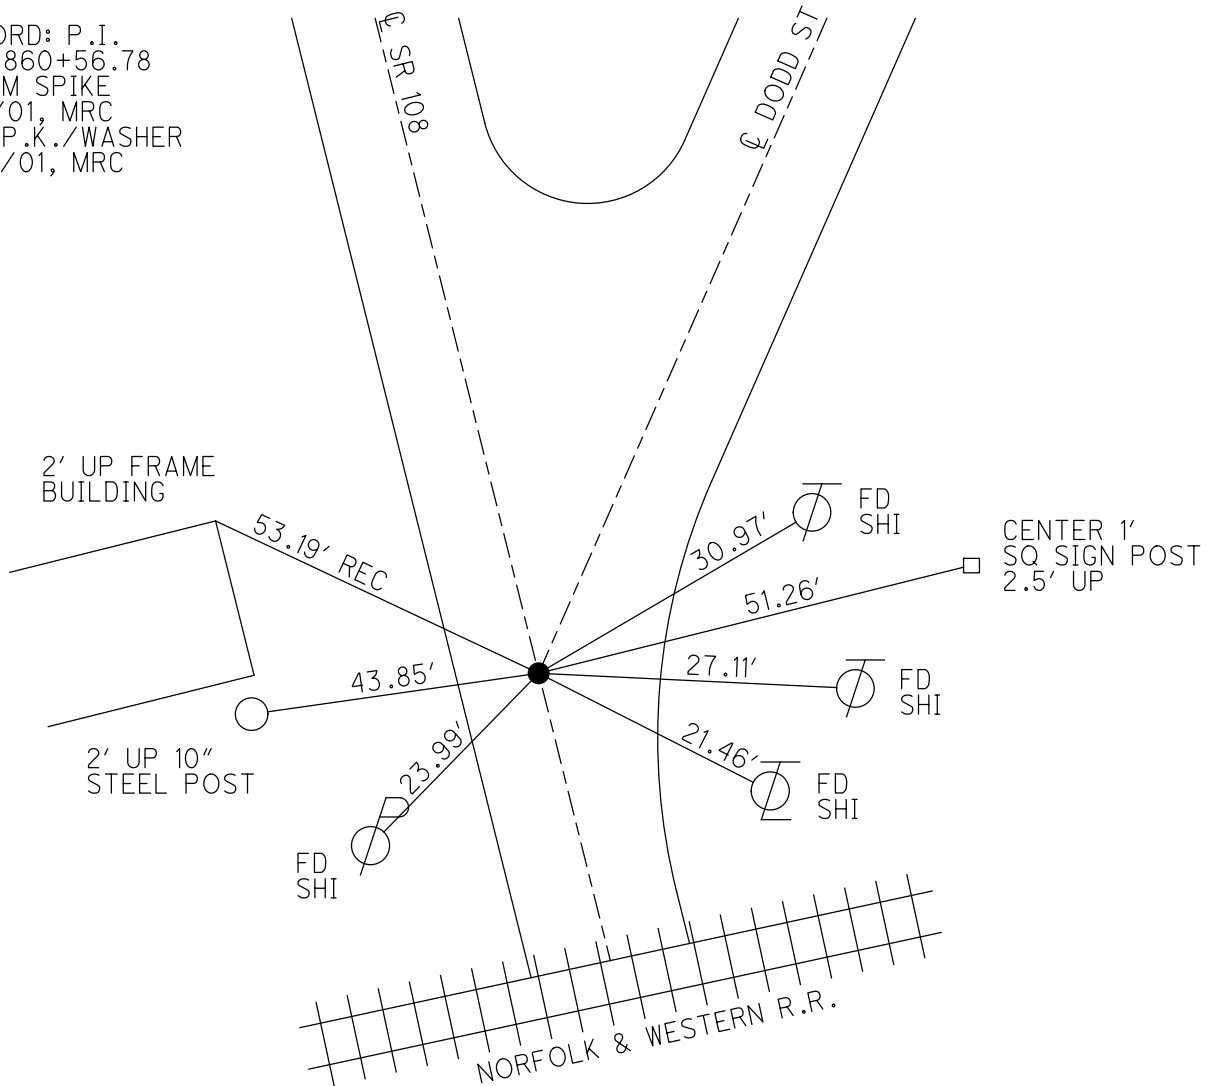

O.D.O.T. DISTRICT 2 SURVEY OFFICE

PERSONNEL

REFERENCE NO. 62

SHEET 2 OF 21

NOTES MOSEK

H.C. CANTERBURY

DATE 8-2-01

ROUTE 108

R.C. MOSEK

WEATHER CLEAR

COUNTY HENRY

TEMP. 75°F

TOWNSHIP NAPOLEON

SECTION 13

T 5 N R 6 E

TYPE MONUMENT SM. SPIKE



ON SURFACE ~~BELOW~~ ON

~~LEFT~~ - C. PAV'T. - ~~RIGHT~~ C.

14.5' TO LT. EDGE PAVEMENT

S.L.M. 859 + 93

RESET P.K./WASHER
 11/15/01
 M.R.C.

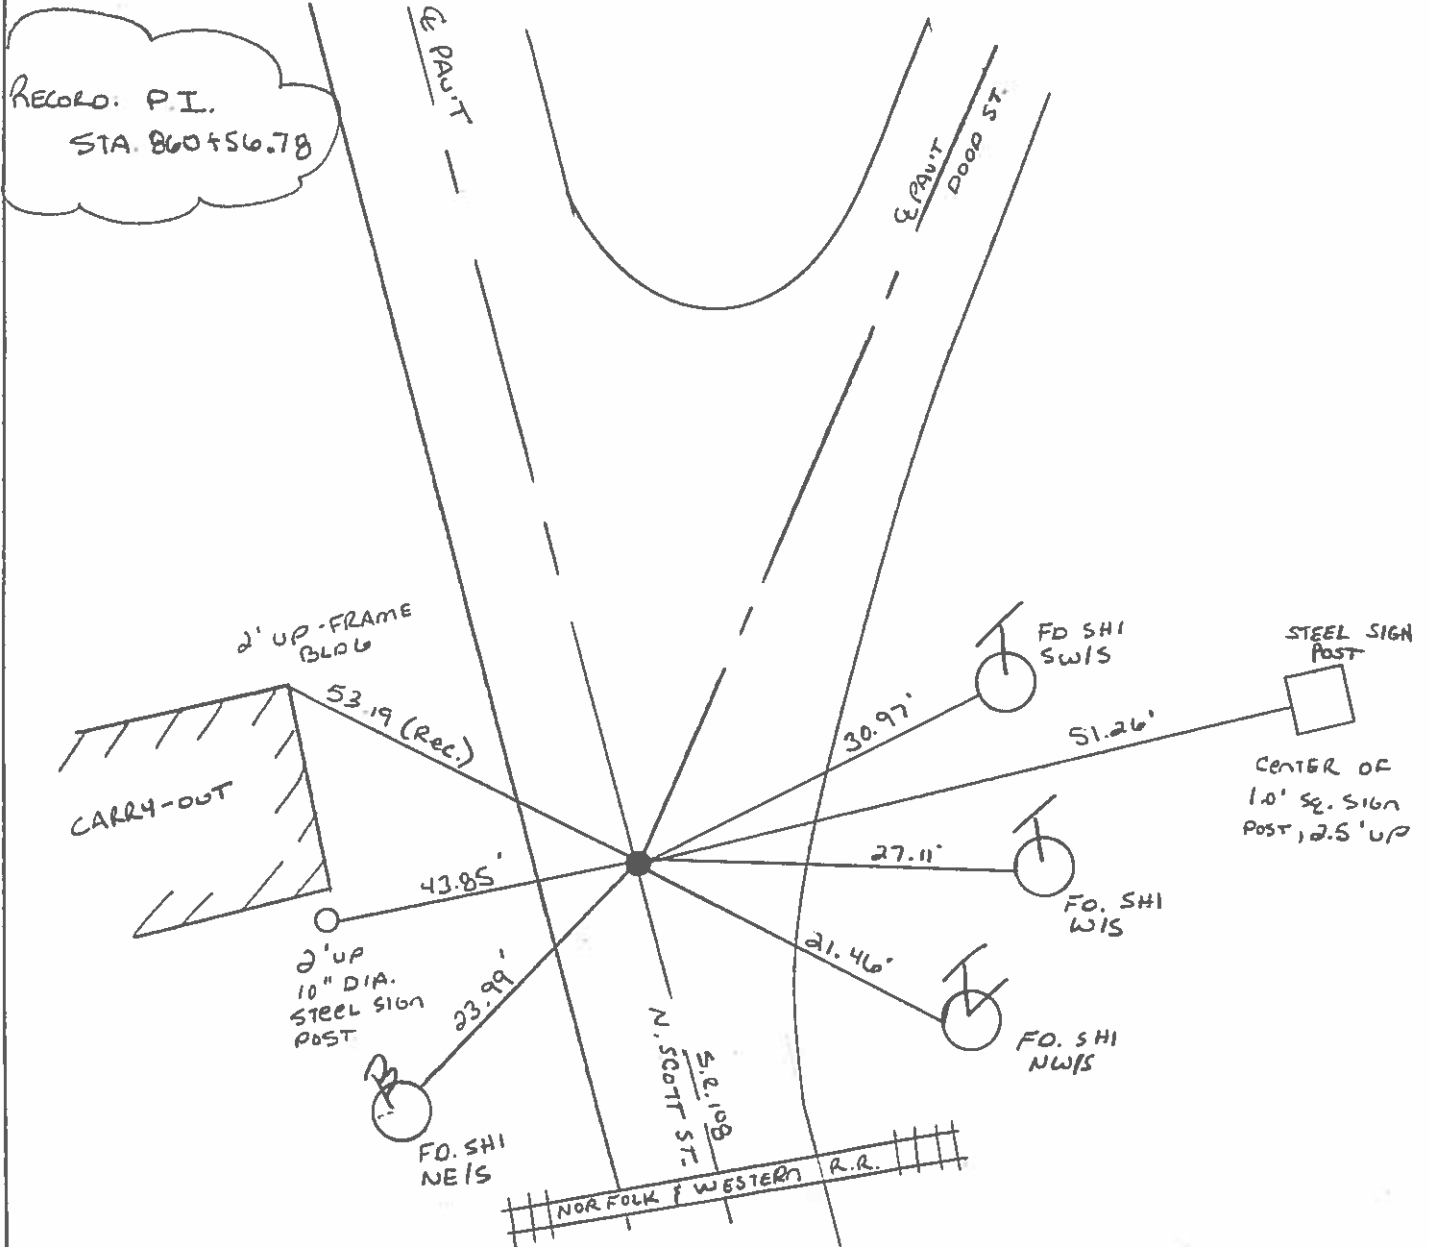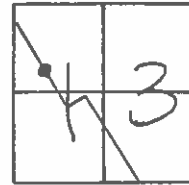

O.D.O.T. DISTRICT 2 SURVEY OFFICE

PERSONNEL _____

REFERENCE NO. 62

SHEET 14 OF 33

NOTES HOFFMAN

H.C. BARNHISEL

R.C. _____

DATE 3-29-88

WEATHER OVERCAST

TEMP. 60°

ROUTE SR 108

COUNTY HENRY

TOWNSHIP NAPOLÉON

SECTION 13

T S N R 6 E

TYPE MONUMENT 1" I. PIPE


~~ON SURFACE~~ - BELOW 3"

~~LEFT- & PAV'T. - RIGHT~~ YES


15.5 TO RT EDGE PAVEMENT

S.L.M. 859+93

Set SMALL
R.R. SPIKE
5-25-88 suok

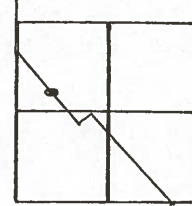

Record!
P.I. Sta. 860+56.78

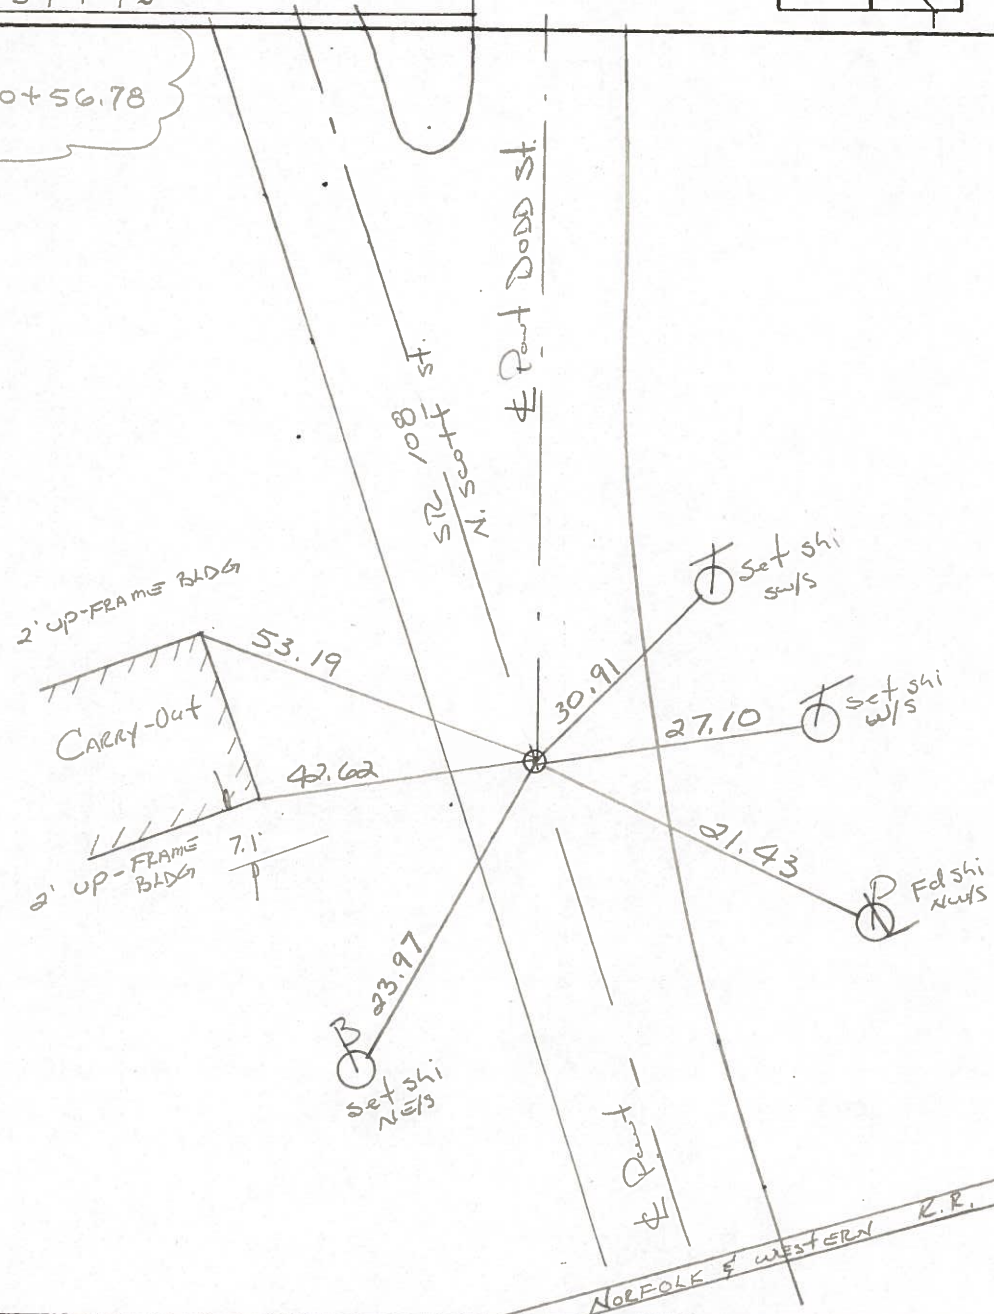

O.D.O.T. DISTRICT 2 SURVEY OFFICE

Sht. 14 of 19

S.R. 108

County HENRY

Date 8-30-77

Township NAPOLEON

Weather CLEAR

Section 13

Temp. +75°


T5N, R6E

Personnel BURNSIDE

SMITH

KNAPE


MEAD

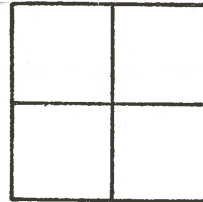

#6

P.I. STA. 860+56.78

FD. 1" I. PIPE 3"
BELOW SURFACE

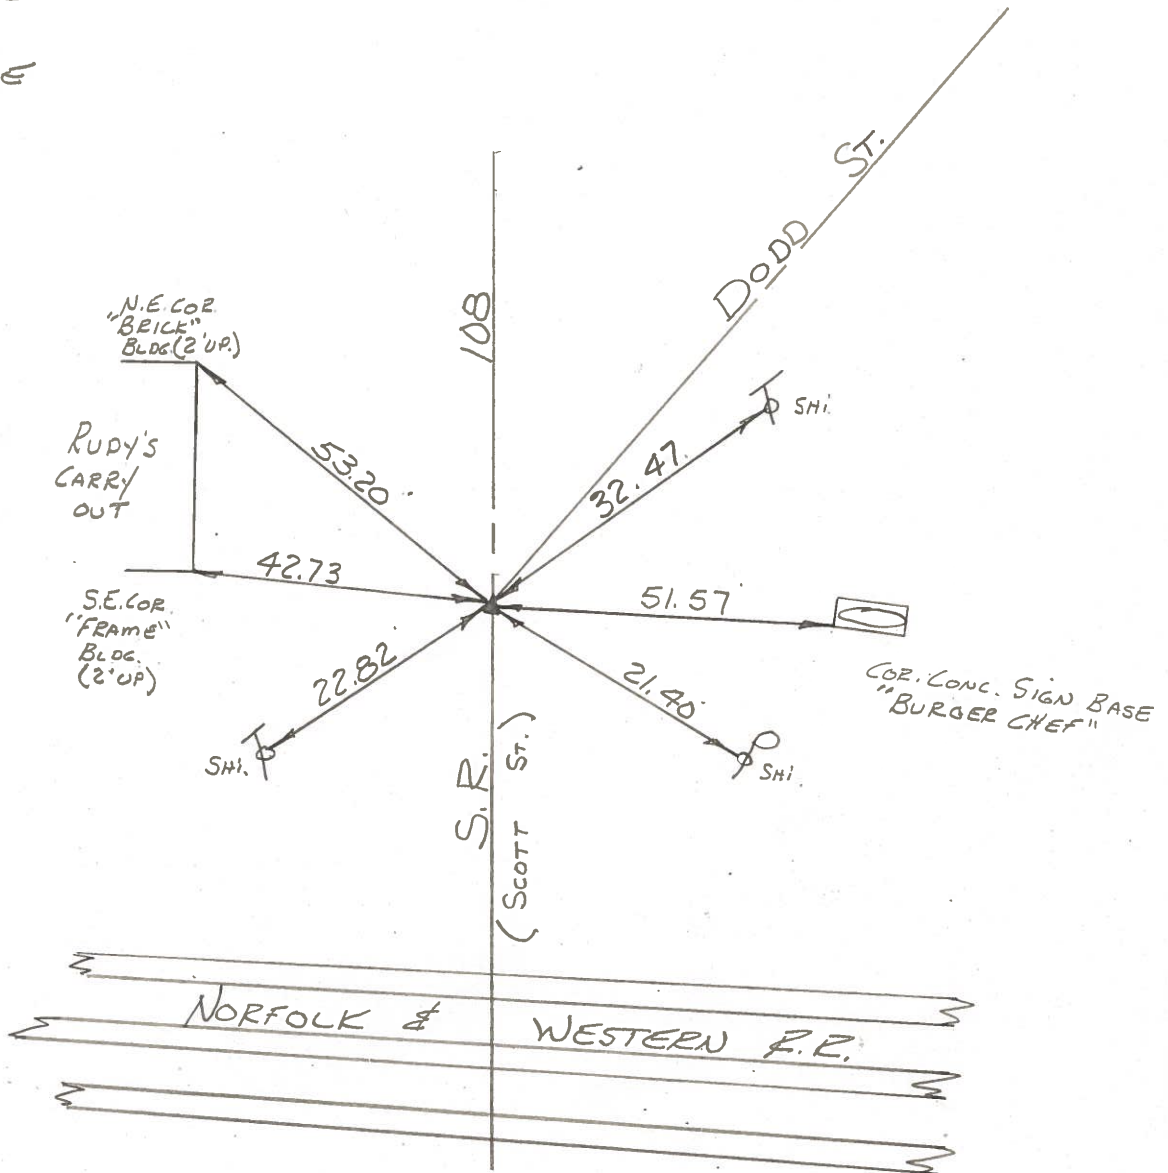


PERSONNEL	TITLE	PERSONNEL	TITLE
Tomsic			
Neuser			
Vaayo			
Granata			

COUNTY HENRY DATE AUG 23 1979

S. R. 108 WEATHER _____

SEC. NAPOLÉON TWP. TEMP. _____

DESCRIPTION _____ LEFT _____ CENTER LINE _____ RIGHT _____ JOB NO. _____

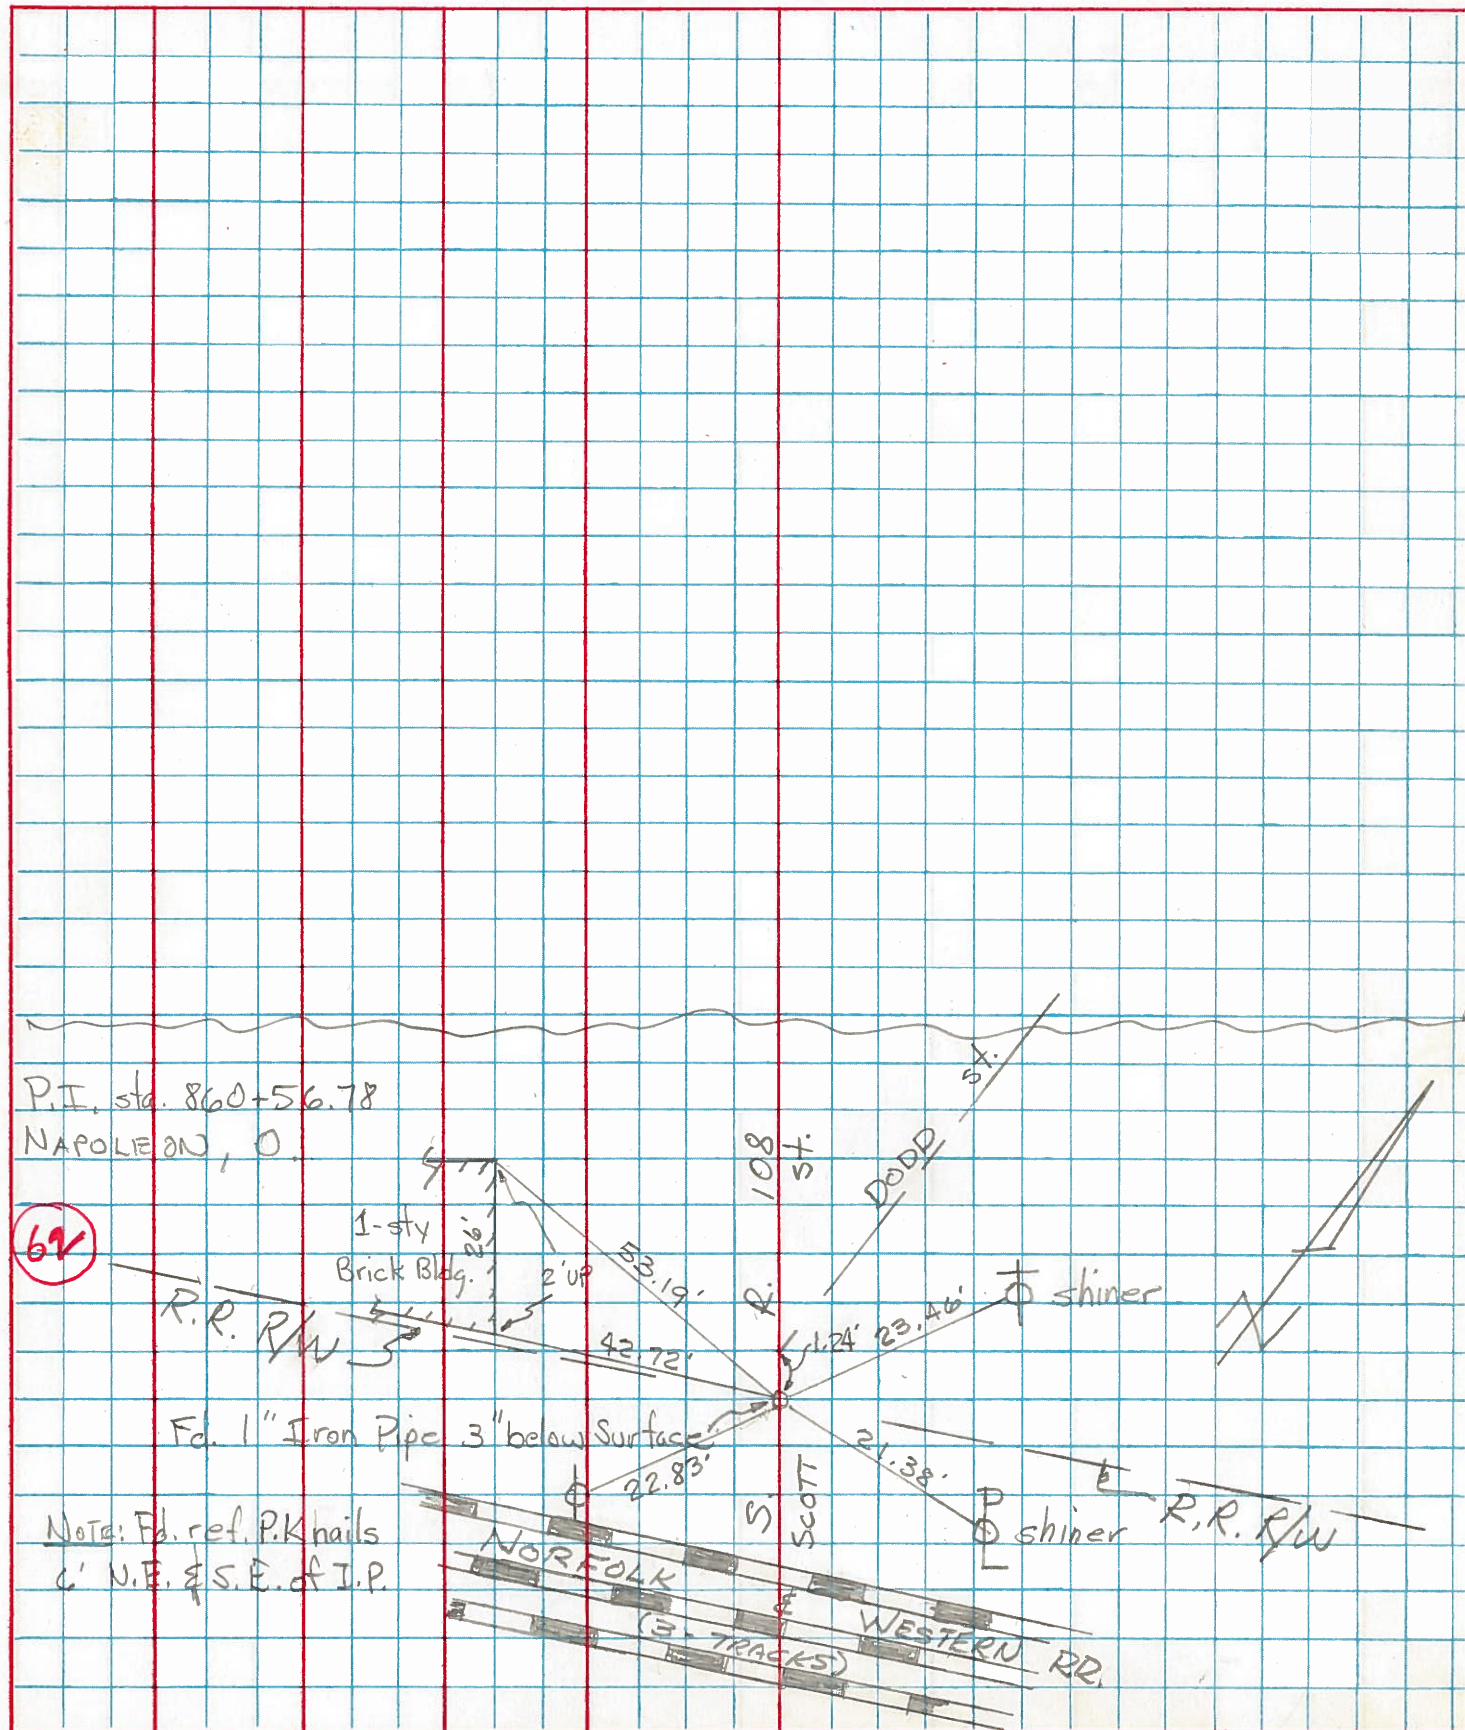

62

NOTE: Fd. ref. P.K. nails
C' N.E. & S.E. of I.P.