

O.D.O.T. DISTRICT 2 SURVEY OFFICE (USE ONLY)

PERSONNEL

REFERENCE NO. 63

SHEET 8 OF 14

NOTES MOSER

DATE 8/2/01

ROUTE SR 108

H.C. CANTERBURY

WEATHER CLEAR

COUNTY HENRY

R.C. MOSER

TEMP. 80°

TOWNSHIP NAPOLEON

SECTION 13

DWG BY NIESE PID \_\_\_\_\_

T 5 N R 6 E

TYPE MONUMENT P.K./WASHER

ON SURFACE - ~~BELOW~~ ON


OFFSET 12.6'  $\perp$  PAVEMENT 0.7'  $\pm$  : RT

TO RT EDGE PAVEMENT


STATION: 861+62

HORZ.DATUM: \_\_\_\_\_ GEOID: \_\_\_\_\_

GRID: NORTHING: \_\_\_\_\_ EASTING: \_\_\_\_\_

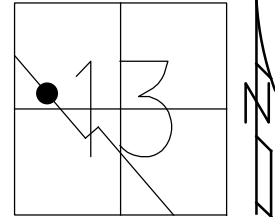

RECORD:  
 FD NAIL  
 ORIGIN UNKNOWN  
 4/8/88  
 FD P.K./WASHER  
 8/2/01, MRC  
 SET P.K./WASHER  
 11/15/01, MRC

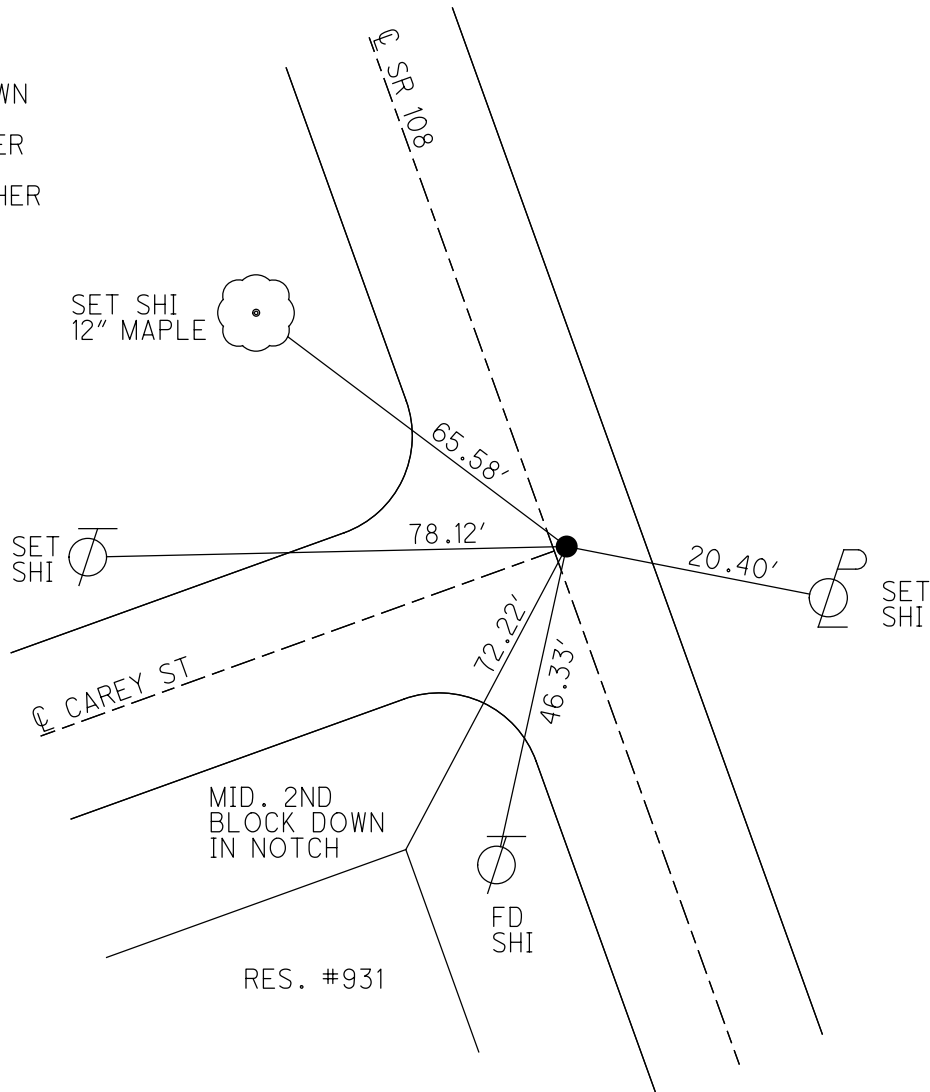

# O.D.O.T. DISTRICT 2 SURVEY OFFICE

PERSONNEL

REFERENCE NO. 63

SHEET 3 OF 21

NOTES MOSE

H.C. CAUTERBURY

R.C. MOSE

DATE 8-2-01

WEATHER CLEAR

TEMP. +80°F

ROUTE 108

COUNTY HENRY

TOWNSHIP NAPOLÉON

SECTION 13

T 5 N R 6 E

TYPE MONUMENT PK/WASHER


ON SURFACE - BELOW ON

~~LEFT~~ PAV'T. - RIGHT 0.7' RT.


12.6' TO RT. EDGE PAVEMENT

S.L.M. 861+62

RESET PK/WASHER  
 11/15/01  
 M.R.C.

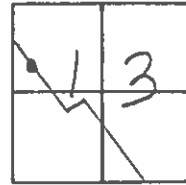

Record:  
 4-8-88  
 Fd. Nail  
 ORIGIN UNKNOWN

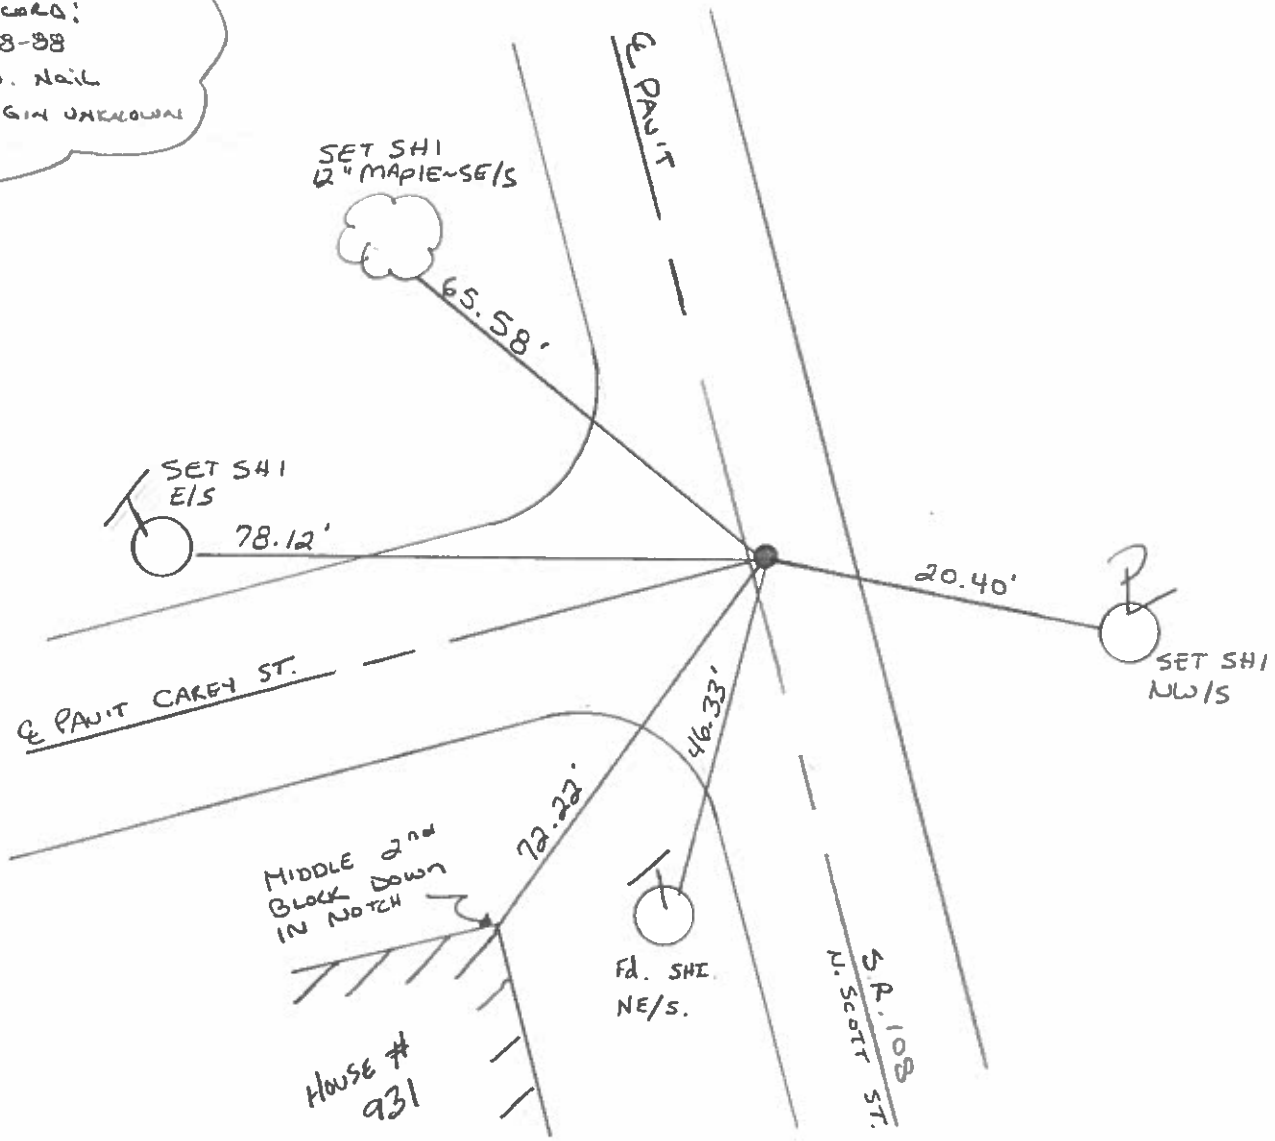

# O.D.O.T. DISTRICT 2 SURVEY OFFICE

PERSONNEL \_\_\_\_\_

REFERENCE NO. 63

SHEET 15 OF 33

NOTES Hoffman

H.C. Barnhisel

R.C. Loehrke

DATE 4-8-88

WEATHER CLEAR

TEMP. 58°

ROUTE SR 108

COUNTY HENRY

TOWNSHIP NAPOLEON

SECTION 13

T.S. N R 6 E

TYPE MONUMENT Nail - ORIGINAL UNKNOWN



~~ON SURFACE~~ - BELOW 1"

~~LEFT - & PAW'T. - RIGHT~~ 1'

12.6 TO RT EDGE PAVEMENT

S.L.M. 861 + 62

Set P.K./WASHER  
5-25-88 SWA

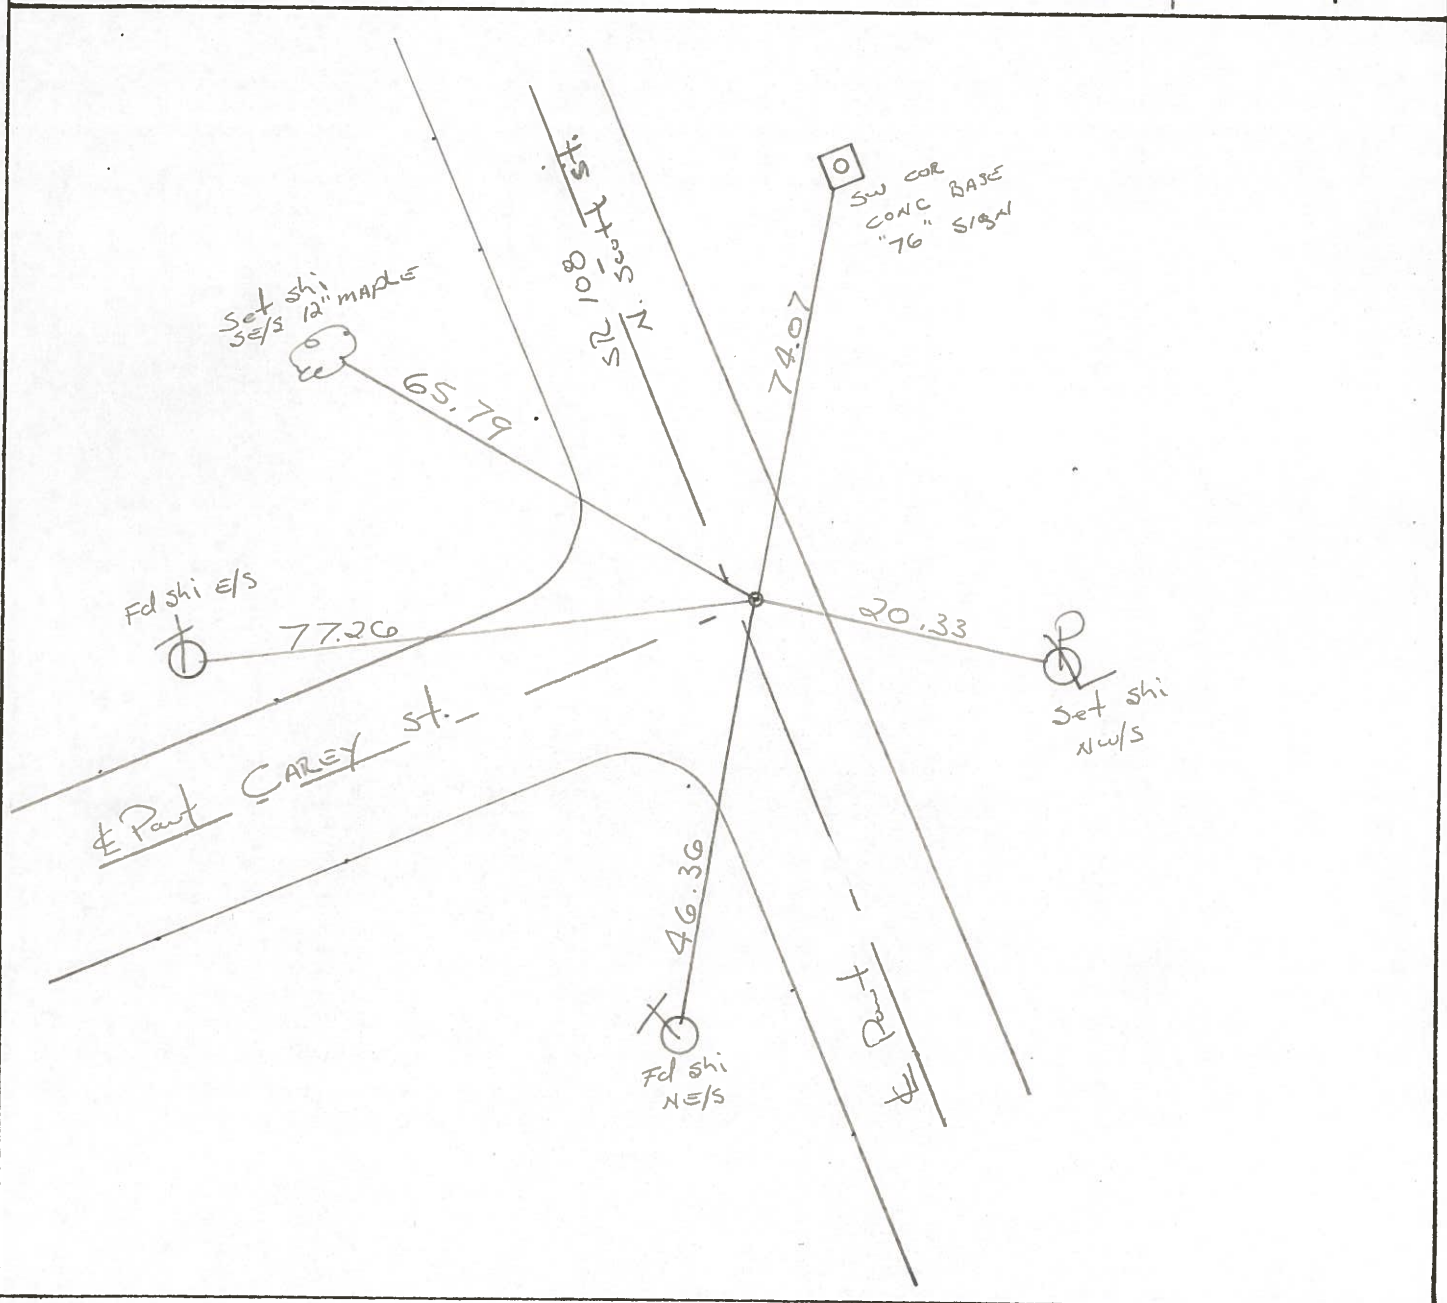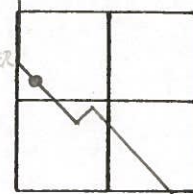

O.D.O.T. DISTRICT 2 SURVEY OFFICE

Sht. 15 of 19  
S.R.108

County HENRY

Date 8-30-77

Township NAPOLEON

Weather CLEAR

Section 13

Temp. +82°


T5N, R6E

Personnel BURNSIDE

SMITH

KAPE

MEAD

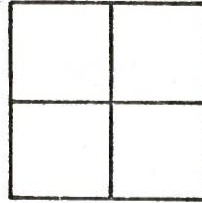

#63

FD. CONC. NAIL @  
SURFACE.

(ORIGIN UNKNOWN)

IN CTR. PAVE. CAREY ST.

& 1 ± RT. CTR. PAVE. S.R.108

