

O.D.O.T. DISTRICT 2 SURVEY OFFICE (USE ONLY)

PERSONNEL _____

REFERENCE NO. 64

SHEET 9 OF 14

NOTES MOSE

DATE 8/2/01

ROUTE SR 108

H.C. CANTERBURY

WEATHER CLEAR

COUNTY HENRY

R.C. MOSE

TEMP. 85°

TOWNSHIP NAPOLEON

SECTION 13

DWG BY NIесе PID _____

T 5 N R 6 E

TYPE MONUMENT SM. P.K.

ON SURFACE - ~~BELOW~~ ON


OFFSET Ц PAVEMENT ON LT : RT

17.0' TO RT EDGE PAVEMENT


STATION: 871+08

HORIZ.DATUM: _____ GEOID: _____

GRID: NORTHING: _____ EASTING: _____

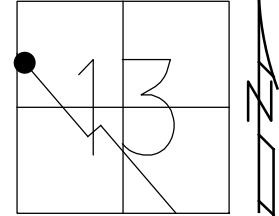

RECORD:
 STA 871+68.53
 FD SM. P.K.
 8/2/01, MRC
 SET P.K./WASHER
 11/15/01, MRC

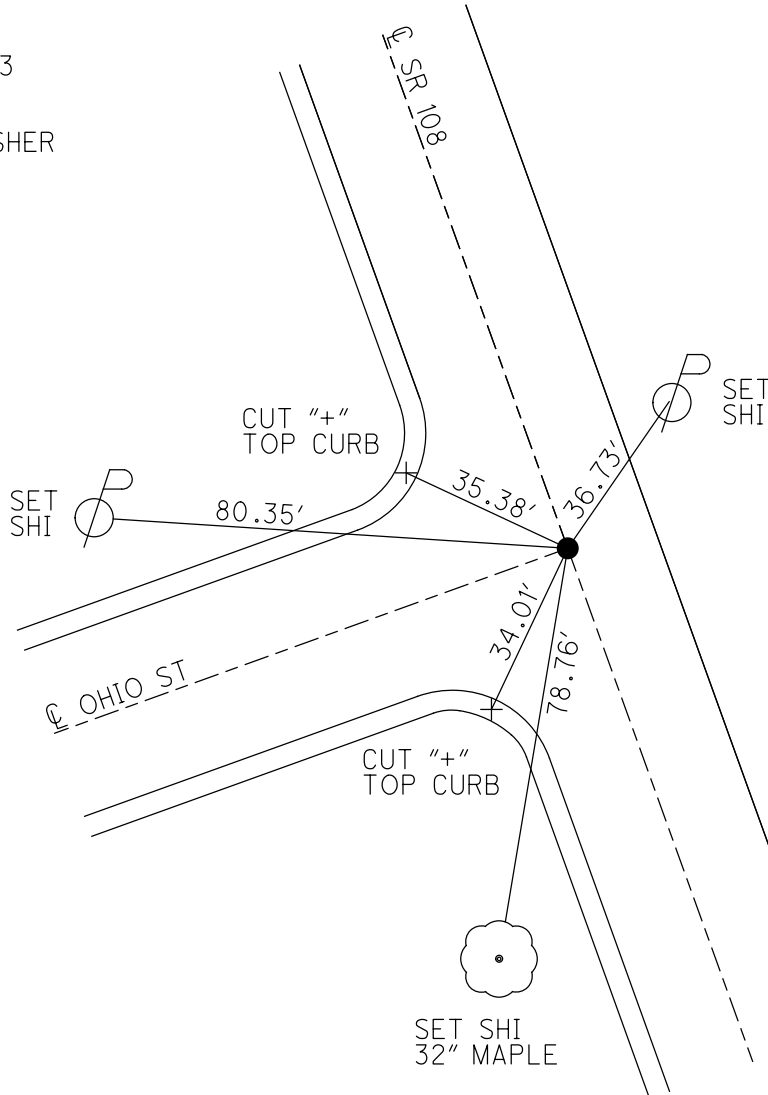

O.D.O.T. DISTRICT 2 SURVEY OFFICE

PERSONNEL

REFERENCE NO. 64

SHEET 4 OF 21

NOTES MOSEK

H.C. CANTERBURY

R.C. MOSEK

DATE 8-2-01

WEATHER CLEAR

TEMP. 85°

ROUTE 108

COUNTY HENRY

TOWNSHIP NAPOLEON

SECTION 13

T5 N R 6 E

TYPE MONUMENT Small P.K.


ON SURFACE - ~~BELOW~~ ON

~~LEFT~~ - LEFT PAV'T. - ~~RIGHT~~ RIGHT & BOTH PAV'TS


17.0 TO RT EDGE PAVEMENT FACE OF CURB

S.L.M. 871 + 08

RESET P.K./WASHER
 11/15/01
 M.R.C.

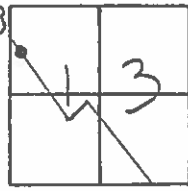

RECORD: 871 + 68.53

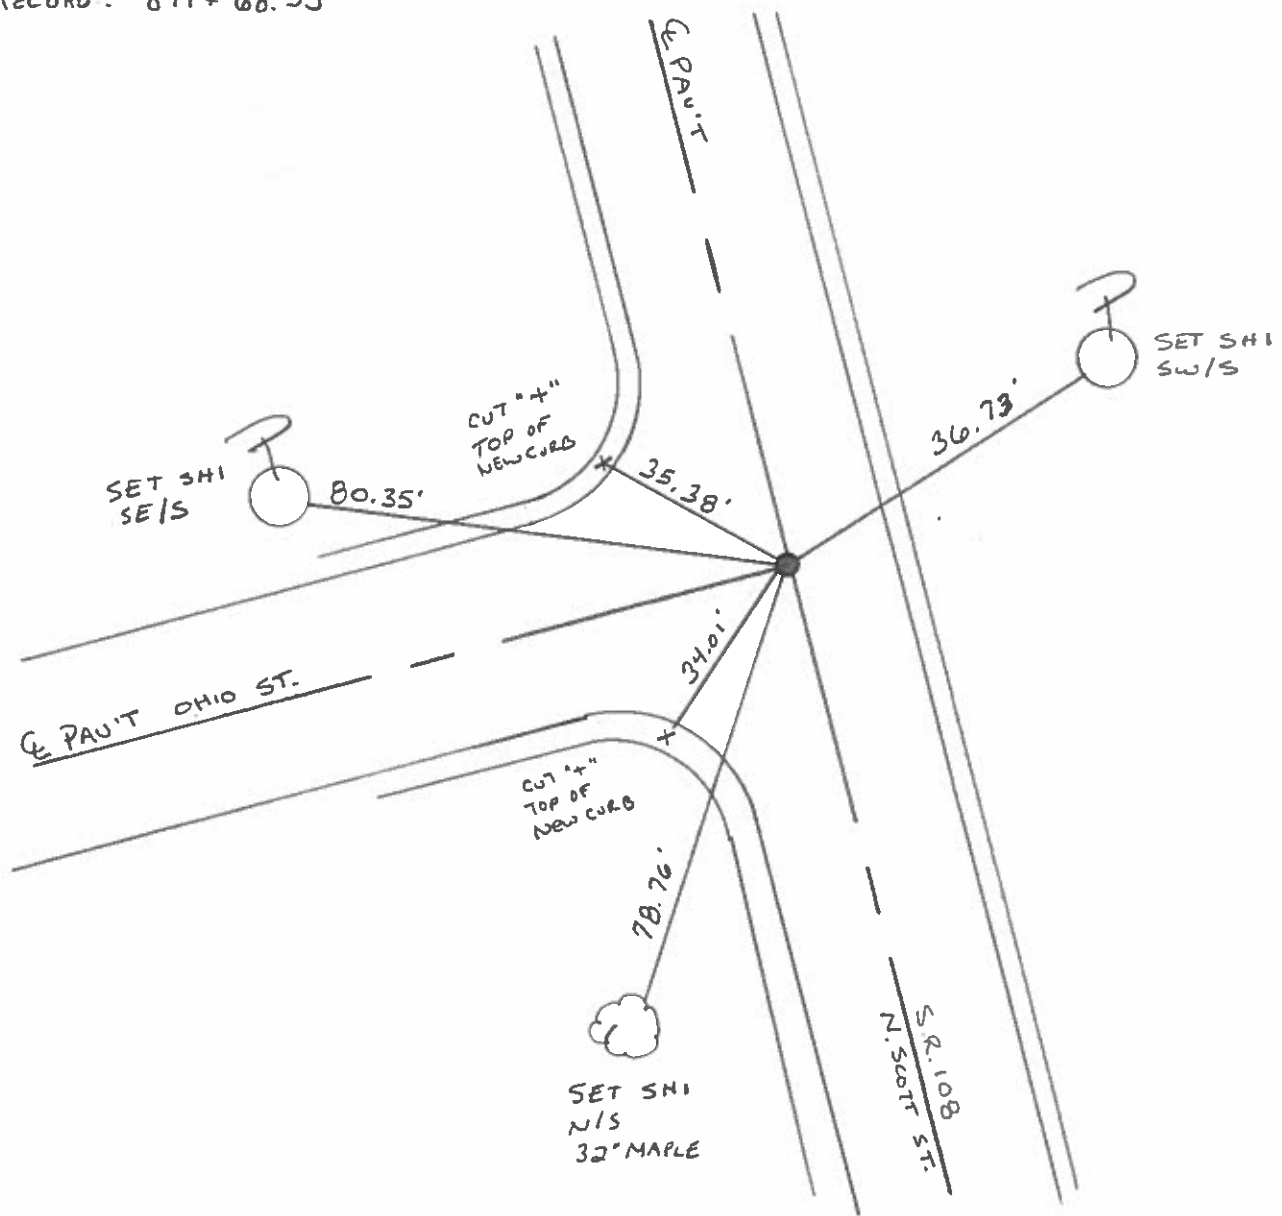

O.D.O.T. DISTRICT 2 SURVEY OFFICE

PERSONNEL _____

REFERENCE NO. 64

SHEET 16 OF 33

NOTES HOFFMAN

H.C. BARNHISEL

DATE 4-8-88

ROUTE SR 108

R.C. LOEHKE

WEATHER CLEAR

COUNTY HENRY

TEMP. 58°

TOWNSHIP NADOLEAL

SECTION 13

T. 5 N. R. 6 E.

TYPE MONUMENT P.K.


*Set P.K./WASHER
5-25-88 SWH*

~~ON SURFACE - BELOW~~ 1"


~~LEFT - & PAV'T. - RIGHT~~ BOTH Pav't's

14.0 TO 2+ EDGE PAVEMENT

S.L.M. 871+08

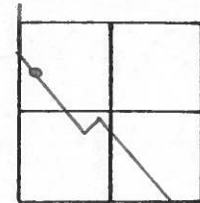

Record:
871+68.53

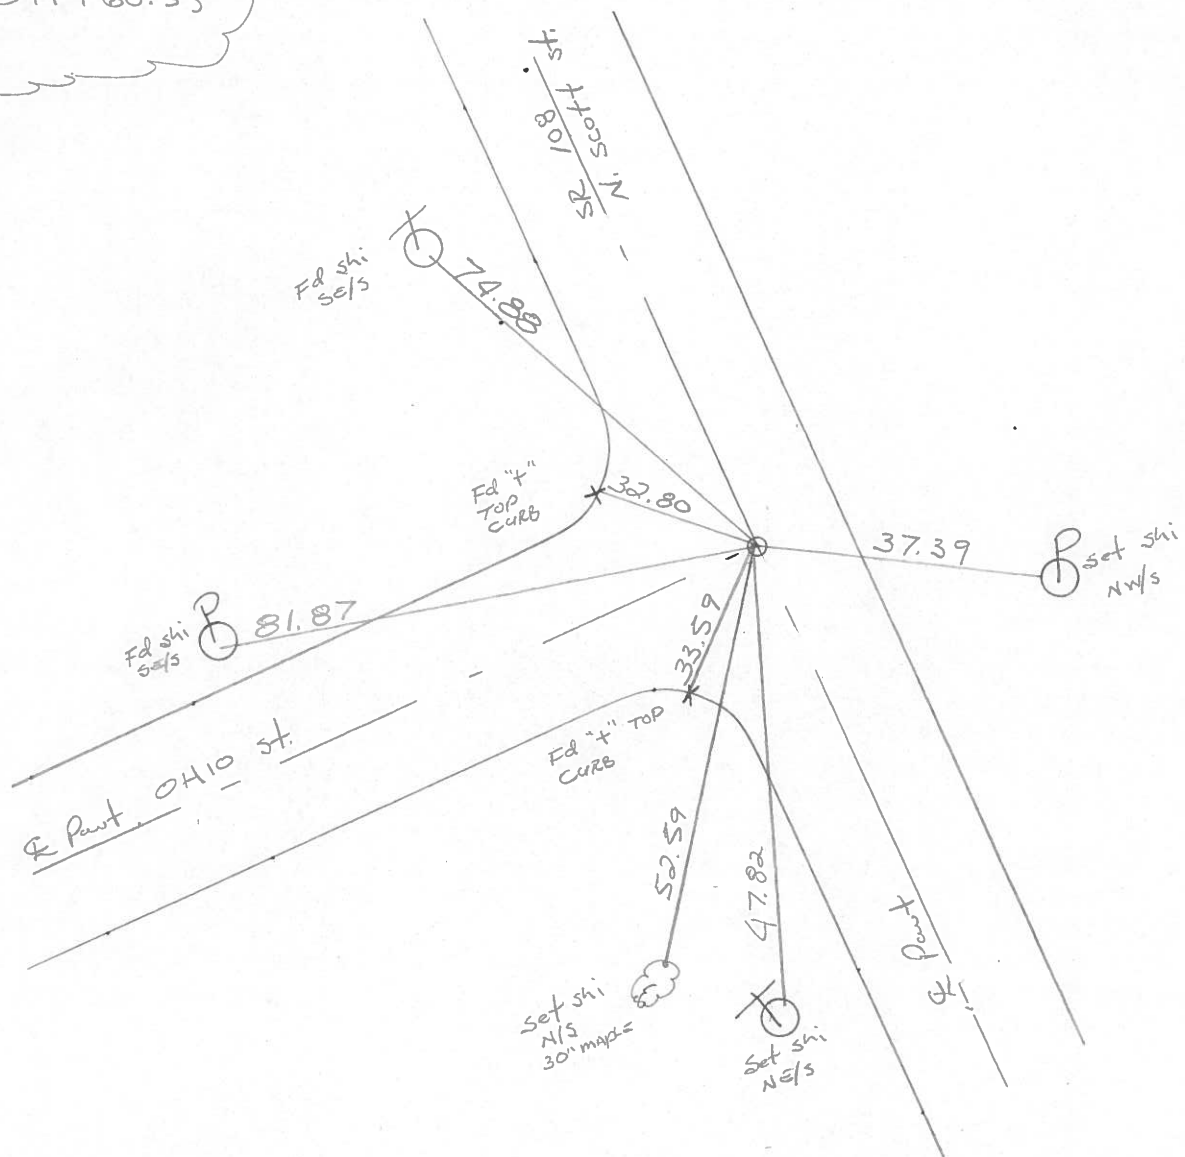

OD.O.T. DISTRICT 2 SURVEY OFFICE

Sht. 16 of 19
S.R. 108

County HENRY

Date 8-30-77

Township NAPOLEON

Weather PT. CLOUDY

Section _____

Temp. +83°


T5N, R6E

Personnel BURNSIDE

SMITH


KNAPE

MEAD

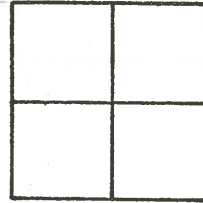

FD. P.K. NAIL @
SURFACE & IN
CTR. PAVEMENTS
STA. 871+68.53


#64

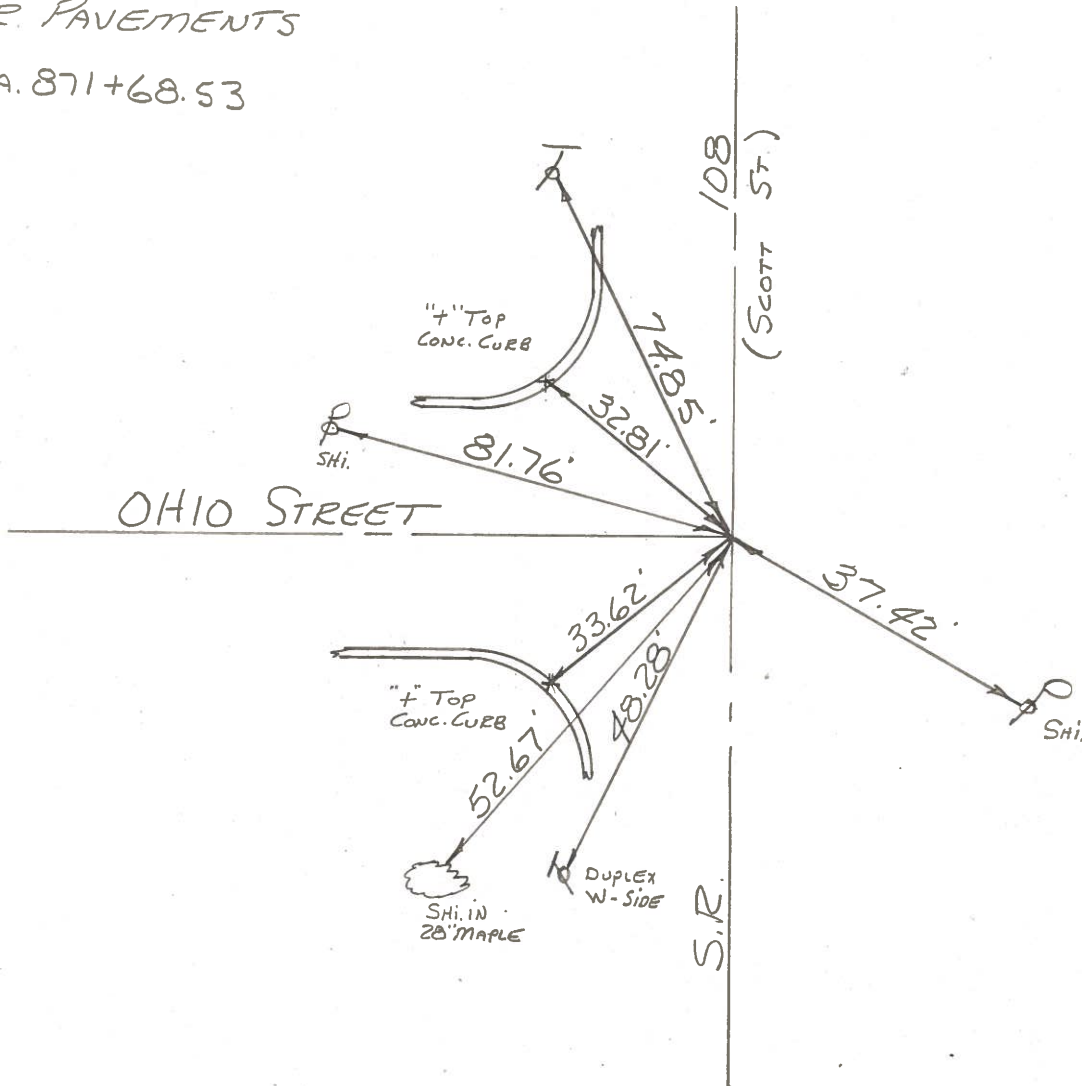

PERSONNEL	TITLE	PERSONNEL	TITLE
Trmsic			
Newser			
Janyo			
Granata			

COUNTY HENRY DATE Aug 23, 1974
 S. R. 108 WEATHER
 SEC. NAPOLEON TWP TEMP.

DESCRIPTION LEFT CENTER LINE RIGHT JOB NO.

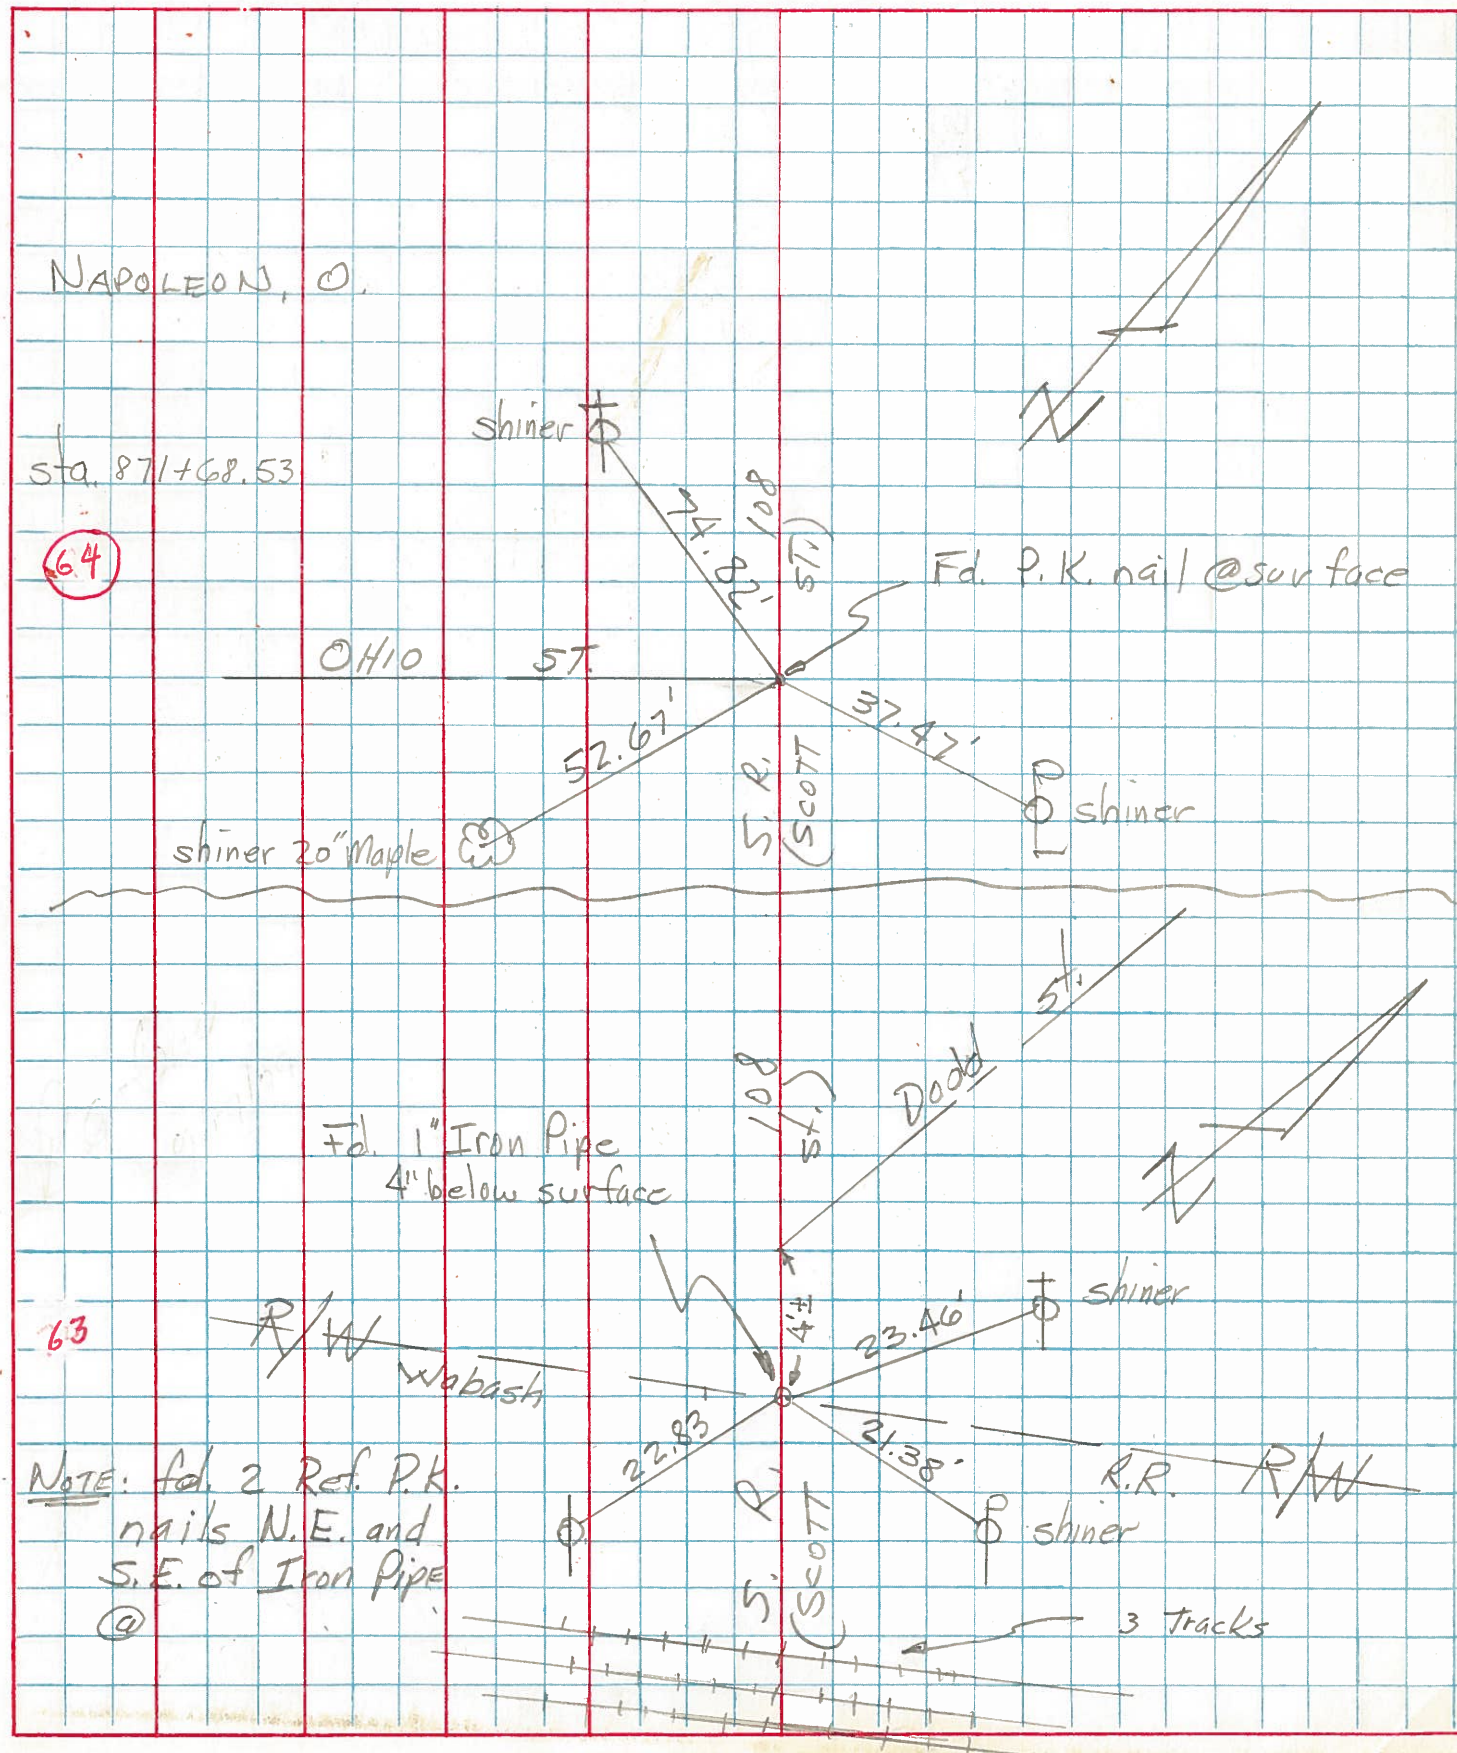

64

63

NOTE: Fd. 2 Ref. P.K. nails N.E. and S.E. of Iron Pipe @