

O.D.O.T. DISTRICT 2 SURVEY OFFICE (USE ONLY)

PERSONNEL \_\_\_\_\_

REFERENCE NO. 66

SHEET 11 OF 14

NOTES MOSER

DATE 8/2/01

ROUTE SR 108

H.C. CANTERBURY

WEATHER CLEAR

COUNTY HENRY

R.C. MOSER

TEMP. 85°

TOWNSHIP NAPOLEON

DWG BY NIESE

PID \_\_\_\_\_

SECTION 13

T 5 N R 16 E

TYPE MONUMENT MONBOX W/ IPIN

ON SURFACE - ~~BELOW~~ ON

OFFSET  $\text{C}$  PAVEMENT ON LT : RT

20.2' TO LT ~~EDGE PAVEMENT~~ FACE OF CURB


STATION: 882+82

HORZ.DATUM: \_\_\_\_\_


GEOID: \_\_\_\_\_

GRID: NORTHING: \_\_\_\_\_

EASTING: \_\_\_\_\_

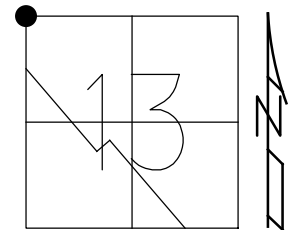

RECORD:  
 STA 883+50.96  
 FD MONBOX  
 W/ IPIN  
 8/2/01, MRC

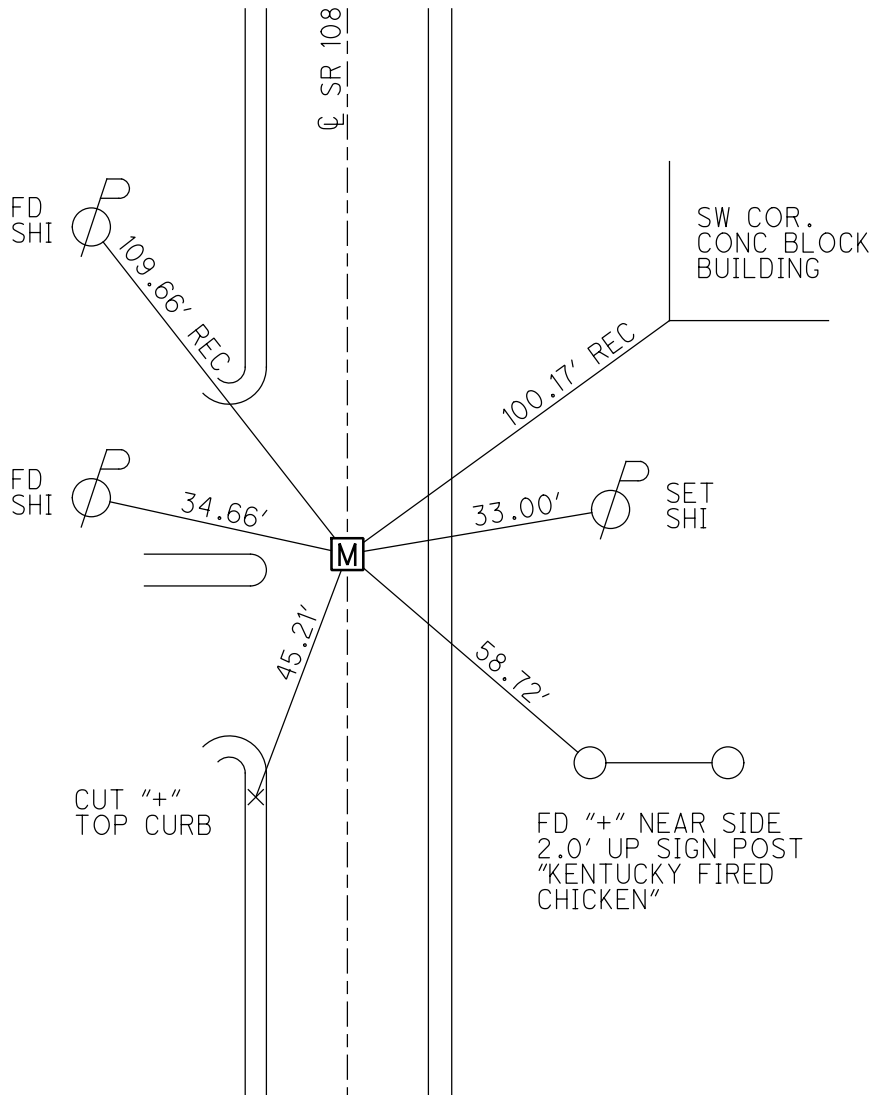

# O.D.O.T. DISTRICT 2 SURVEY OFFICE

PERSONNEL

REFERENCE NO. 66

SHEET 6 OF 21

NOTES MOSER

H.C. CANTERBURY

DATE 8-2-01

ROUTE 108

R.C. MOSER

WEATHER CLEAR

COUNTY HENRY

TEMP. +85°F

TOWNSHIP NAPOLEON

SECTION 13

T 5 N R 6 E

I. PIN


TYPE MONUMENT Mon Box - OPENED LID

ON SURFACE - ~~BELLOW~~ ON


~~LEFT~~ - LT. PAV'T. - ~~RIGHT~~ R

20.2 TO LT. EDGE PAVEMENT FACE OF CURB

S.L.M. 882 + 82

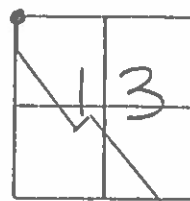

RECORD:  
STA. 883+50.96

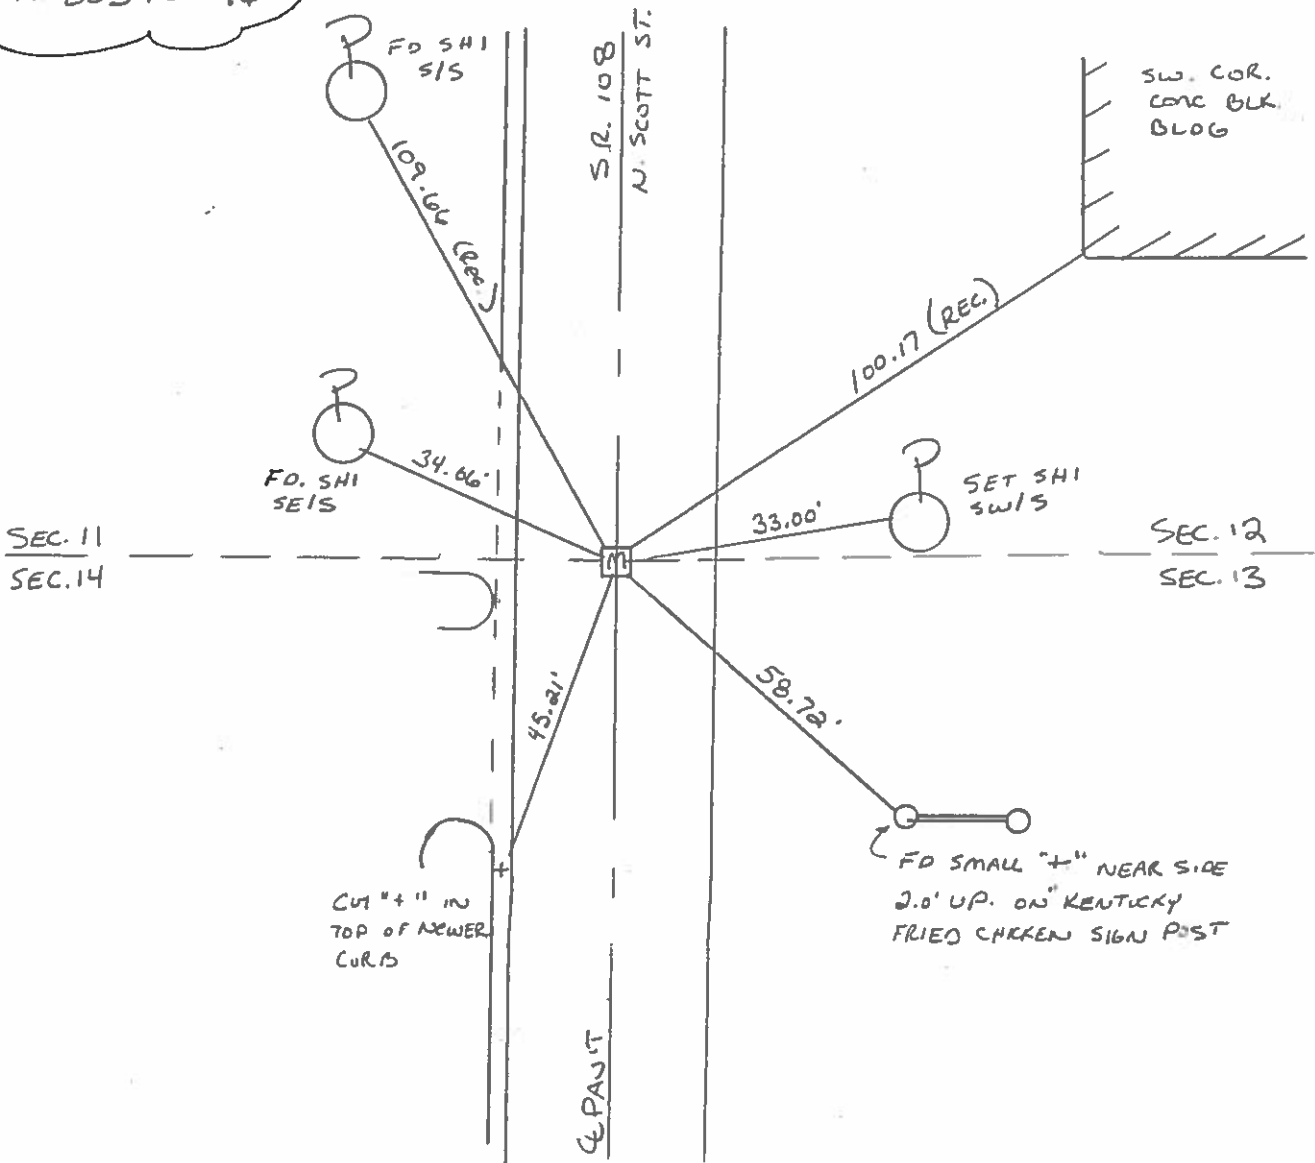

# O.D.O.T. DISTRICT 2 SURVEY OFFICE

PERSONNEL

REFERENCE NO. 66

SHEET 18 OF 33

NOTES HOFFMAN

H.C. BARNHISEL

R.C. LOEHKE

DATE 4-8-88

WEATHER CLEAR

TEMP. 58°

ROUTE SR 108

COUNTY HENRY

TOWNSHIP NADOLSON

SECTION 13

T5 N R 6 E

TYPE MONUMENT Boat SPIKE


~~ON SURFACE~~ - BELOW 1"

LEFT- & PAV'T. - RIGHT 1'

14.1 TO LT EDGE PAVEMENT


S.L.M. 882 + 82

Set SMALL  
R.R. SPIKE  
5-25-88 SWA

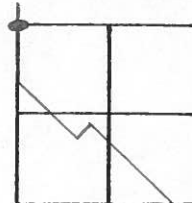

Record:  
883+50.96

ALSO FOUND  
@ surface:  
P.K. 0.17' N. of spike  
&  
Hinge Nail 0.31' N. of spike

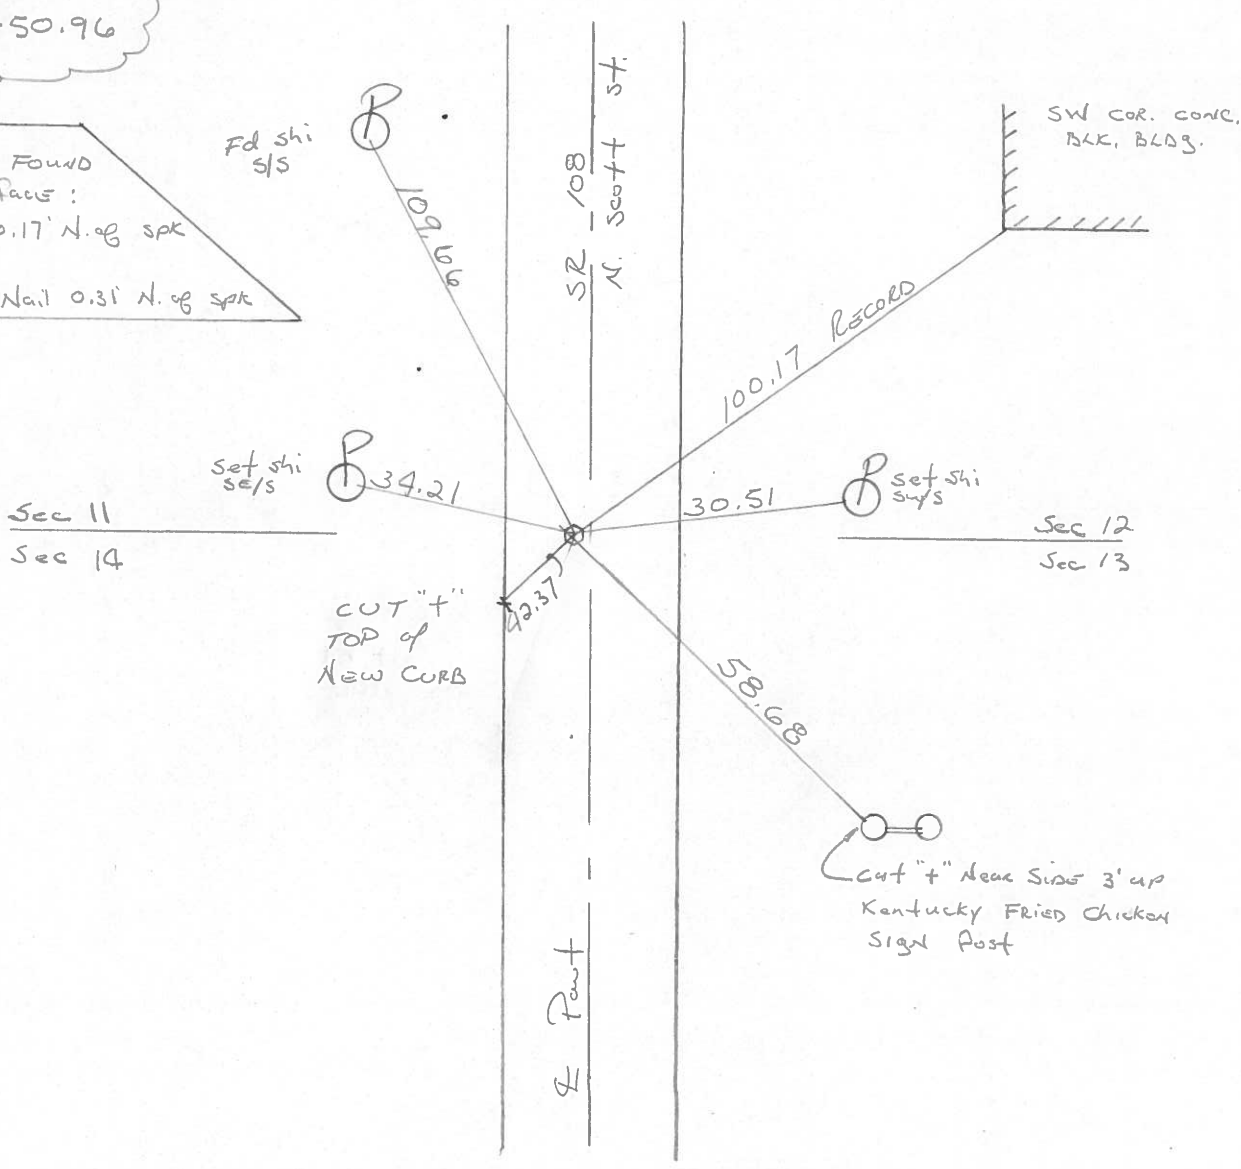

ODOT. DISTRICT 2 SURVEY OFFICE

Sht. 18 of 19  
S.R. 108

County HENRY

Date 8-30-77

Township NAPOLEON

Weather CLEAR

Section SE. COR. SEC. 11

Temp. +85°


T5N, R6E

Personnel BURNSIDE

SMITH


KNAPE

MEAD

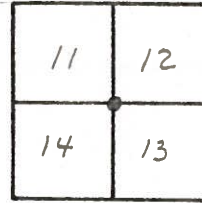

FD. BOAT SPK.  
@ SURFACE

STA 883+50.96

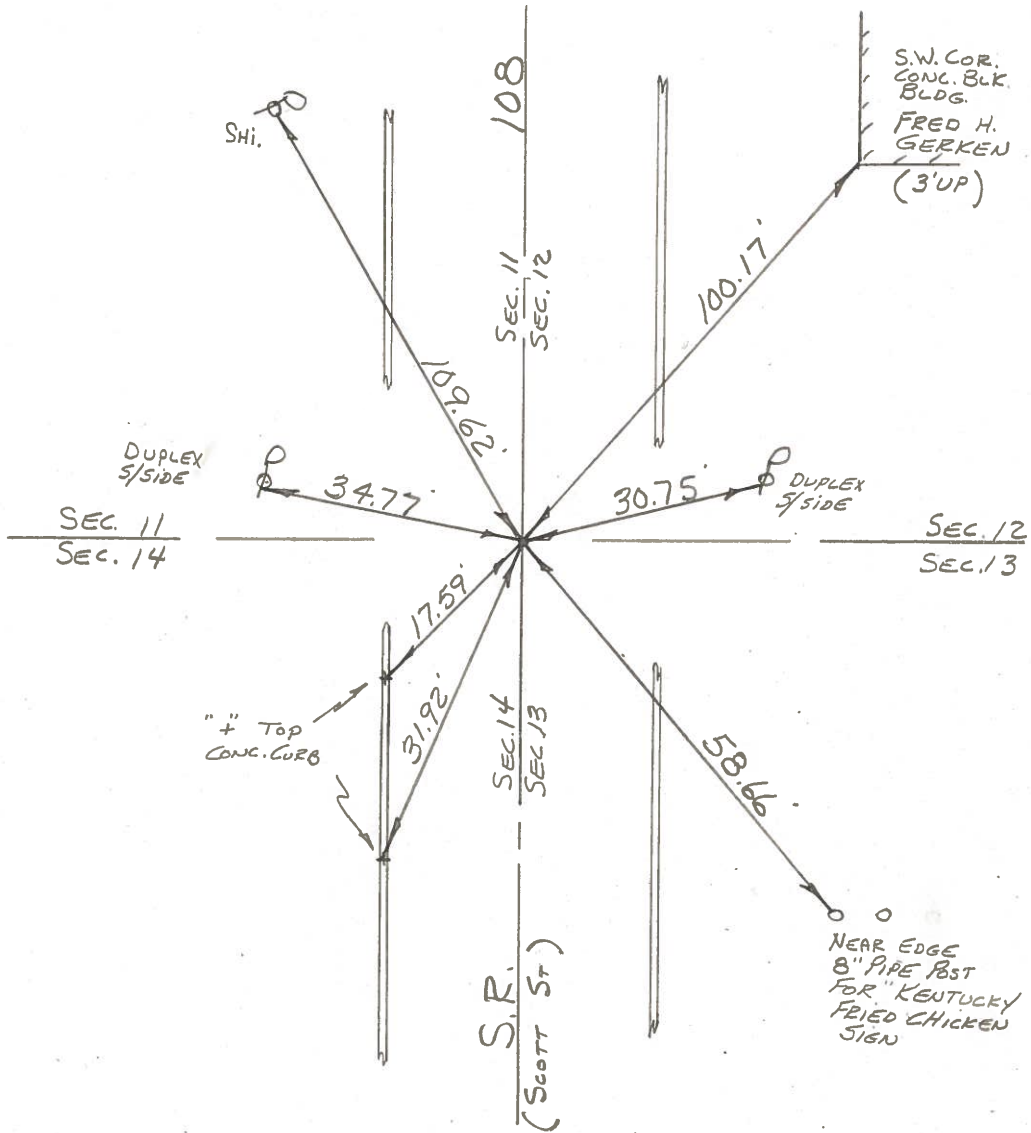

PERSONNEL	TITLE	PERSONNEL	TITLE
Tomsik			
Naiser			
Janyo			
Brnata			

COUNTY HENRY DATE Aug 23, 1974

S. R. 108 WEATHER \_\_\_\_\_

SEC. NAPOLÉON TWP. TEMP. \_\_\_\_\_

DESCRIPTION \_\_\_\_\_ LEFT \_\_\_\_\_ CENTER LINE \_\_\_\_\_ RIGHT \_\_\_\_\_ JOB NO. \_\_\_\_\_

