

O.D.O.T. DISTRICT 2 SURVEY OFFICE (USE ONLY)

PERSONNEL

REFERENCE NO. 67

SHEET 13 OF 14

NOTES MOSER

DATE 8/2/01

ROUTE SR 108

H.C. CANTERBURY

WEATHER CLEAR

COUNTY HENRY

R.C. MOSER

TEMP. 85°

TOWNSHIP NAPOLEON

SECTION 12

DWG BY NIESE PID _____

T 5 N R 6 E

TYPE MONUMENT MONBOX

ON SURFACE - ~~BELOW~~ ON

OFFSET Q PAVEMENT ON LT : RT

20.1' TO LT ~~EDGE PAVEMENT~~ FACE OF CURB


STATION: 909+06

HORIZ.DATUM: _____


GEOID: _____

GRID: NORTHING: _____

EASTING: _____

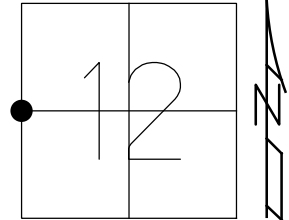

RECORD:
1966 PLAN
STA 909+74.40
FD MONBOX
8/2/01, MRC

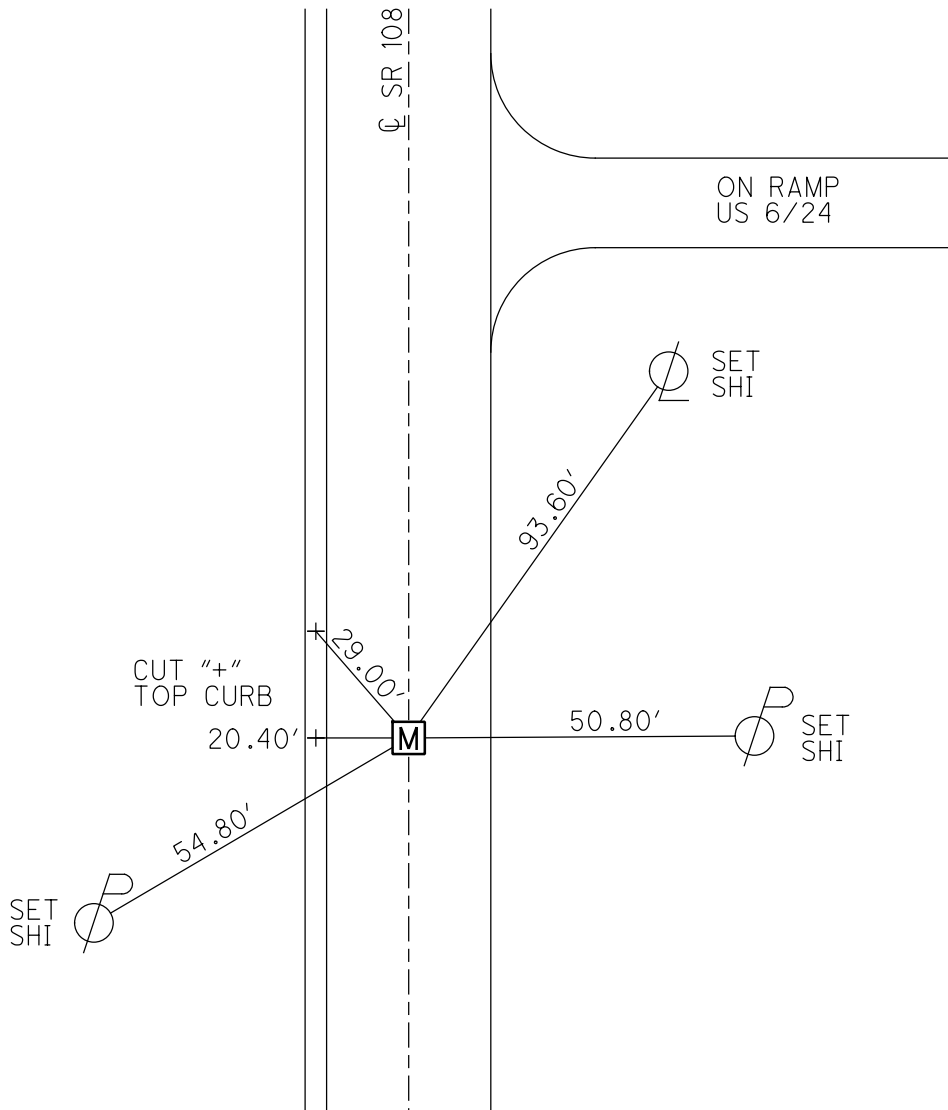

O.D.O.T. DISTRICT 2 SURVEY OFFICE

PERSONNEL

REFERENCE NO. 67 SHEET 8 OF 21

NOTES MOSE

H.C. CANTERBURY

DATE 8-2-01

ROUTE 108

R.C. MOSE

WEATHER CLEAR

COUNTY HENRY

TEMP. 78.5°F

TOWNSHIP NAPOLEON

SECTION 11

T.S. N 6 E


TYPE MONUMENT Mon Box

ON SURFACE - BELOW ON


LEFT - ☉ PAV'T. - RIGHT ☉

20.1 TO LT EDGE PAVEMENT FACE OF CURB

S.L.M. 909+06

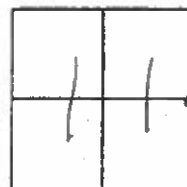

1966 PLAN = 909+74.40

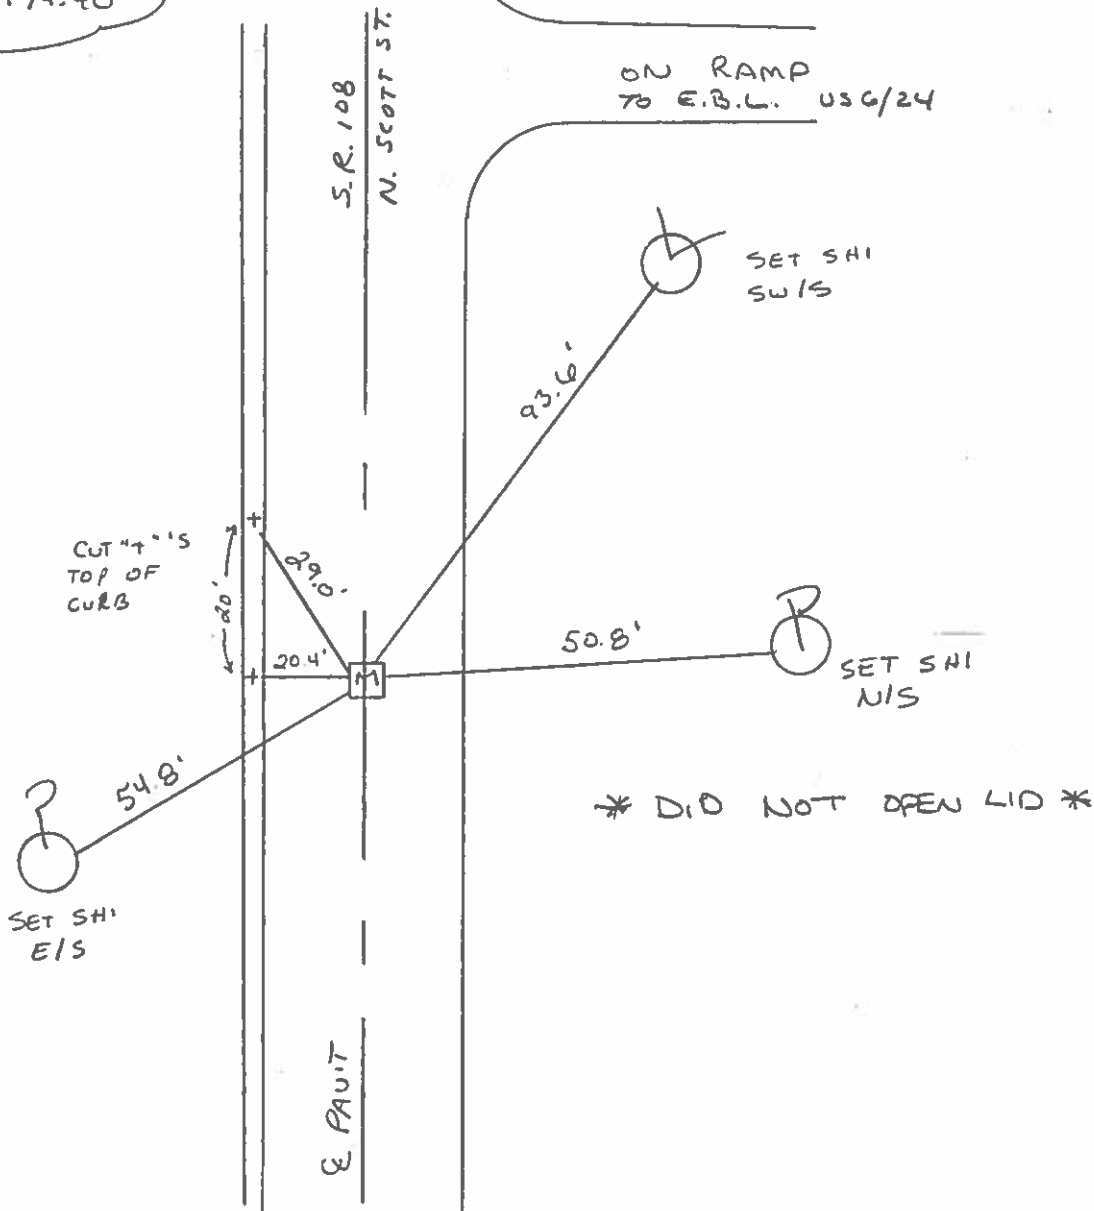

* DID NOT OPEN LID *