

O.D.O.T. DISTRICT 2 SURVEY OFFICE (USE ONLY)

PERSONNEL _____

REFERENCE NO. 67 B

SHEET 1 OF 21

NOTES HUSS

DATE 4/15/09

ROUTE SR 108

H.C. CORDES

WEATHER CLDY-RAIN

COUNTY HENRY

R.C. CORY

TEMP. 45°

TOWNSHIP NAPOLEON

SECTION 11

T 5 N R 6 E

TYPE MONUMENT MON.BOX



ON SURFACE - ~~BELOW~~ ON

LEFT - CL PAV'T - RIGHT ON

- TO - EDGE PAVEMENT

S.L.M. 920+00.15

Grid: Northing: 639073.189 Easting: 1520854.181

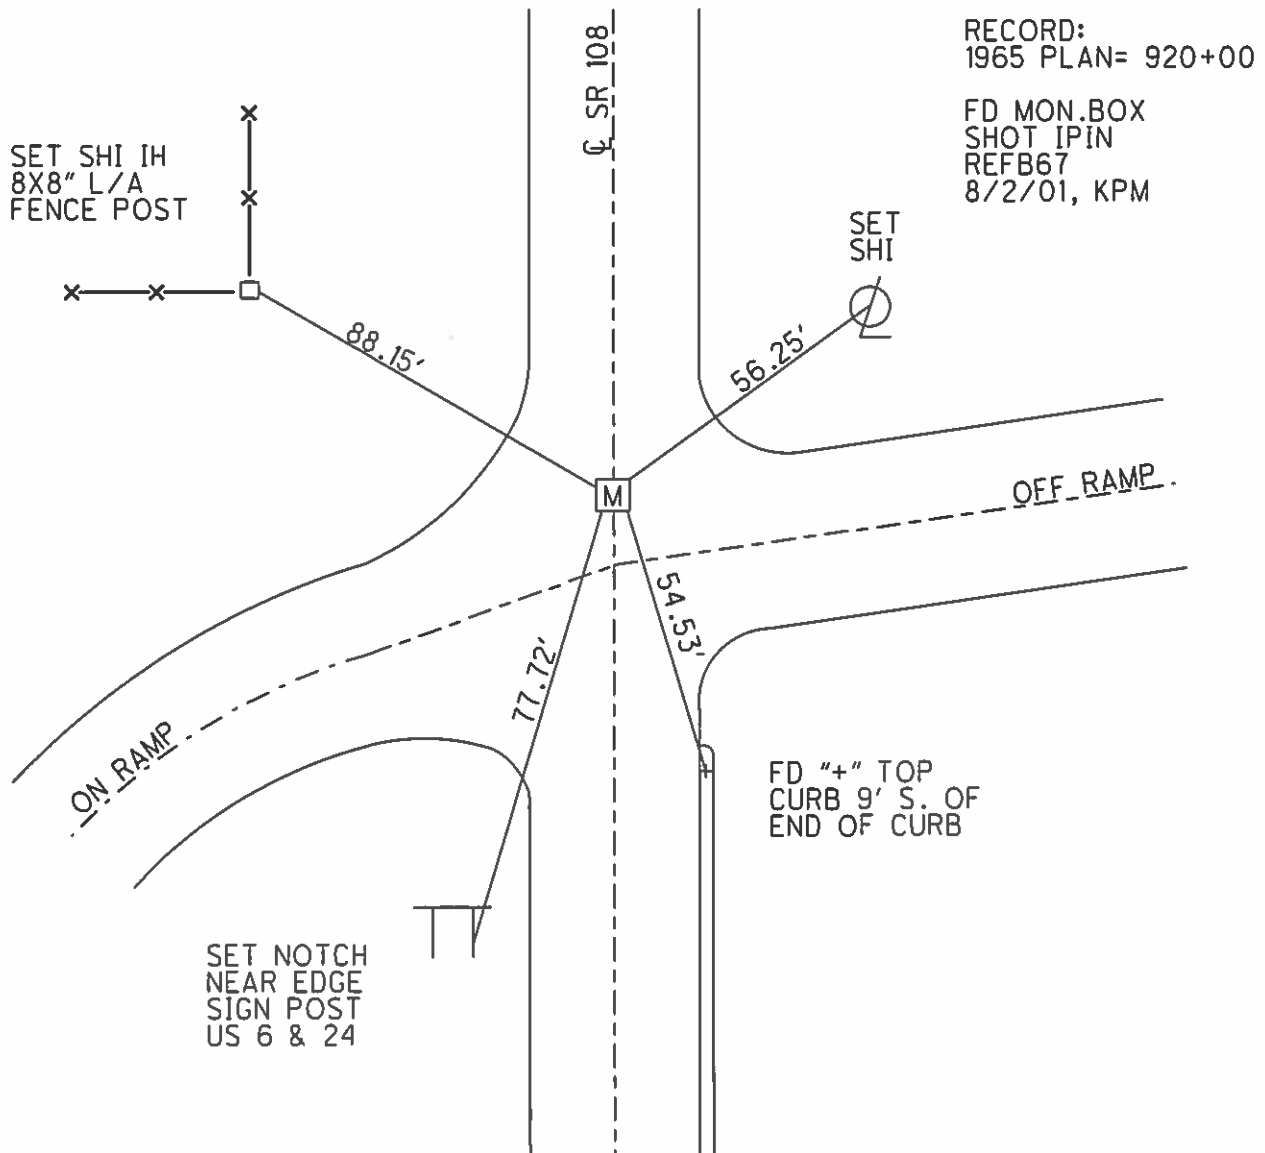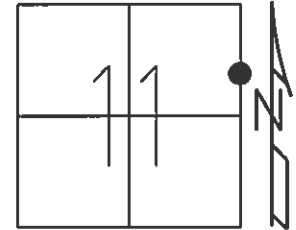

O.D.O.T. DISTRICT 2 SURVEY OFFICE

PERSONNEL

REFERENCE NO. 67-B

SHEET 10 OF 21

NOTES MOSEK

H.C. CAUTERBURY

DATE 8-2-01

ROUTE 108

R.C. MOSEK

WEATHER OVERCAST

COUNTY HENRY

TEMP. 79.0°F

TOWNSHIP NAPOLEON

SECTION 11

T5 N R 6 E


TYPE MONUMENT Mon. Box

ON SURFACE - BELOW ON

~~LEFT~~ - PAV'T. - ~~RIGHT~~ ☺


— TO — EDGE PAVEMENT

S.L.M. 919+33

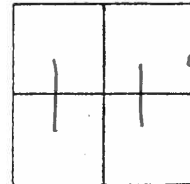

Record:
1965 PLAN = 920+00

DID NOT OPEN LID

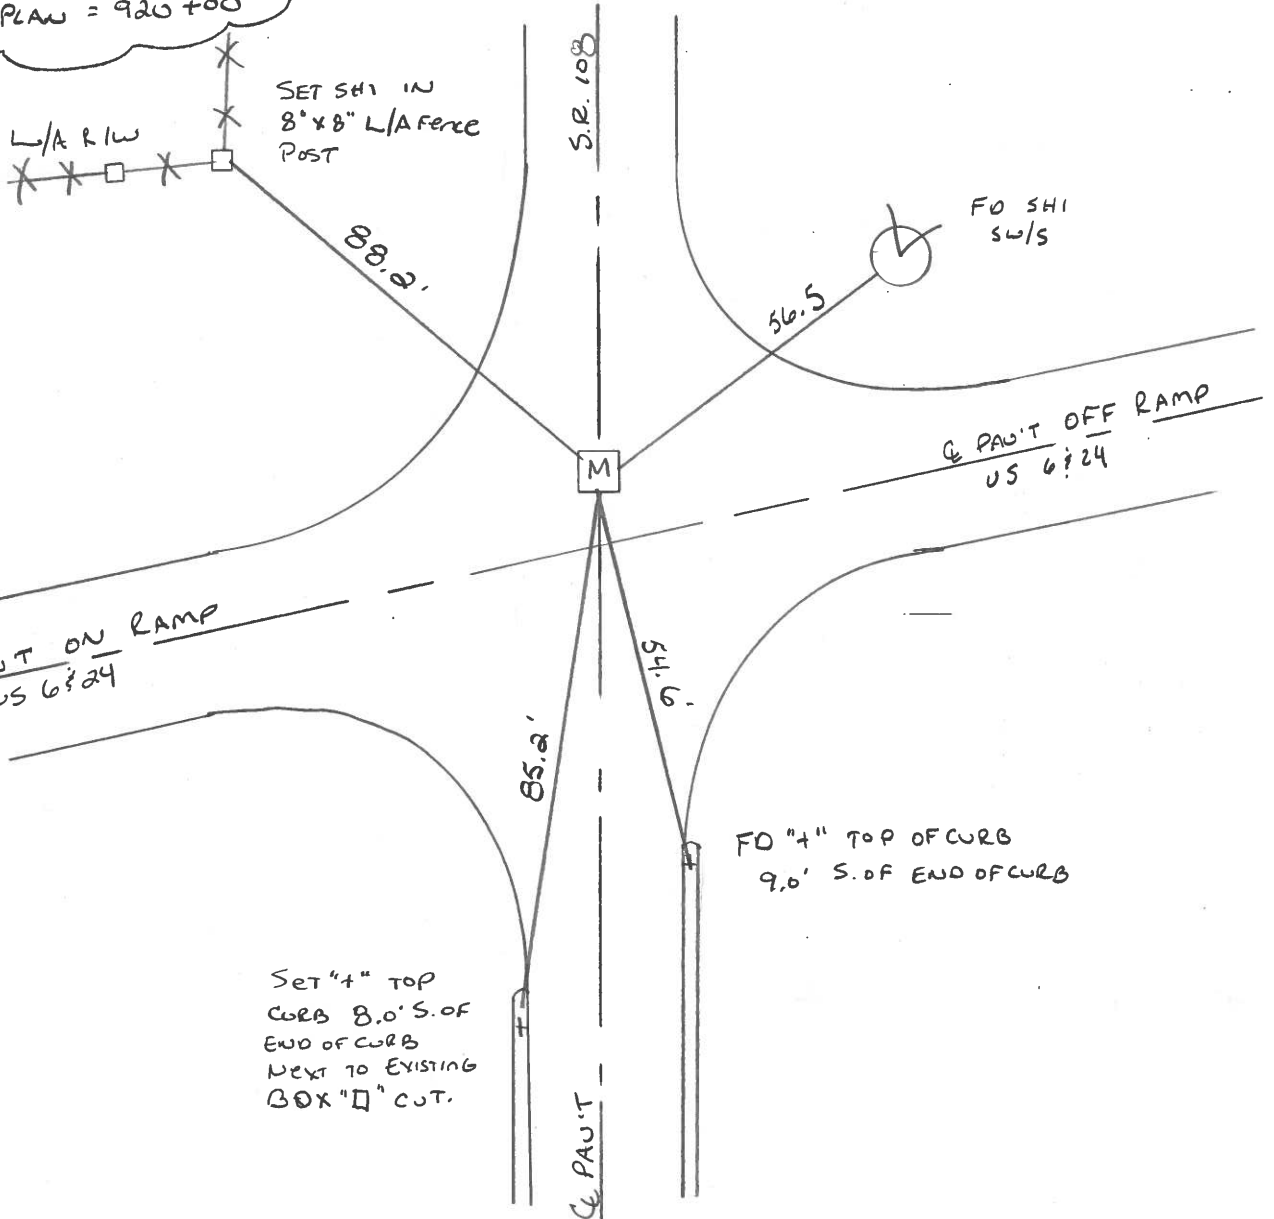

Set "4" TOP
CURB 8.0' S. OF
END OF CURB
NEXT TO EXISTING
BOX "12" CUT.

FO "4" TOP OF CURB
9.0' S. OF END OF CURB

☺ PAV'T ON RAMP
TO US 6724

☺ PAV'T OFF RAMP
US 6724

L/A R/W

SET SH1 IN
8" x 8" L/A FENCE
POST

FO SH1
SW/S

SR 108

☺ PAV'T

O.D.O.T. DISTRICT 2 SURVEY OFFICE

PERSONNEL _____

REFERENCE NO. _____

SHEET 22 OF 33

NOTES Hoffman

H.C. BARNDISEL

R.C. LOEHLKE

REED

DATE 4-18-88

WEATHER P. CLEAR

TEMP. 43°

ROUTE 52 108

COUNTY HENRY

TOWNSHIP NAPOLEON

SECTION 11

T5 NR 6 E


TYPE MONUMENT Monument Box

ON SURFACE - ~~BELOW~~ YES

LEFT- & PAV'T. - RIGHT YES

TO EDGE PAVEMENT


S.L.M. 919+33

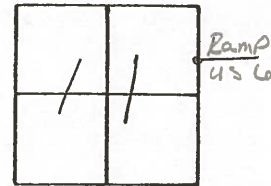

1965 PLAN = 920+00

DID NOT OPEN AID.

67-B

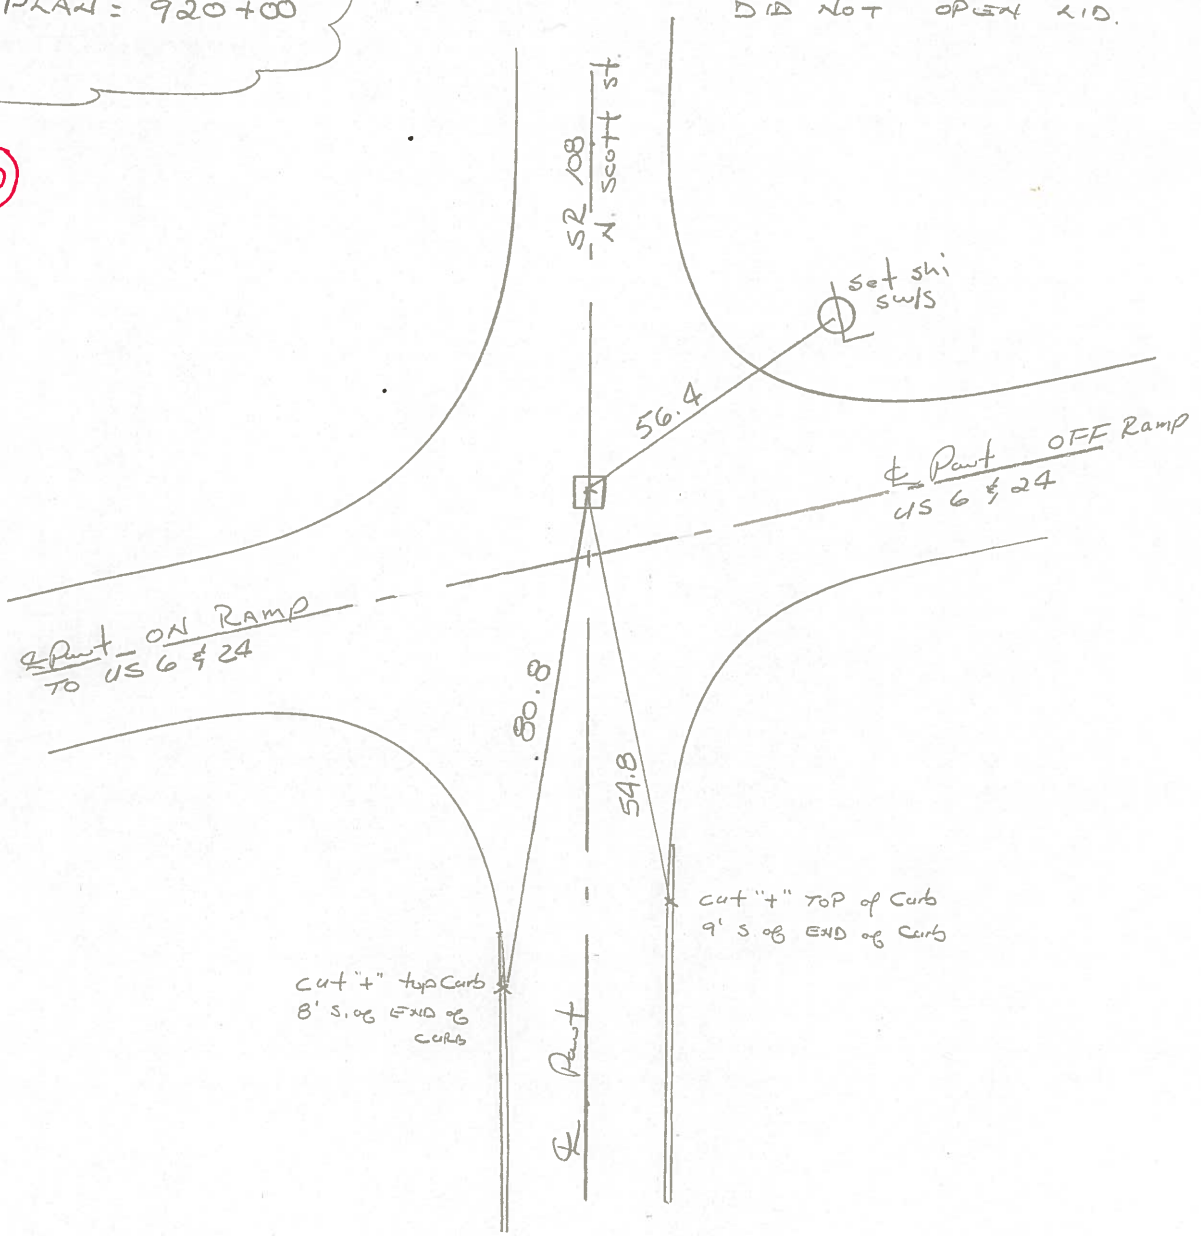

PAV'T ON RAMP
TO US 6 & 24

cut "+" top curb
8' S. of END of
curb

cut "+" TOP of curb
9' S. of END of curb

PAV'T