

O.D.O.T. DISTRICT 2 SURVEY OFFICE (USE ONLY)

PERSONNEL

REFERENCE NO. 69 A

SHEET 4 OF 21

NOTES HUSS

DATE 4/15/09

ROUTE SR 108

H.C. CORDES

WEATHER CLOUDY

COUNTY HENRY

R.C. CORY

TEMP. 45°

TOWNSHIP NAPOLEON

DWG BY NIESE PID 101211

SECTION 2

T 5 N R 6 E

TYPE MONUMENT MONBOX W/1" IPIN

ON SURFACE - ~~BELOW~~ ON

OFFSET Q PAVEMENT ON LT : RT

12.1' TO RT EDGE PAVEMENT


STATION: 967+42.85

HORZ.DATUM: NAD83(2011)


GEOID: 2012A

GRID: NORTHING: 643814.968

EASTING: 1520952.985

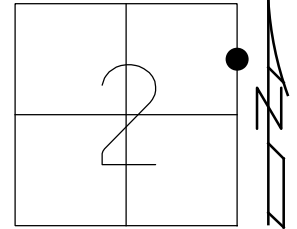


RECORD:
1966 PLAN
STA 967+43.00
FD MONBOX
W/IPIN
REFA69
8/6/01, KPM
FD MONBOX
REFA69
4/4/18, JLL

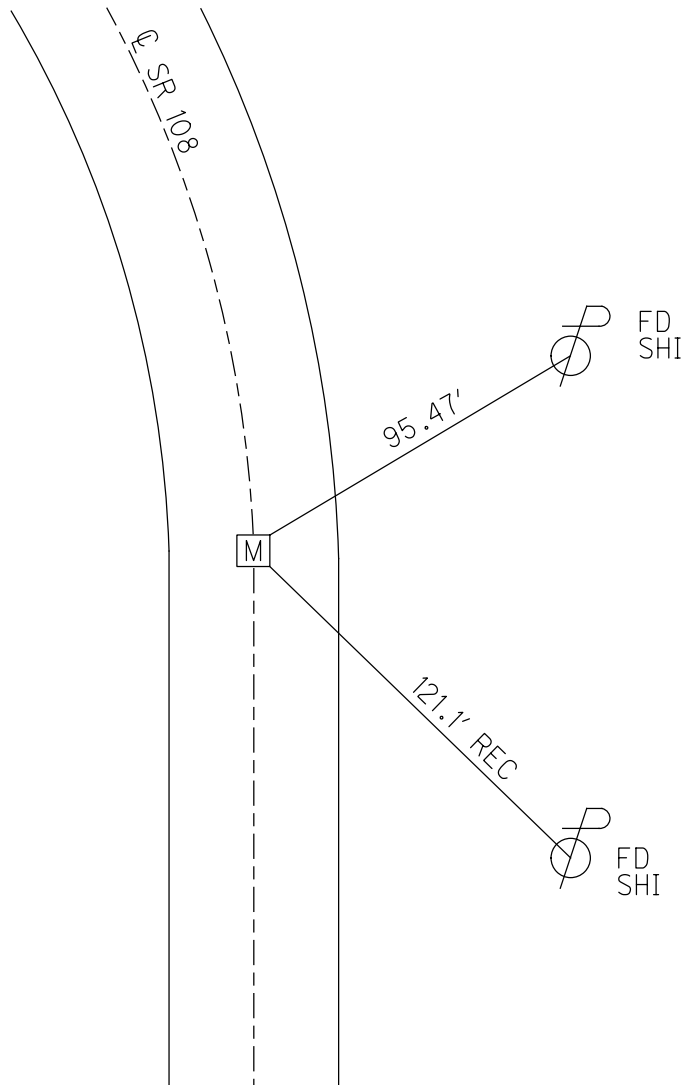

O.D.O.T. DISTRICT 2 SURVEY OFFICE (USE ONLY)


PERSONNEL	REFERENCE NO. <u>69 A</u>	SHEET <u>4</u> OF <u>21</u>
NOTES <u>HUSS</u>	DATE <u>4/15/09</u>	ROUTE <u>SR 108</u>
H.C. <u>CORDES</u>	WEATHER <u>CLDY-COOL</u>	COUNTY <u>HENRY</u>
R.C. <u>CORY</u>	TEMP. <u>45°</u>	TOWNSHIP <u>NAPOLEON</u>
		SECTION <u>2</u>
		T. <u>5</u> N R. <u>6</u> E

TYPE MONUMENT MON.BOX
 ON SURFACE - ~~BELOW~~ ON
 LEFT - Q PAV'T - RIGHT ON
12.1' TO RT EDGE PAVEMENT
 S.L.M. 967+42.85
 Grid: Northing: 643814.858 Easting: 1520952.923

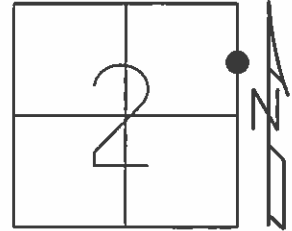

RECORD:
 1966 PLAN= 967+43.00

FD MON.BOX
 SET E-W STRADLES
 USE S.EDGE OF
 WEST NAIL.
 SHOT IPIN
 REFA69
 8/6/01, KPM

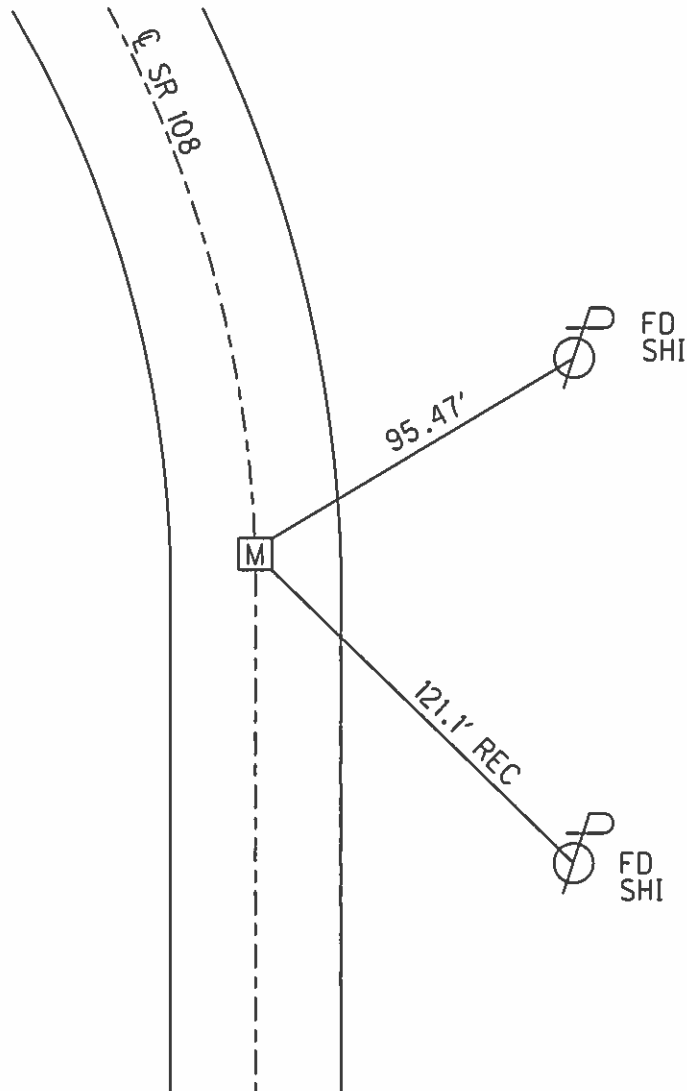

O.D.O.T. DISTRICT 2 SURVEY OFFICE

PERSONNEL

REFERENCE NO. 69-A

SHEET 13 OF 21

NOTES MOSE

H.C. CANTERBURY

R.C. MOSE

DATE 8-6-01

WEATHER SUN

TEMP. +80°

ROUTE 108

COUNTY HENRY

TOWNSHIP NAPOLEON

SECTION 2

T5 N R 6 E


TYPE MONUMENT Mon. Box

ON SURFACE - ~~BELOW~~ SURFACE

LEFT - ~~Q~~ PAV'T. - ~~RIGHT~~ Q


12.1 TO RT EDGE PAVEMENT

S.L.M. 966 + 75

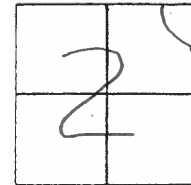

RECORD:
1966 PLAN = 967 + 43.00

SET STRADLES
8-6-01
E-W STRADLES USE S. EDGE
OF WEST NAIL.

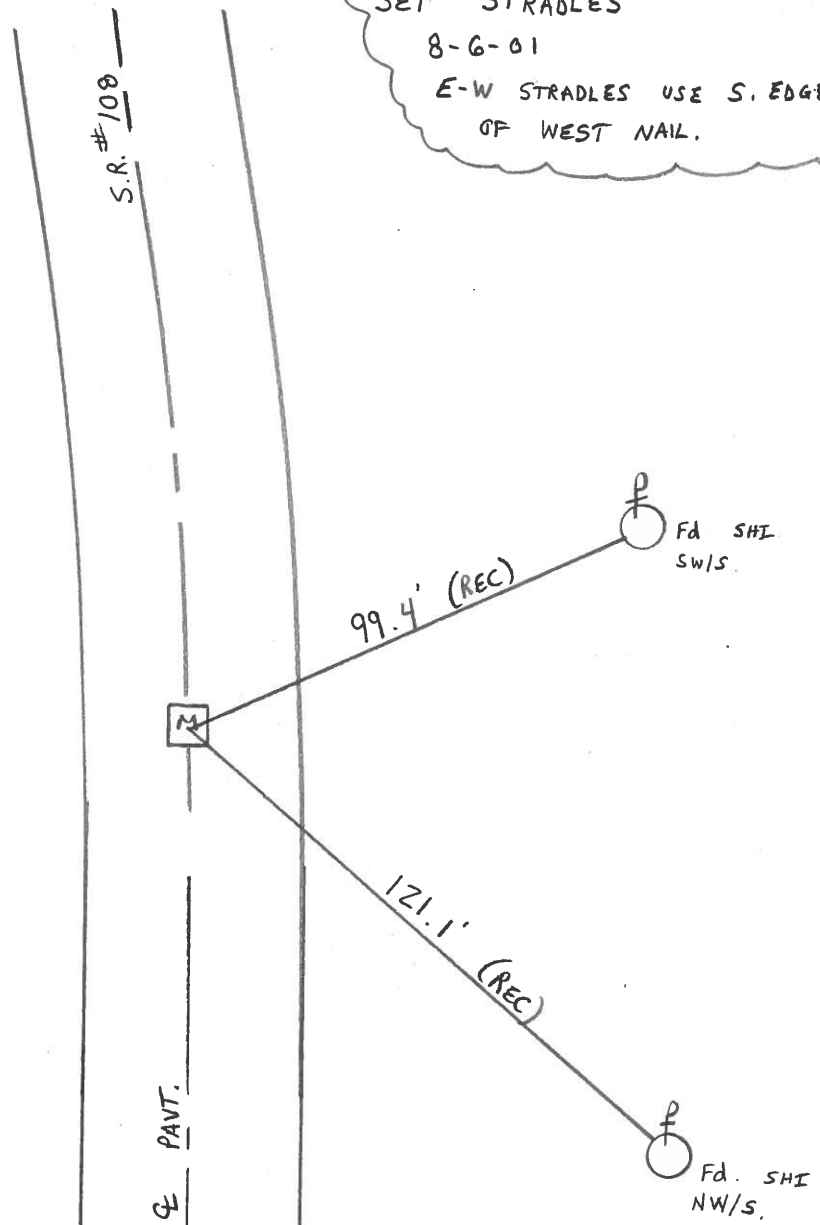

O.D.O.T. DISTRICT 2 SURVEY OFFICE

PERSONNEL _____

REFERENCE NO. _____

SHEET 25 OF 33

NOTES HOFFMAN

H.C. BARNHISEL

R.C. LOBHILL

REED

DATE 4-18-88

WEATHER P. CLEAR

TEMP. 43°

ROUTE SR 108

COUNTY HENRY

TOWNSHIP NAPOLSON

SECTION 2

T.S. NR 6 E


TYPE MONUMENT Monument Box

ON SURFACE - BELOW YES

LEFT- & PAV'T. - RIGHT YES

12.1 TO RT EDGE PAVEMENT

S.L.M. 966 + 75

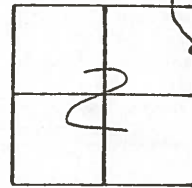

1966 PLAN = 967+43.00

DID NOT OPEN X IN

(69-A)

