

O.D.O.T. DISTRICT 2 SURVEY OFFICE (USE ONLY)

PERSONNEL

REFERENCE NO. 69 C

SHEET 6 OF 21

NOTES HUSS

DATE 4/15/09

ROUTE SR 108

H.C. CORDES

WEATHER CLOUDY

COUNTY HENRY

R.C. CORY

TEMP. 47°

TOWNSHIP NAPOLEON

DWG BY NIESE PID 101211

SECTION 2

T 5 N R 6 E

TYPE MONUMENT MONBOX W/1" IPIN

ON SURFACE - ~~BELOW~~ ON _____

OFFSET ☉ PAVEMENT ON _____ ~~LT~~ : RT

12.1' TO RT EDGE PAVEMENT


STATION: 975+41.26

HORZ.DATUM: NAD83(2011)


GEOID: 2012A

GRID: NORTHING: 644603.364

EASTING: 1520856.652

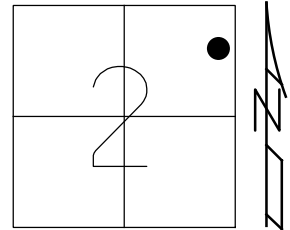


RECORD:
1966 PLAN
STA. 975+42.76
FD MONBOX
W/IPIN
REFC69
8/6/01, KPM
FD MONBOX
REFC69
4/4/18, JLL
FD MONBOX
9/17/19, JLL

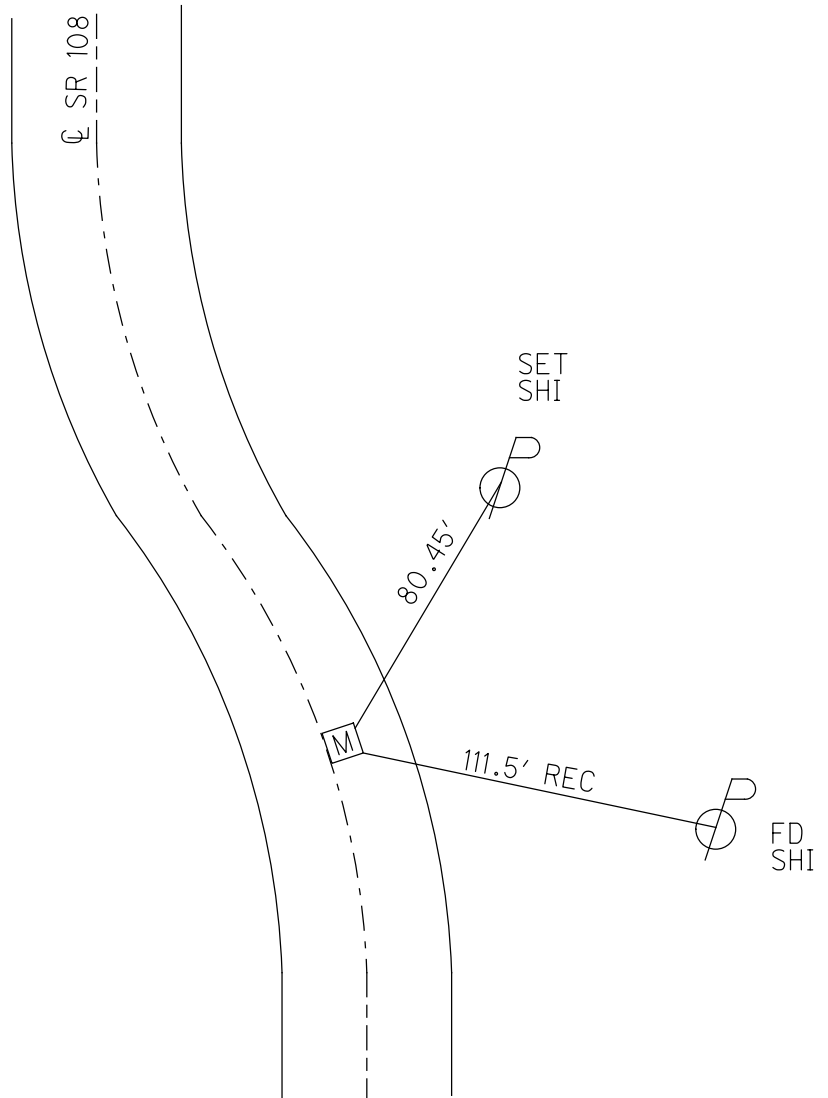

O.D.O.T. DISTRICT 2 SURVEY OFFICE (USE ONLY)


PERSONNEL _____ REFERENCE NO. 69 C SHEET 6 OF 21
NOTES HUSS DATE 4/15/09 ROUTE SR 108
H.C. CORDES WEATHER CLDY-BREEZY COUNTY HENRY
R.C. CORY TEMP. 47° TOWNSHIP NAPOLEON
SECTION 2
T 5 N R 6 E

TYPE MONUMENT MON.BOX
ON SURFACE - ~~BELOW~~ ON _____
~~LEFT~~ - CL PAV'T - RIGHT 1.0'
12.1' TO RT EDGE PAVEMENT
S.L.M. 975+41.26

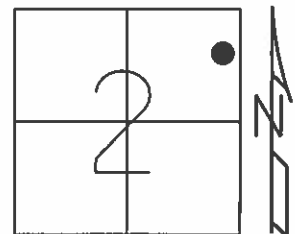

Grid: Northing: 644603.286 Easting: 1520856.608

RECORD:
1966 PLAN= 975+42.76
FD MON.BOX
SET STRADLES
SHOT IPIN
REFC69
8/6/01, KPM

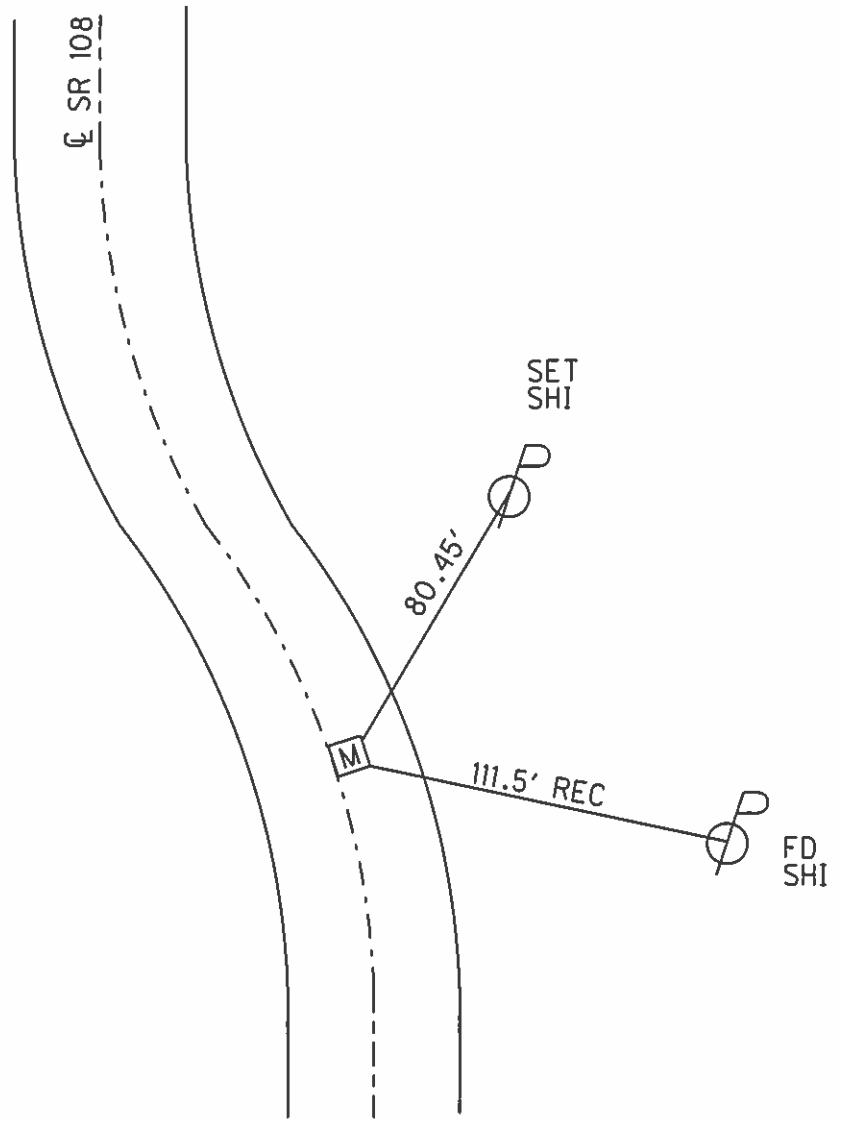

O.D.O.T. DISTRICT 2 SURVEY OFFICE

PERSONNEL

REFERENCE NO. 69-C SHEET 15 OF 21

NOTES MOSE

H.C. CANTERBURY

R.C. MOSE

DATE 8-6-01

WEATHER SUN

TEMP. +80°

ROUTE 108

COUNTY HENRY

TOWNSHIP NAPOLEON

SECTION 2

T S N R 6 E



TYPE MONUMENT Mon. Box

ON SURFACE - ~~BELOW~~ SURFACE

~~LEFT~~ - & PAV'T. - RIGHT 1.0' RT

12.1' TO RT. EDGE PAVEMENT

S.L.M. 974 + 77

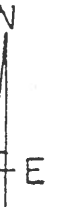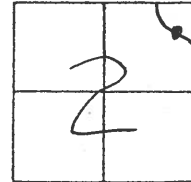

RECORD:

1966 PLAN = 975 + 42.76

SET STRADLES

8-6-01

S.R. # 108


78.6' (REC)

Fd. SHE
G' UP SW/S.

111.5' (REC)

Fd. SHE.
NW/S.

& PAVT.

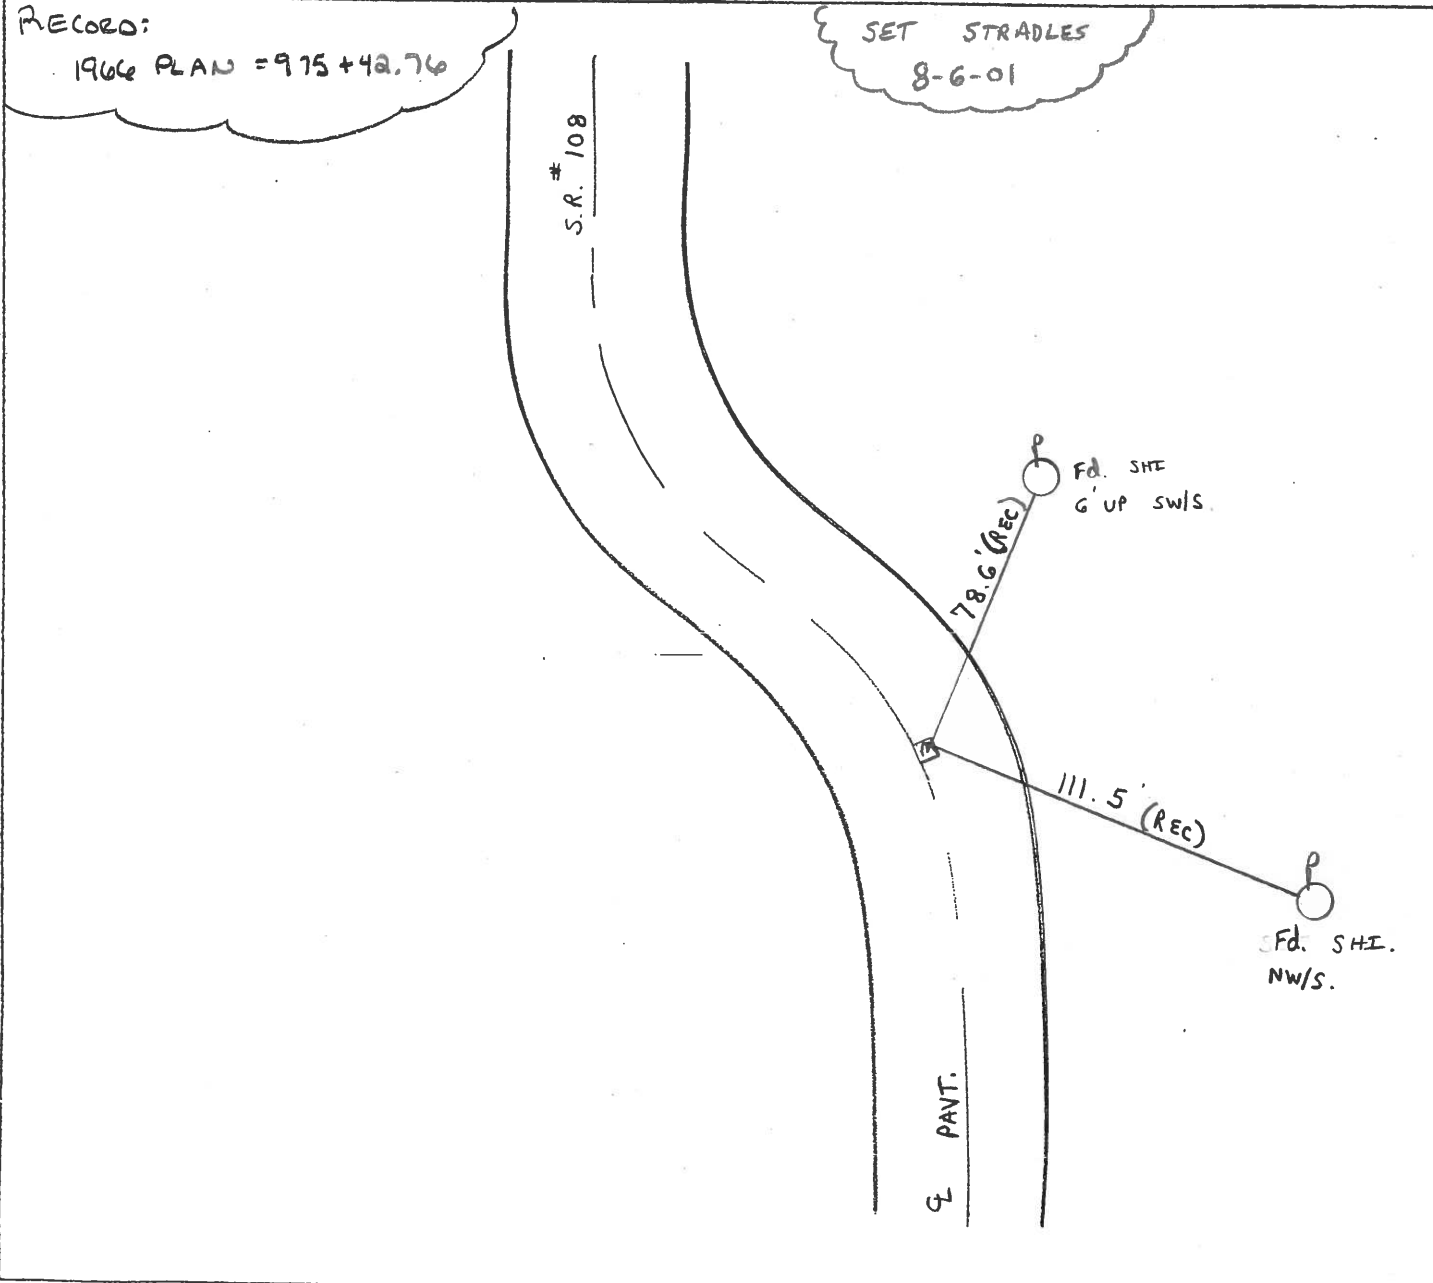

O.D.O.T. DISTRICT 2 SURVEY OFFICE

PERSONNEL

REFERENCE NO. _____

SHEET 27 OF 33

NOTES HOFFMAN

H.C. BARWISAL

R.C. LOCHREK

REED

DATE 4-18-88

WEATHER P. CLEAR

TEMP. 43°

ROUTE SR 108

COUNTY HENRY

TOWNSHIP NADOLSON

SECTION 2

T5 N R 6 E


TYPE MONUMENT Monument Box

ON SURFACE - BELOW YES

~~LEFT~~ - PAV'T. - RIGHT 1.0'

R1 TO R2 EDGE PAVEMENT

S.L.M. 974+77

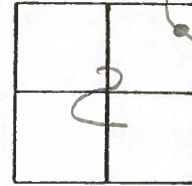


1966 PLAN = 975+42.76

DID NOT OPEN LID

69-C

SR 108

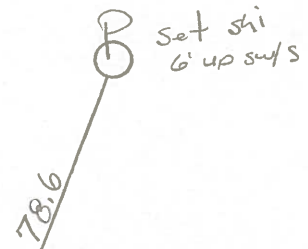

Set stn
6' up sw/s



Set stn
6' up
sw/s

Part
E