

O.D.O.T. DISTRICT 2 SURVEY OFFICE (USE ONLY)

PERSONNEL

REFERENCE NO. 69 D

SHEET 7 OF 21

NOTES HUSS

DATE 4/15/09

ROUTE SR 108

H.C. CORDES

WEATHER CLOUDY

COUNTY HENRY

R.C. CORY

TEMP. 47°

TOWNSHIP NAPOLEON

SECTION 2

DWG BY NIESE PID 101211

T 5 N R 6 E

TYPE MONUMENT MONBOX W/1" IPIN

ON SURFACE - ~~BELOW~~ ON \_\_\_\_\_

OFFSET ☉ PAVEMENT ON \_\_\_\_\_ LT : RT  
12.6' TO RT EDGE PAVEMENT


STATION: 979+40.978

HORZ.DATUM: NAD83(2011)


GEOID: 2012A

GRID: NORTHING: 644967.177

EASTING: 1520691.141

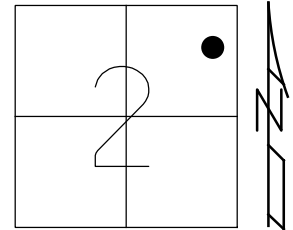

RECORD:  
 1966 PLAN  
 STA. 979+42.76  
 FD MONBOX  
 W/IPIN  
 REFD69  
 8/2/01, KPM  
 FD MONBOX  
 REFD69  
 4/4/18, JLL  
 FD MONBOX  
 9/17/19, JLL

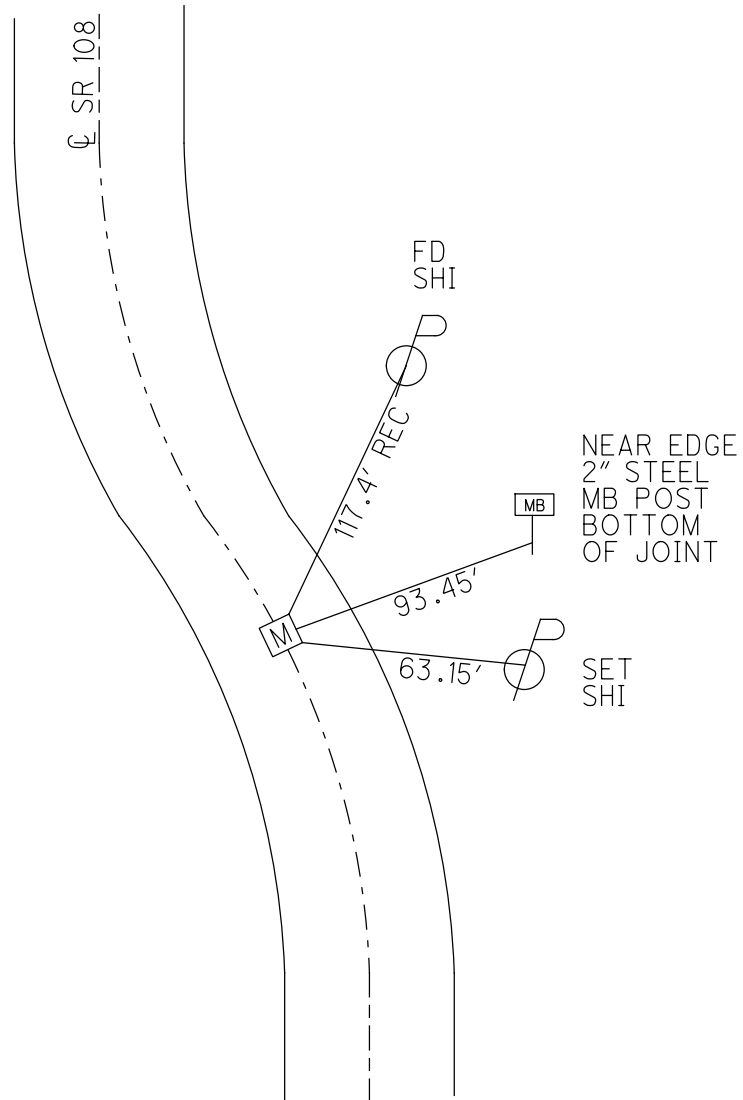

O.D.O.T. DISTRICT 2 SURVEY OFFICE (USE ONLY)

PERSONNEL \_\_\_\_\_

REFERENCE NO. 69 D

SHEET 7 OF 21

NOTES HUSS

DATE 4/15/09

ROUTE SR 108

H.C. CORDES

WEATHER CLDY-COOL

COUNTY HENRY

R.C. CORY

TEMP. 47°

TOWNSHIP NAPOLEON

SECTION 2

T 5 N R 6 E

TYPE MONUMENT MON.BOX


ON SURFACE - ~~BELOW~~ ON

LEFT - CL PAV'T - RIGHT ON

12.6' TO RT EDGE PAVEMENT


S.L.M. 979+40.978

Grid: Northing: 644967.134 Easting: 1520691.116

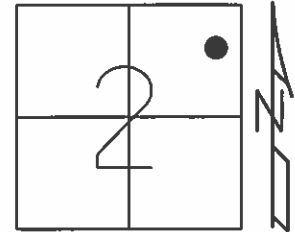

RECORD:  
1966 PLAN= 979+42.76

FD MON.BOX  
SHOT IPIN  
REFD69  
8/2/01, KPM

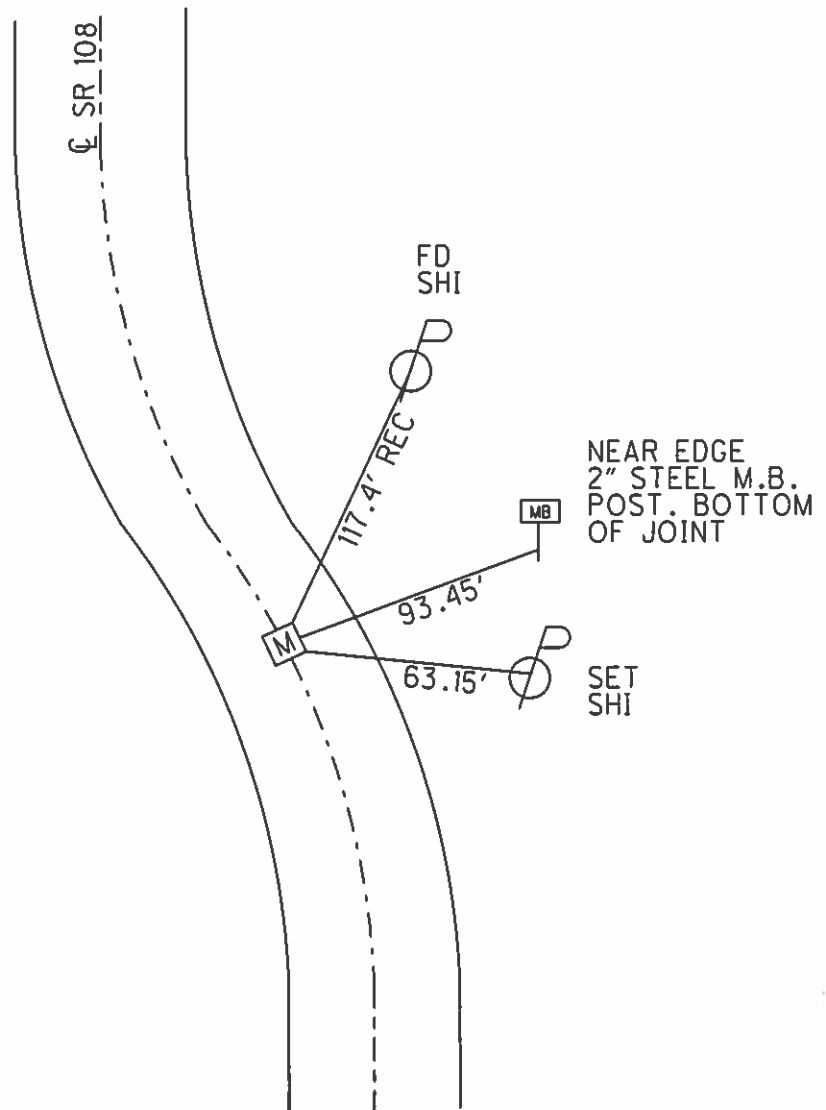

O.D.O.T. DISTRICT 2 SURVEY OFFICE

PERSONNEL


REFERENCE NO. 69-D SHEET 16 OF 21

NOTES MOSEK  
 H.C. CANTERBURY  
 R.C. MOSEK

DATE 8-2-01  
 WEATHER OVERCAST  
 TEMP. +90° F


ROUTE 108  
 COUNTY HENRY  
 TOWNSHIP NAPOLEON  
 SECTION 2  
T S N R G E

TYPE MONUMENT Man. Box  
 ON SURFACE - ~~BELOW~~ SURFACE  
~~LEFT - C~~ PAV'T. - RIGHT 0.5' RT.  
12.6 TO RT EDGE PAVEMENT  
 S.L.M. 978 +76

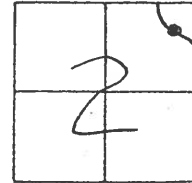

RECORD:

1966 PLAN = 979+42.76

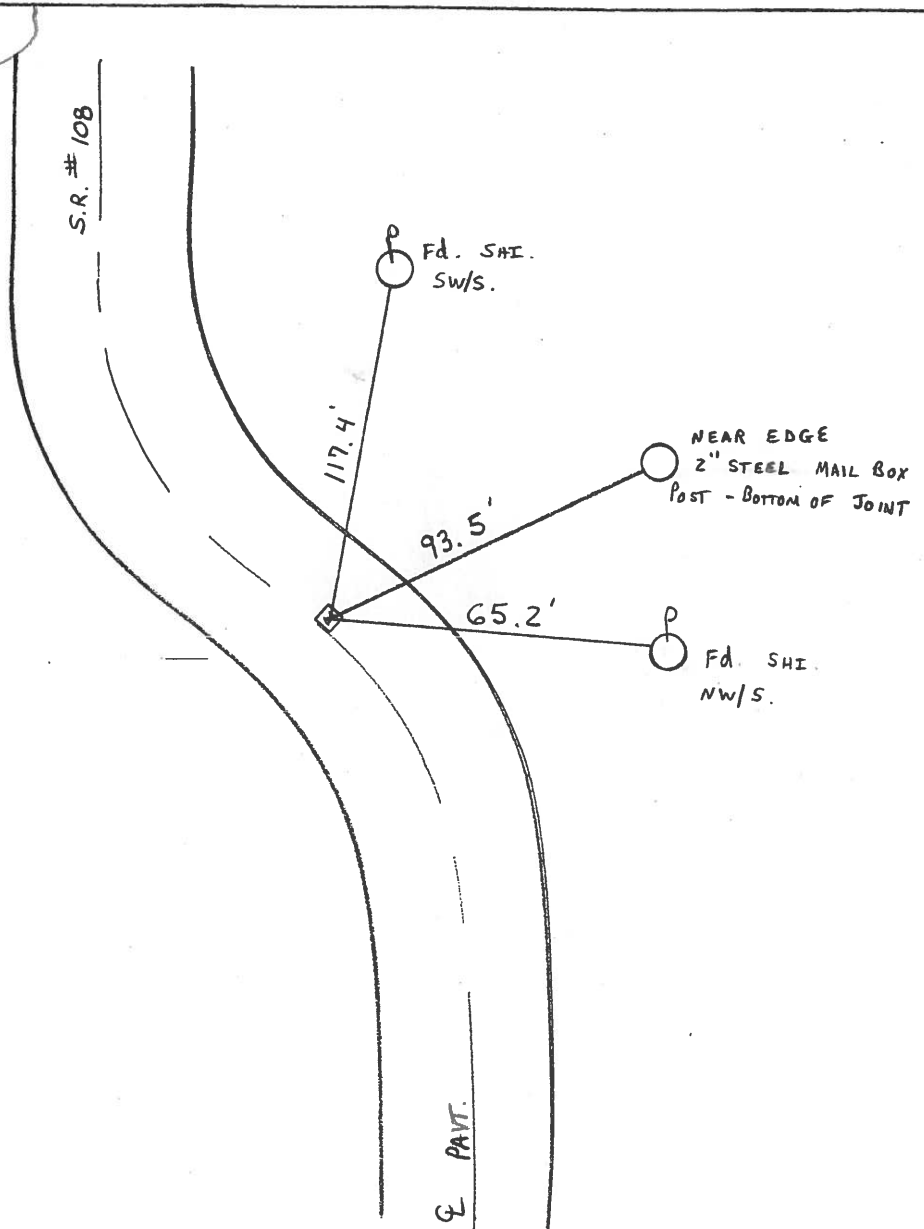

O.D.O.T. DISTRICT 2 SURVEY OFFICE

PERSONNEL

REFERENCE NO. \_\_\_\_\_

SHEET 28 OF 33

NOTES HOFFMAN

H.C. BARNHISEL

R.C. LOCHKE

REED

DATE 4-18-88

WEATHER P CLEAR

TEMP. 43°

ROUTE SR 108

COUNTY HENRY

TOWNSHIP NAPOLEON

SECTION 2

T.S. N R 6 E


TYPE MONUMENT Monument Box

ON SURFACE - ~~BELOW~~ YES

~~LEFT~~ & PAV'T. - RIGHT 0.5

11.8 TO RT EDGE PAVEMENT

S.L.M. 978+76

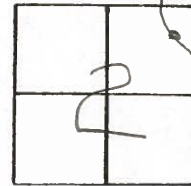

1966 PLAN = 979+42.76

DID NOT OPEN LID

69-D

