

O.D.O.T. DISTRICT 2 SURVEY OFFICE (USE ONLY)

PERSONNEL

REFERENCE NO. 69 F

SHEET 9 OF 21

NOTES HUSS

DATE 4/15/09

ROUTE SR 108

H.C. CORDES

WEATHER CLOUDY

COUNTY HENRY

R.C. CORY

TEMP. 47°

TOWNSHIP NAPOLEON

DWG BY NIESE

PID 101211

SECTION 2

T 5 N R 6 E

TYPE MONUMENT MONBOX W/1" IPIN

ON SURFACE - ~~BELOW~~ ON

OFFSET $\text{\textcircled{C}}$ PAVEMENT 0.5' LT : ~~RT~~
12.3' TO LT EDGE PAVEMENT


STATION: 984+90.63

HORZ.DATUM: NAD83(2011)


GEOID: 2012A

GRID: NORTHING: 645464.818

EASTING: 1520458.025

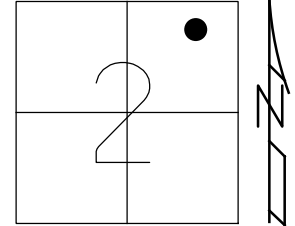

RECORD:
1966 PLAN
STA.984+92.90
FD MONBOX
REFF69
8/2/01, KPM
FD MONBOX
REFF69
4/4/18, JLL
FD MONBOX
9/17/19, JLL

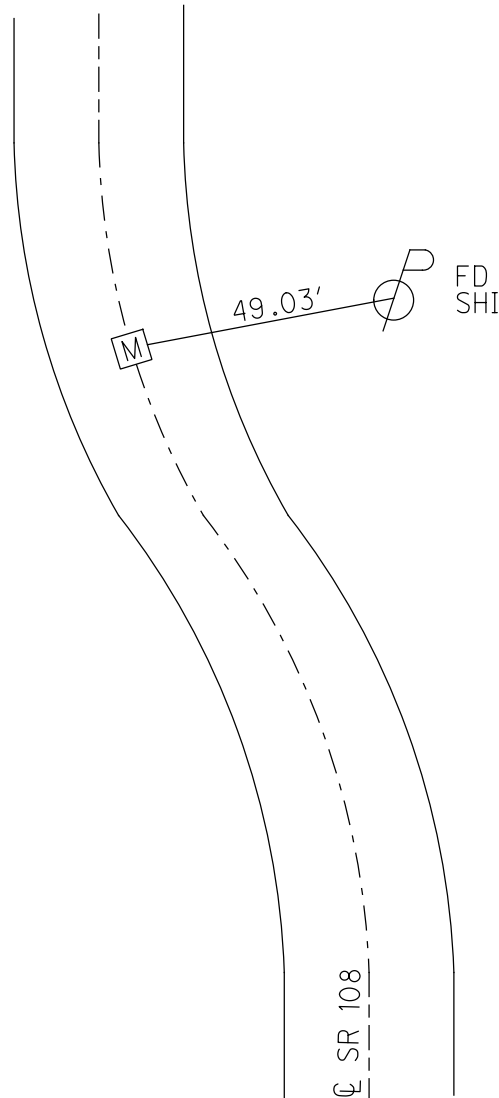

O.D.O.T. DISTRICT 2 SURVEY OFFICE (USE ONLY)

PERSONNEL

REFERENCE NO. 69 F

SHEET 9 OF 21

NOTES HUSS

DATE 4/15/09

ROUTE SR 108

H.C. CORDES

WEATHER CLDY-FAIR

COUNTY HENRY

R.C. CORY

TEMP. 47°

TOWNSHIP NAPOLEON

SECTION 2

T 5 N R 6 E

TYPE MONUMENT MON.BOX



ON SURFACE - ~~BELOW~~ ON

LEFT - Q PAV'T - ~~RIGHT~~ 0.5'

12.3' TO LT EDGE PAVEMENT

S.L.M. 984+90.63

Grid: Northing: 645464.835 Easting: 1520458.064

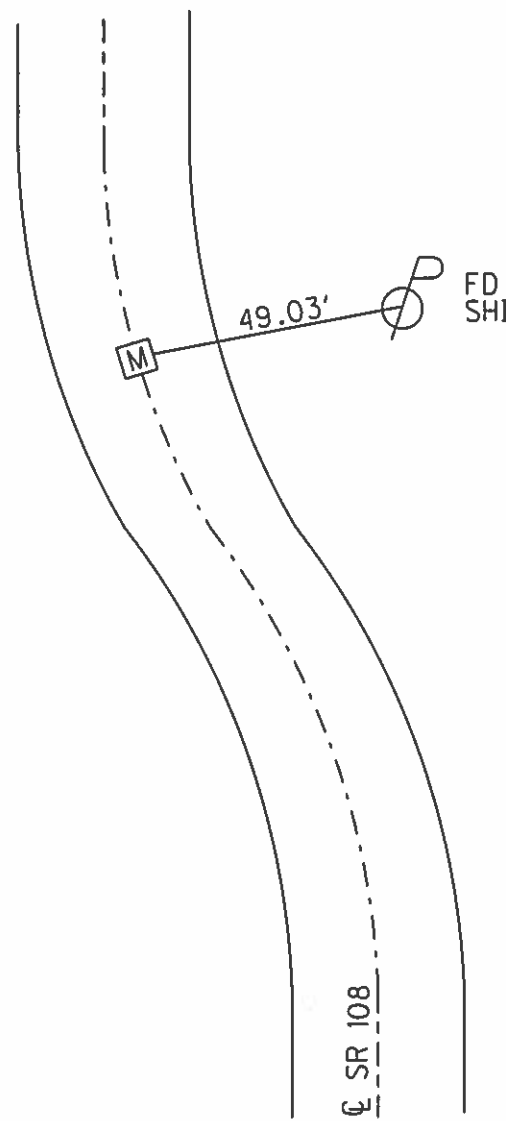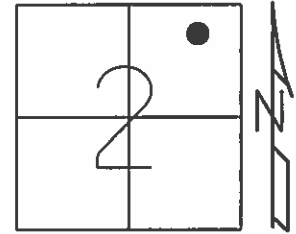

RECORD:
1966 PLAN= 984+92.90

FD MON.BOX
COULD NOT OPEN
MEASURED TO CTL
OF LID. SHOT LID.
REFF69
8/2/01, KPM

O.D.O.T. DISTRICT 2 SURVEY OFFICE

PERSONNEL

REFERENCE NO. 69-F

SHEET 18 OF 21

NOTES MOSEK

H.C. CANTERBURY

R.C. MOSEK

DATE 8-2-01

WEATHER OVERCAST

TEMP. +90°

ROUTE 108

COUNTY HENRY

TOWNSHIP NAPOLEON

SECTION 2

T S N R 6 E


TYPE MONUMENT Mon. Box

ON SURFACE - ~~BELOW~~ SURFACE

LEFT - Q PAV'T. - ~~RIGHT~~ 0.5' LT


12.3' TO LT EDGE PAVEMENT

S.L.M. 984 +25

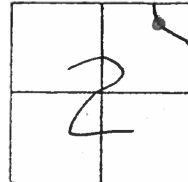

RECORD:

1966 PLAN = 984 +92.90

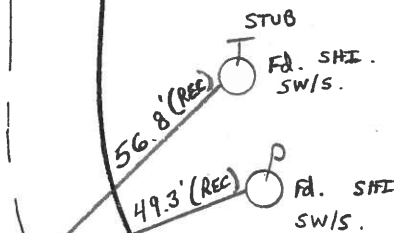

Q PAV'T.

O.D.O.T. DISTRICT 2 SURVEY OFFICE

PERSONNEL

REFERENCE NO. _____

SHEET 30 OF 33

NOTES HOEFMAN

H.C. BARANISEL

R.C. LOSHRKE

REED

DATE 4-18-88

WEATHER P. CLEAR

TEMP. 44°

ROUTE SR 108

COUNTY HENRY

TOWNSHIP NAPOLEON

SECTION 2

T.S. N R 6 E


TYPE MONUMENT Monument Box

ON SURFACE - ~~BELOW~~ YES

LEFT-~~0~~ PAV'T. - ~~RIGHT~~ 0.5

12.3' TO LT EDGE PAVEMENT

S.L.M. 984+25

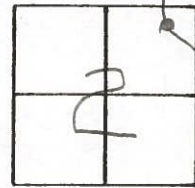

1966 PLAN = 984+92.90

DID NOT OPEN LID

(69-F)

