


O.D.O.T. DISTRICT 2 SURVEY OFFICE (USE ONLY)


PERSONNEL _____ REFERENCE NO. 69 G SHEET 10 OF 21
 NOTES HUSS DATE 4/15/09 ROUTE SR 108
 H.C. CORDES WEATHER CLOUDY COUNTY HENRY
 R.C. CORY TEMP. 47° TOWNSHIP NAPOLEON
 DWG BY NIESE PID 101211 SECTION 2
 T 5 N R 6 E

TYPE MONUMENT MONBOX W/1" IPIN
 ON SURFACE - ~~BELOW~~ ON
 OFFSET CL PAVEMENT ON LT : RT
12.3' TO RT EDGE PAVEMENT
 STATION: 988+93.79

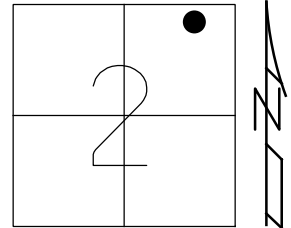

HORZ.DATUM: NAD83(2011) GEOID: 2012A
 GRID: NORTHING: 645858.088 EASTING: 1520369.242

RECORD:
 1966 PLAN
 STA.988+97.19
 FD MONBOX
 REFG69
 8/2/01, KPM
 FD MONBOX
 REFG69
 4/4/18, JLL
 FD MON BOX
 9/17/19, JLL


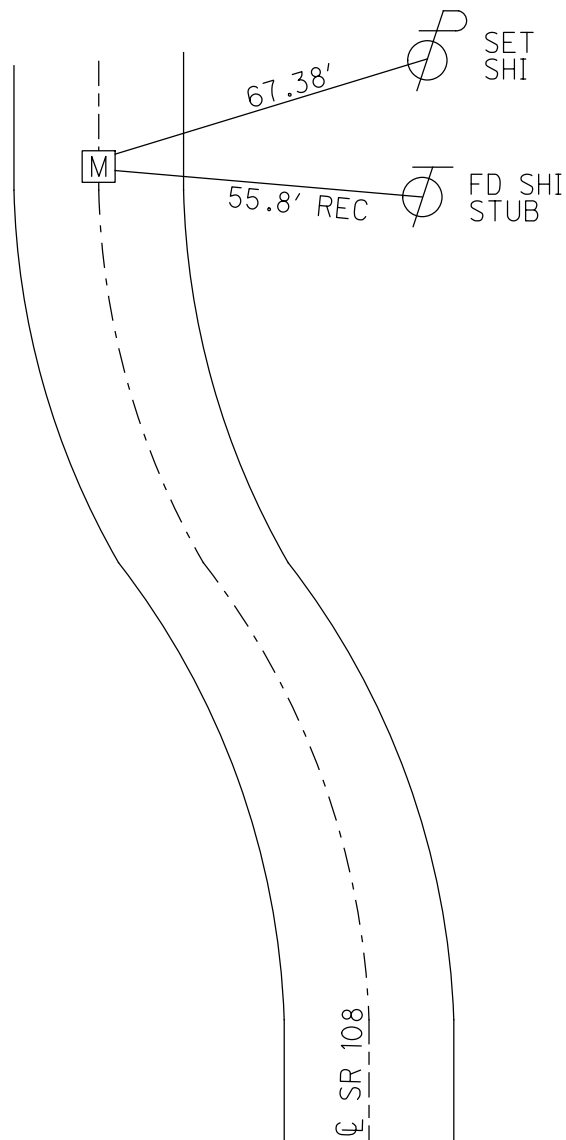


O.D.O.T. DISTRICT 2 SURVEY OFFICE (USE ONLY)

PERSONNEL _____ REFERENCE NO. 69 G SHEET 10 OF 21
NOTES HUSS DATE 4/15/09 ROUTE SR 108
H.C. CORDES WEATHER CLDY-BREEZY COUNTY HENRY
R.C. CORY TEMP. 47° TOWNSHIP NAPOLEON
SECTION 2
T 5 N R 6 E

TYPE MONUMENT MON.BOX
ON SURFACE - ~~BELOW~~ ON
LEFT - CL PAV'T - RIGHT ON
12.3' TO RT EDGE PAVEMENT
S.L.M. 988+93.79

Grid: Northing: 645858.085 Easting: 1520369.221

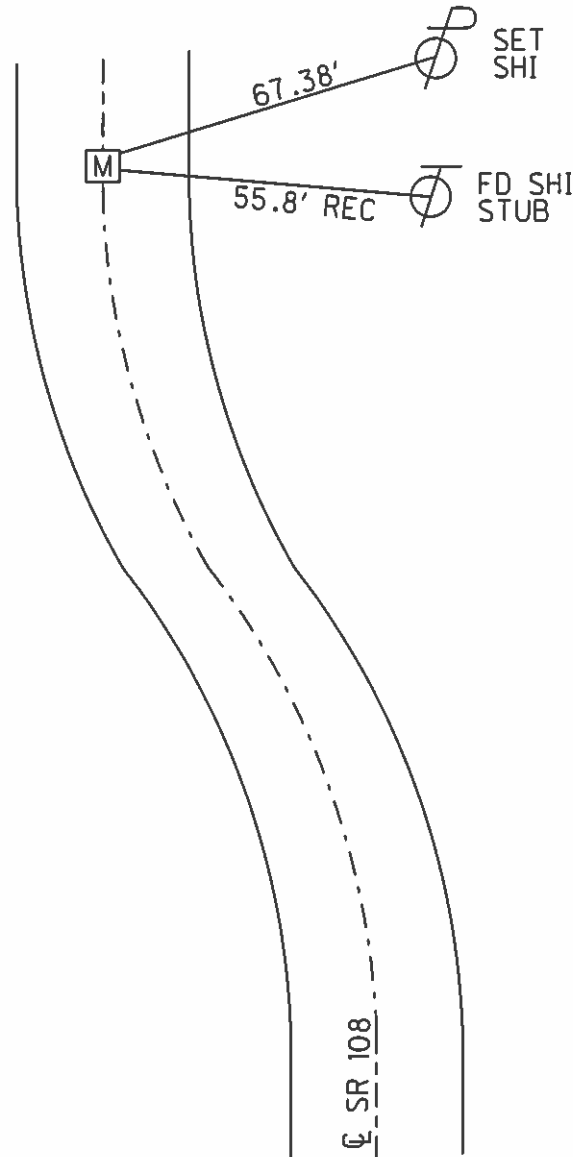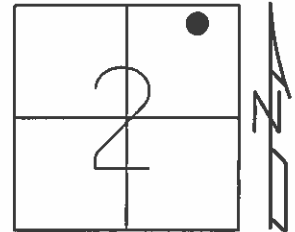

RECORD:
1966 PLAN= 988+97.19

FD MON.BOX
COULD NOT OPEN
MEASURED TO CTL
OF LID. SHOT LID.
REFG69
8/2/01, KPM

O.D.O.T. DISTRICT 2 SURVEY OFFICE

PERSONNEL

REFERENCE NO. 69-G

SHEET 19 OF 21

NOTES MOSEK

H.C. CANTERBURY

R.C. MOSEK

DATE 8-2-01

WEATHER OVERCAST

TEMP. +90°

ROUTE 108

COUNTY HENRY

TOWNSHIP NAPOLÉON

SECTION 2

T S N R 6 E


TYPE MONUMENT Mon. Box

ON SURFACE - ~~BELOW~~ SURFACE


~~LEFT - & PAV'T. - RIGHT & PAVT.~~

12.3' TO RT. EDGE PAVEMENT

S.L.M. 988 +29

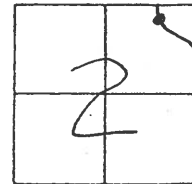

RECORD:
1966 PLAN = 988 +97.19

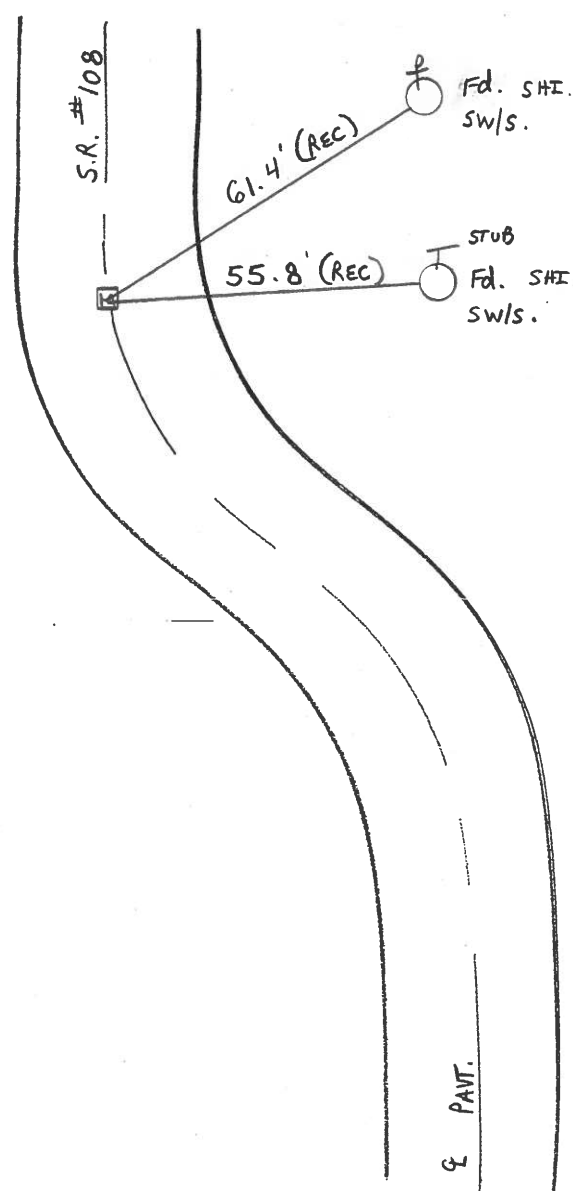

O.D.O.T. DISTRICT 2 SURVEY OFFICE

PERSONNEL

REFERENCE NO. _____

SHEET 31 OF 33

NOTES HOFFMAN

H.C. BARNHISEL

R.C. LOEBRKE

REED

DATE 4-18-88

WEATHER P. CLEAR

TEMP. 44°

ROUTE SR 108

COUNTY HENRY

TOWNSHIP NAPOLEON

SECTION 2

T.S. N R 6 E


TYPE MONUMENT Monument Box

ON SURFACE - BELOW YES

LEFT - & PAV'T. - RIGHT YES

12.3' TO RT. EDGE PAVEMENT

S.L.M. 988 +29

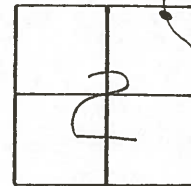

1966 PLAN = 988 + 97.19

DID NOT OPEN LID

(69-6)

